

TWO-LANE RESURFACING PROGRAM

SHEET 1 OF 3

PRIORITY NO. 14

PART 2 OF 2

COUNTY Seneca

ROUTE US 23

SECTION 11.95

BEGIN LOG (SLM) ~~11.95~~ 11.95

TERMINI 5R12 (Little Street)

END LOG (SLM) 12.57±

TERMINI Const joint (Seneca County Line Road)

TOTAL LENGTH 0.62

MILES

MUNICIPALITY Fosterie

BEGIN LOG (SLM) 11.95 END LOG (SLM) 12.57±

MUNICIPALITY

BEGIN LOG (SLM) END LOG (SLM)

PROPOSED WORK:

PAVEMENT 1 1/2" 404

SHOULDER Grind 5± along curb

OTHER Repair all bad joints and potholes

EXISTING DATA:

SLM 632+00	TO	N. Bound	PAV'T	WIDTH	28.0	(type)	SHLD	WIDTH	(type)
SLM 632+00	TO	S. Bound	PAV'T	WIDTH	28.0	(type)	SHLD	WIDTH	(type)
SLM 642+00	TO	N. Bound	PAV'T	WIDTH	28.0	(type)	SHLD	WIDTH	(type)
SLM 642+00	TO	S. Bound	PAV'T	WIDTH	28.0	(type)	SHLD	WIDTH	(type)
SLM 644+00	TO	650+61	PAV'T	WIDTH	52.0	(type)	SHLD	WIDTH	(type)
SLM 650+94	TO	NO DIVIDE	PAV'T	WIDTH	52.0	(type)	SHLD	WIDTH	(type)
SLM 661+99	TO	NO DIVIDE	PAV'T	WIDTH	52.0	(type)	SHLD	WIDTH	(type)
SLM	TO		PAV'T	WIDTH		(type)	SHLD	WIDTH	(type)
SLM	TO		PAV'T	WIDTH		(type)	SHLD	WIDTH	(type)
SLM	TO		PAV'T	WIDTH		(type)	SHLD	WIDTH	(type)
SLM	TO		PAV'T	WIDTH		(type)	SHLD	WIDTH	(type)

STRUCTURES:

STR. NO. 12.12 RR. OVERPASS	WIDTH	LENGTH	PROP. WORK
STR. NO. 544 STREET NO	WIDTH	LENGTH	PROP. WORK
STR. NO.	WIDTH	LENGTH	PROP. WORK
STR. NO.	WIDTH	LENGTH	PROP. WORK
STR. NO.	WIDTH	LENGTH	PROP. WORK
STR. NO.	WIDTH	LENGTH	PROP. WORK

RAILROAD CROSSING:

NAME	STATION	NO. TRACKS	LENGTH ALONG C L	(no work)
NAME	STATION	NO. TRACKS	LENGTH ALONG C L	ft
NAME	STATION	NO. TRACKS	LENGTH ALONG C L	ft

MISCELLANEOUS:

NO. RAISED PAVEMENT MARKERS; EDGE OF PAVEMENT NONE, CENTERLINE

NO. MAILBOX APPROACHES NONE, MAILBOX SUPPORTS NONE

REMARKS:

Stop at concrete section, pickup bad joints and pavement areas

BEGINNING POINT 630+20 SPLIT PAVT ON S.E. 12 (BACKED STATIONING 4/2 FROM R.R. STRUCTURE 12/12)

ENDING POINT 661+99 / 52.0

R = Raise F = Feather

STATION	OUT Rt/Lt (Ft)	CATCH BASIN	MAN- HOLE	INLET	W V BOX	MON BOX	CASTING		REMARKS
							R	F	
631+02	2	X					X		4' S. OF CONC. MEDIAN AT INT. STA 12 + 23
634+80	ON LT CURE3			X			X	X	S. Bound LANES
634+80	ON RT CURE3			X			X	X	" "
634+80	ON LT CURE3			X			X	X	N. Bound LANES
634+80	ON RT CURE3			X			X	X	" "
637+63	ON RT CURE3			X			X	X	" "
637+65	ON LT CURE3			X			X	X	" "
637+65	ON RT CURE3			X			X	X	S. Bound LANES
637+66	18' LT OF RT CURE3		X				X		" "
637+67	ON LT CURE3			X			X	X	S. Bound LANES
640+37	16' LT OF RT CURE3		X				X		" "
640+37	ON RT CURE3			X			X	X	" "
640+37	ON LT CURE3			X			X	X	N. Bound LANES
640+37	ON RT CURE3			X			X	X	" "
641+42	15' LT OF RT CURE3		X		CASTING REMOVED +		X		S. Bound LANES
642+64	15' LT OF RT CURE3		X		COVERED BY ASPHALT (NOT IN USE)		X		S. Bound LANES
642+68	ON RT CURE3			X			X	X	" "
642+70	ON LT CURE3			X			X	X	N. Bound LANES
642+74	ON RT CURE3			X			X	X	" "
643+54	12' RT OF LT CURB		X				X	X	" "
645+11	ON LT CURE3	X					X	X	" "
645+12	ON RT CURE3			X			X	X	" "
645+12	ON LT CURE3			X			X	X	S. Bound LANES
645+12	ON RT CURE3			X			X	X	" "
647+32	ON LT CURE3			X			X	X	N. Bound LANES
647+46	ON LT CURE3	X					X		" "
648+55	31' RT OF LT CURB	X					X	X	S. Bound LANES
649+41	4' RT OF LT CURB	X					X	X	IF GRINDING
649+43	ON LT CURE3	X					X		WASH TEASED LAST TIME
649+99	ON RT CURE3	X	LOCATED		IN RADIUS OF 1/4	SOUTH ST	X	X	IF GRINDING
650+05	15' RT OF LT CURE3		X				X		N. Bound LANES
653+30	ON RT CURE3	X					X	X	IF GRINDING
656+14	ON LT CURE3	X					X	X	IN DRIVE OF FIRE STATION
656+14	ON RT CURE3		X				X	X	
656+80	ON LT CURE3	X	X				X	X	

AD LONGER
DIVIDER
HYDRA

PERSONNEL
Van Dusen
BARNHISE

TITLE
Asst
0

PERSONNEL

TITLE

COUNTY
JENESHA

DATE
11-2-92

S.R.
U.S. 23

WEATHER
RAIN

SEC.
12.12

TEMP.
+58°F

DESCRIPTION
Minimum


VERT.
Vct.

Distance under bridges

JOB NO.

S.R.	S.L.M.	Vert. Dist	Date Checked	Remarks
U.S. 23	12.12	14.63	11-2-92	R.R. OVERPASS NORTH STRUCTURE N. BOUND L.A.
U.S. 23	12.12	13.70	11-2-92	R.R. OVERPASS SOUTH STRUCTURE N. BOUND L.A.
U.S. 23	12.12	14.51	11-2-92	R.R. OVERPASS NORTH STRUCTURE S. BOUND L.A.
U.S. 23	12.12	14.53	11-2-92	R.R. OVERPASS SOUTH STRUCTURE S. BOUND L.A.



PERSONNEL	TITLE	PERSONNEL	TITLE	COUNTY	DATE	WEATHER
MAN DUSEN	DI			JENESCH	10-30-92	
BARNHART	TAPS			S.R. 45.23		CLOUDY
				SEC. 11.95		TEMP. +50°F
DESCRIPTION		BAD AREA'S @ U.S. 23 & LYTLE		JOB NO.		
LEFT		CENTER LINE		RIGHT		

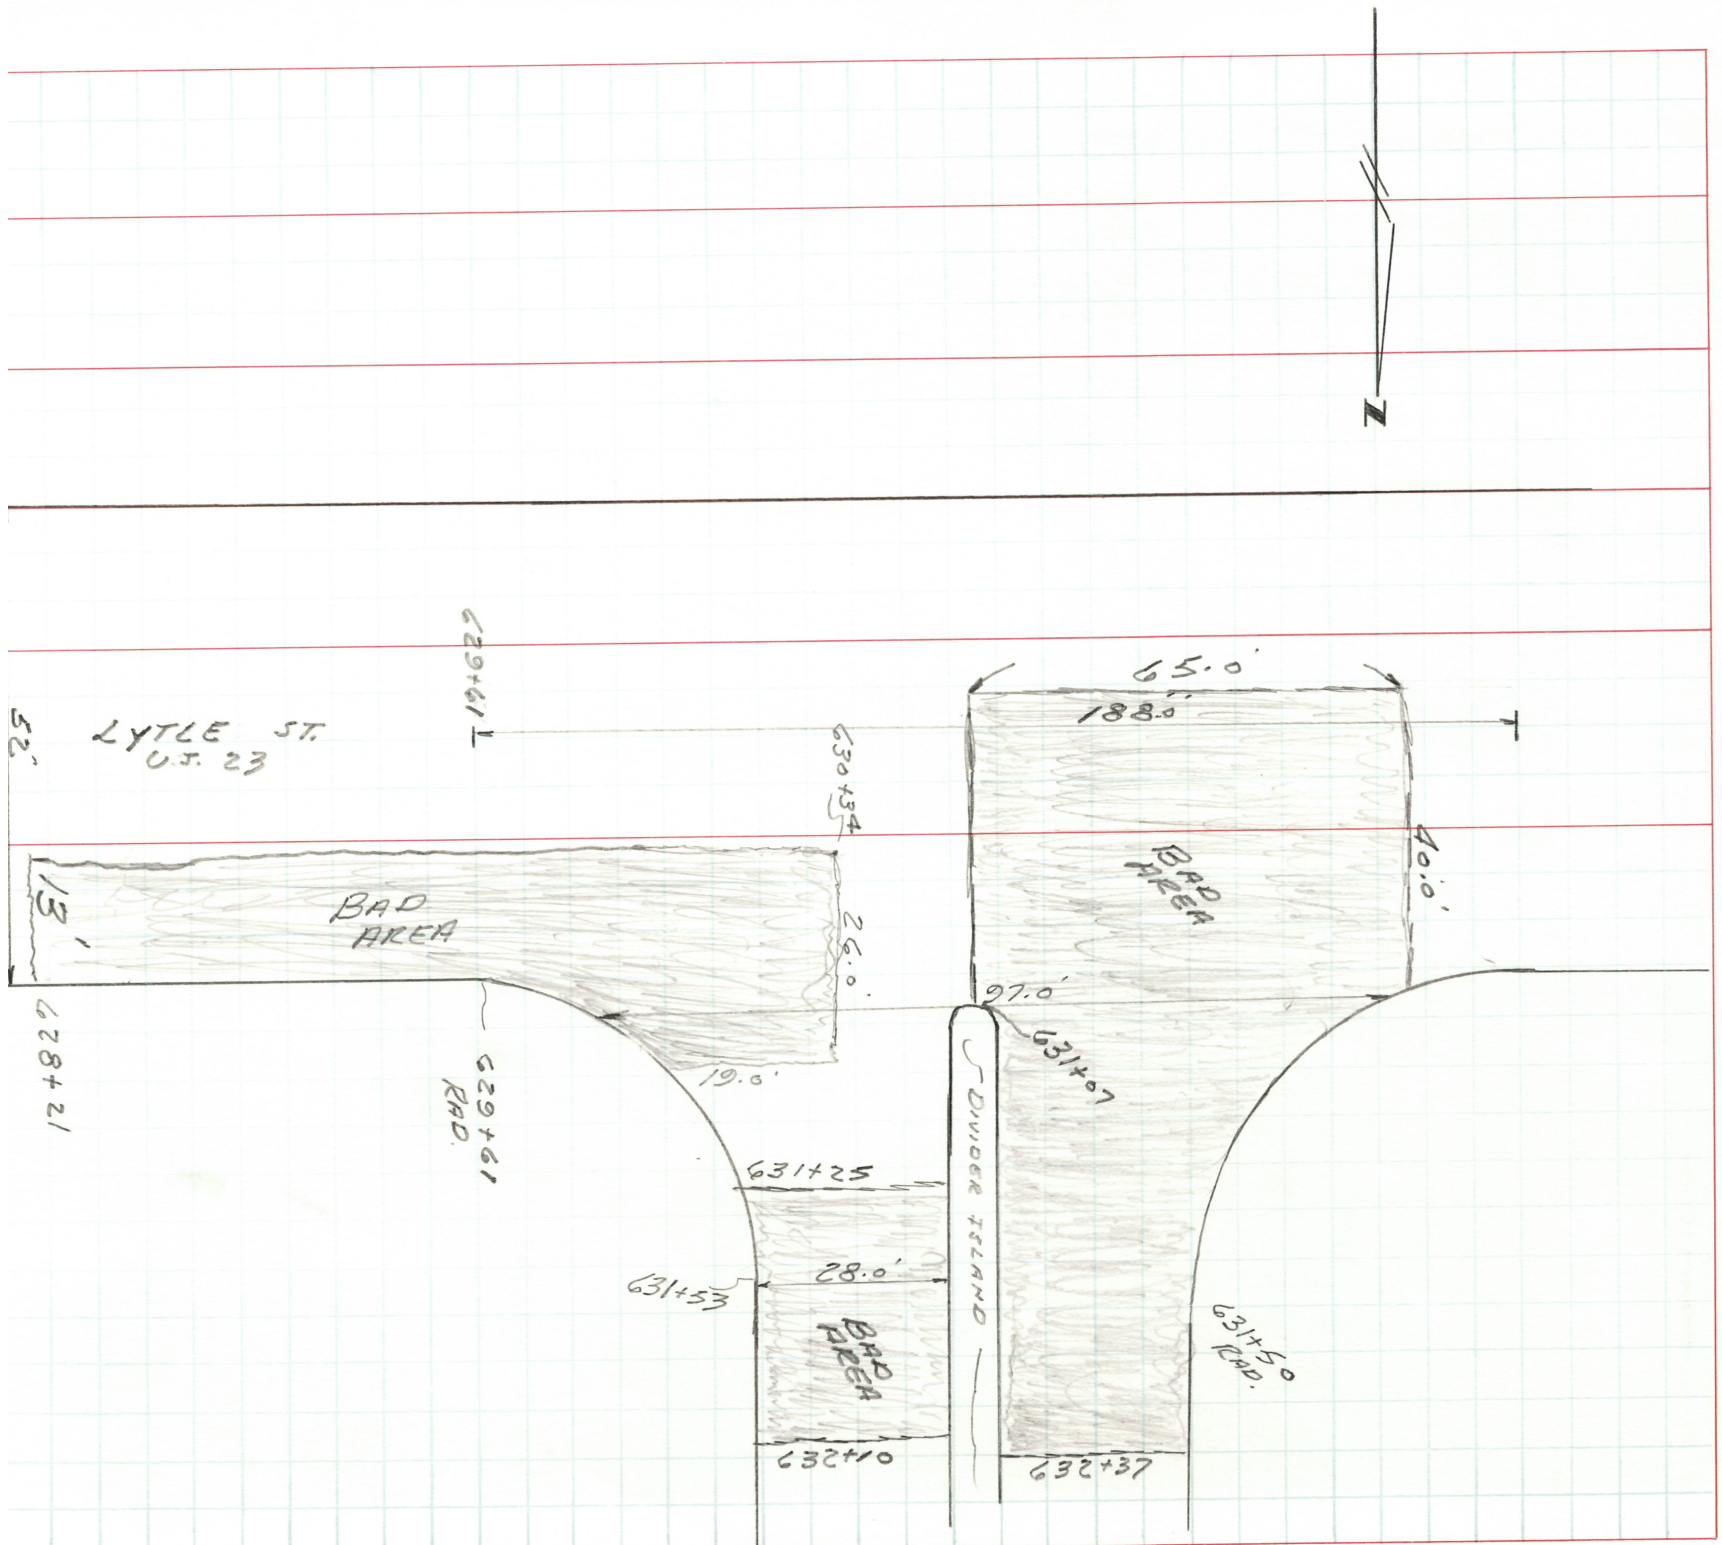

PERSONNEL	TITLE	PERSONNEL	TITLE	COUNTY	DATE	WEATHER
Van Dusen				Seneca	10-30-92	
BARWISSE	DD			S.R. 4.S. 23		CLOUDY

SEC.	TEMP.
11.95	+ 50°

DESCRIPTION	ADDITIONAL PAINT MARKINGS	LEFT	CENTER LINE	RIGHT	JOB NO.
-------------	---------------------------	------	-------------	-------	---------

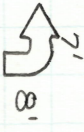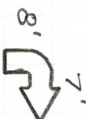STA:			Size	LANE
631+16	STOP BAR		2' x 31'	S. Bound
631+56	LT TURN ARROW			"
631+56	RT TURN ARROW			"
631+80	"	"	"	"
631+80	LT TURN ARROW		"	"
632+02	"	"	"	"
632+02	RT TURN ARROW		"	"
634+97	X-WALK		6.5' x 28.0'	N. + S. Bound
645+31	X-WALK		4.5' x 28.0'	N. + S. Bound
656+66	STOP BAR		2' x 27'	N. Bound
656+72	X-WALK		8' x 54'	N. + S. Bound
657+31	X-WALK		8' x 54'	N. + S. Bound
657+42	STOP BAR		2' x 27'	S. Bound
657+05	X-WALKS BOTH SIDES OF UNION ST. WITHIN OUR 15' FEATHER			
661+68	RT TURN ARROW			RT LANE N. Bound
661+68	TURN ARROWS			LT LANE N. Bound

PERSONNEL TITLE PERSONNEL TITLE COUNTY Seneca DATE 11-2-92


Van Dusen

Baranisek M S.R. 41.5.23 WEATHER Rain




SEC. 11.95 TEMP. +58°

DESCRIPTION BAD Pav't AREAS LEFT CENTER LINE RIGHT JOB NO.

STA:	S. BOUND		N. BOUND		REMARKS	
	LT. LANE	RT. LANE	LT. LANE	RT. LANE		
646+26			X	X	JOINT 3' long	BADLY CRACKED BADLY RUTTED + SLIDING X
646+57			X	X	JOINT X 3' long	
648+95 To 649+51			X	X		X
649+00 To 649+35	X	X				X
650+80 To 651+28				X		X
651+45 To 651+56		X			8' WIDE / HOLE BEEN PATCHED	X
652+81				X	JOINT 3' long	X
652+97	X	X			JOINT 3' long	X
653+23 To 656+20				X		X
654+19 To 654+40	X					X
657+32 To 659+39	X					X

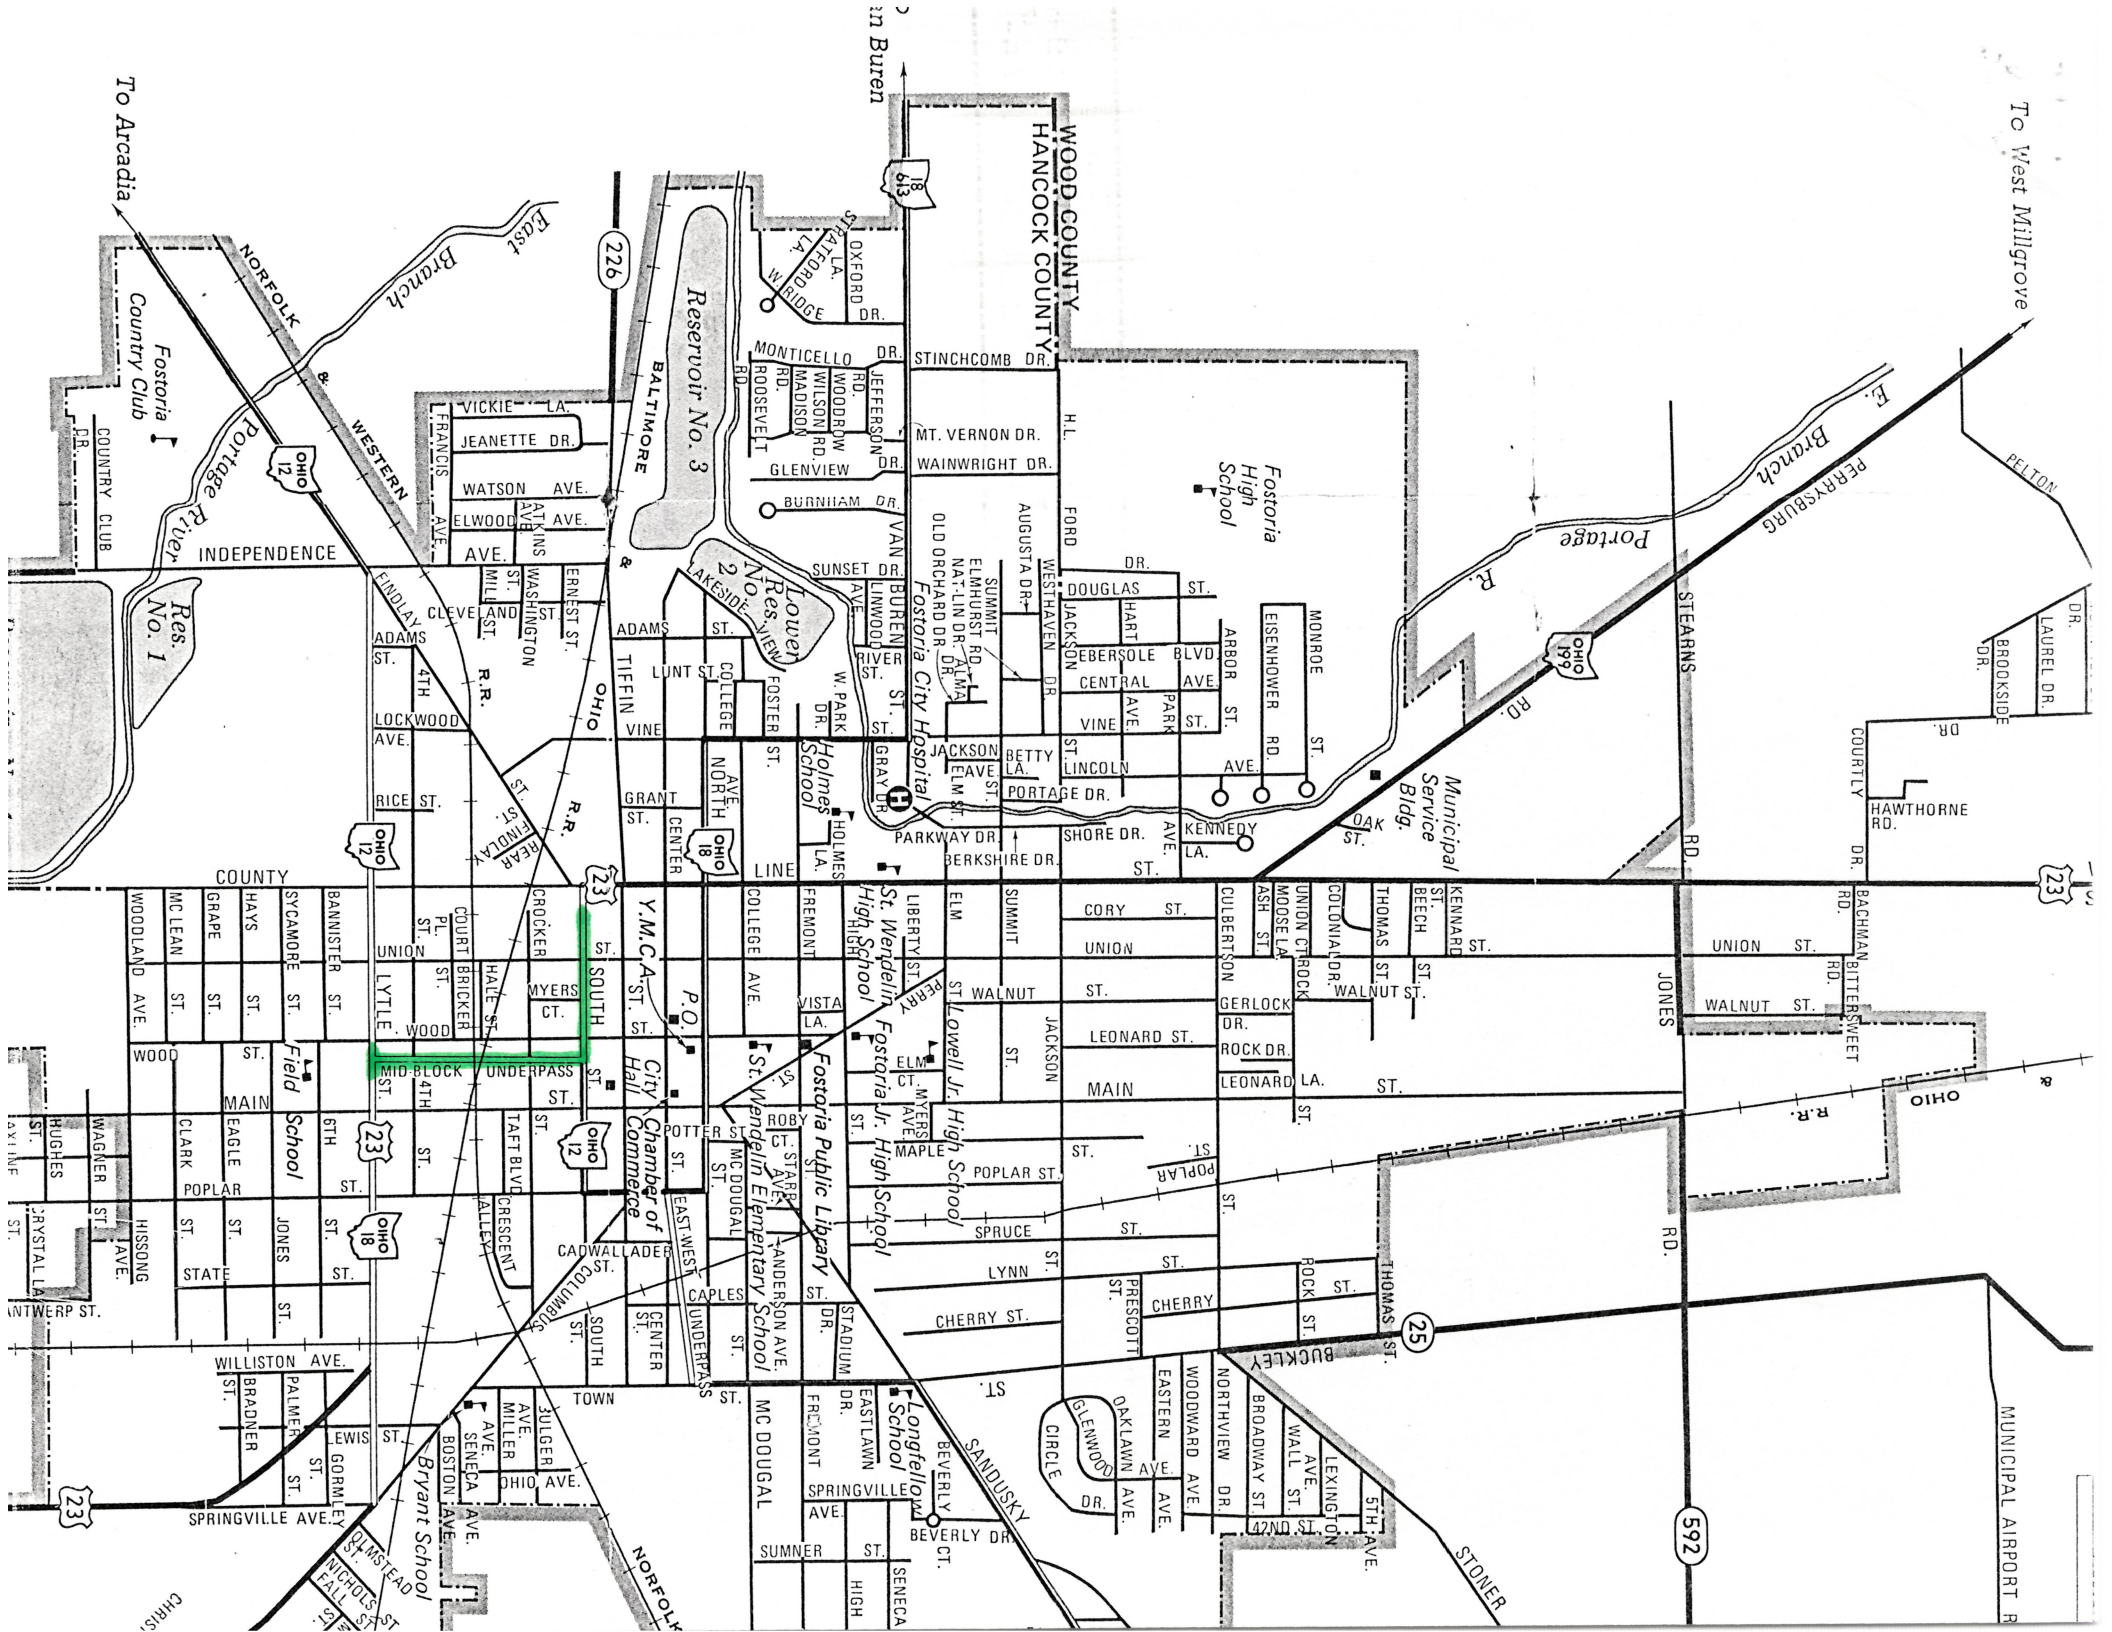

DISTRICT	2
COUNTY	SENECA
ROUTE	US 23

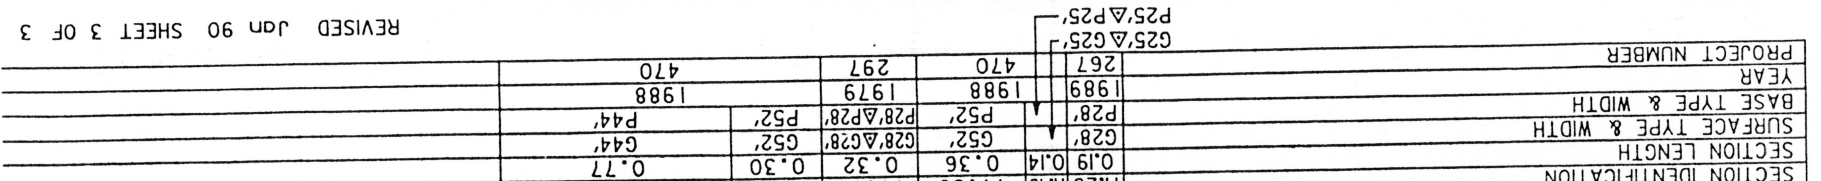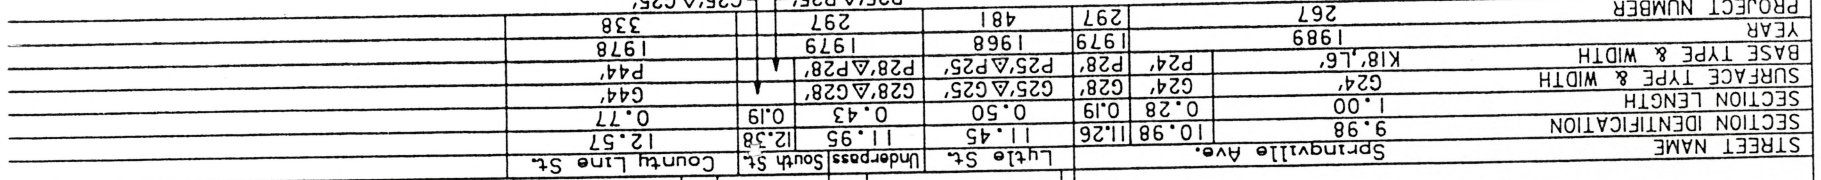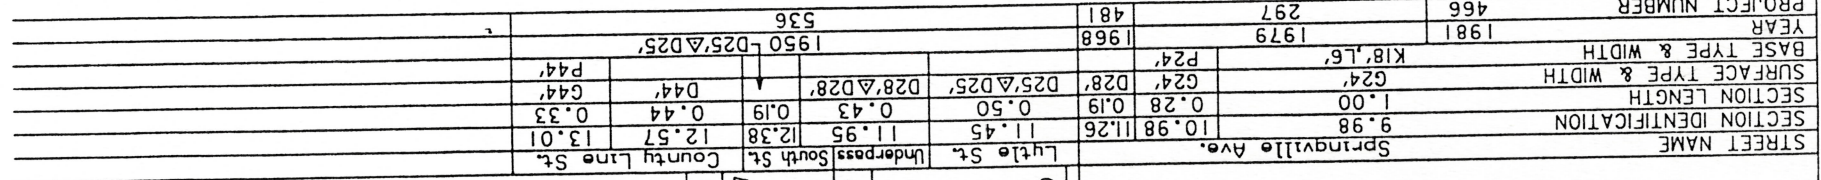

Wood-23-11.95 to 12.57
1993 Resurfacing



Locate by station & lane, all Pav Joints

Locate ALL BAD PAVEMENT
Locate ALL RUTTED Pavt.

Look For, locate Joints

South Street

SR 12

Locate divided Pavt,
Note Median, curb,
etc.

Rail Road

Need Vertical Clearance

Locate BAD Pavt

SR 19
US 23

US 23
SR 199

Begin Work 630+60

SR 12

The new Work will go around the corners to make it
easy bad Pavt or rutted Pavt. Give measurements
to limits you think will be necessary

Begin station
at R.R. overpass
Bridges, S.L.M. = 12.12 = 639+94

Fire station

US 23
SR 199

Locate
BAD Pavt

Wood Street

UNION

STREET

Joint 661+98.3
EXD at
Cove Pavt.

Possible
BAD
RUTTED
Pavt

COUNTY LINE ROAD

US 23 SR 199

Finley Street

