



O.D.O.T. DISTRICT 2 SURVEY OFFICE (USE ONLY)

PERSONNEL _____ REFERENCE NO. A SHEET 2 OF 71
 NOTES NIESE DATE 12/5/23 ROUTE SR 12
 H.C. AUBLE WEATHER RAINY COUNTY SENECA
 R.C. NIESE TEMP. 38° TOWNSHIP LOUDON
 DWG BY RHOADES PID 110192 SECTION 6
 T 2 N R 13 E

TYPE MONUMENT MAG/WASHER
 ON SURFACE - ~~BELOW~~ ON _____
 OFFSET \odot PAVEMENT 3" ~~±~~ : RT
 - TO - EDGE PAVEMENT
 STATION: 74+77

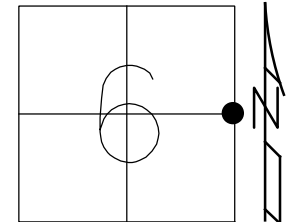


HORZ.DATUM: NAD83 2011 GEOID: NAVD88 2018
 GRID: NORTHING: 545149.798 EASTING: 1719239.030

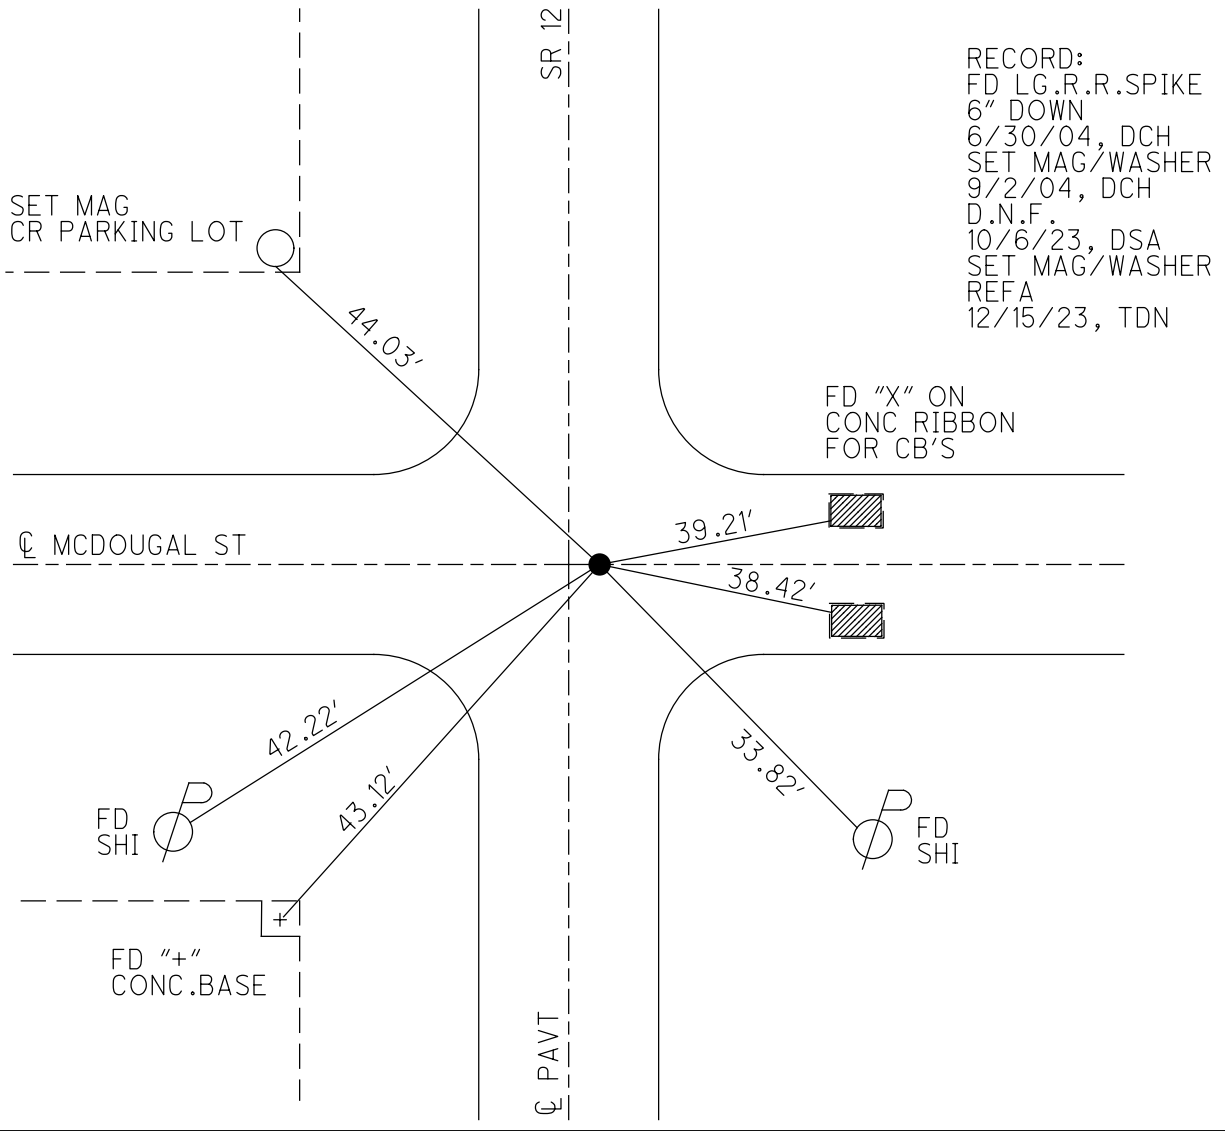

O.D.O.T. DISTRICT 2 SURVEY OFFICE (USE ONLY)


PERSONNEL	REFERENCE NO.	<u>A</u>	SHEET	<u>1</u>	OF	<u>70</u>
NOTES	<u>HUSS</u>	DATE	<u>06-30-04</u>	ROUTE	<u>SR 12</u>	
H.C.	<u>HOMAN</u>	WEATHER	<u>SUNNY</u>	COUNTY	<u>SENECA</u>	
R.C.	<u>NUHFER</u>	TEMP.	<u>76°</u>	TOWNSHIP	<u>LOUDON</u>	
				SECTION	<u>6</u>	
				T	<u>2</u>	R
					<u>N</u>	<u>13</u>
					<u>E</u>	

TYPE MONUMENT _____ LG RR SPIKE
 ON-SURFACE - BELOW _____ 6"
 LEFT - ϕ PAV'T - RIGHT _____ 3'
 _____ TO _____ EDGE PAVEMENT
 S.L.M. _____ 74+77

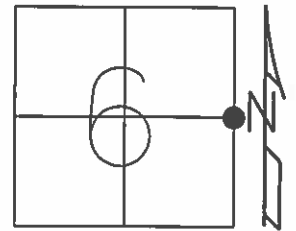

GRID: NORTHING: _____ EASTING: _____

SET MAG NAIL
& WASHER, DCH
09-02-04

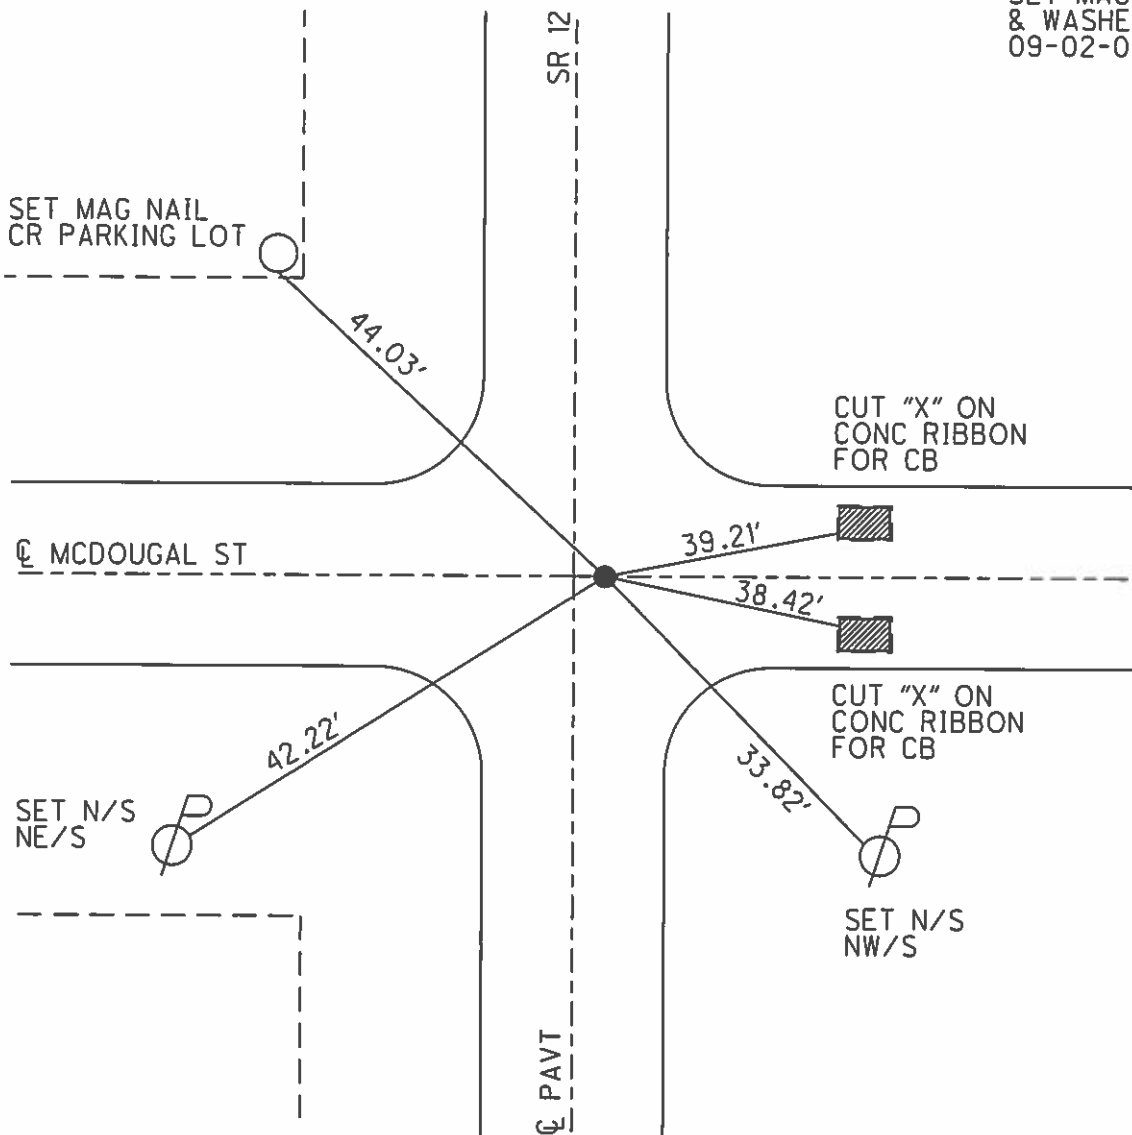

O.D.O.T. DISTRICT 2 SURVEY OFFICE

PERSONNEL

REFERENCE NO. A

SHEET 1 OF 1

NOTES HUSS

DATE 6-30-04

ROUTE SR 12

H.C. HOMAN

WEATHER SUNNY

COUNTY SENECA

R.C. NUHFER

TEMP. 76°

TOWNSHIP LOUDON

SECTION 6

T 2 N R 13 E

TYPE MONUMENT LG RR SPIKE

~~ON SURFACE~~ - BELOW 6"

~~LEFT - C PAVT~~ - RIGHT 3' RT

TO EDGE PAVEMENT

S.L.M. 74+77

