


O.D.O.T. DISTRICT 2 SURVEY OFFICE (USE ONLY)


PERSONNEL	REFERENCE NO.	<u>13</u>	SHEET	<u>14</u>	OF	<u>70</u>
NOTES	<u>HARBAUGH</u>	DATE	<u>05-18-12</u>	ROUTE	<u>SR 12</u>	
H.C.	<u>ROUSOS</u>	WEATHER	<u>SUNNY</u>	COUNTY	<u>SENECA</u>	
R.C.	<u>HUSS</u>	TEMP.	<u>60°</u>	TOWNSHIP	<u>JACKSON</u>	
				SECTION	<u>27</u>	
				T <u>3</u> N	R <u>13</u> E	

TYPE MONUMENT	<u>PK/WASHER</u>
ON SURFACE - BELOW	<u>ON</u>
LEFT - \odot PAV'T - RIGHT	<u>ON</u>
<u>11.5'</u> TO LT EDGE PAVEMENT	
S.L.M.	<u>281+73</u>

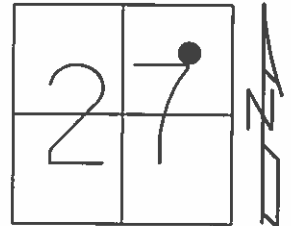

GRID: NORTHING: 557230.575 EASTING: 1735325.514

10-13-99 SET PK/WASHER, SAH
 05-18-12 FD PK/WASHER, JMH
 05-31-12 GPS REF13, MC
 11-15-12 SET MAG/WASHER, SDC
 11-15-12 GPS NEWREF13, SDC

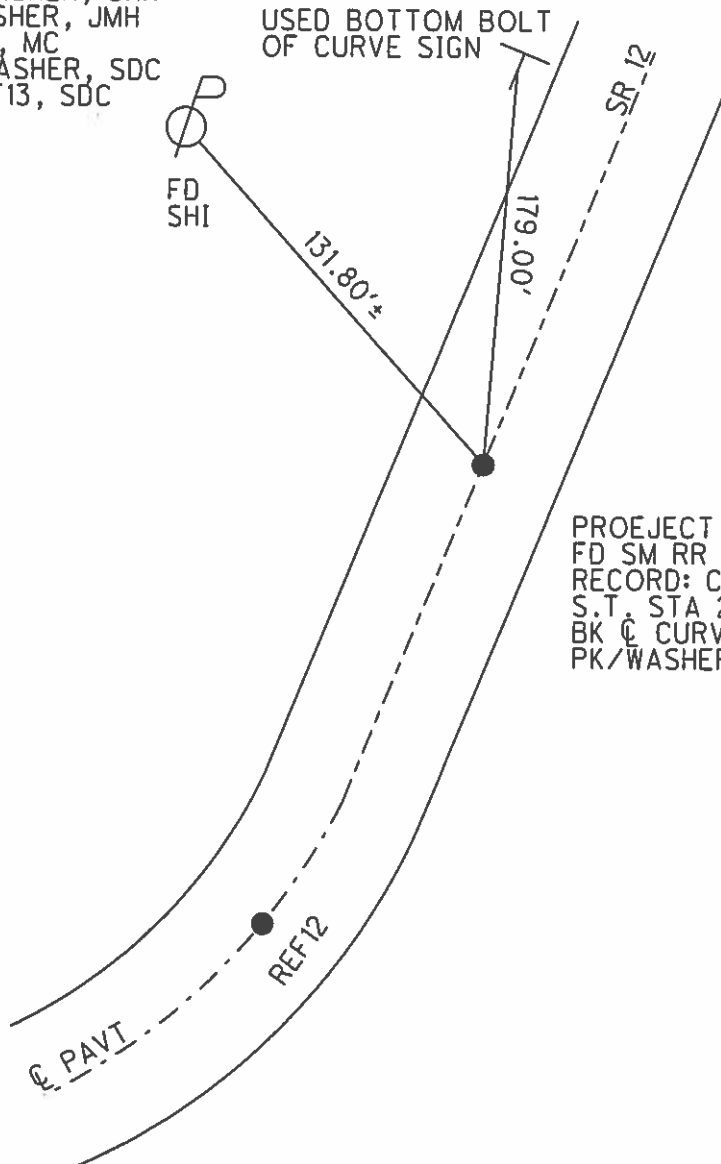

PROEJECT STA 281+73
 FD SM RR SPIKE 1 " DEEP
 RECORD: CRONIN - 1987
 S.T. STA 265+38.22
 BK \odot CURVEY = STA 265+58.85
 PK/WASHER ATOP MINE SPIKE

O.D.O.T. DISTRICT 2 SURVEY OFFICE

PERSONNEL

REFERENCE NO. 12E13

SHEET 10 OF 52

NOTES LOEHRKE

H.C. VAN DUSEN

R.C. ROUSOS

DATE 8-17-99

WEATHER FAIR

TEMP. +76°

ROUTE S.R. 12

COUNTY Seneca

TOWNSHIP Jackson

SECTION 27

T 3 N R 13 E


TYPE MONUMENT Sm R.R. Spike - P.K. WASHER

ON SURFACE - BELOW 1 1/2" - 2"


~~LEFT~~ - & PAV'T. - ~~RIGHT~~ Yes

±12 TO Lt EDGE PAVEMENT

S.L.M. 277+53 281+73

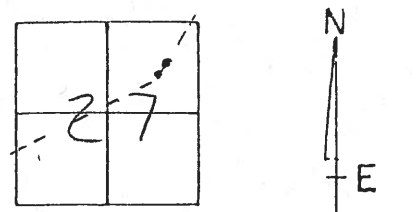

Set P.K./W's
both points
10-13-99
SAH

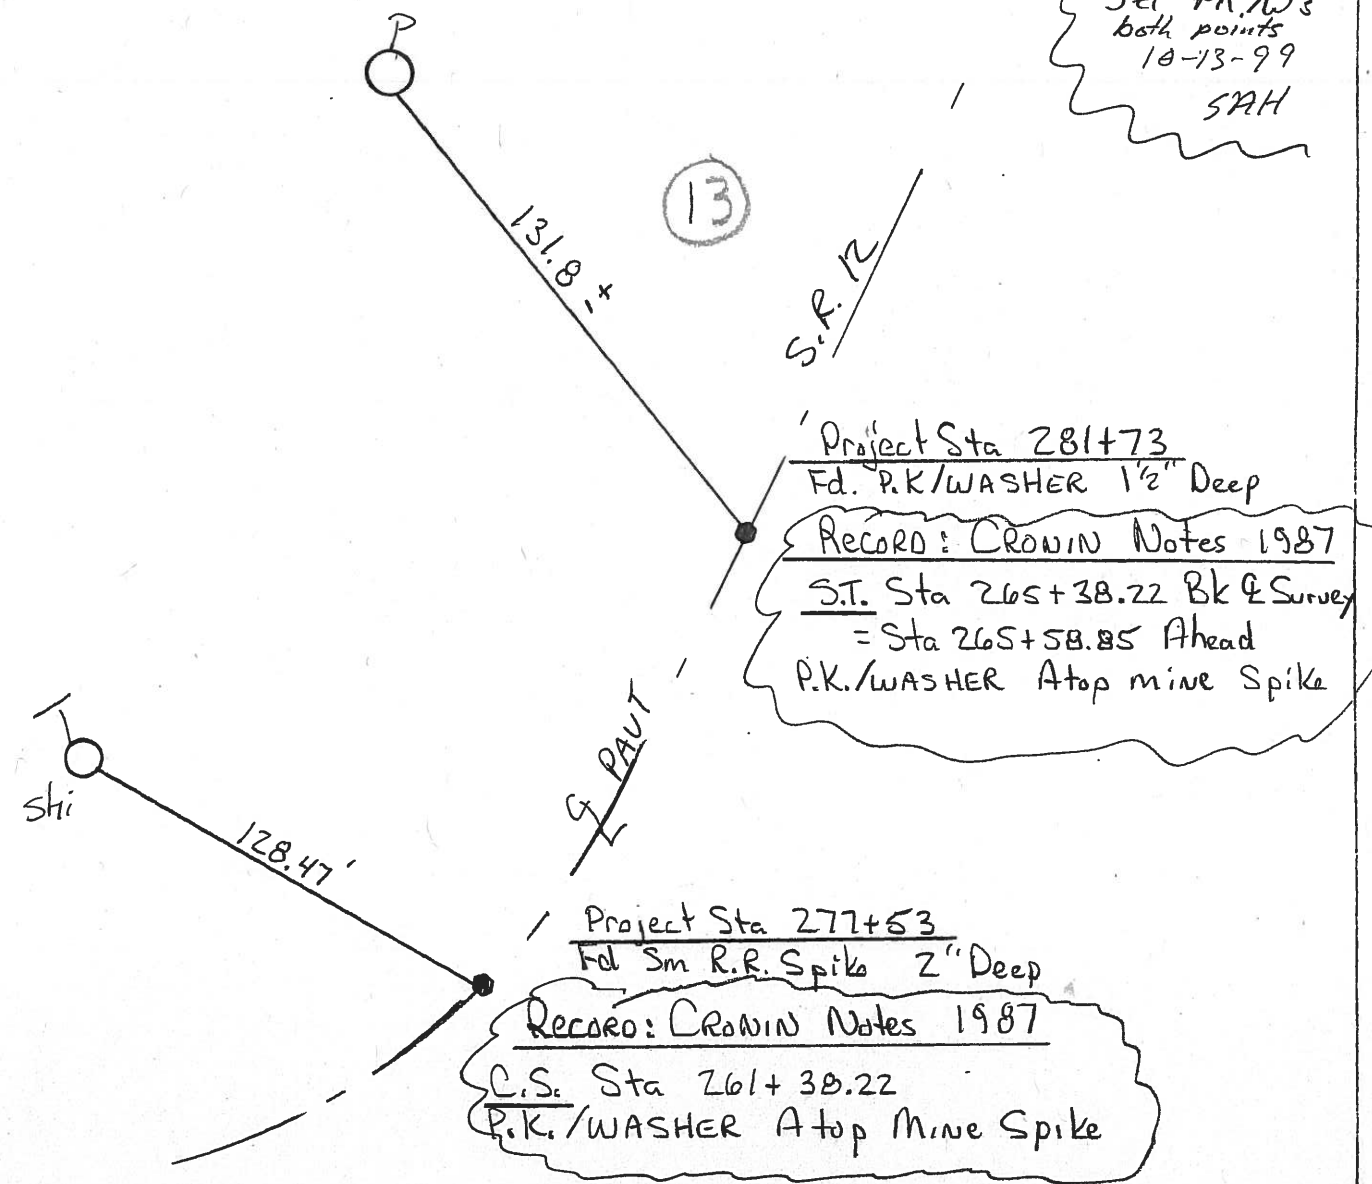

O.D.O.T. DISTRICT 2 SURVEY OFFICE

PERSONNEL

NOTES Cranin
 H.C. Ripple
 R.C. Geyman
Barbour


REFERENCE NO. 13

DRAWN 1/26/87
 DATE 5/06/87
 WEATHER sunny
 TEMP. 55°


SHEET 12 OF _____

ROUTE #12
 COUNTY Seneca
 TOWNSHIP Jackson
 SECTION 27
T 3 N R 13 E

TYPE MONUMENT P.K. & washer
 ON SURFACE - BELOW below surface
 LEFT - CL PAV'T. - RIGHT & Pav't.
 TO _____ EDGE PAVEMENT
 S.L.M. _____

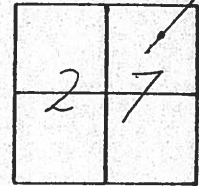

S.T.
265+38.22 Bl. & Survey =
265+58.85 Ahead
P.K. & washer atop mine spk.
below surface

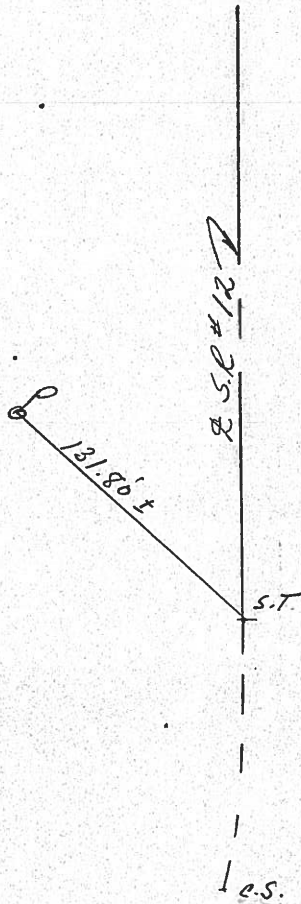

PERSONNEL _____ TITLE _____ PERSONNEL _____ TITLE _____
 COUNTY Seneca DATE 10-13-72
 S. R. 12 WEATHER Cool
 SEC. 27 Jackson Twp TEMP. 40°
 DESCRIPTION Fostoria to Sand Co. Line JOB NO. _____

