


O.D.O.T. DISTRICT 2 SURVEY OFFICE (USE ONLY)


PERSONNEL _____ REFERENCE NO. 22 SHEET 24 OF 70
 NOTES HUSS DATE 05-21-12 ROUTE SR 12
 H.C. HUSS WEATHER SUNNY COUNTY SENECA
 R.C. CANTERBURY TEMP. 82° TOWNSHIP JACKSON
 _____ SECTION 23
 _____ T 3 N R 13 E

TYPE MONUMENT _____ PK/WASHER _____
 ON SURFACE - BELOW _____ ON _____
 LEFT - Q PAV'T - RIGHT _____ ON _____
11.8' TO LT EDGE PAVEMENT
 S.L.M. _____ 354+41

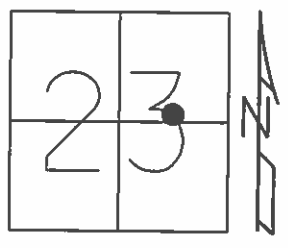

GRID: NORTHING: 561658.431 EASTING: 1740702.686

RECORD:
 T.S. 338+66.91
 PK/WASHER ATOP MINE SPK
 10-14-99 SET PK/WASHER. SAH
 06-04-12 GPS REF22
 10-22-12 SET MAG/WASHER, SDC
 11-14-12 GPS NEWREF22, SDC

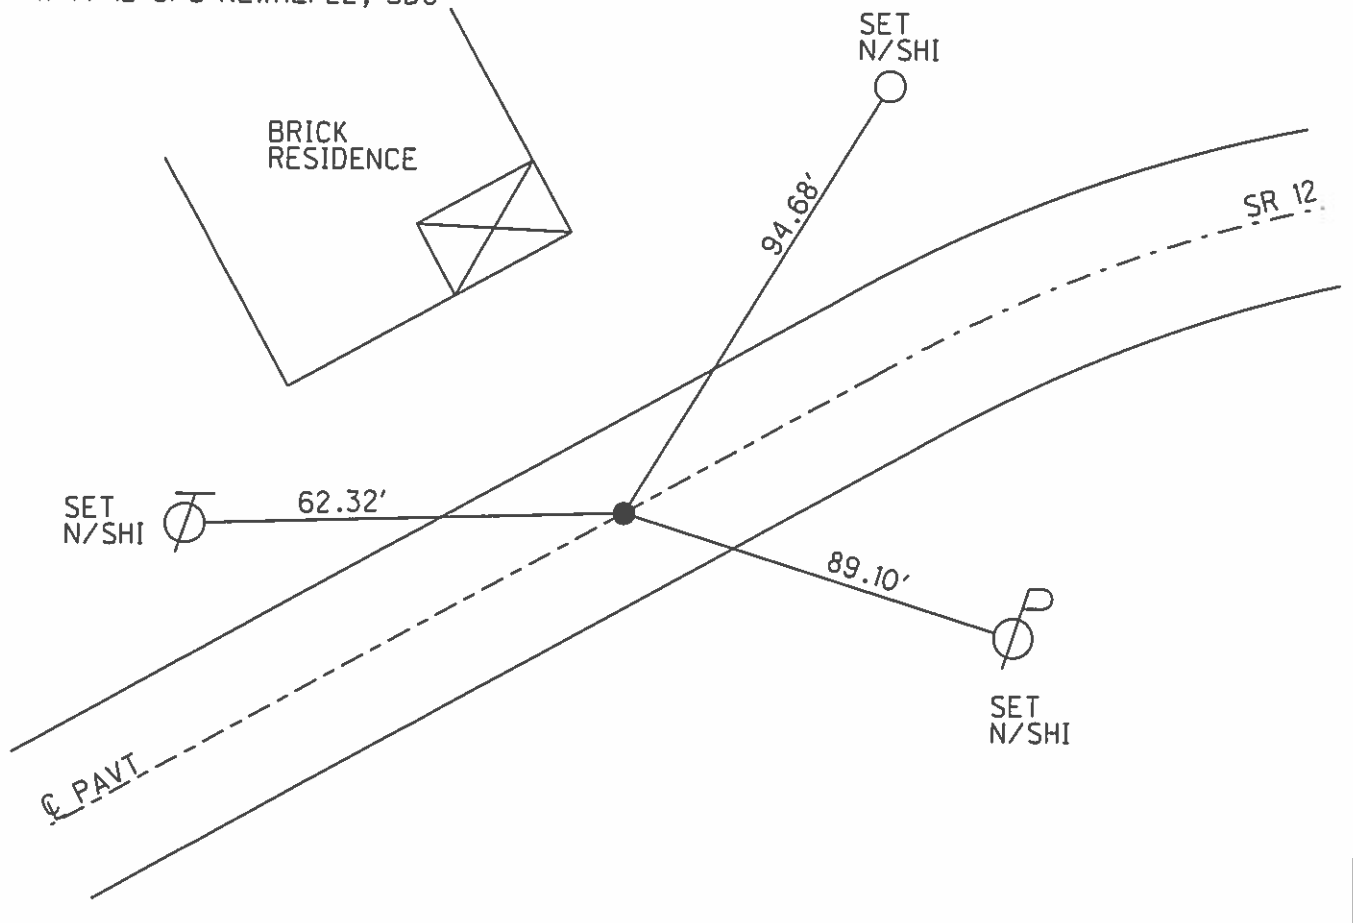

O.D.O.T. DISTRICT 2 SURVEY OFFICE

PERSONNEL _____

REFERENCE NO. 22

SHEET 17 OF 52

NOTES VanDusen

H.C. hochmke

R.C. Rousos

DATE 8-17-99

WEATHER Sunny

TEMP. +88°F

ROUTE 12

COUNTY Seneca

TOWNSHIP Jackson

SECTION 23

T 3 N R 13 E


TYPE MONUMENT PK/w

ON SURFACE - ~~WINDOW~~ Surface

~~MARK~~ - PAV'T - ~~MARK~~ & Pav.

11.8 TO Lt. EDGE PAVEMENT


S.L.M. 354+41

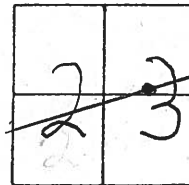

Record:

T.S. 338+66.91
PK/w atop Misc Spt.

Set PK/w
10-14-99
SAH

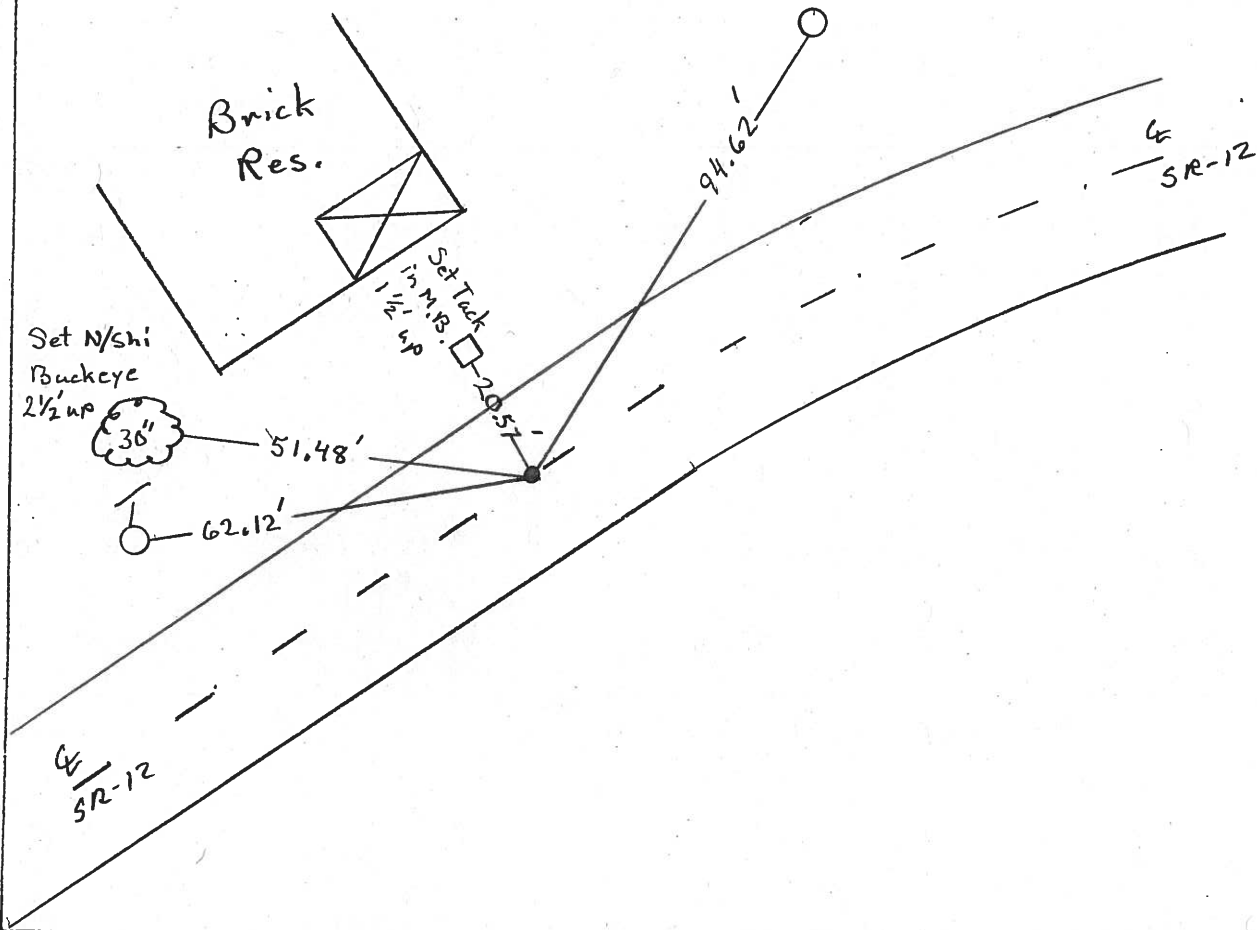

O.D.O.T. DISTRICT 2 SURVEY OFFICE

PERSONNEL _____

REFERENCE NO. 22

SHEET 21 OF _____

NOTES Cronin

DRAWN 2-01-87
1-29-87

H.C. RIPPLE

DATE 5-06-87

R.C. BARBOUR

WEATHER SUNNY

GEYMAN

TEMP. 58°

ROUTE # 12

COUNTY Seneca

TOWNSHIP Jackson

SECTION 23

T 3 N R 13 E



TYPE MONUMENT P.K. & washer

ON SURFACE - BELOW on surface

LEFT - to PAV'T. - RIGHT to Pav't.

TO _____ EDGE PAVEMENT


S.L.M. _____

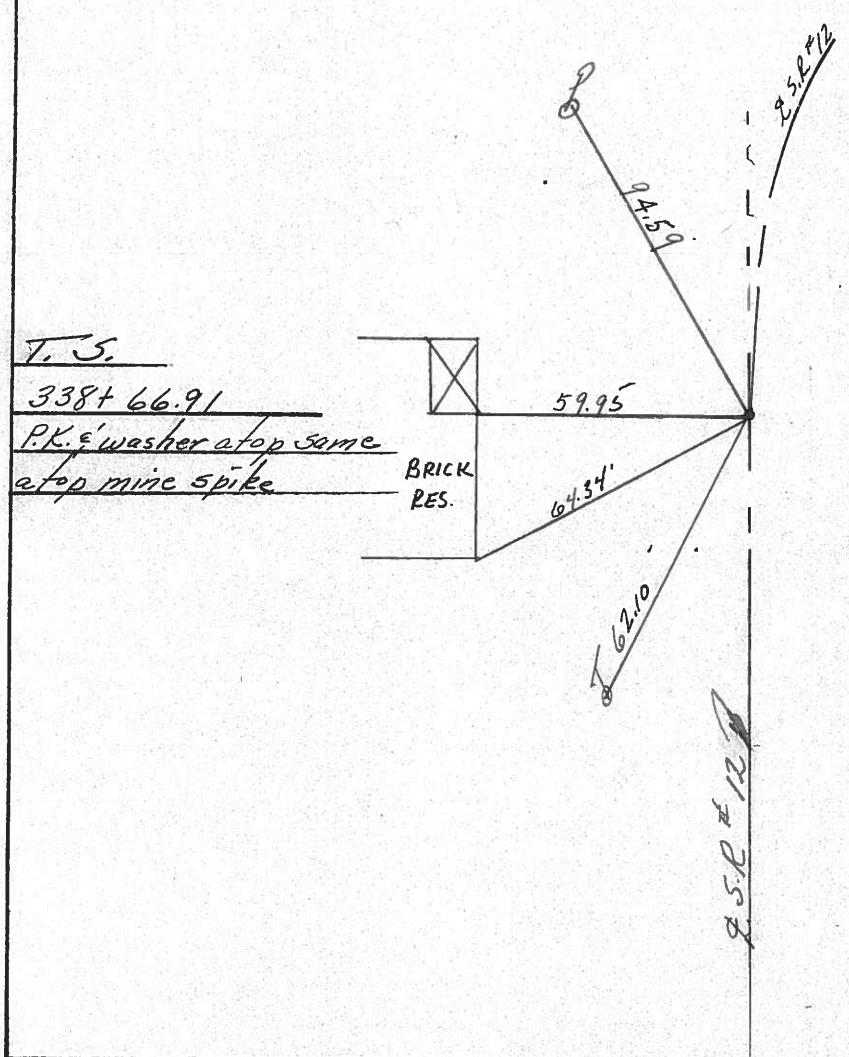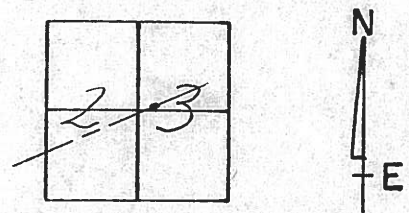

PERSONNEL	TITLE	PERSONNEL	TITLE
		COUNTY	<u>Seneca</u>
		DATE	<u>10-17-72</u>
		S. R.	<u>12</u>
		WEATHER	<u>Fair</u>
		SEC.	<u>23 Jackson Twp.</u>
		TEMP.	<u>50°</u>
DESCRIPTION	<u>Fostoria to Sandusky Co. Line</u>		
	LEFT	CENTER LINE	RIGHT
			JOB NO.

S.C.
342+66.91
small R.R. spk.

23

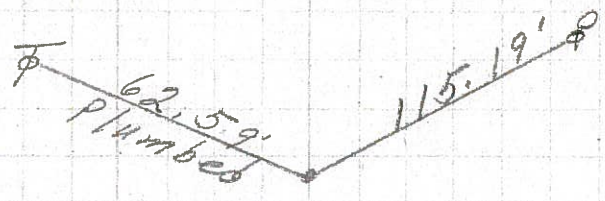


T.S.
338+66.91
small R.R. spk.

22


Top at water table

322+52.82
Sec Lines

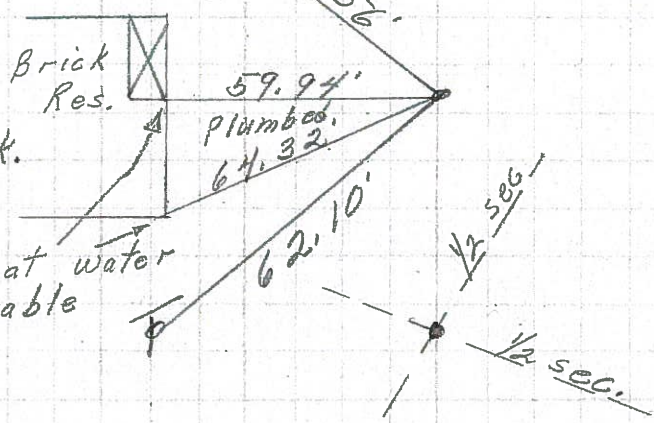

P.I.
315+95.12
Fd. small
R.R. spk.
on & R/W
 $\Delta = 0^{\circ}04' RT.$

21

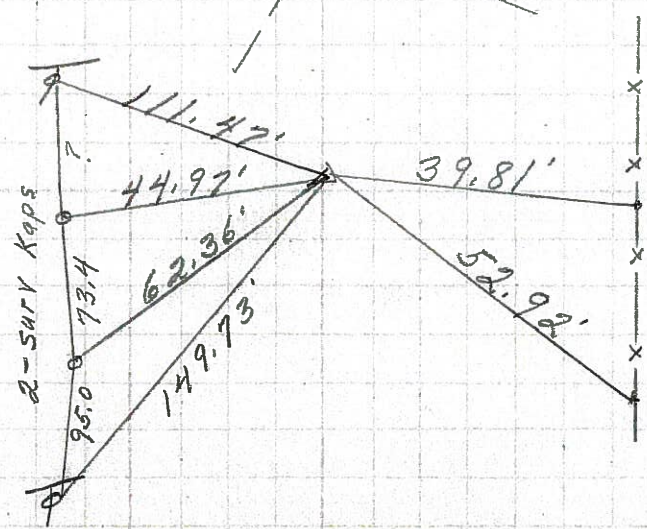

Loose steel fence posts

