



O.D.O.T. DISTRICT 2 SURVEY OFFICE (USE ONLY)

PERSONNEL	REFERENCE NO.	<u>23</u>	SHEET	<u>25</u>	OF	<u>70</u>
NOTES	<u>HUSS</u>	DATE	<u>05-21-12</u>	ROUTE	<u>SR 12</u>	
H.C.	<u>HUSS</u>	WEATHER	<u>FAIR</u>	COUNTY	<u>SENECA</u>	
R.C.	<u>CANTERBURY</u>	TEMP.	<u>82°</u>	TOWNSHIP	<u>JACKSON</u>	
				SECTION	<u>23</u>	
				T	<u>3</u>	N
				R	<u>13</u>	E

TYPE MONUMENT \_\_\_\_\_ PK/WASHER \_\_\_\_\_  
 ON SURFACE - BELOW \_\_\_\_\_ ON \_\_\_\_\_  
 LEFT -  $\phi$  PAV'T - RIGHT \_\_\_\_\_ 0.4' \_\_\_\_\_  
12.2' TO LT EDGE PAVEMENT  
 S.L.M. \_\_\_\_\_ 358+40 \_\_\_\_\_  
 GRID: NORTHING: 561822.748 EASTING: 1741067.242

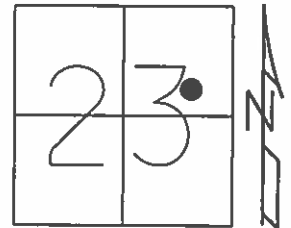

RECORD:  
 SC - 342+66.91  
 10-14-99 SET PK/WASHER, SAH  
 06-04-12 GPS REF23  
 11-14-12 SET MAG/WASHER, SDC  
 11-14-12 GPS NEWREF23, SDC

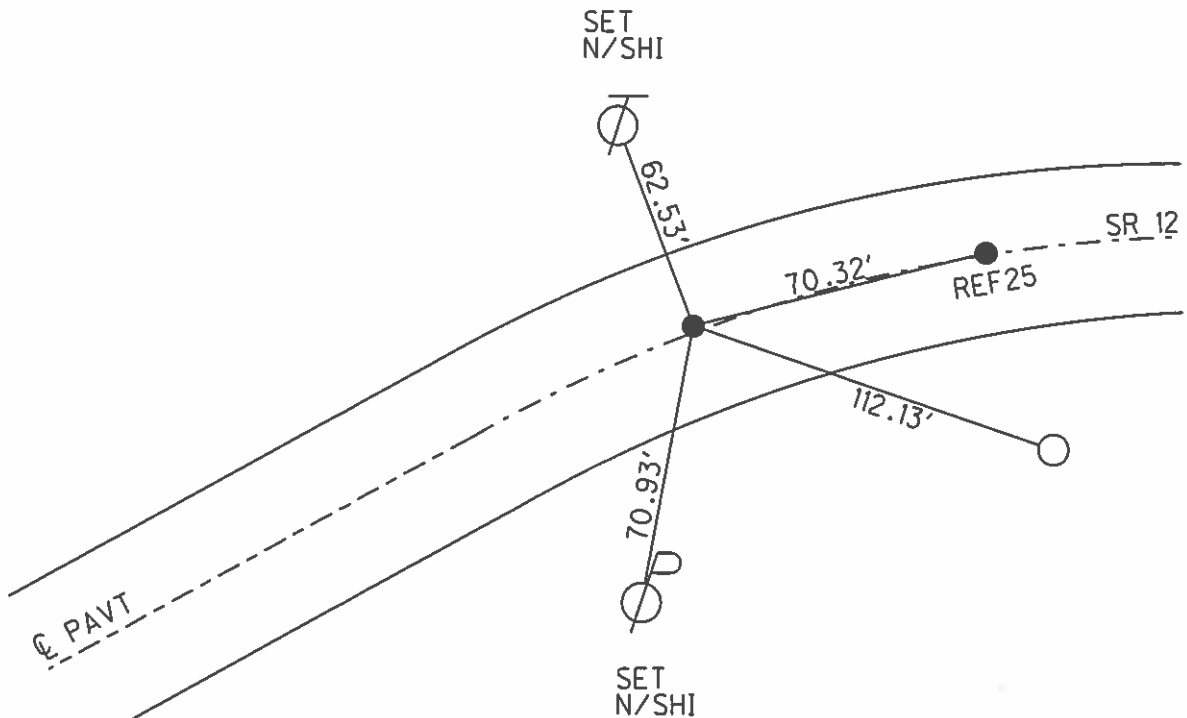

O.D.O.T. DISTRICT 2 SURVEY OFFICE

PERSONNEL

REFERENCE NO. 23

SHEET 18 OF 52

NOTES Canterbury

H.C. Rousos

R.C. Barnhisel

DATE 8-20-99

WEATHER Fair

TEMP. +85°

ROUTE 12

COUNTY Seneca

TOWNSHIP Jackson

SECTION 23

T3 N R 13 E


TYPE MONUMENT PK/w

ON SURFACE - ~~BELOW~~ Surface

LEFT - & PAV'T. - ~~RIGHT~~ .2 Lt &


12.2' TO Lt. EDGE PAVEMENT

S.L.M. 358+40

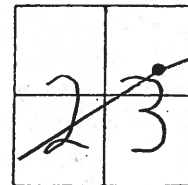

Record:  
SC - 342+66.91

Set PK/w  
10-14-99  
SAH

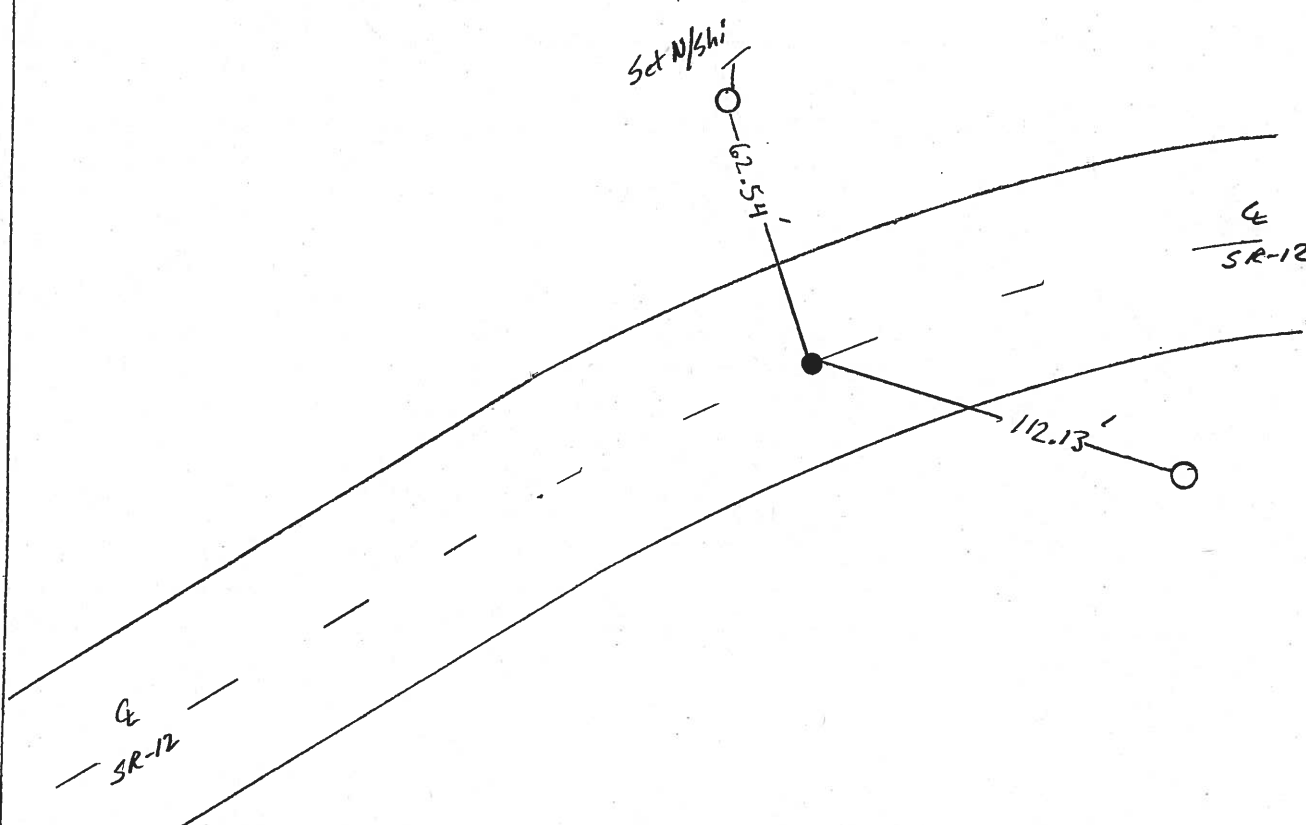

# O.D.O.T. DISTRICT 2 SURVEY OFFICE




PERSONNEL

NOTES Cronin  
 H.C. Ripple  
 R.C. Barbour  
Geyman

REFERENCE NO. 23  
 DRAWN - 2/01/90  
 DATE 1/29/87  
 WEATHER SUNNY  
 TEMP. 58°

SHEET 22 OF \_\_\_\_\_  
 ROUTE # 12  
 COUNTY Seneca  
 TOWNSHIP Jackson  
 SECTION 23  
T 3 N R 13 E

TYPE MONUMENT MINE SPIKE  
 ON SURFACE - BELOW 1 1/2" ±  
 LEFT - CL PAV'T. - RIGHT \_\_\_\_\_  
 \_\_\_\_\_ TO \_\_\_\_\_ EDGE PAVEMENT  
 S.L.M. \_\_\_\_\_

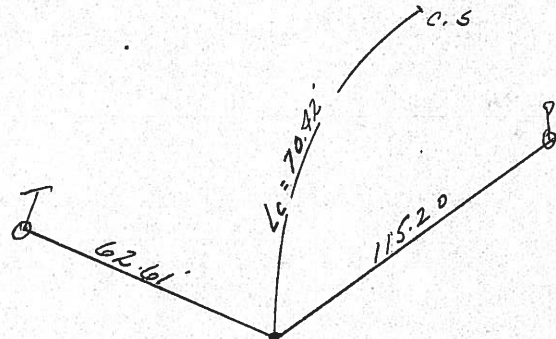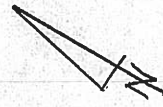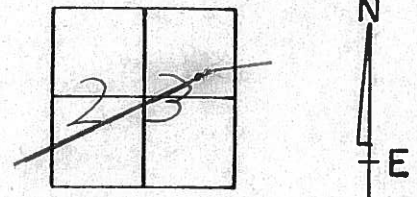

S.C.  
342+66.91

PERSONNEL TITLE PERSONNEL TITLE

COUNTY Seneca DATE 10-17-72

S. R. 12 WEATHER Fair


SEC. 23 Jackson Twp. TEMP. 50°

DESCRIPTION Fostoria to Sandusky Co. Line JOB NO.

LEFT CENTER LINE RIGHT

S.C.  
342+66.91  
small R.R. spk.

23

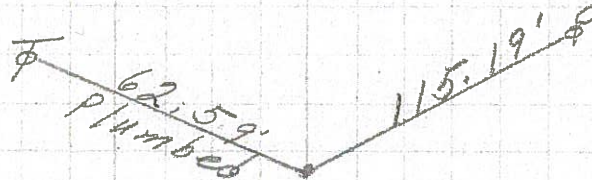


T.S.  
338+66.91  
small R.R. spk.

22


Top at water table

322+52.82  
Sec Lines

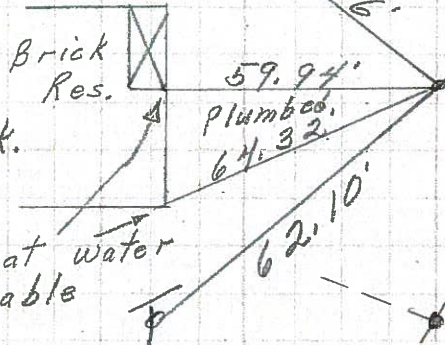

P.I.  
315+95.12  
Fd. small  
R.R. spk.  
on & R/W  
 $\Delta = 0^{\circ}04' Rt.$

21

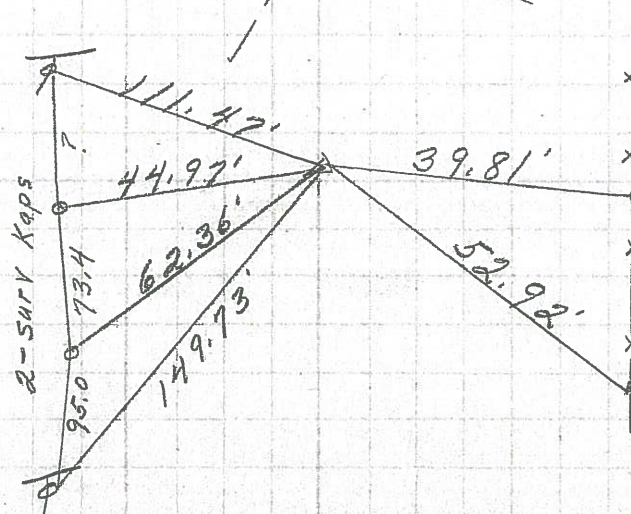

Loose steel fence posts