


O.D.O.T. DISTRICT 2 SURVEY OFFICE (USE ONLY)

PERSONNEL	REFERENCE NO.	<u>44</u>	SHEET	<u>45</u>	OF	<u>70</u>
NOTES	<u>HARBAUGH</u>	DATE	<u>05-30-12</u>	ROUTE	<u>SR 12</u>	
H.C.	<u>CANTERBURY</u>	WEATHER	<u>CLEAR</u>	COUNTY	<u>SENECA</u>	
R.C.	<u>COUCHER</u>	TEMP.	<u>58°</u>	TOWNSHIP	<u>JACKSON</u>	
				SECTION	<u>24</u>	
				T	<u>3</u>	N
				R	<u>13</u>	E


TYPE MONUMENT _____ MAG _____
 ON SURFACE - BELOW _____ ON _____
 LEFT - Q PAV'T - RIGHT _____ 1.0' _____
9.5' TO RT EDGE PAVEMENT
 S.L.M. _____ 407+41 _____

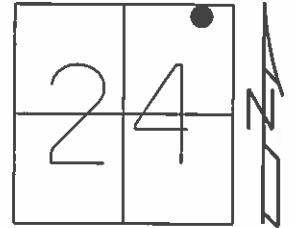

GRID: NORTHING: 563109.974 EASTING: 1745755.538

RECORD:
 C.S. SURVEY
 STA 391+52.58


- 11-10-99 SET PK/WASHER, SAH
- 05-30-12 FD SHANK
- 06-05-12 RESET MAG
- 06-05-12 GPS REF44
- 11-13-12 SET MAG/WASHER, SDC
- 11-13-12 GPS NEWREF44, SDC

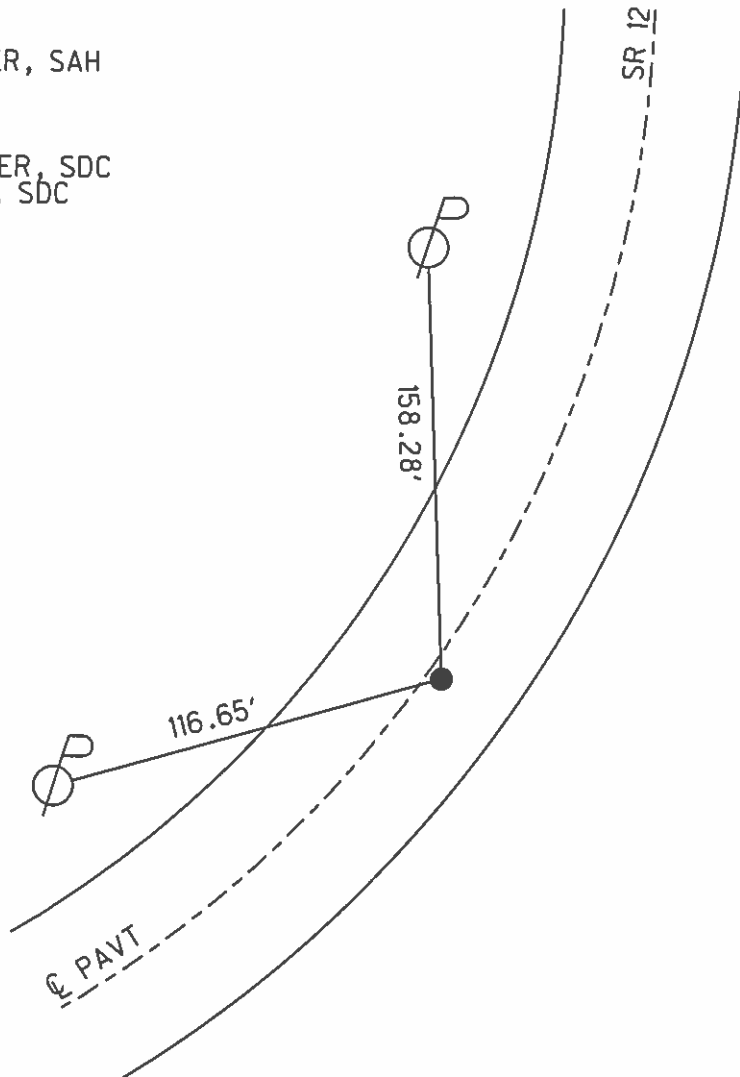

O.D.O.T. DISTRICT 2 SURVEY OFFICE


PERSONNEL _____ REFERENCE NO. 44 SHEET 37 OF 52
NOTES LOEHRKE
H.C. ROUSOS DATE 8-19-99 ROUTE S.R. 12
R.C. LOEHRKE WEATHER OVERCAST COUNTY Seneca
_____ TEMP. 72° TOWNSHIP Jackson
_____ SECTION 24
_____ T 3 N R 13 E

TYPE MONUMENT P.K./WASHER
ON SURFACE - ~~BELOW~~ Yes
~~LEFT~~ - C. PAV'T. - RIGHT 1.0' Rt.
11.2' TO Rt EDGE PAVEMENT
S.L.M. 407+41

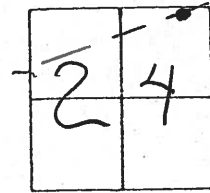

Record
C.S. Survey
Sta 391+52.5B

Set PK/W
11-10-99
SAH

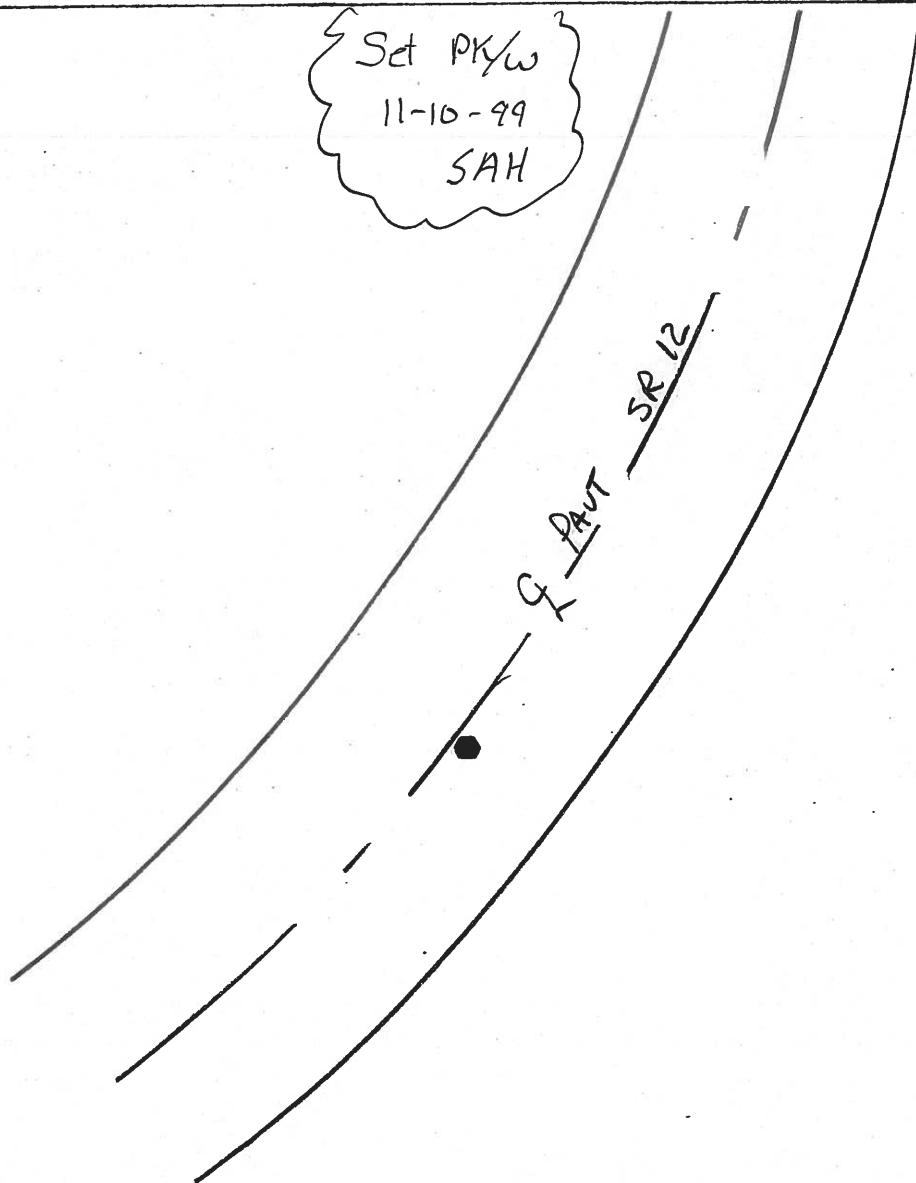

O.D.O.T. DISTRICT 2 SURVEY OFFICE

PERSONNEL

NOTES Cronin
H.C. Ripple
R.C. Barbour
Geyman

REFERENCE NO. 44

DRAWN 2/05/90

DATE 2/01/90

WEATHER overcast-windy

TEMP. 42°

SHEET 38 OF _____

ROUTE #12

COUNTY Seneca

TOWNSHIP Jackson

SECTION 24

T 3 N R 13 E



TYPE MONUMENT Mine spike

ON SURFACE - BELOW 1 1/2" ±


LEFT - ☉ PAV'T. - RIGHT _____

TO _____ EDGE PAVEMENT

S.L.M. _____

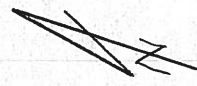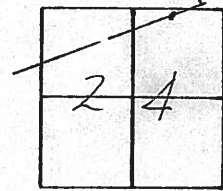

notes

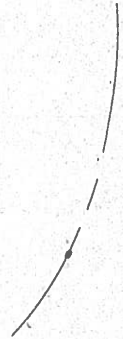

C.S. Survey
3914 52.58

PERSONNEL	TITLE	PERSONNEL	TITLE
COUNTY		DATE	
<u>Seneca</u>		<u>11-9-72</u>	
S. R.		WEATHER	
<u>12</u>		<u>cloudy</u>	
SEC		TEMP.	
<u>24 Jackson Twp</u>		<u>40°</u>	
DESCRIPTION <u>Fostoria to Sandusky Co. Line</u>			JOB NO.

C.S.
 391+52.58
 E SURVEY
 Small R.R. spk

44

P.I.
 391+02.43
 $\Delta = 20^{\circ}17' Lt.$
 1" iron pin

43

S.C.
 390+49.50
 E SURVEY
 small R.R. spk.

42

