

PRIORITY NO. _____ PART 3 OF 6 SHEET _____ OF _____

COUNTY SENECA ROUTE SR 18 SECTION 1.31

BEGIN LOG (SLM) 1.31 TERMINII US 23

END LOG (SLM) 1.55 TERMINII Columbus Ave. (Batt. @ prev. project)

TOTAL LENGTH 0.24 MILES

MUNICIPALITY Fosteria BEGIN LOG (SLM) 1.31 END LOG (SLM) 1.55

MUNICIPALITY _____ BEGIN LOG (SLM) _____ END LOG (SLM) _____

PROPOSED WORK:

PAVEMENT _____ SHOULDER _____

OTHER _____

EXISTING DATA:

SLM 1.31 TO 1.55; PAV'T WIDTH 2@28 (type 404), SHLD WIDTH _____ (type _____)

SLM _____ TO _____; PAV'T WIDTH _____ (type _____), SHLD WIDTH _____ (type _____)

SLM _____ TO _____; PAV'T WIDTH _____ (type _____), SHLD WIDTH _____ (type _____)

STRUCTURES:

STR. NO. _____, WIDTH _____, LENGTH _____, PROP. WORK _____

STR. NO. _____, WIDTH _____, LENGTH _____, PROP. WORK _____

RAILROAD CROSSING:

NAME _____ STATION _____ NO. TRACKS _____ LENGTH ALONG C L _____ ft (no work)

NAME _____ STATION _____ NO. TRACKS _____ LENGTH ALONG C L _____ ft

NAME _____ STATION _____ NO. TRACKS _____ LENGTH ALONG C L _____ ft

MISCELLANEOUS:

NO. RAISED PAVEMENT MARKERS; EDGE OF PAVEMENT _____, CENTERLINE _____


NO. MAILBOX APPROACHES _____, AVERAGE AREA _____

REMARKS: conc curb both sides

PERSONNEL	TITLE	PERSONNEL	TITLE
<u>Cronin</u>			
<u>Ripple</u>			
<u>Geymer</u>			
<u>Barbour</u>			

COUNTY SenecaDATE 4/28/87S. R. #18WEATHER sunny - windySEC. 1.31 - 1.55TEMP. 45°DESCRIPTION Pavement Areas (Extra)

JOB NO. _____

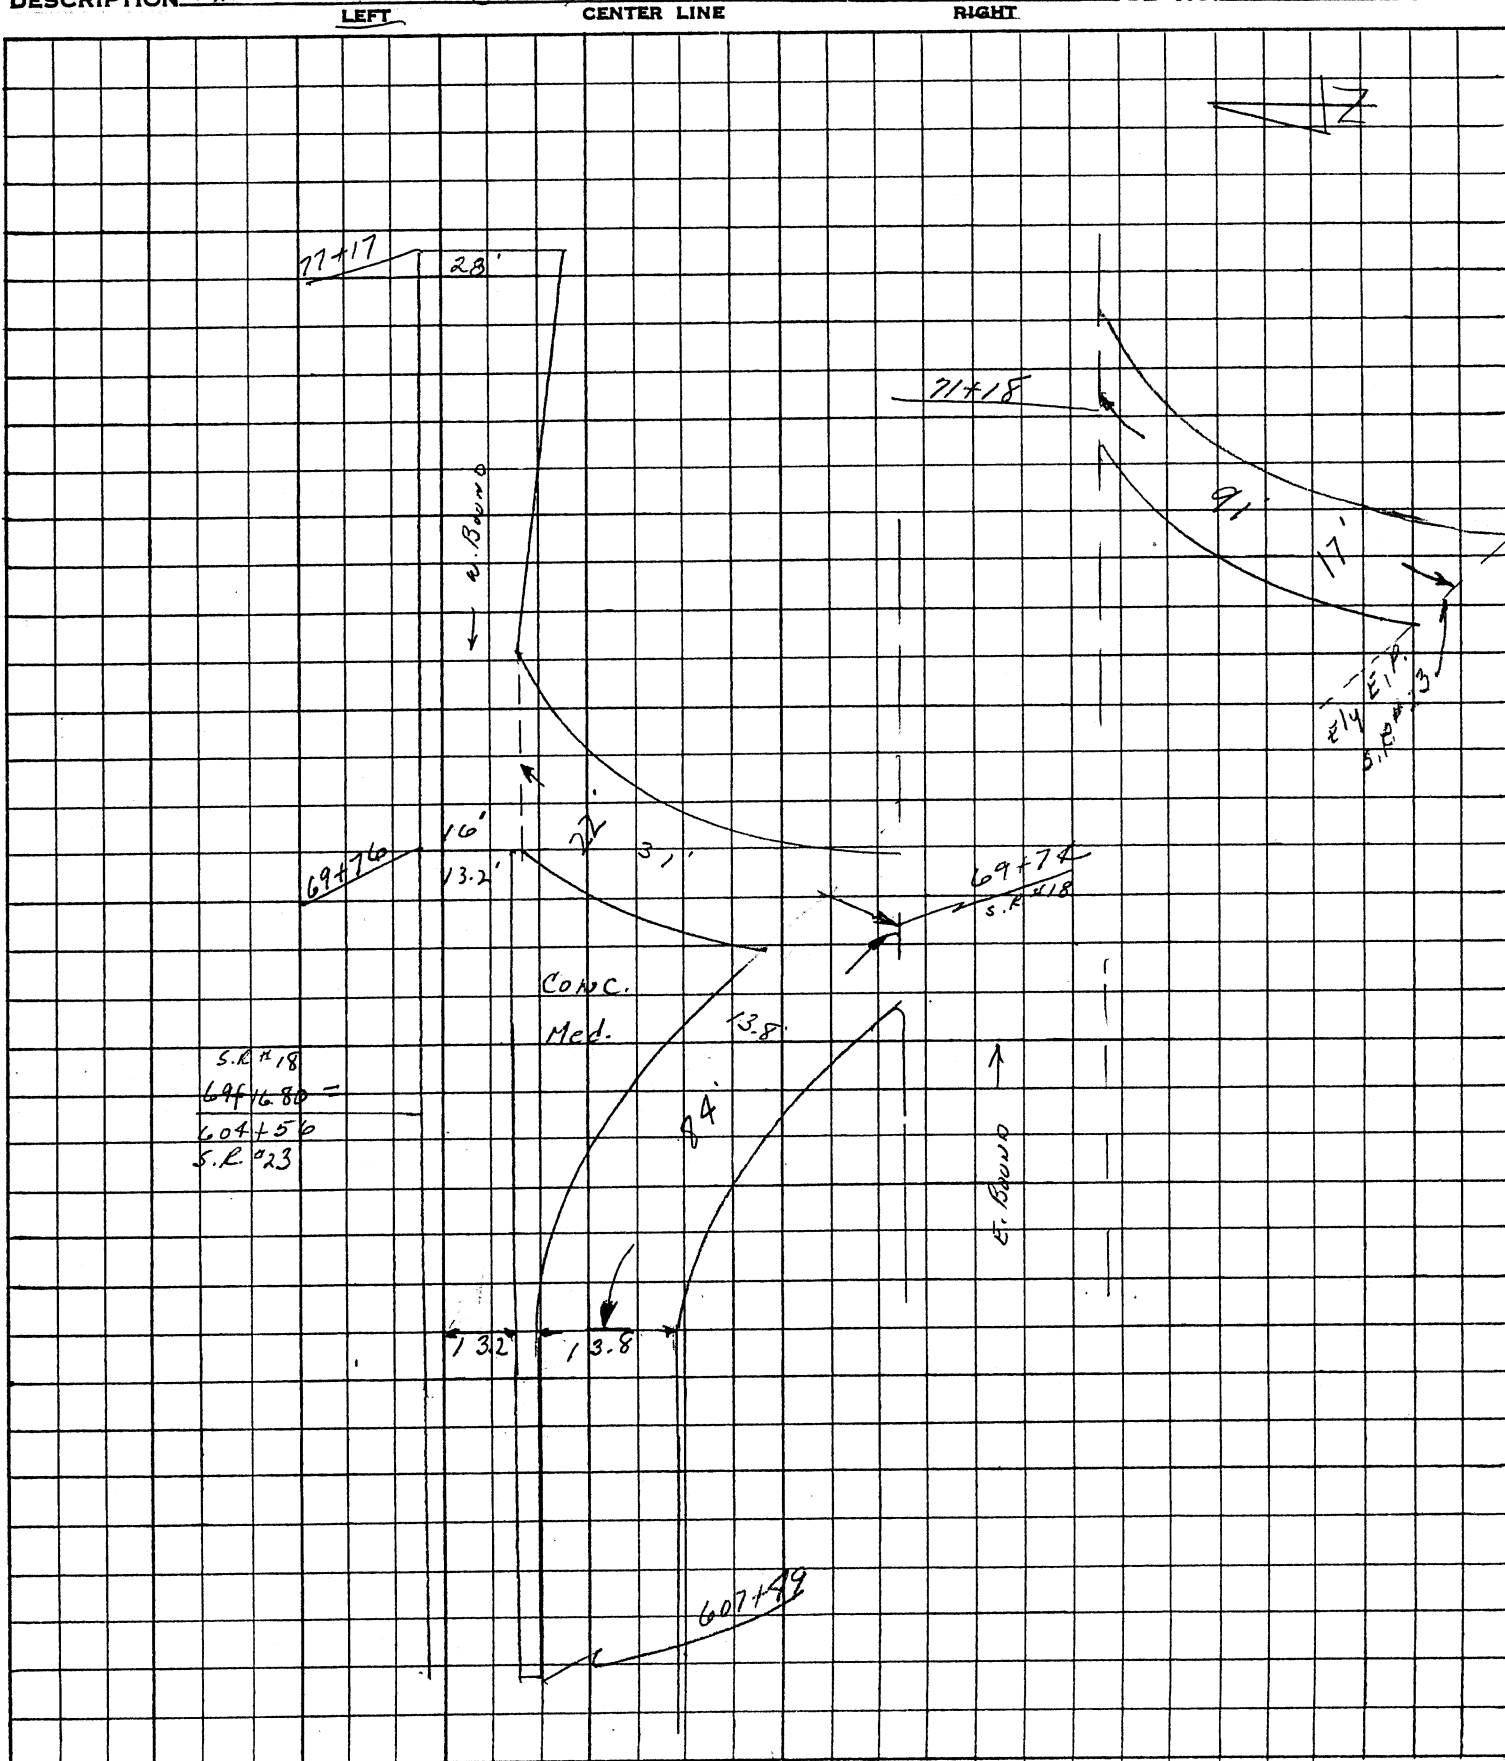


PERSONNEL	TITLE	PERSONNEL	TITLE
Cranin			
Ripple			
Geyman			
Barbour			

COUNTY Seneca DATE 4/23/87

S. R. 418 WEATHER Sunny-windy

SEC. 1.31 - 1.55 TEMP. 45°

DESCRIPTION	LEFT	CENTER LINE	RIGHT	JOB NO.
Extra Pavement Areas				

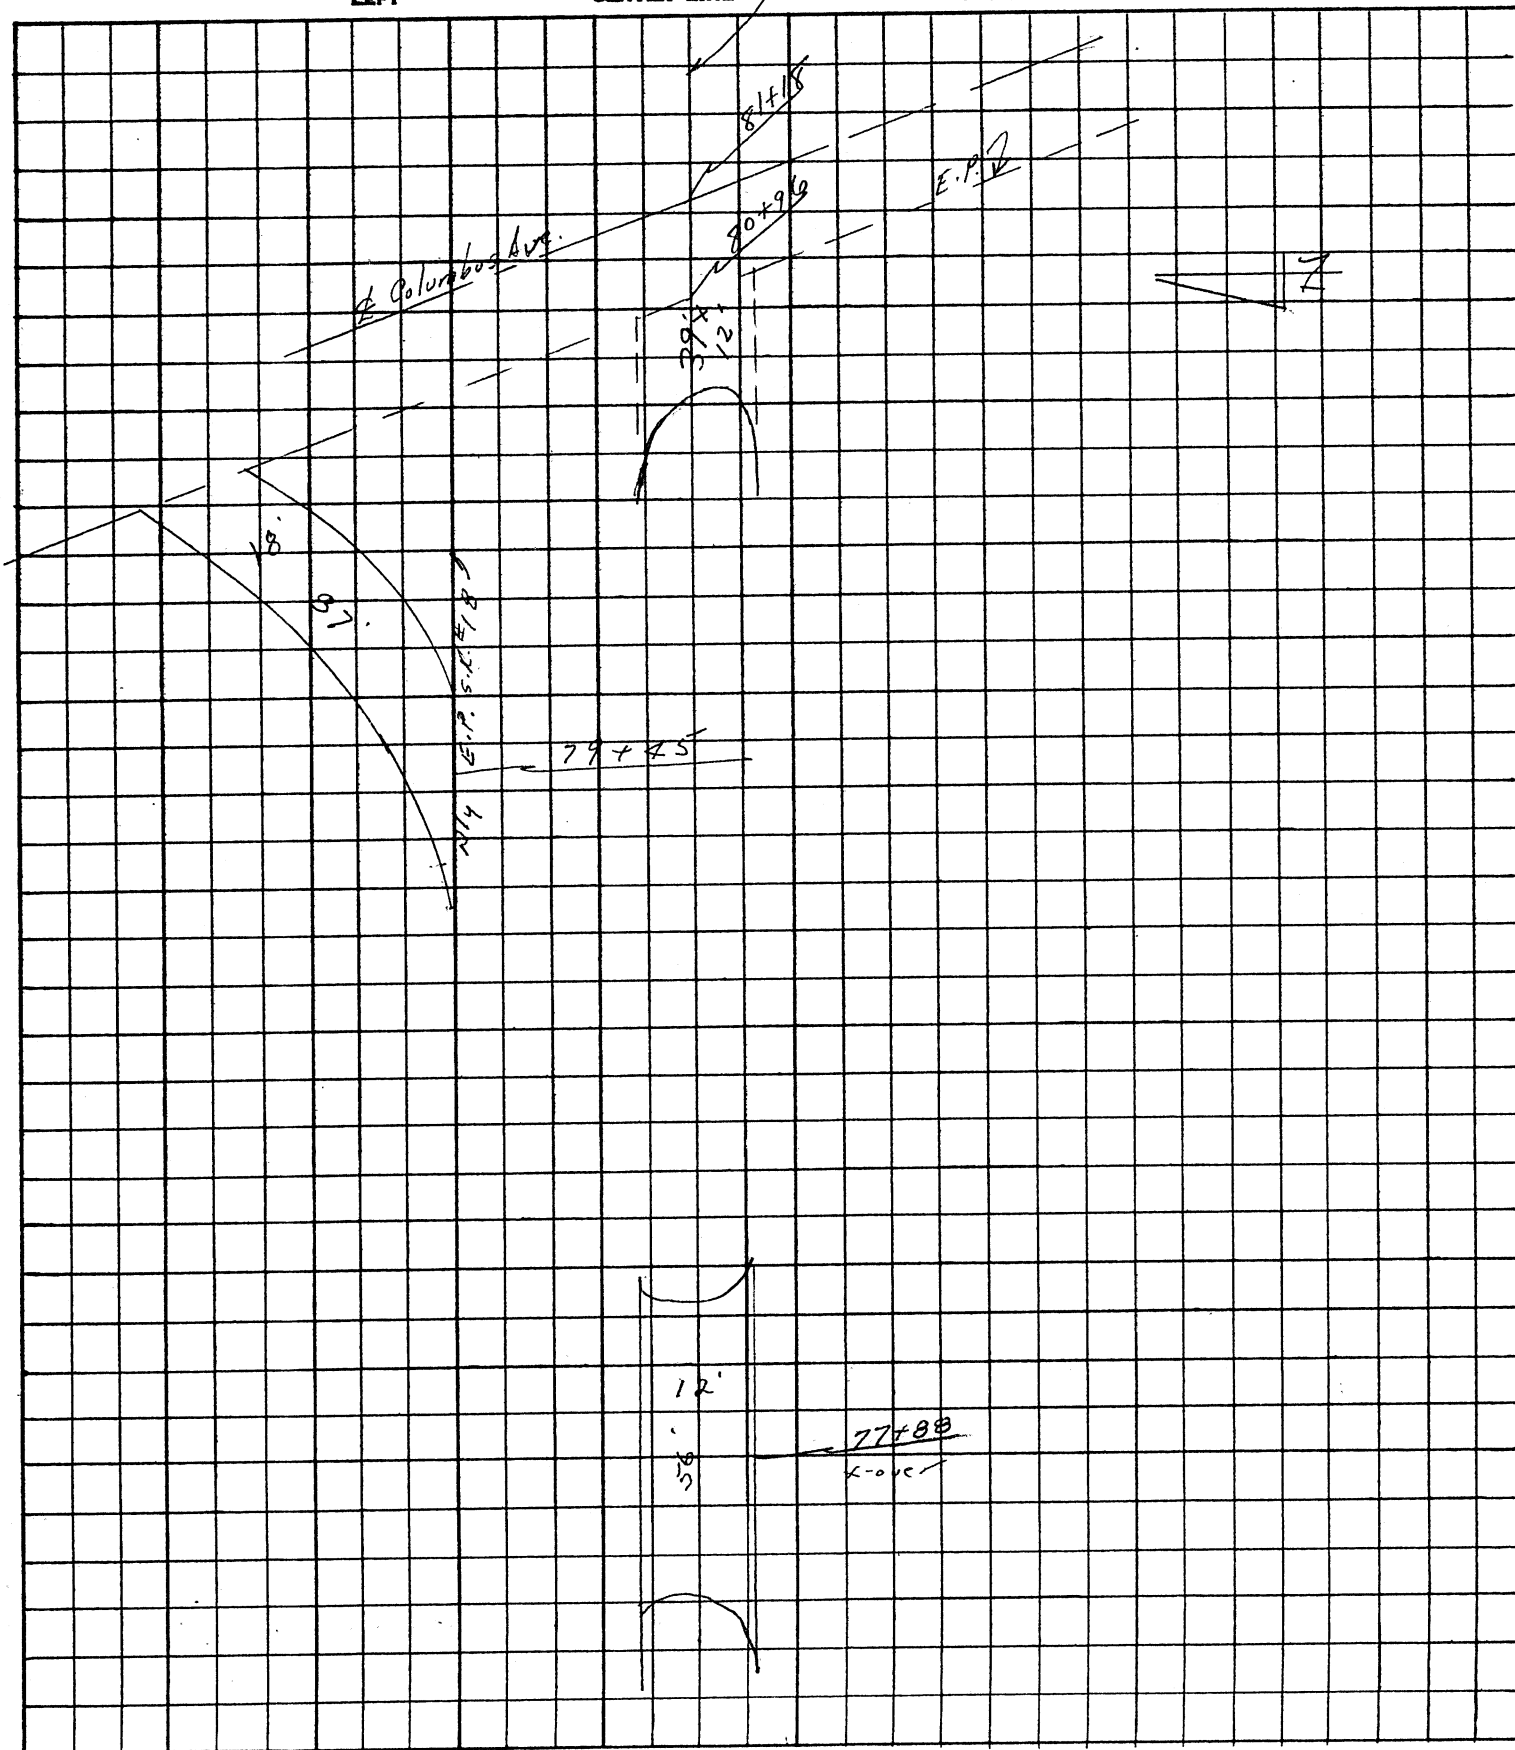

SECTION 1.51 - 1.55

STATION	OUT Rt/Lt	CATCH BASIN	MAN- HOLE	INLET	W V BOX	MON BOX	CASTING		REMARKS
							R	F	
70+91	Det curb	✓ #1					✓		
71+84	Det curb E. Bound	✓ #1					✓		
71+84	Det curb E. Bound	✓ #1					✓		
71+84	Det curb W. Bound	✓ #1					✓		
71+84	Det curb W. Bound	✓ #2					✓		Found inlet used as Gut type
74+10	Det curb E. Bound	✓ #1					✓		
+10	Det curb E. Bound	✓ #1					✓		
+10	Det curb W. Bound	✓ #1					✓		
+10	Det curb W. Bound	✓ #1					✓		
76+49	Det curb E. Bound	✓ #1					✓		
76+49	Det curb E. Bound	✓ #1					✓		
76+49	Det curb W. Bound	✓ #1					✓		
76+49	Det curb W. Bound	✓ #1					✓		
77+69	Det curb E. Bound	✓ #1					✓		
79+69	Det curb W. Bound	✓ #1					✓		

 $77 + 17$

s^{+2} , 71+18