

stamped
July 1997

SEC. 35 ADAMS TWP T3N R16E


FED. RD. DIVISION	STATE	PROJECT
2	OHIO	

R/W PLAN
SEN. 18-(26.67)

SUMMARY OF ADDITIONAL R/W REQUIRED

Parcel No.	Owner	Area	EXIST. Blkgs.	Sheet No.
1	Melvin Eugene & Carrie L. Hayward	0.228		
1-TS	" " " " " "	0.041		
2	Otto K. & Ferne Hensinger Rev 5-15-60 FG	0.071		
2-SL	" " " " " "	0.028		
3	Curtis L. & Margaret L. Oakleaf	0.038		
4	Forest Sanders	0.033	Yes	
4-TS	" " " " " "	0.021		
5	Curtis L. & Margaret L. Oakleaf	0.034		
5-WA	" " " " " "	0.011		
5-TS	" " " " " "	0.045		

MELVIN EUGENE & CARRIE L. HAYWARD

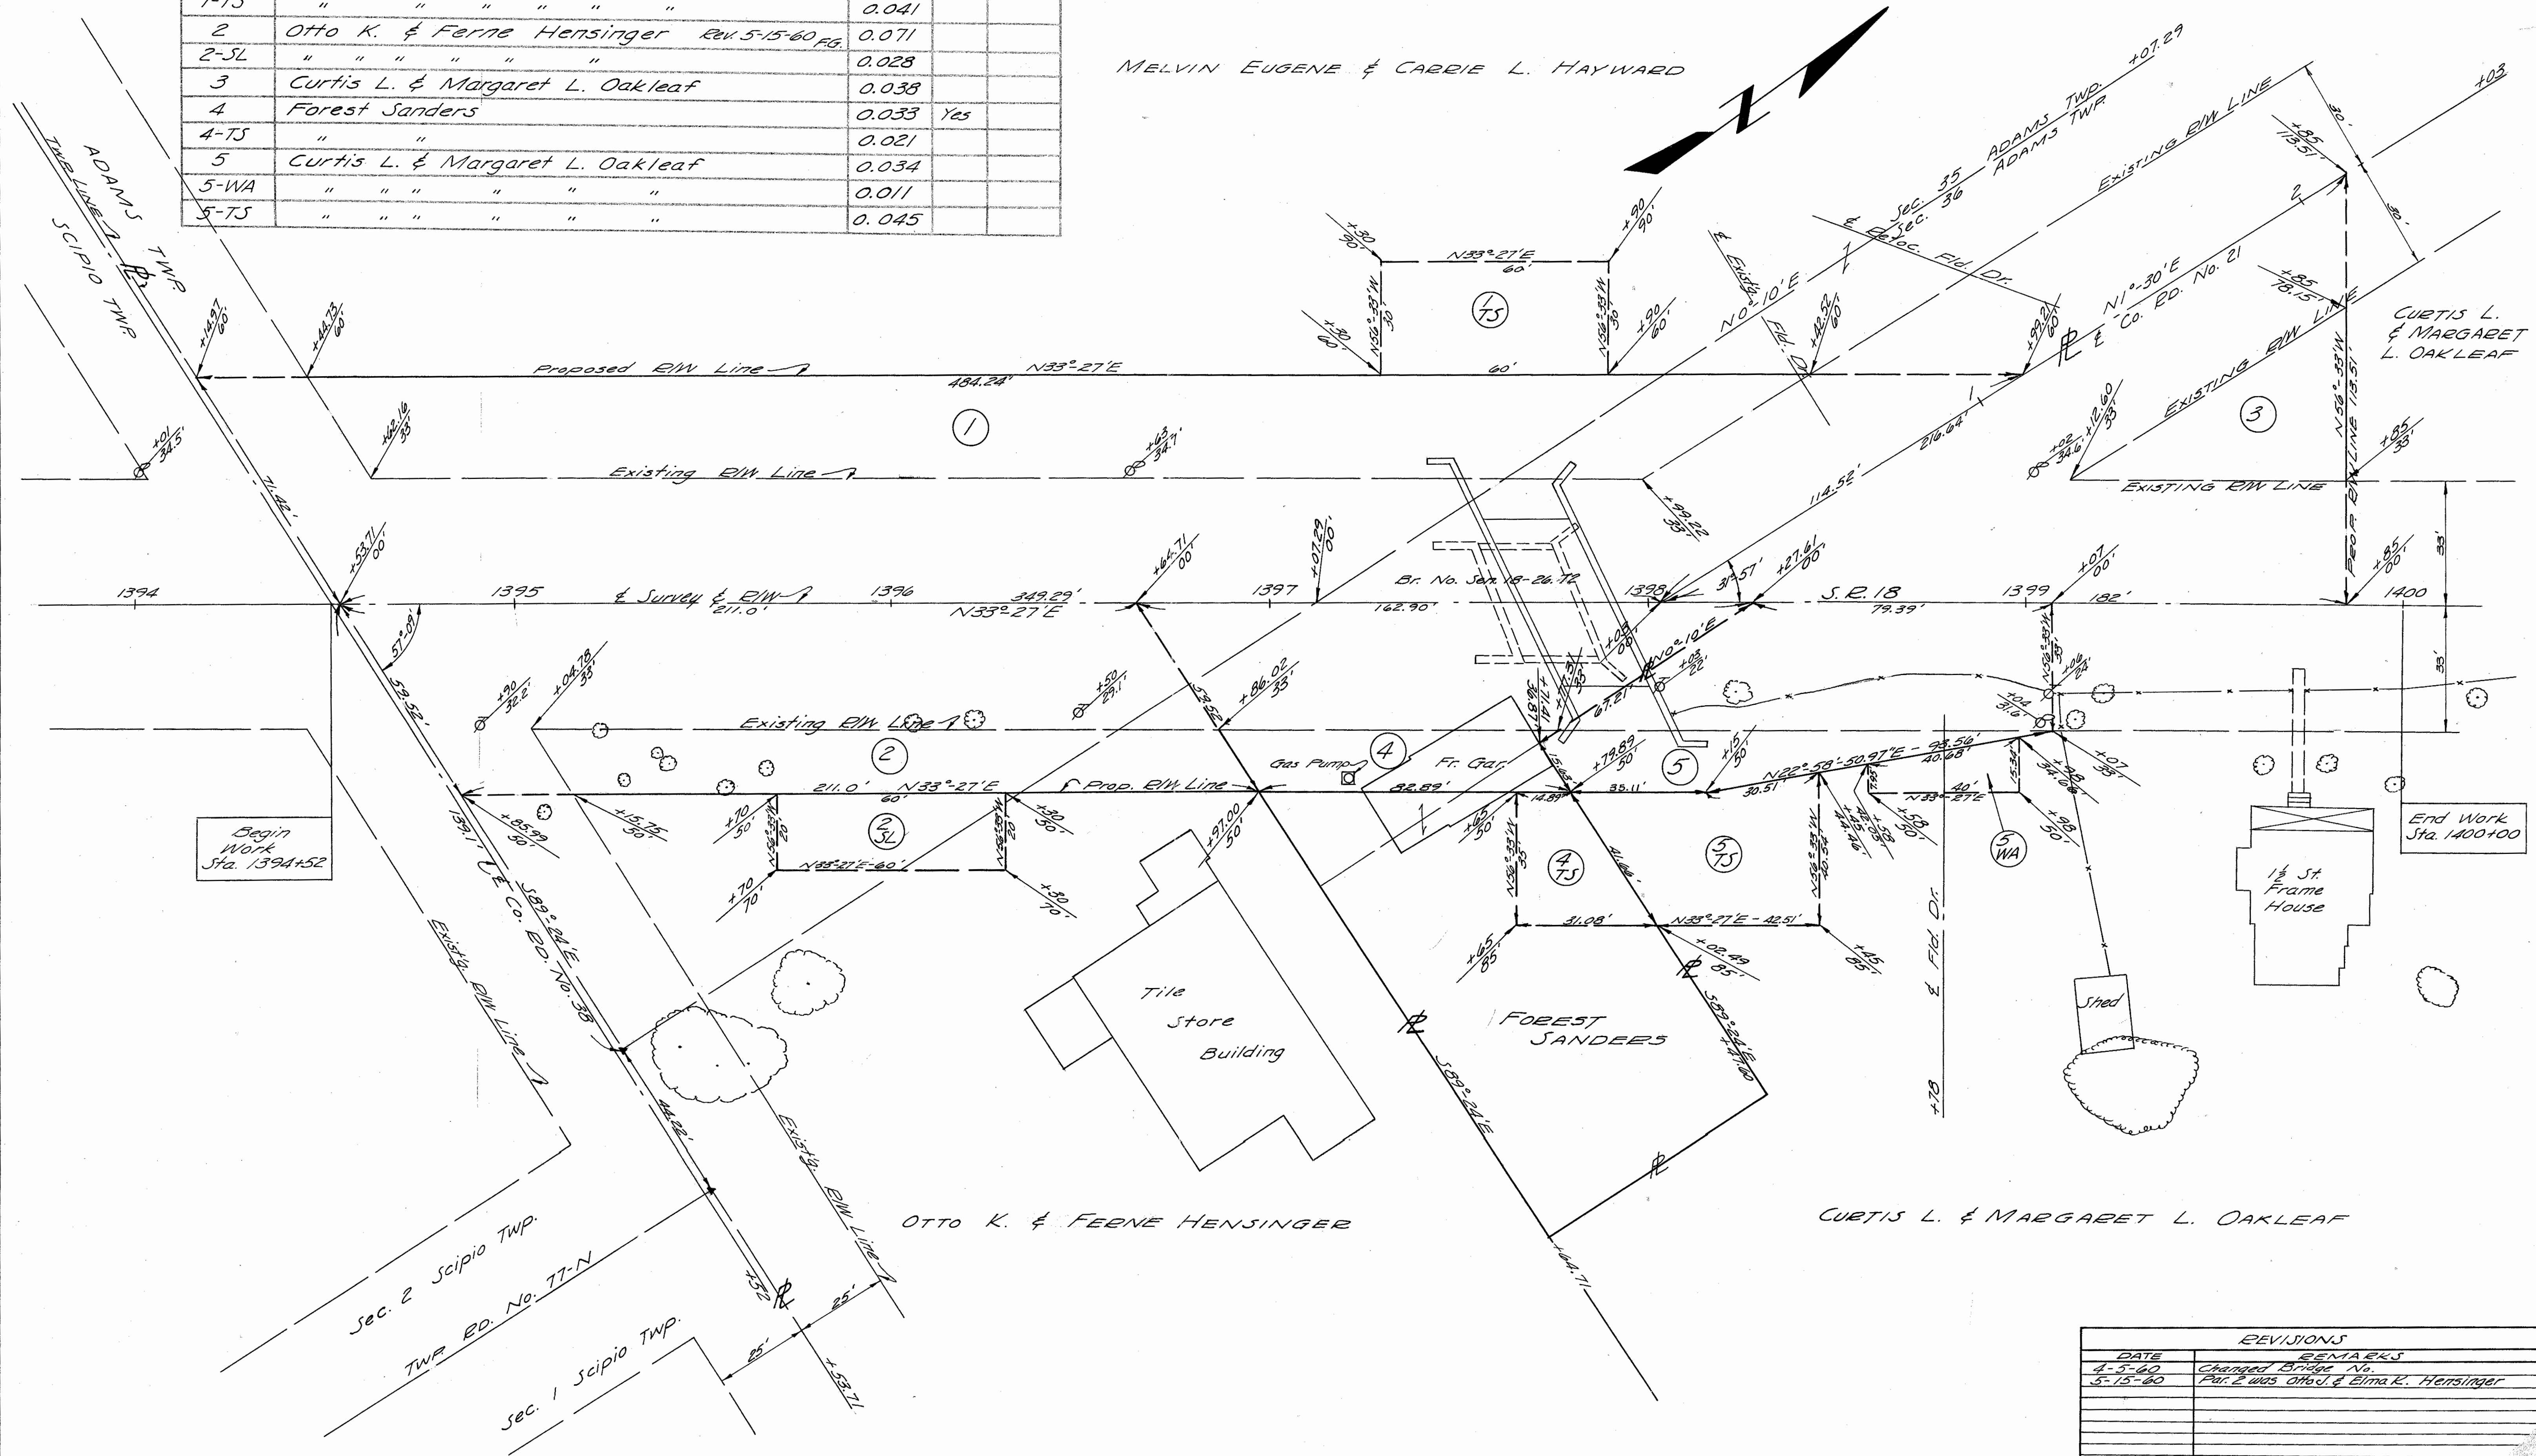

Begin Work
Sta. 1394+52

End Work
Sta. 1400+00

R208A 46 G-57

REVISIONS

DATE	REMARKS
4-5-60	Changed Bridge No.
5-15-60	Par. 2 was Otto K. & Ferne Hensinger



SEC. 36 ADAMS TWP T3N R16E

SEC. 25 ADAMS TWP T3N R16E

FED. RD. DIVISION	STATE	PROJECT
2	OHIO	

30

E/W PLAN
SEN. 18-(28.42)

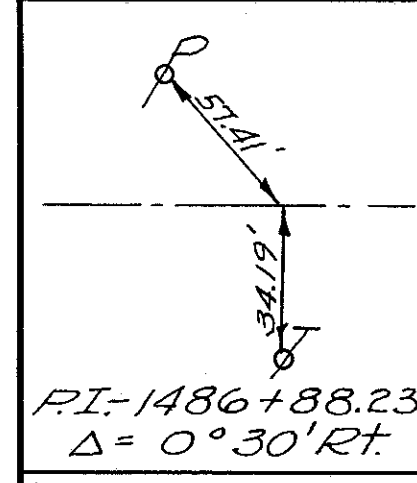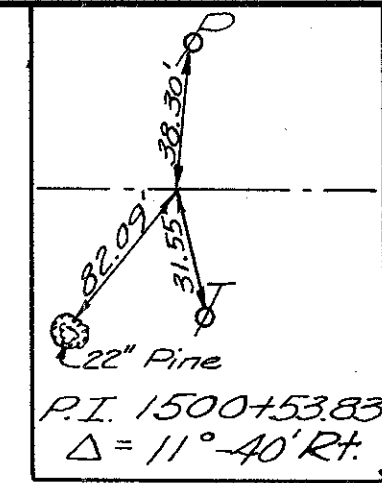

IVAN D. & MAE F. WELLES

VINTON EDGAR MYERS

6


8

7

IVAN D. & MAE F. WELLES

VINTON EDGAR MYERS

9

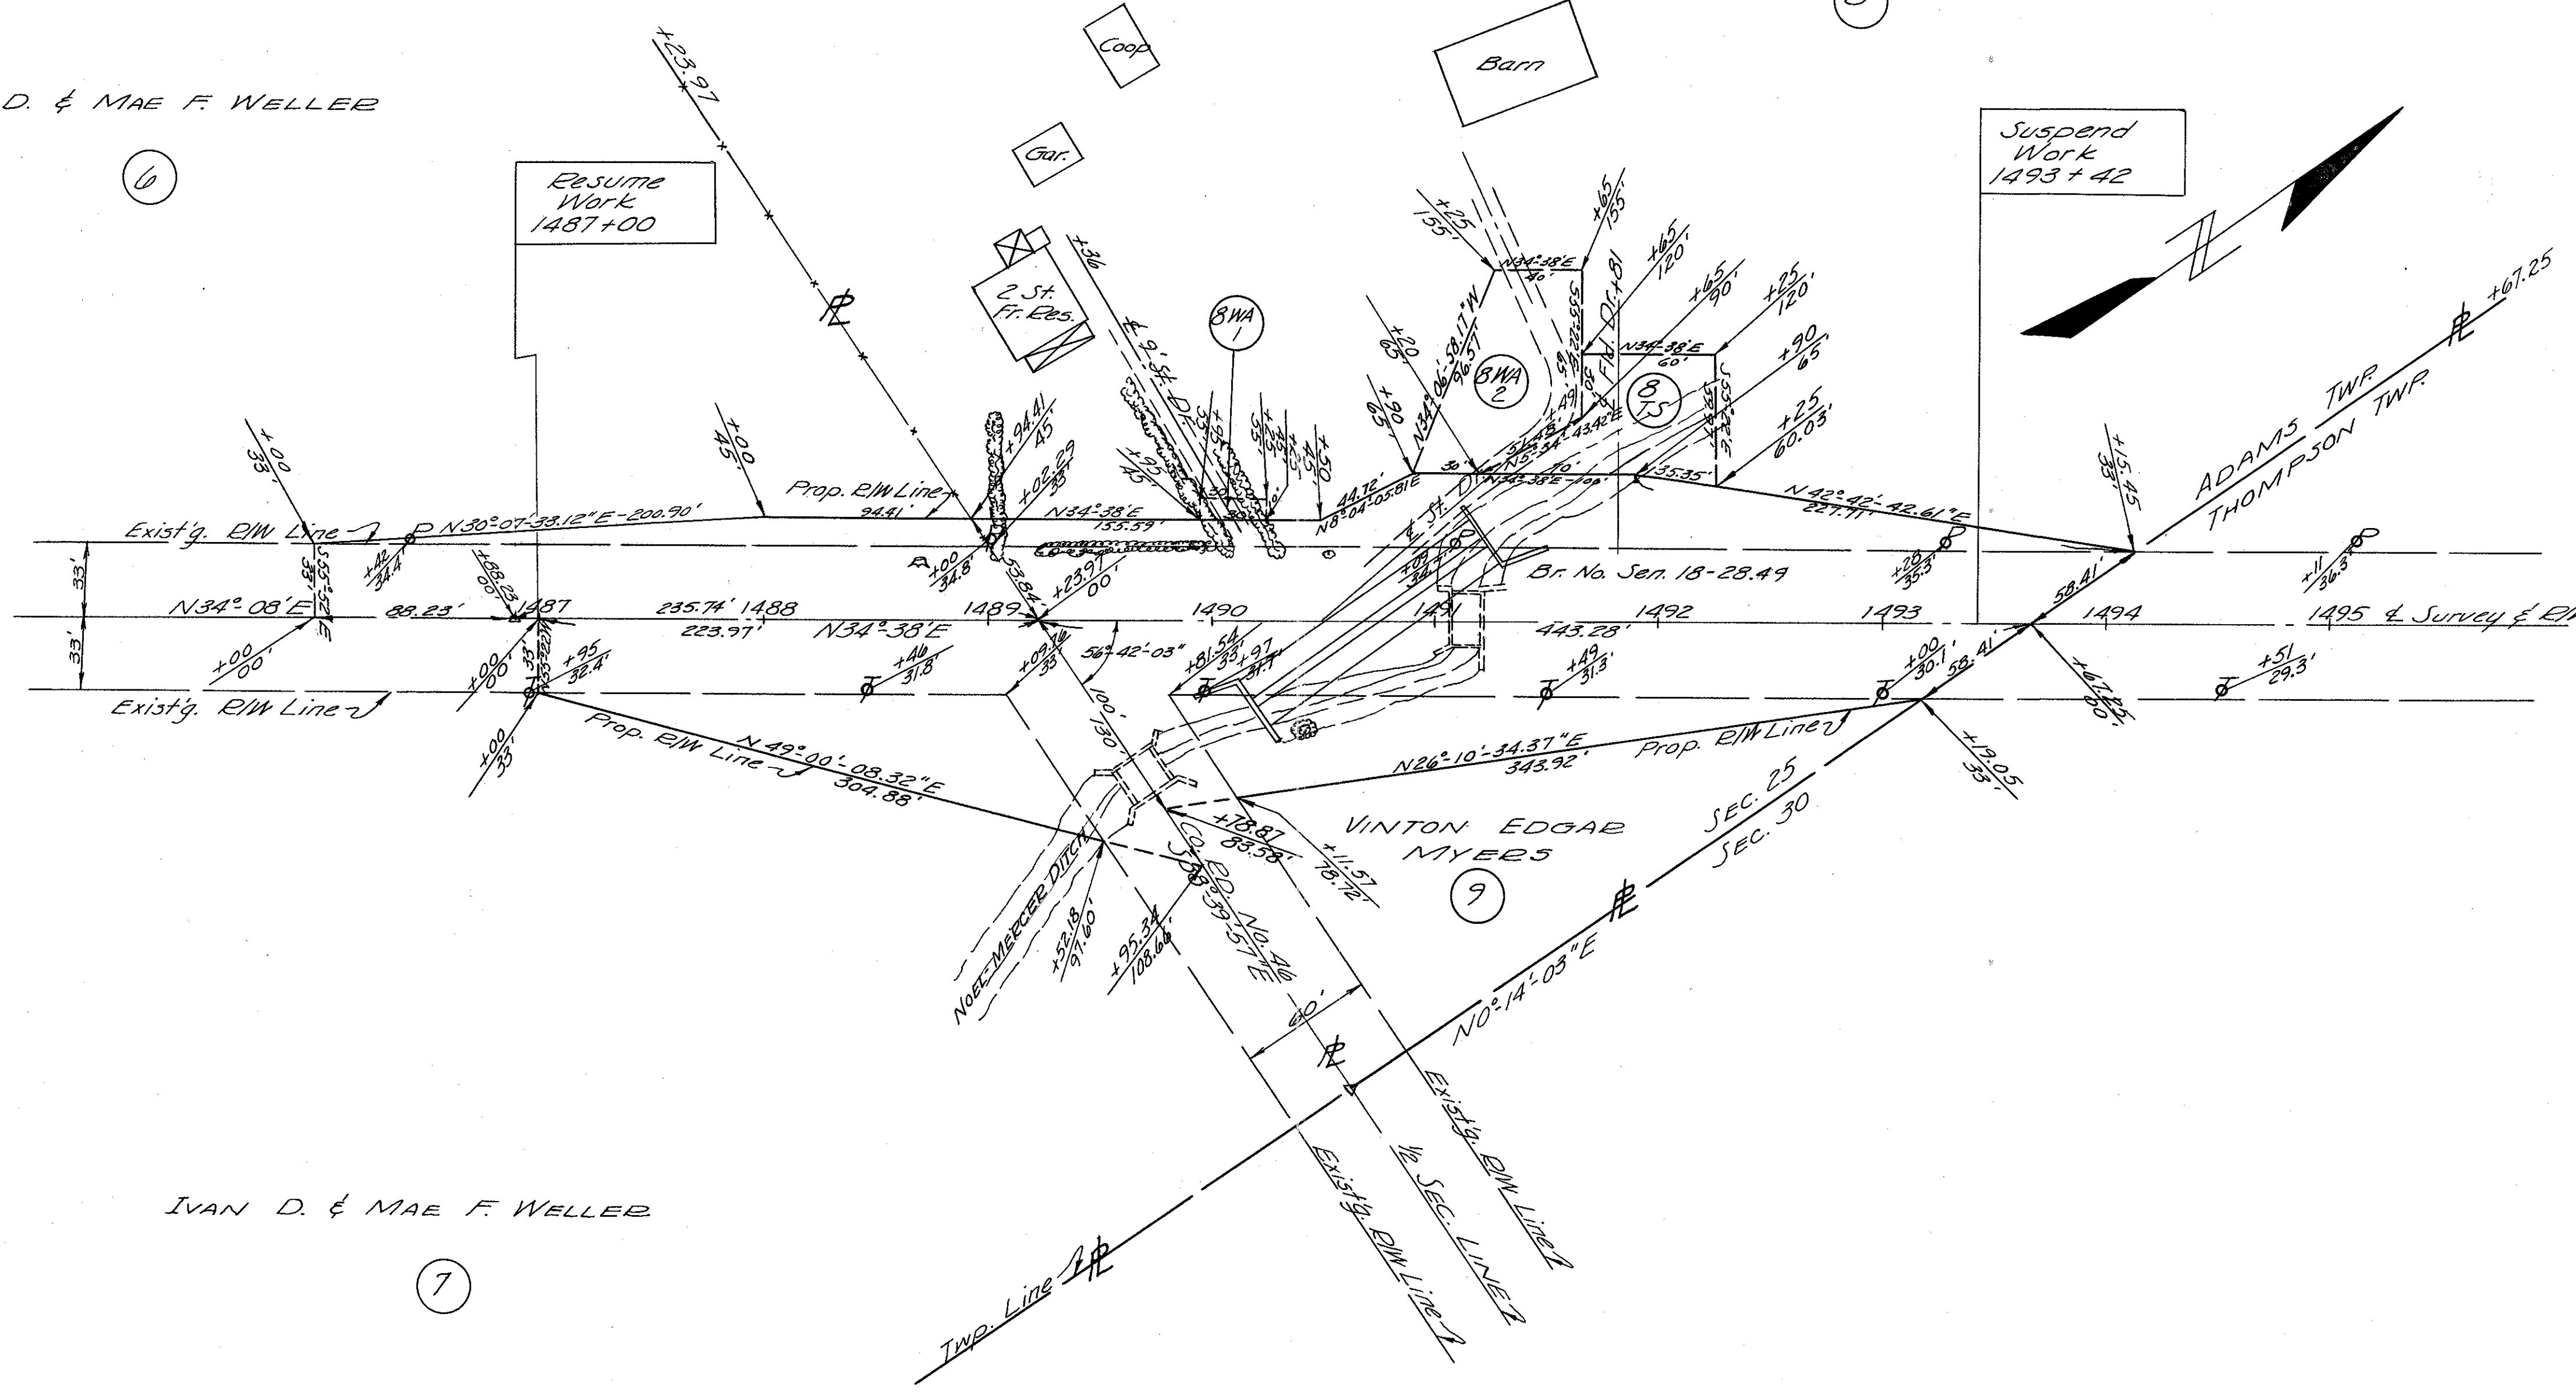

SUMMARY OF ADDITIONAL E/W REQUIRED

Parcel No.	Owner	Area	Exist. Eas.	Street No.	Remarks
6	Ivan D. & Mae F. Weller	0.047			
7	" " " " " "	0.155			
8	Vinton Edgar Myers	0.219			
8-WA-1	" " " "				
8-WA-2	" " " "	0.106			
8-TS	" " " "	0.091			
9	" " " "	0.177			

SEC. 30 THOMPSON TWP T3N R16E

REVISIONS	
DATE	REMARKS
4-5-60	Changed Bridge No.



R/W 2

Stamped July 1977

SEC. 17 THOMPSON TWP T3N, R17E, SENECA Co.

FED. RD. DIVISION	STATE	PROJECT	31
2	OHIO		

R/W PLAN
SEN 18 - (31.28)

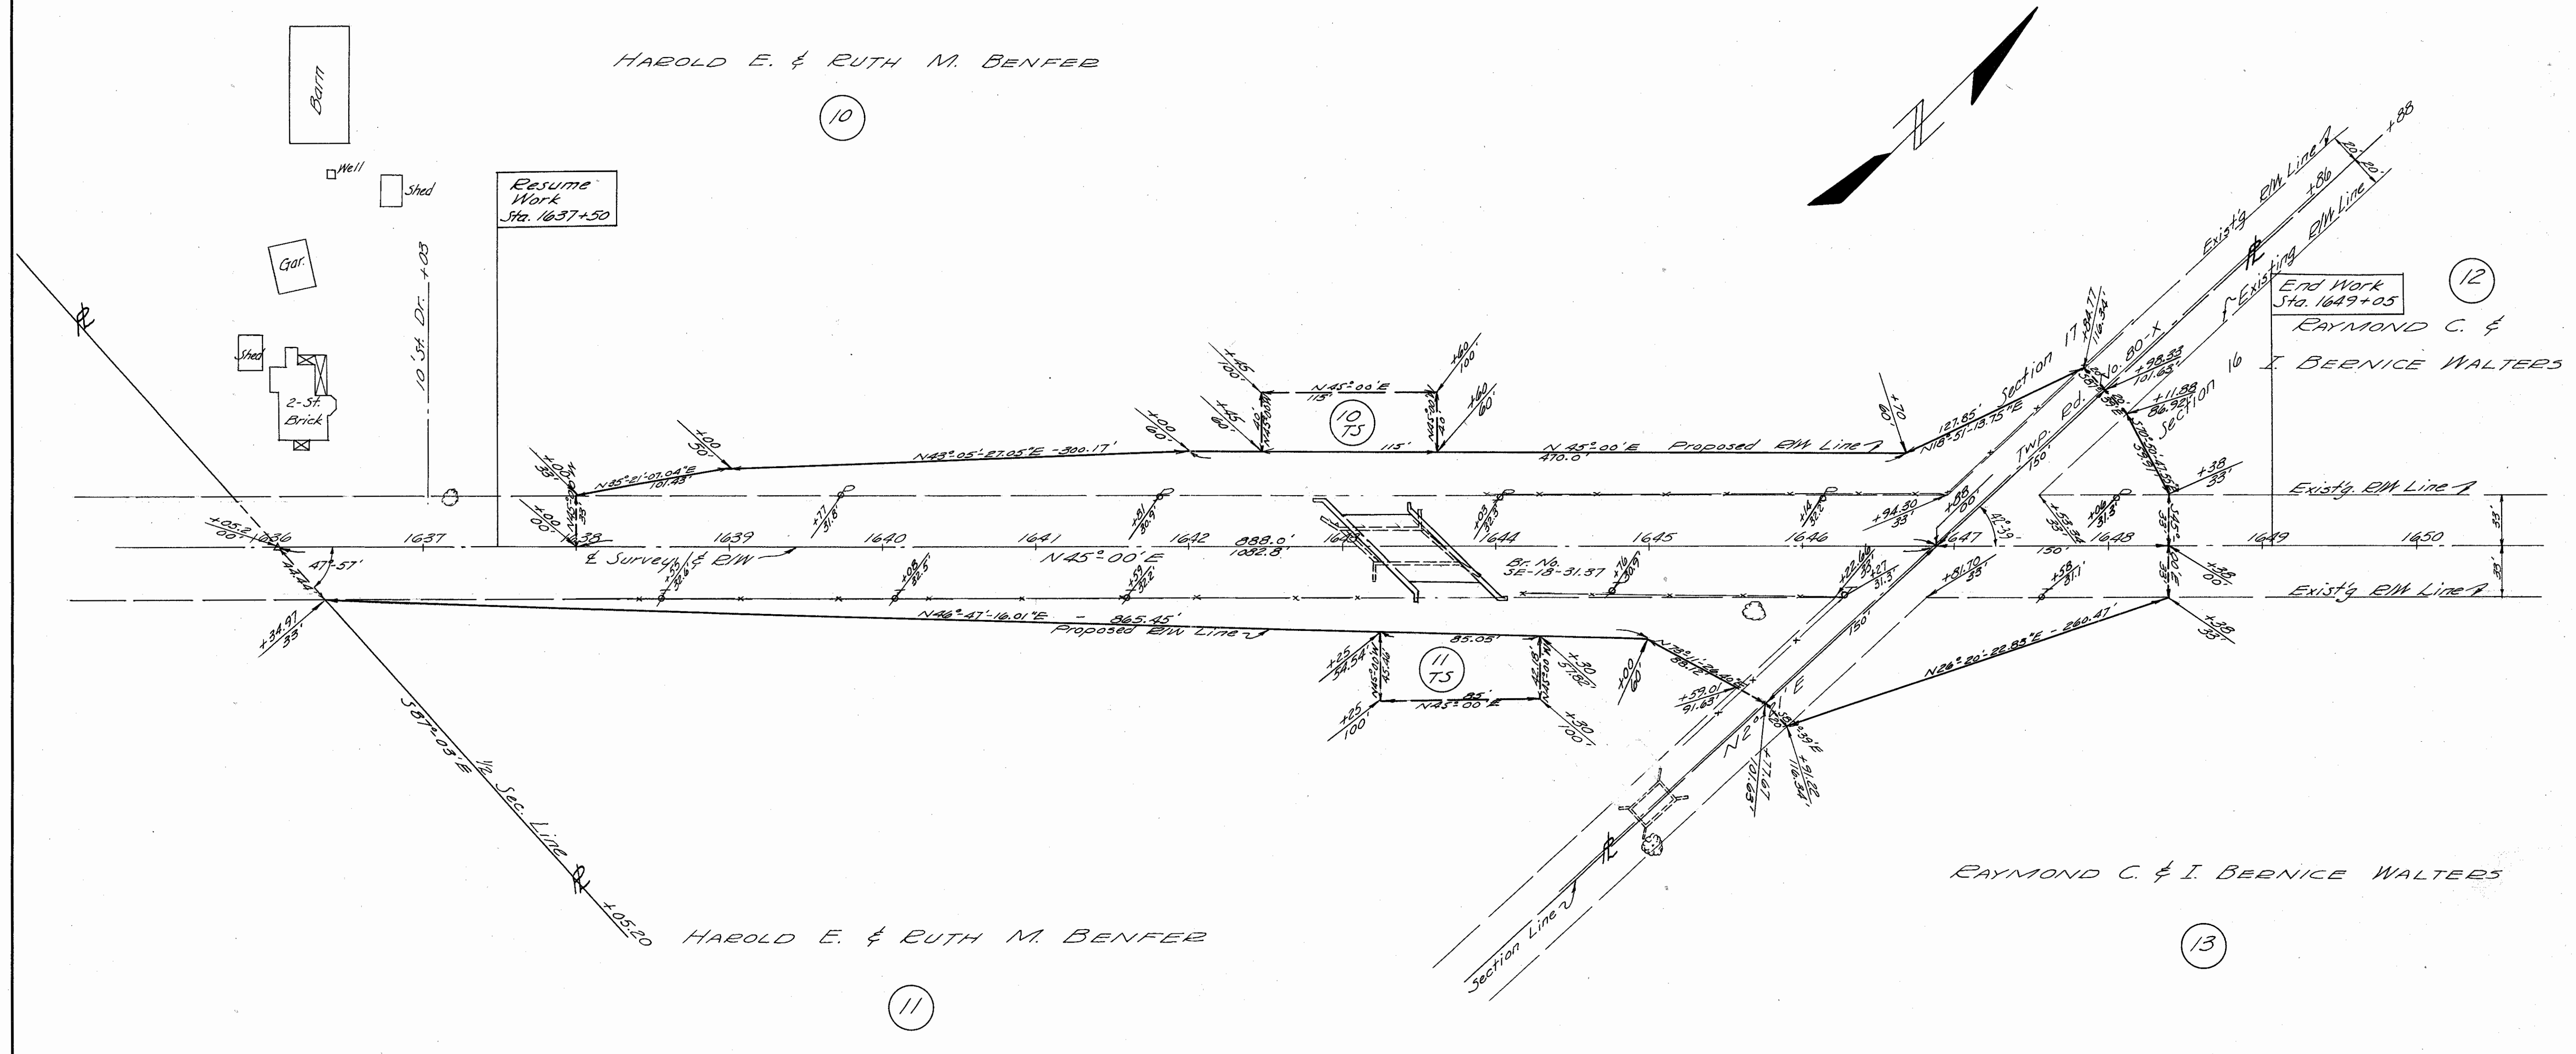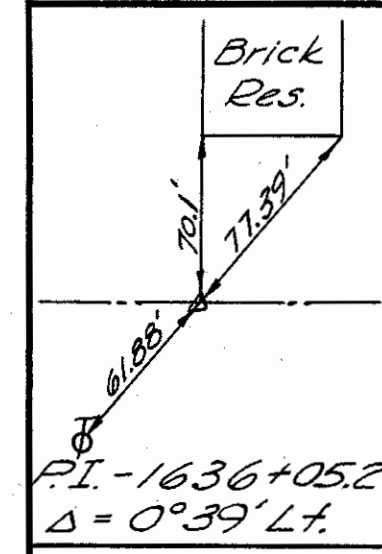

SUMMARY OF ADDITIONAL R/W REQUIRED

Parcel No.	Owner	Area	Exist. Blkgs.	Street No.	Remarks
10	Harold E. & Ruth M. Benfer	0.521			
10-T5	" " " " " "	0.106			
11	" " " " " "	0.373			
11-T5	" " " " " "	0.086			
12	Raymond C. & I. Bernice Walters	0.052			
13	" " " " " "	0.150			

SEC. 16 THOMPSON TWP, T3N, R17E, SENECA Co.

REVISIONS	
DATE	REMARKS

SEC. 17 THOMPSON TWP, T3N, R17E, SENECA Co.