



O.D.O.T. DISTRICT 2 SURVEY OFFICE (USE ONLY)

PERSONNEL _____ REFERENCE NO. D SHEET 4 OF 13
 NOTES MILLER DATE 5/4/23 ROUTE SR 18
 H.C. MILLER WEATHER FAIR COUNTY SENECA
 R.C. RHOADES TEMP. 51° TOWNSHIP LOUDON
 DWG BY RHOADES PID 101280 SECTION 8
 T 2 N R 13 E

TYPE MONUMENT R.R.SPIKE
 ON SURFACE - ~~BELOW~~ ON
 OFFSET \varnothing PAVEMENT ON _____ LT : RT
 _____ TO _____ EDGE PAVEMENT
 STATION: 83+95

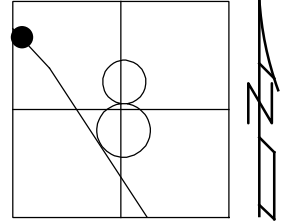

HORIZ.DATUM: _____ GEOID: _____
 GRID: NORTHING: _____ EASTING: _____

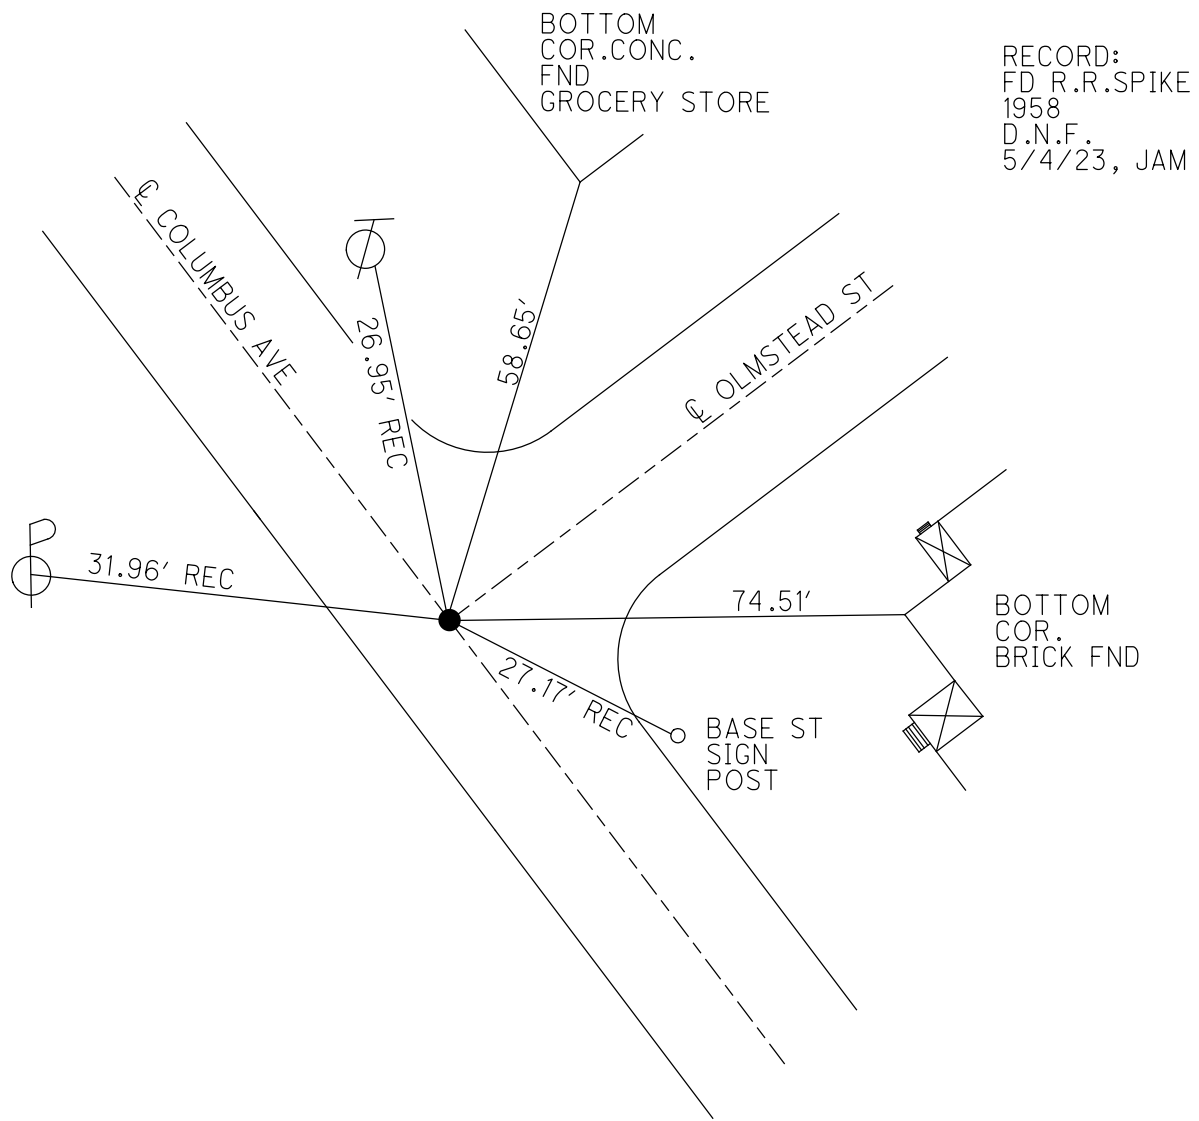

RECORD:
 FD R.R.SPIKE
 1958
 D.N.F.
 5/4/23, JAM

PERSONNEL TITLE PERSONNEL TITLE

R. Darr

H. Ward

R. Zeyen

COUNTY Seneca (Fostoria)

DATE 2-14-58

S. R. 18

WEATHER Cloudy & Cold

SEC. _____

TEMP. +26°

DESCRIPTION Ties for points on Columbus Ave From Lytle St. SE.

JOB NO. _____

LEFT

CENTER LINE

RIGHT

