


O.D.O.T. DISTRICT 2 SURVEY OFFICE (USE ONLY)

PERSONNEL _____	REFERENCE NO. <u>3AA</u>	SHEET _____ OF _____
NOTES <u>MILLER</u>	DATE <u>8/5/24</u>	ROUTE <u>SR 18</u>
H.C. <u>NIESE</u>	WEATHER <u>BREEZY</u>	COUNTY <u>SENECA</u>
R.C. <u>PRESTON-COLVIN</u>	TEMP. <u>80°</u>	TOWNSHIP <u>LOUDON</u>
<u>ASTON</u>		SECTION <u>8</u>
DWG BY <u>BARRIERE</u>	PID <u>92371</u>	T <u>2</u> N R <u>13</u> E

TYPE MONUMENT MAG NAIL  
 ON SURFACE - BELOW ON  
 OFFSET  $\text{C}$  PAVEMENT 8.1' RT LT : RT  
TO EDGE PAVEMENT  
 STATION: 128+14.63

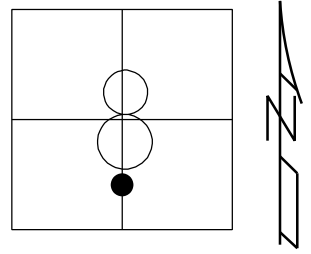

HORZ.DATUM: <u>NAD83 (2011)</u>	GEOID: <u>18</u>
GRID: NORTHING: <u>538067.681</u>	EASTING: <u>1722847.906</u>
LDP: NORTHING: _____	EASTING: _____

RECORD:  
 UNKNOWN POINT  
 FD MAG NAIL  
 REF 3AA  
 4/5/24

DIST A3-4= 7.47'  
 DIST A3-3AA= 0.36'  
 DIST 3AA-4= 7.72'

