


O.D.O.T. DISTRICT 2 SURVEY OFFICE (USE ONLY)


PERSONNEL _____ REFERENCE NO. 28 A SHEET 29 OF 48
 NOTES RHOADES DATE 12/19/18 ROUTE SR 18
 H.C. O'DONNELL WEATHER FAIR COUNTY SENECA
 R.C. RHOADES TEMP. 35° TOWNSHIP HOPEWELL
 DWG BY RHOADES PID 92128 SECTION 18
 T 2 N R 14 E

TYPE MONUMENT MONBOX W/1" IPIN
 ON SURFACE - ~~BELOW~~ ON _____
 OFFSET $\text{\textcircled{C}}$ PAVEMENT - _____ LT : RT
 - _____ TO - _____ EDGE PAVEMENT
 STATION: 431+78

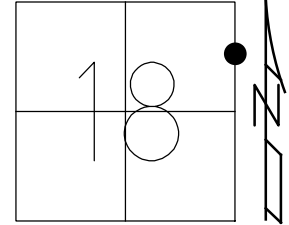

HORZ.DATUM: NAD83 2011 GEOID: 2012A
 GRID: NORTHING: 535118.908 EASTING: 1752183.195

NOTE: REF 1A SR 635

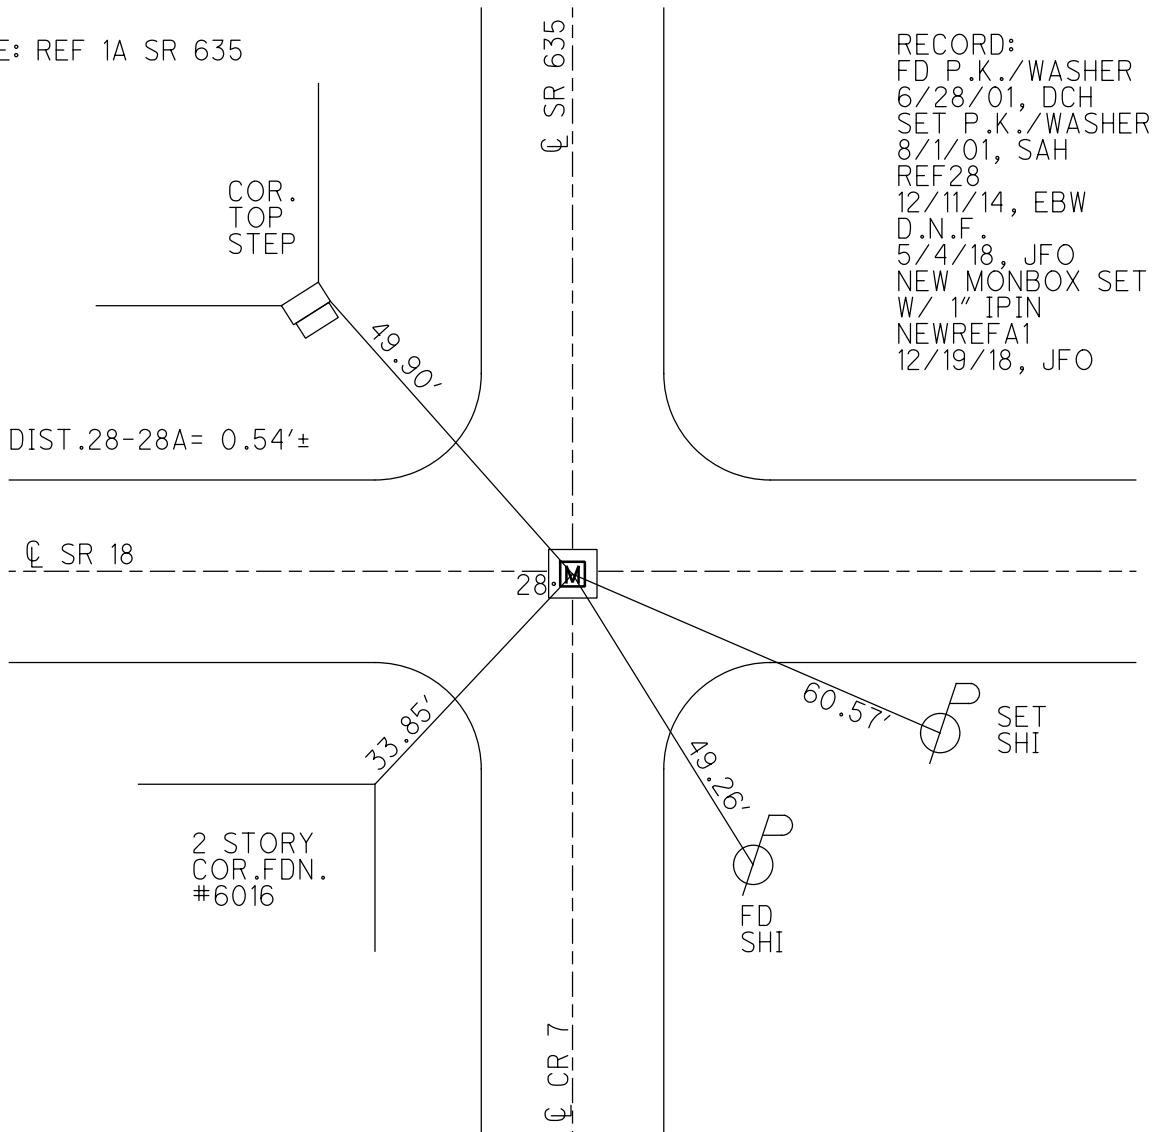

RECORD:
 FD P.K./WASHER
 6/28/01, DCH
 SET P.K./WASHER
 8/1/01, SAH
 REF28
 12/11/14, EBW
 D.N.F.
 5/4/18, JFO
 NEW MONBOX SET
 W/ 1" IPIN
 NEWREFA1
 12/19/18, JFO