

O.D.O.T. DISTRICT 2 SURVEY OFFICE (USE ONLY)

PERSONNEL _____ REFERENCE NO. 35 SHEET 37 OF 48
 NOTES VAN DUSEN DATE 6/4/01 ROUTE SR 18
 H.C. ROUSOS WEATHER SUNNY COUNTY SENECA
 R.C. BROWN TEMP. 60° TOWNSHIP HOPEWELL
 SECTION 17
 DWG BY NIESE PID NO PID T 2 N R 14 E

TYPE MONUMENT BOLT

~~ON SURFACE~~ - BELOW ±


OFFSET ℄ PAVEMENT 18.5' LT : ~~RT~~

8.0' TO LT EDGE PAVEMENT


STATION: 476+50.21

HORZ.DATUM: NAD83(2011) GEOID: 2012A

GRID: NORTHING: 534700.416 EASTING: 1756698.294

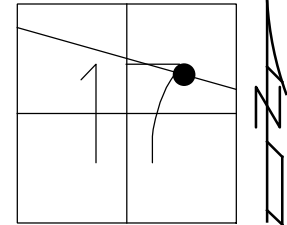

RECORD: P.I.
 CONSTRUCTION
 STA.464+50.21
 FD BOLT
 ± DOWN
 6/4/01, BVD
 FD 1" IPIN
 4" DOWN
 REF35
 4/23/19, JFO

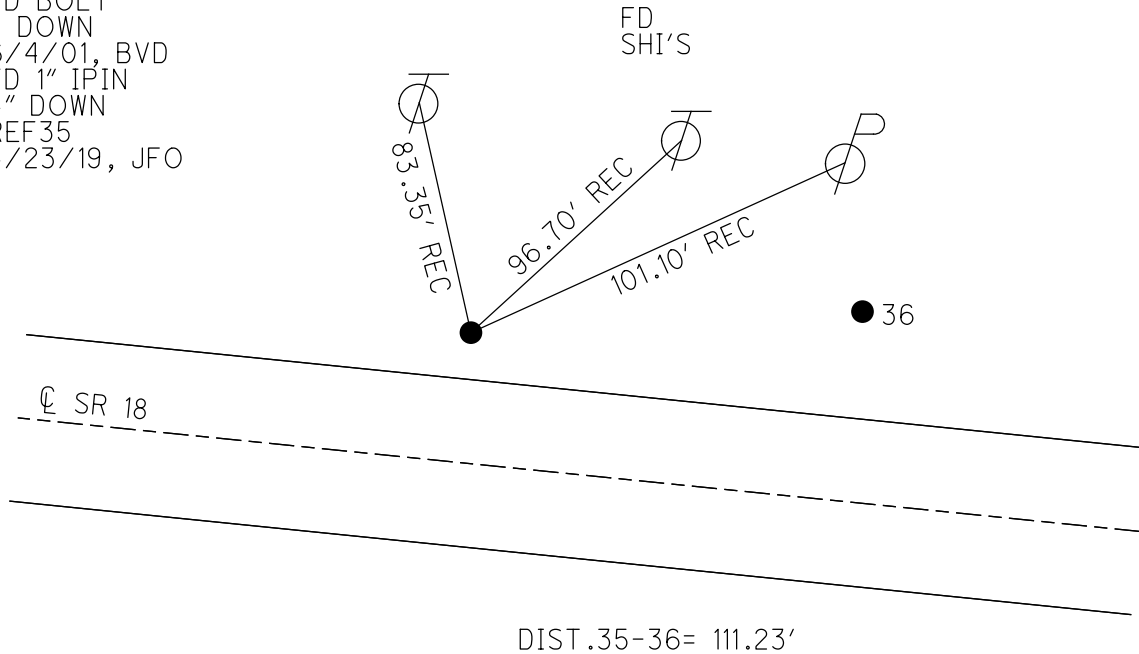

O.D.O.T. DISTRICT 2 SURVEY OFFICE

PERSONNEL _____

REFERENCE NO. 35436

SHEET 16 OF 26

NOTES VanDusen

H.C. Rousos

R.C. Brown

DATE 6-4-01

WEATHER Sunny

TEMP. 60°F.

ROUTE 18

COUNTY Seneca

TOWNSHIP Hopewell

SECTION 17

T 2 N R 14 E


TYPE MONUMENT (A) - Bolt.
(B) - 1" Iron Pin

ON SURFACE - (BELOW)

LEFT ~~ON PAVT~~ RIGHT (A) = 18.5' (B) 36.5'

^{A = 8.7'}
^{B = 25.5'} TO N. EDGE PAVEMENT


S.L.M. (A) 476179 (B) 477188

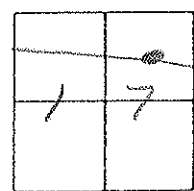

Record:

(A) Plan Sta. = 464+50.21

(B) Plan Sta. = 465+61.90

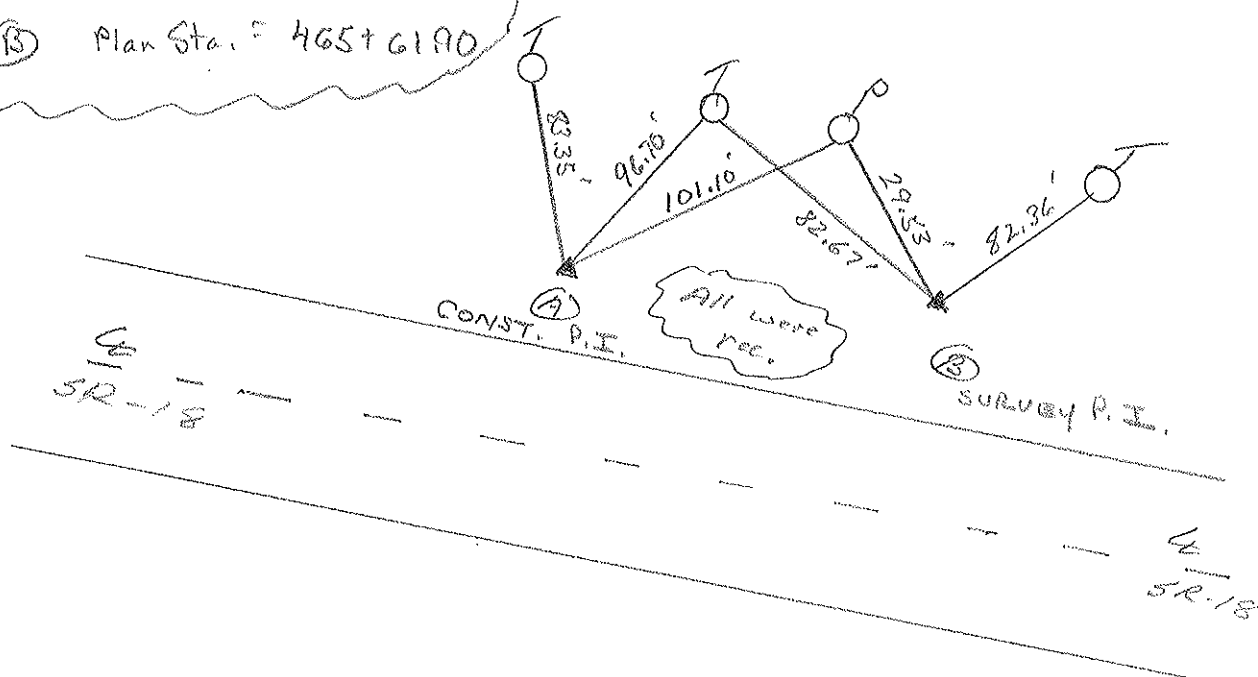

O.D.O.T. DISTRICT 2 SURVEY OFFICE

PERSONNEL

REFERENCE NO. 35+36

SHEET 16 OF 27

NOTES CHENEY

H.C. RIPPLE

DATE 11-5-1991

ROUTE 18

R.C. BARDOUR

WEATHER PARTLY CLOUDY

COUNTY SENECA

GEYMAN

TEMP. 25°

TOWNSHIP HOPWELL

SECTION 17

T2 N R 14 E


TYPE MONUMENT 1" I. PIN - Q. SURVEY - P.I.
BOLT - Q. CONST. - P.I.

~~ON SURFACE~~ - BELOW


LEFT - C. PAV'T. - ~~RIGHT~~ 36.5' - SURVEY
28.5' - CONST.

TO N. EDGE PAVEMENT

S.L.M. 477+88 - SURV., 476+79 - CONST.

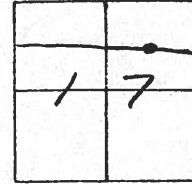

SURV. - 25.5'
CONST. - 2.0'

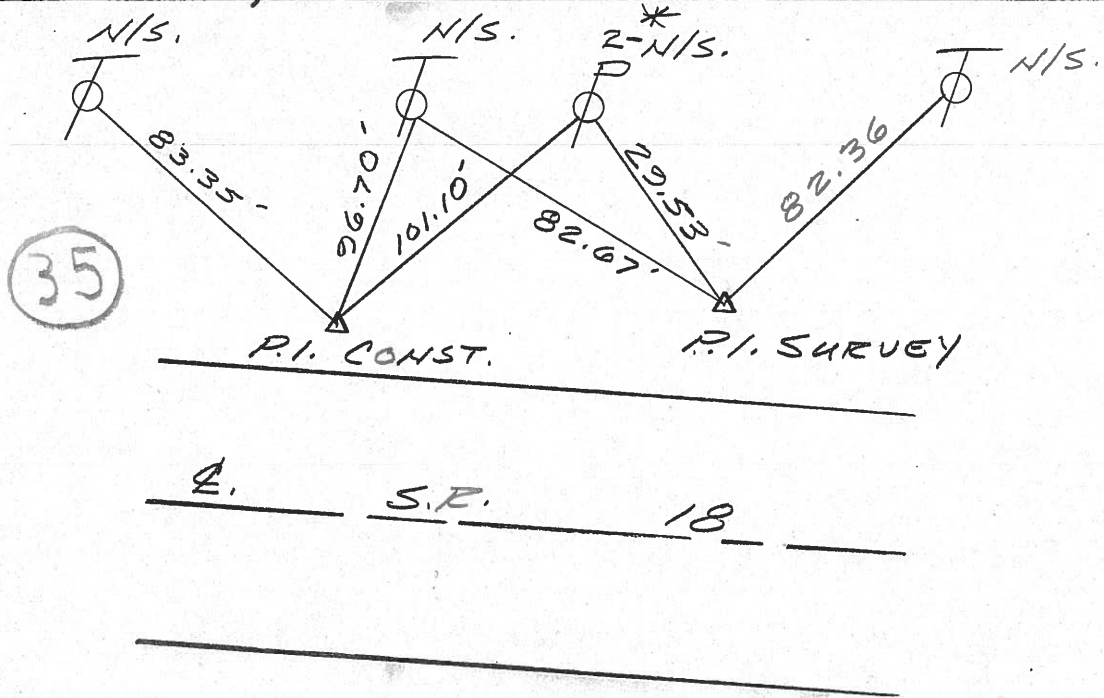

PLAN STA = 464+50.21

PLAN STA 465+61.90

OK-9-12-80-G.W.S.

County Seneca S.R. # 18

Date 5-19-80

Township Hopewell

Weather Cloudy

Section 17

Temp. 58°

T2N, R14E


Personnel Schneider

Mosser

Barbour

Cronin

Ripple Geyman

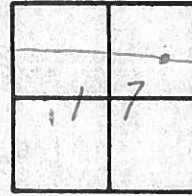


36

OK
 P.I. Survey
 465 + 61.90
 Iron Pin

OK
 P.I. Const. -
 464 + 50.21
 sq. bolt

35

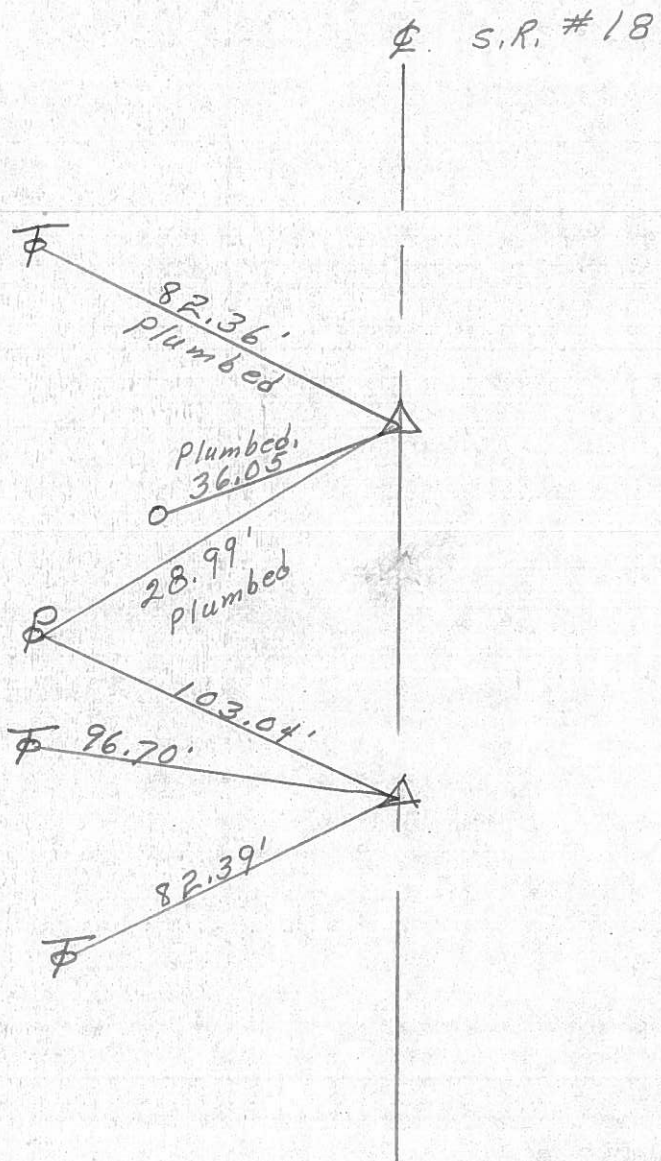

PERSONNEL	TITLE	PERSONNEL	TITLE	COUNTY	DATE
Schneider		Potts		Seneca	10-24-68
Mosser				S. R. 1.8	WEATHER Cloudy-Rain
Barbour				SEC. Bascom to Tiffin	TEMP. 50°

DESCRIPTION Ties for Control Points JOB NO. _____

