

O.D.O.T. DISTRICT 2 SURVEY OFFICE (USE ONLY)

PERSONNEL

REFERENCE NO. 40 A

SHEET 43 OF 48

NOTES SAVAGE DATE 9/8/21

H.C. AUBLE WEATHER SUNNY

R.C. NIESE TEMP. 68°

ROUTE SR 18

COUNTY SENECA

TOWNSHIP HOPEWELL

SECTION 15

DWG BY RHOADES PID PVTRAIN

T 2 N R 14 E

TYPE MONUMENT P.K.SHANK

ON SURFACE - ~~BELOW~~ ON

OFFSET 11.0' TO LT EDGE PAVEMENT 1.0' LT : RT

11.0' TO LT EDGE PAVEMENT


STATION: 558+84

HORZ.DATUM: NAD83(2011)


GEOID: 2012A

GRID: NORTHING: 531636.064

EASTING: 1763995.384

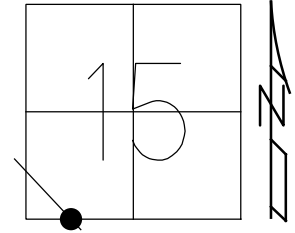

- RECORD:
 FD P.K./WASHER
 11/5/91
 FD P.K./WASHER
 6/4/01, BVD
 SET P.K./WASHER
 8/1/01, SAH
 FD P.K./WASHER
 REFA40
 4/23/19
 8/16/19, JFO
 FD P.K.SHANK
 9/8/21, DSA
 2/16/22, JFO

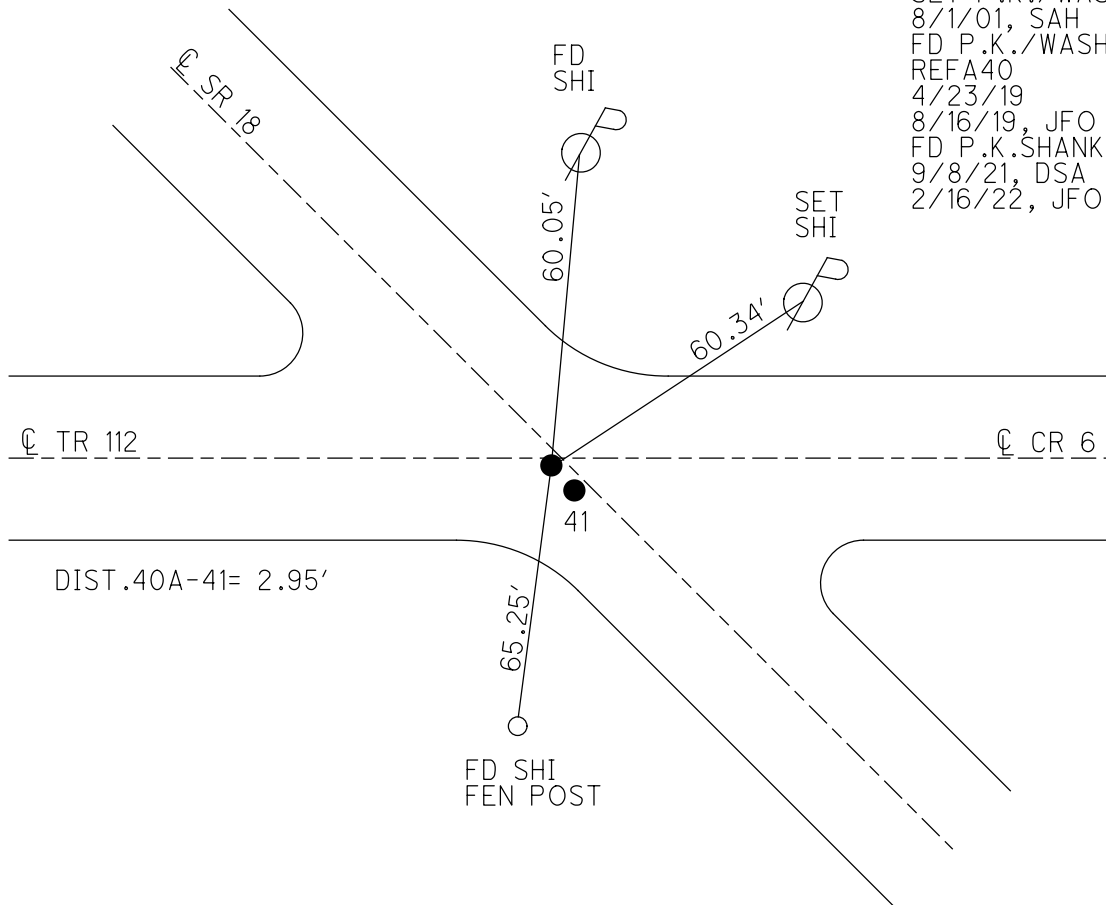

O.D.O.T. DISTRICT 2 SURVEY OFFICE (USE ONLY)

PERSONNEL

REFERENCE NO. 40 A

SHEET 43 OF 48

NOTES VAN DUSEN

DATE 6/4/01

ROUTE SR 18

H.C. ROUSOS

WEATHER SUNNY

COUNTY SENECA

R.C. BROWN

TEMP. 60°

TOWNSHIP HOPEWELL

SECTION 15

DWG BY NIESE

PID NO PID

T 2 N R 14 E

TYPE MONUMENT P.K./WASHER

ON SURFACE - ~~BELOW~~ ON

OFFSET Q PAVEMENT 1.0' RT : LT

11.0' TO LT EDGE PAVEMENT


STATION: 558+84

HORZ.DATUM: NAD83(2011)


GEOID: 2012A

GRID: NORTHING: 531636.064

EASTING: 1763995.384

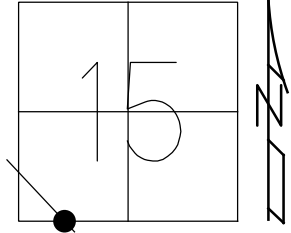

RECORD:
 FD P.K./WASHER
 11/5/91
 FD P.K./WASHER
 6/4/01, BVD
 SET P.K./WASHER
 8/1/01, SAH
 FD P.K./WASHER
 REFA40
 4/23/19
 8/16/19, JFO

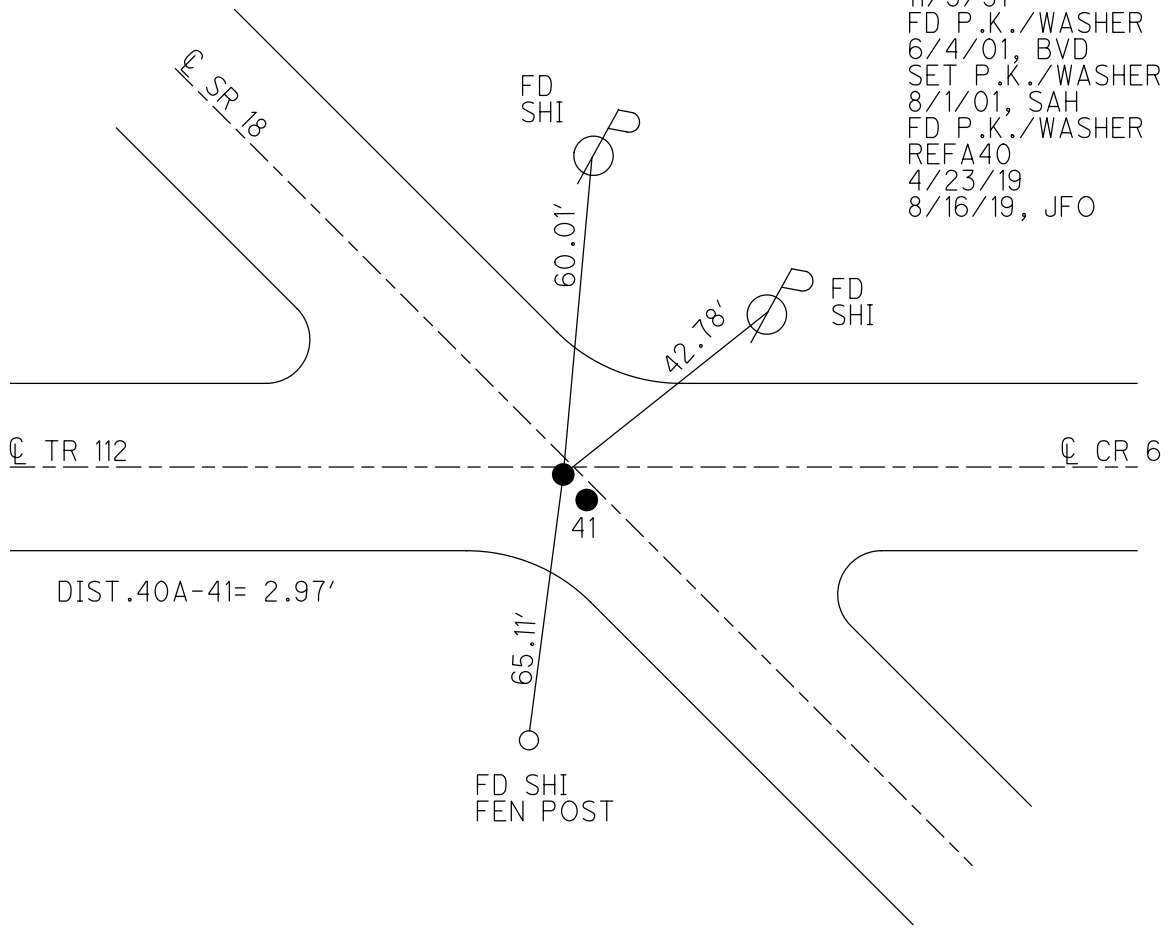

O.D.O.T. DISTRICT 2 SURVEY OFFICE

PERSONNEL _____

REFERENCE NO. 41

SHEET 21 OF 26

NOTES VanDusen

H.C. PA1505

R.C. Brown

DATE 6-4-01

WEATHER Sunny

TEMP. 68°F

ROUTE 18

COUNTY Seneca

TOWNSHIP Hopewell

SECTION 15+22

T 2 N R 14 E



TYPE MONUMENT (A)(B) = PK/W

ON SURFACE - ~~BELOW~~

~~LEFT~~ - (C) PAW'T. - RIGHT 1' Both Points

11' TO N. EDGE PAVEMENT

S.L.M. (A) = 558+84 (B) = 558+87

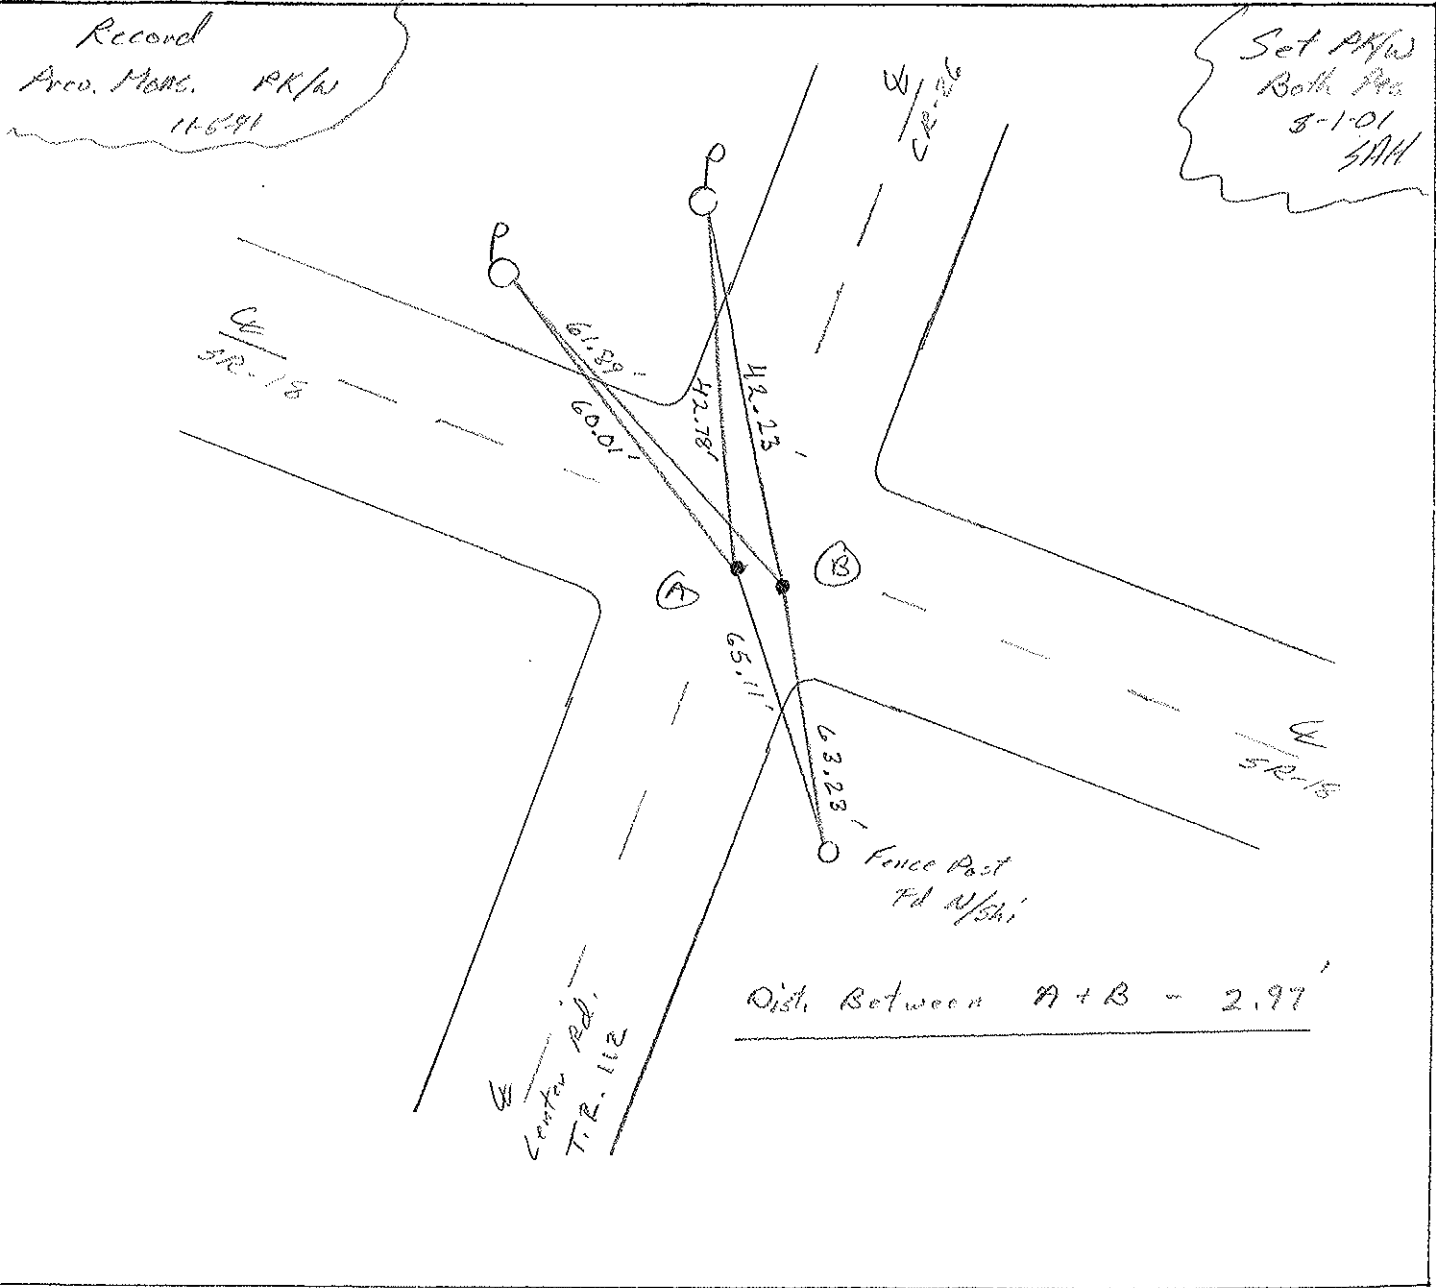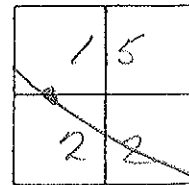

O.D.O.T. DISTRICT 2 SURVEY OFFICE

PERSONNEL

REFERENCE NO. 41

SHEET 24 OF 27

NOTES CHENEY

H.C. RIPPLE

DATE 11-5-1991

ROUTE 18

R.C. BARBOUR

WEATHER PARTLY CLOUDY

COUNTY SENECA

BEYMAN

TEMP. 30°

TOWNSHIP HOPWELL

SECTION 15 1/2 22

T2N R14E

TYPE MONUMENT SET PK/WASHERS

ON SURFACE - ~~BELOW~~

~~LEFT~~ - 1' TO PAV'T. - RIGHT 1' BOTH POINTS


11' TO N. EDGE PAVEMENT BOTH POINTS

S.L.M. 558+71

15	
28	



PREVIOUS MONUMENTS:
PKS/SHIMERS

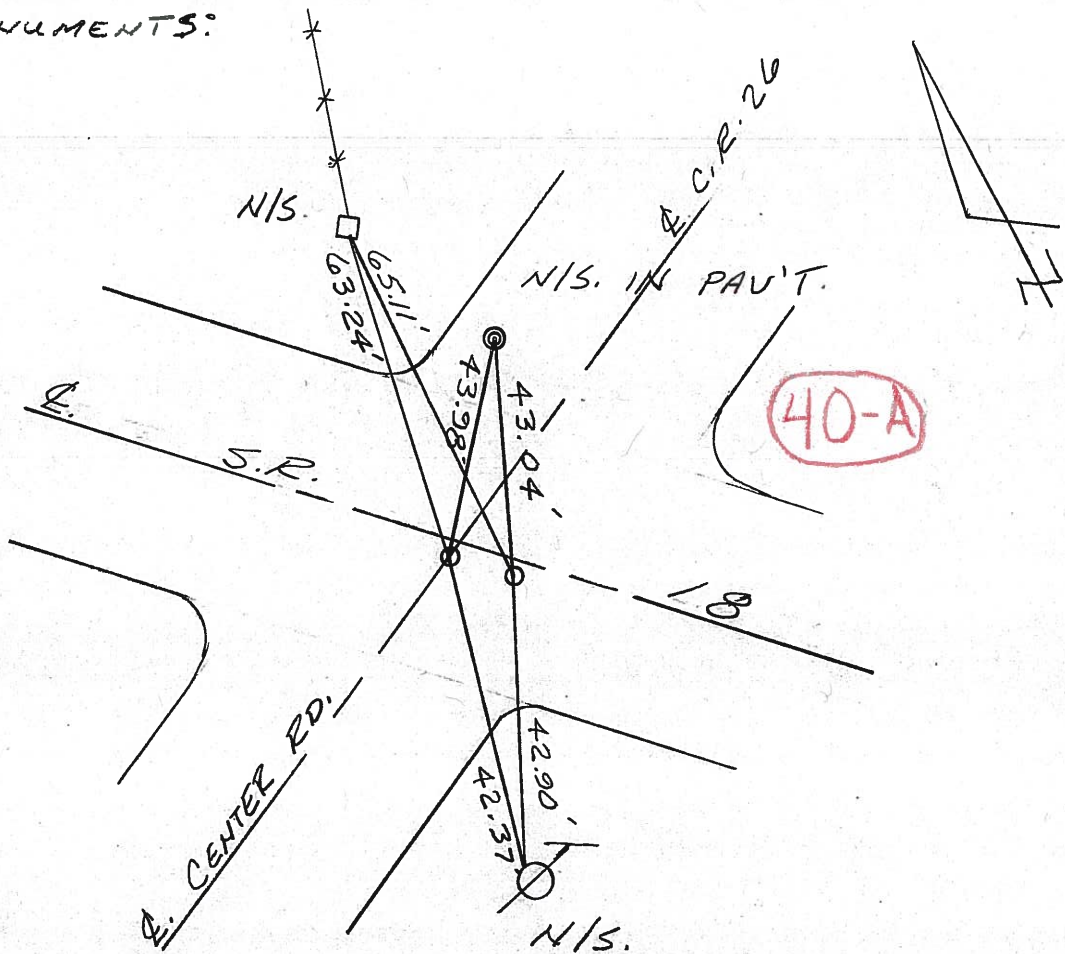

QD.O.T. DISTRICT 2 SURVEY OFFICE

Sht. ___ of ___

County Seneca S.R. # 18

Date 5-19-80

OK-9-12-80-G.W.S.

Township Hopewell

Weather cloudy

Section 15 & 22

Temp. 58°

T2N, R1E

Personnel Schneider


Mosser

Barbour

Cronin


Ripple Geyman

1	5
2	2

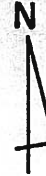

~~40~~

§ S.R. #18

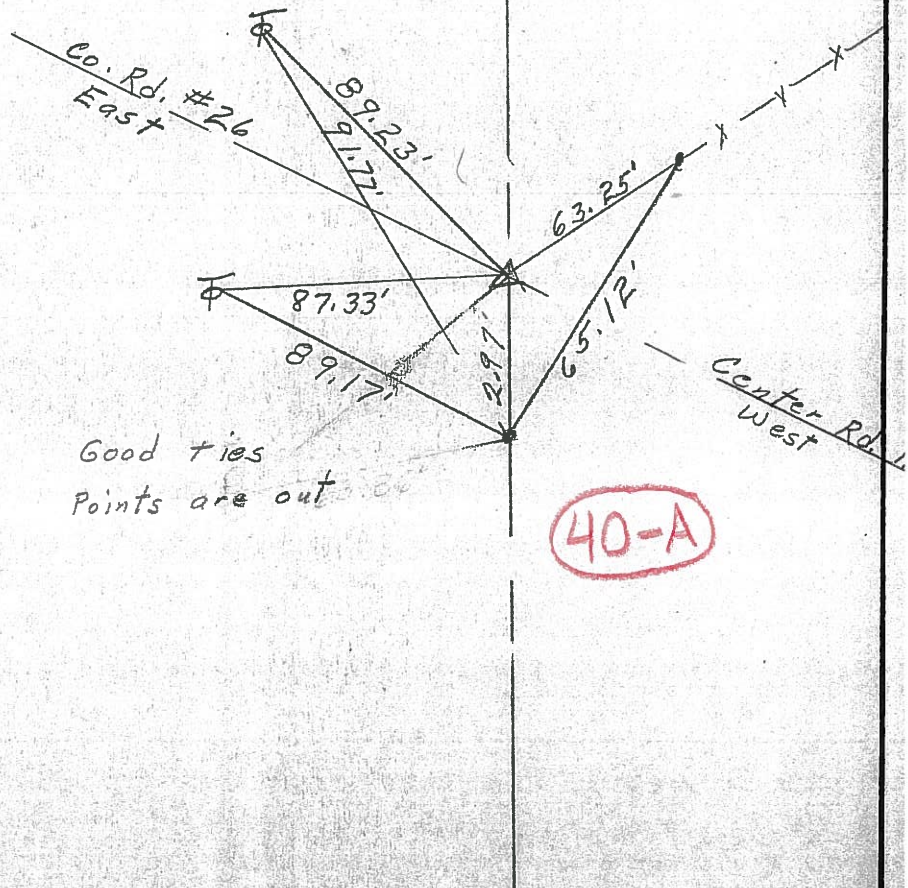

45-1-77.4

1942 Plan

SET P.K. NAILS & SHI.

Good ties
Points are out

40-A