

O.D.O.T. DISTRICT 2 SURVEY OFFICE (USE ONLY)

PERSONNEL

REFERENCE NO. 45

SHEET 5 OF 18

NOTES CRONIN DATE 12/13/79
 H.C. RIPPLE WEATHER OVERCAST
 R.C. SCHNEIDER TEMP. 30°
MOSSER/BARBOUR

ROUTE SR 18
 COUNTY SENECA
 TOWNSHIP HOPEWELL
 SECTION 23
 T 2 N R 12 E

DWG BY NIESE PID _____

TYPE MONUMENT P.K./WASHER


ON SURFACE - ~~BELOW~~ ON

OFFSET ϕ PAVEMENT ON LT : RT
- TO - EDGE PAVEMENT


STATION: 665+28

HORZ.DATUM: _____ GEOID: _____

GRID: NORTHING: _____ EASTING: _____

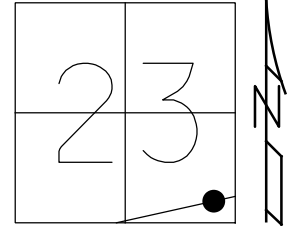

RECORD: P.I.
 $\Delta = 00^{\circ} 38' 00''$ LT
 STA 47+23.42
 FD P.K./WASHER
 12/13/79, CRONIN

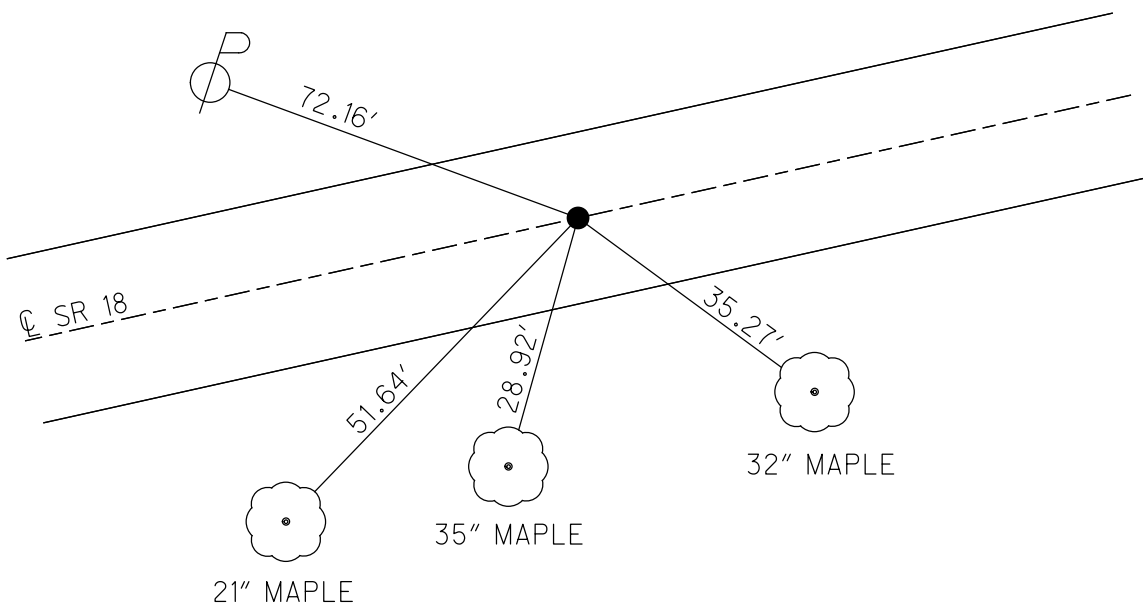

County Seneca - S.R. # 18

Date 12/13/79

Township Hopewell

Weather overcast

Section _____

Temp. 30°

T2N, R4E


Personnel Cronin

Ripple

Schneider

Mosser

Barbour

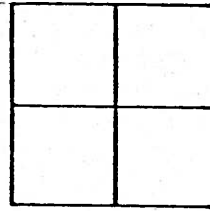

45



P.I. - A = 00° 38' Lt.

47 + 23.42

P.K. & Washer on surface

