


O.D.O.T. DISTRICT 2 SURVEY OFFICE (USE ONLY)


PERSONNEL _____ REFERENCE NO. 80 A SHEET 12 OF 28
 NOTES TRENKA DATE 5-29-18 ROUTE SR 18
 H.C. RHOADES WEATHER SUNNY COUNTY SENECA
 R.C. TRENKA TEMP. 80° TOWNSHIP SCIPIO
 _____ SECTION 2
 DWG BY JAMES PID 101281 T 2 N R 16 E

TYPE MONUMENT P.K./WASHER
 ON SURFACE - ~~BELOW~~ ON
 OFFSET Q PAVEMENT ON LT : RT
- TO - EDGE PAVEMENT
 STATION: 1369+46.14

HORZ.DATUM: NAD83 2011 GEOID: NAVD88 2012A
 GRID: NORTHING: 544844.367 EASTING: 1835112.280

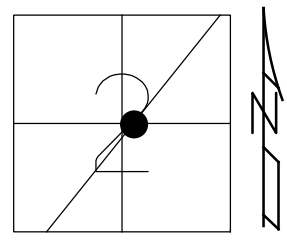

RECORD:
 ORGIN UNKNOWN
 FD P.K.NAIL
 7-15-85, CL
 SET P.K./WASHER
 9-26-85, SWH
 FD P.K./WASHER
 7-31-02, MB
 FD P.K./WASHER
 REFA80
 2-27-17, JFO
 5-29-18, JMR
 SET MAG/WASHER
 1-10-19, JFO

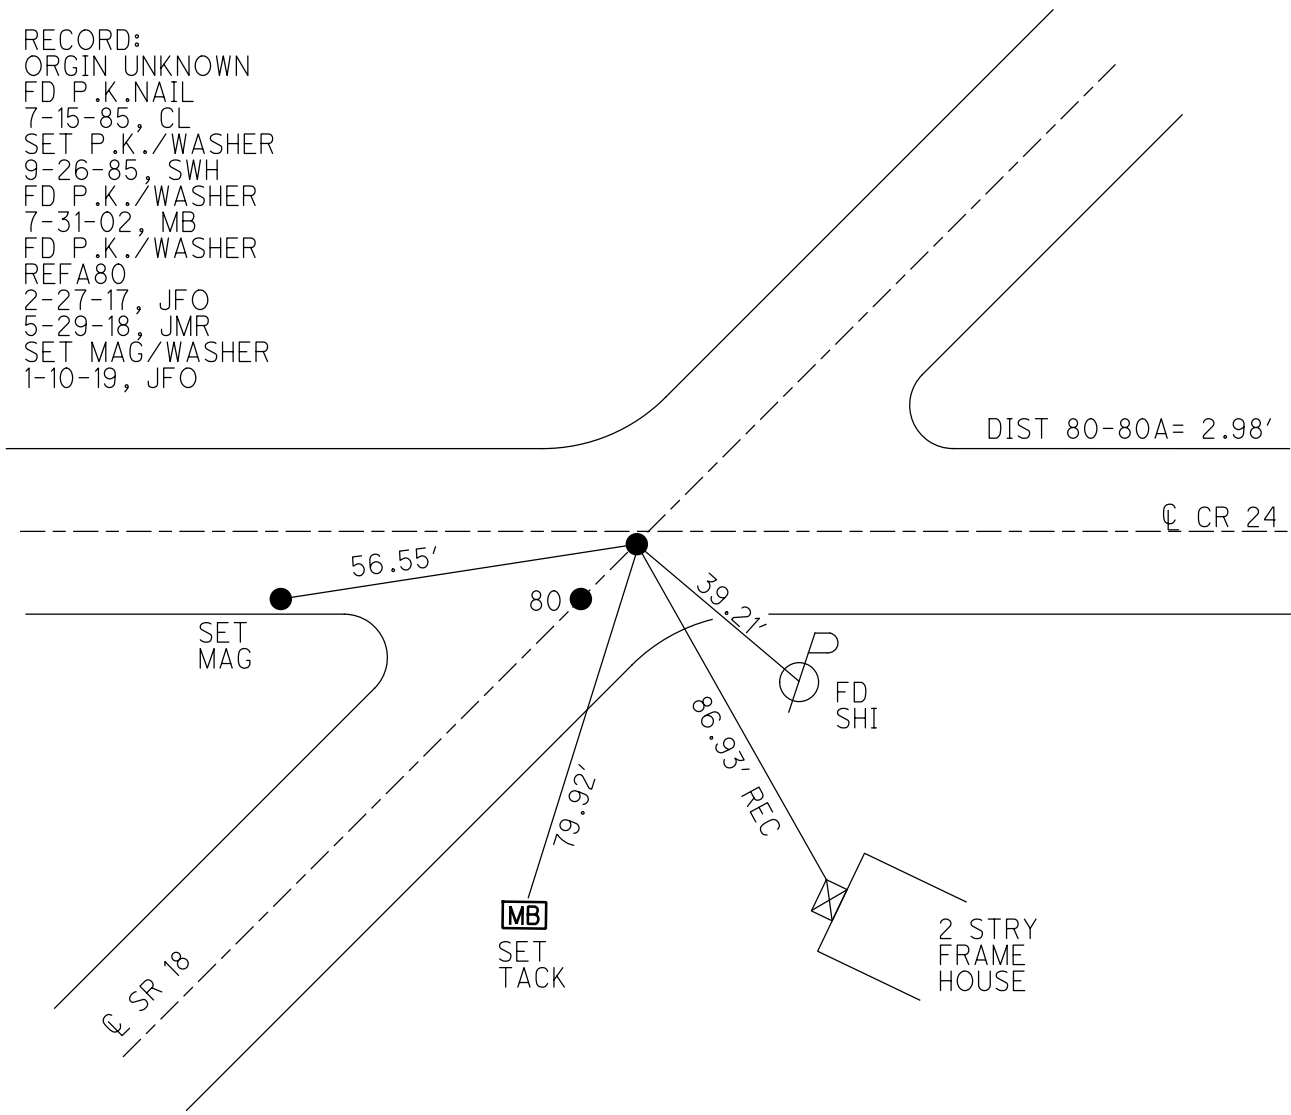

O.D.O.T. DISTRICT 2 SURVEY OFFICE

PERSONNEL _____

REFERENCE NO. 80

SHEET _____ OF _____

NOTES Loffman

H.C. Loehcke

R.C. BARNHISEL

DATE 7-15-85

WEATHER Cloudy

TEMP. 75°

ROUTE 18

COUNTY Seneca

TOWNSHIP Scipio

SECTION 2

T2 N R 16 E

TYPE MONUMENT SMALL SPK (A)


ON SURFACE - BELOW Yes

LEFT - to PAVT. - RIGHT Yes [3.5' S of Rd 24 EAST]

TO EDGE PAVEMENT

S.L.M. 1373+57

Set P.K./WASHER @ BOTH POINTS 9-26-85 SICK

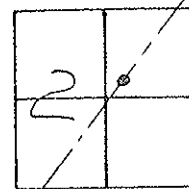


Record: (A)

P.I.

$\Delta = 0^{\circ}-34' RT.$

153 + 31.08

"B" = Fd P.K. @ SURFACE - ORIGIN UNKNOWN 2.96' North of "A"

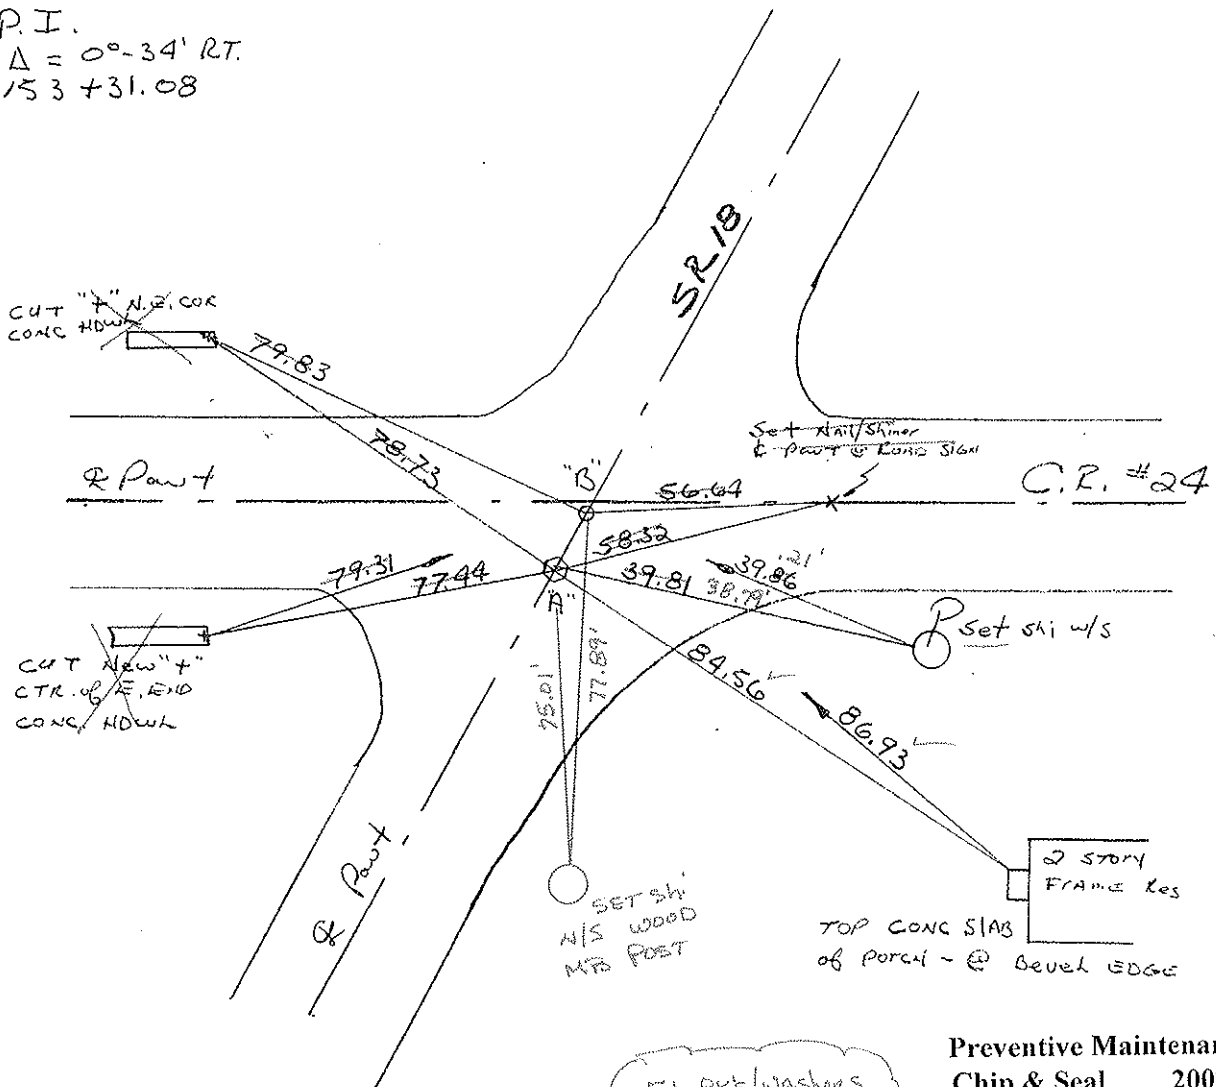

Preventive Maintenance
 Chip & Seal 2002
 Existing Point Uncovered
 Date 12-05-02

O.D.O.T. DISTRICT 2 SURVEY OFFICE

PERSONNEL _____

REFERENCE NO. 80

SHEET _____ OF _____

NOTES Hoffman

H.C. LOEHRKE

DATE 7-15-85

ROUTE 18

R.C. BAENHISEL

WEATHER Cloudy

COUNTY Seneca

TEMP. 75°


TOWNSHIP Scipio

SECTION 2

T 2 N R 16 E

TYPE MONUMENT SMALL SPK (A)
 ON SURFACE - BELOW yes
 LEFT- & PART - RIGHT yes [3.5' S. of Ed 24 EAST]
 TO EDGE PAVEMENT
 S.L.M. 1373+57

Set P.K./WASHER
 @ BOTH POINTS
 9-26-85
 SCAL

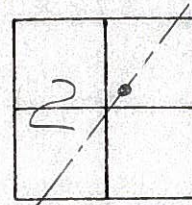

Record: (A)

"B" = Fd P.K. @ SURFACE - ORIGINAL UNKNOWN
 2.96' Northerly of "A"

P.I.
 $\Delta = 0^\circ - 34' RT.$
 153 + 31.08

