

LD-5
5-92

State of Ohio Department of Transportation
Field Notes

SHEET NO. 2 of 2

PERSONNEL	TITLE	PERSONNEL	TITLE	COUNTY	Seneca	DATE	7-21-93
Loehrkke	HA						
CANTERBURY	φ			S. R.	S.R. 19	WEATHER	Cloudy
ROMERO	φ			SEC.	607-Resurf.	TEMP.	+72

DESCRIPTION Profile - UNDER RAILROAD OVERPASS - Structure Sen-19-852 JOB NO.

Sta	+	-	CENTER LINE		Elev.	RIGHT
			LEFT	RIGHT		
B.M.	4116	(865.18)			861.02	S. E. Wing wall, Top S.W. CORNER of Lower Course STONE (FROM NOTES pg 9-15-92 BY HANDSEN)
			Lt Edge		4	Rt Edge
			PAVT		PAVT	
447+00			3.64		3.84	3.45
+25			4.06		3.68	3.86
+50			4.37		4.03	4.20
+75			4.64		4.36	4.54
448+00			4.92		4.63	4.77
+25			5.27		4.94	4.99
+50			5.46		5.14	5.17
+75			5.51		5.21	5.21
449+00			5.52		5.32	5.26
+25			5.70		5.50	5.45
+50			5.76		5.62	5.57
+75			5.69		5.59	5.70
450+00			5.72		5.64	5.71
+25			5.58		5.66	5.68
+50			5.67		5.61	5.77
+75			5.71		5.71	5.88
451+00			5.72		5.76	5.98
			5.74		5.74	5.88

LD-5
5-92

State of Ohio Department of Transportation
Field Notes

SHEET NO. 1072

PERSONNEL
LOEHARKE
CANTERBURY
RANETO

TITLE

PERSONNEL

COUNTY Seneca


DATE 7-21-93

WEATHER Pt Cloudy

TEMP. +72

DESCRIPTION Location of OVERHEAD RAIL ROAD BRIDGE

JOB NO. _____

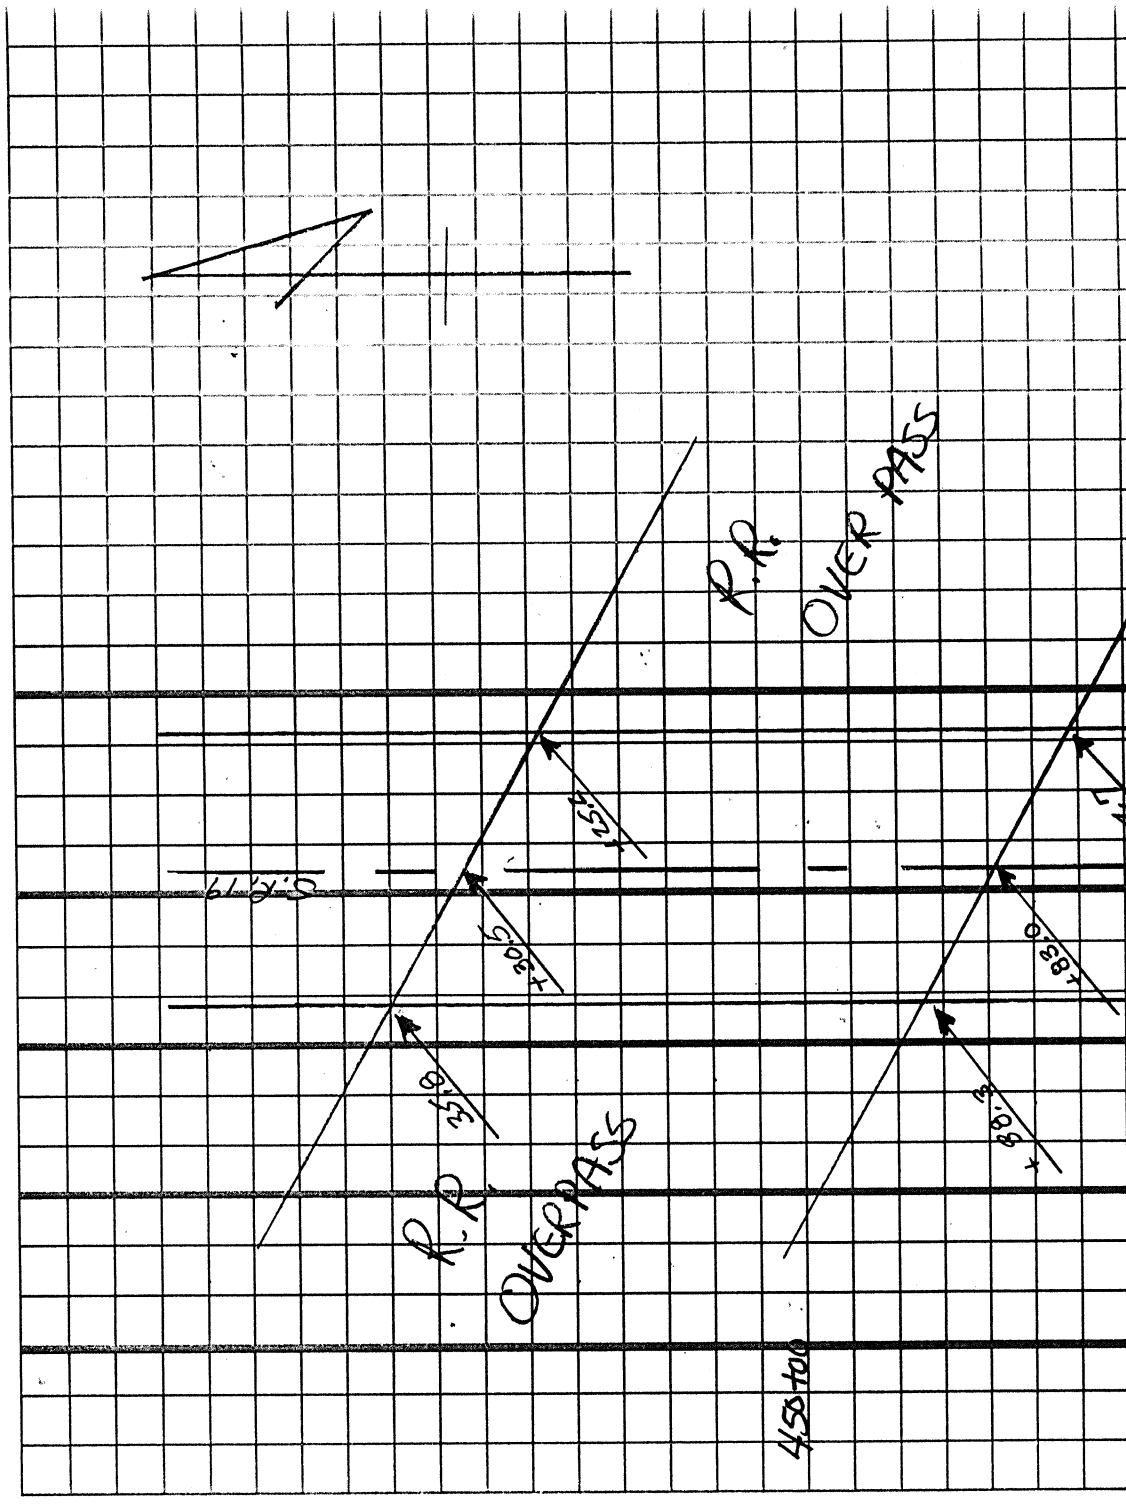

LD-5
5-92

State of Ohio Department of Transportation
Field Notes

SHEET NO. 2 of 2

PERSONNEL Loehrke TITLE HA PERSONNEL _____ TITLE _____
Cantabury φ S.R. S.R. 19 WEATHER Cloudy
Romero φ SEC. 607-Resurf. TEMP. +72

DESCRIPTION Profile - UNDER RAILROAD OVERPASS - Structure Sen-19-852 JOB NO. _____

Sta	+	-	CENTER LINE		ELEV.	RIGHT
			LEFT	RIGHT		
Bgn.	4+16	7	865.18	361.02	S.E. Wingwall, Top S.W. CORNER of Lower Causeway STONE (FROM NOTES pg 9-15-92 BY Vandusen)	
				4		
				Lt Edge		
				PAVT		
447+00				3.64	PAVT	3.45
+25				4.06		3.86
+50				4.37		4.20
+75				4.64		4.54
448+00				4.92		4.77
+25				5.27		4.99
+50				5.46		5.17
+75				5.51		5.21
449+00				5.52		5.26
+25				5.70		5.45
+50				5.76		5.57
+75				5.69		5.70
450+00				5.77		5.71
+25				5.58		5.68
+50				5.67		5.77
+75				5.71		5.88
451+00				5.72		5.98

TITLE

1

1

COUNTY Seneca

DATE _____

8-10-93

1

1

✓

1

1

S.R. 28.19

THER

Loudy

1

21

3

SEC. 9.07

IMP. —

24

1001

1

10

3. NO

CE

E

RIGHT

ON

1

