

O.D.O.T. DISTRICT 2 SURVEY OFFICE (USE ONLY)

PERSONNEL

REFERENCE NO. 51

SHEET 8 OF 10

NOTES LOEHRKE

DATE 6-17-94

ROUTE SR 19

H.C. CANTERBURY

WEATHER NICE

COUNTY SENECA

R.C. VOGEL

TEMP. 94°

TOWNSHIP SCIPIO

DWG BY NIESE PID 107060

SECTION 22

T 2 N R 16 E

TYPE MONUMENT P.K./WASHER

ON SURFACE - ~~BELOW~~ ON

OFFSET C PAVEMENT 0.8' LT : ~~RT~~

10.8' TO LT EDGE PAVEMENT


STATION: 433+23

HORZ.DATUM: NAD83(2011)


GEOID: 2012A

GRID: NORTHING: 527042.108

EASTING: 1826476.459

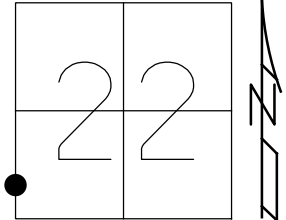

RECORD P.O.T.
 STA 199+00
 SET P.K./WASHER
 8/9/94, CAL
 FD P.K./WASHER
 1" DOWN
 REF51
 3/5/19, JFO
 FD P.K. NAIL
 8/22/19, JMR

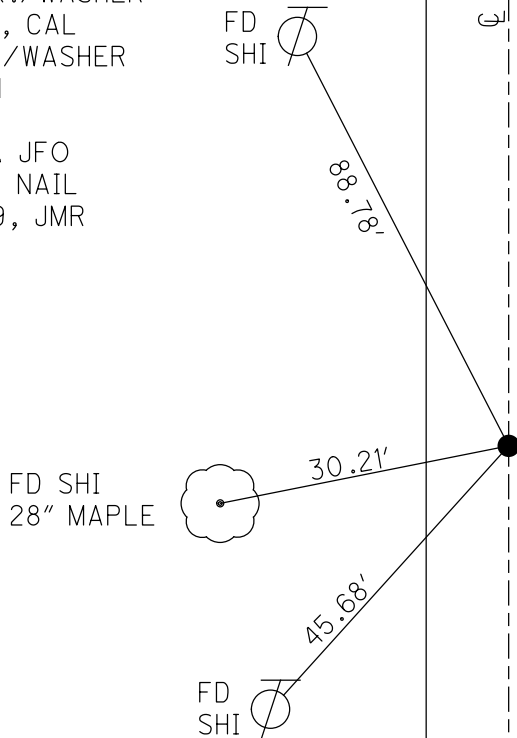

O.D.O.T. DISTRICT 2 SURVEY OFFICE

PERSONNEL _____

REFERENCE NO. 51

SHEET 8 OF 26

NOTES Loehke

M.C. Campbell

R.C. Wood

DATE 6.17.94

WEATHER Nice

TEMP. +94

ROUTE S.R. 19

COUNTY SENECA

TOWNSHIP Scipio

SECTION 22

T. 2 N. R. 16 E.


TYPE MONUMENT P.K. / WASHER

ON SURFACE - BELOW YES

LEFT - & PAVT. - RIGHT 0.8' Lt


10.80 Lt EDGE PAVEMENT

S.L.M. 433+23

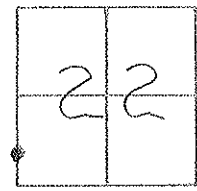

RECORD P.O.T.
Sta 199+00

SET PK & WASHER 8/9/94
C.A.L.

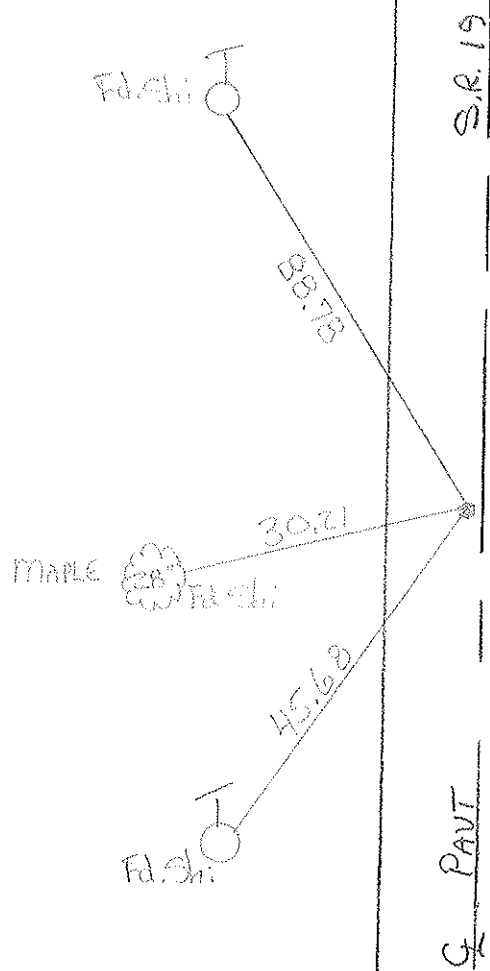

Q.D.O.T. DISTRICT 2 SURVEY OFFICE

SHEET _____ OF _____

County Seneca S.R. #19

Date Drawn 1/11/84 9/3/85

Township Scipio

Weather SUNNY

Section 21 & 22


Temp. 85°

T2N, R16E

Personnel CRONIN

RIPPLE

GEYMAN

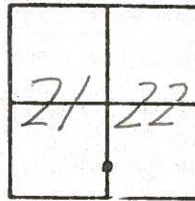

51




P.O.T.

199+00

SET P.K. & WASHER ATOP P.K.

WASHER ATOP R.R. SPIKE

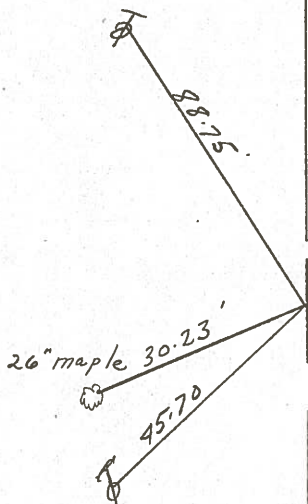

S.S.R. #997

PERSONNEL TITLE PERSONNEL TITLE

Ash
Cronin
Ripple
Anderson

COUNTY Seneca

S. R. # 19

WEATHER sunny

SEC. #

TEMP. 70°

DESCRIPTION Ties for Control Points - Bloomville North

JOB NO.

LEFT

CENTER LINE

RIGHT


No corrections necessary

Scipio Twp.

218+20.40

Set small R.R. spb.
Used S.H. (I.C.H.) #485
1929 Plans to reset
point. Original tie points
in bad shape - retied to
different points

#52

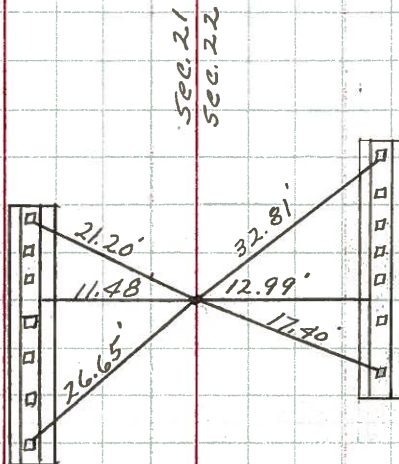


Scipio Twp.

P.O.T.

199+00

Fd. R.R. 2" down.
Raised to Surface


#51

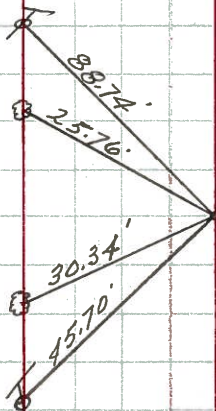


PERSONNEL TITLE PERSONNEL TITLE COUNTY SENNECA DATE 8-4-69
MOSSER _____
BARBOUR _____
POTTS _____
 S. R. # 19 WEATHER HOT
 SECUS 224 - NORTH TEMP. 75°

DESCRIPTION TIES FOR CONTROL POINTS JOB NO. _____
 LEFT CENTER LINE RIGHT


54

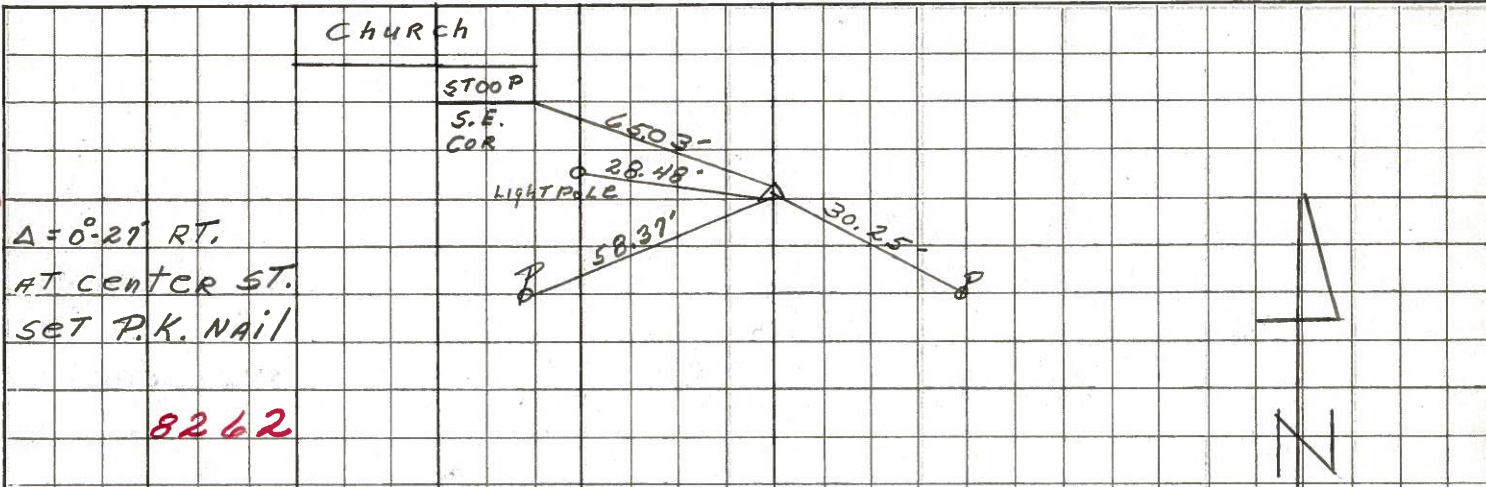

53

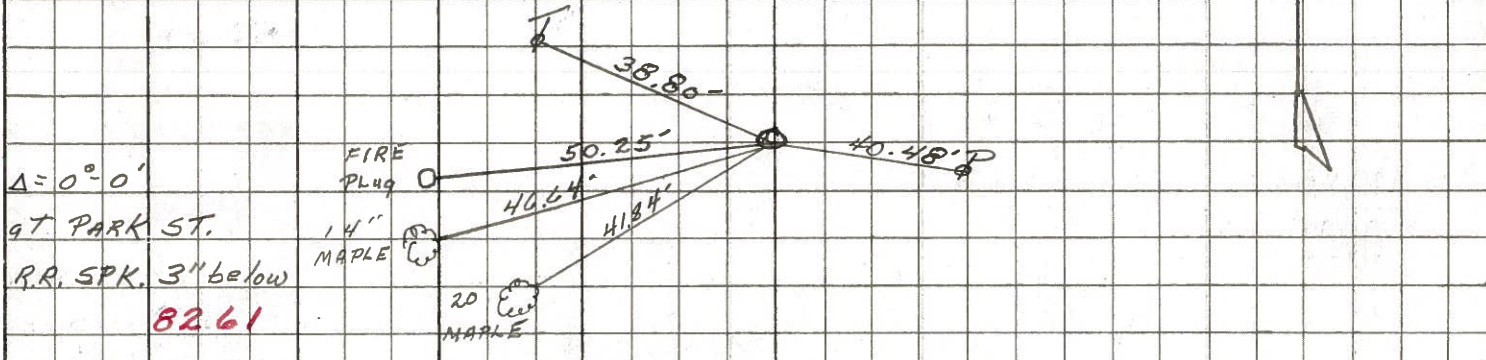

52

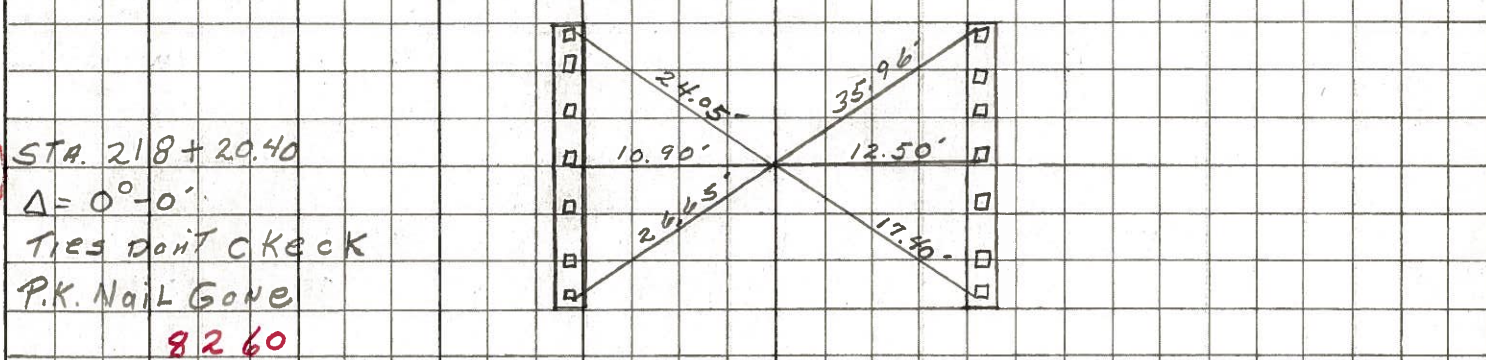

51

