


O.D.O.T. DISTRICT 2 SURVEY OFFICE (USE ONLY)


PERSONNEL _____ REFERENCE NO. 79 A SHEET 26 OF 27

NOTES RHOADES DATE 6-4-18 ROUTE SR 19
 H.C. O'DONNELL WEATHER CLOUDY COUNTY SENECA
 R.C. TRENKA TEMP. 64° TOWNSHIP ADAMS
 SECTION 5
 T 3 N R 16 E

TYPE MONUMENT MAG/WASHER
 ON SURFACE - ~~BELOW~~ ON
~~LEFT~~ - ℄ PAV'T - RIGHT 3.5'
 - TO - EDGE PAVEMENT
 S.L.M. 1057+54.16

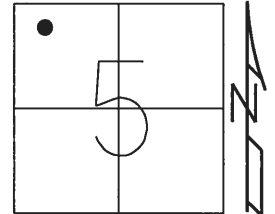

GRID: NORTHING: 578681.447 EASTING: 1816694.989

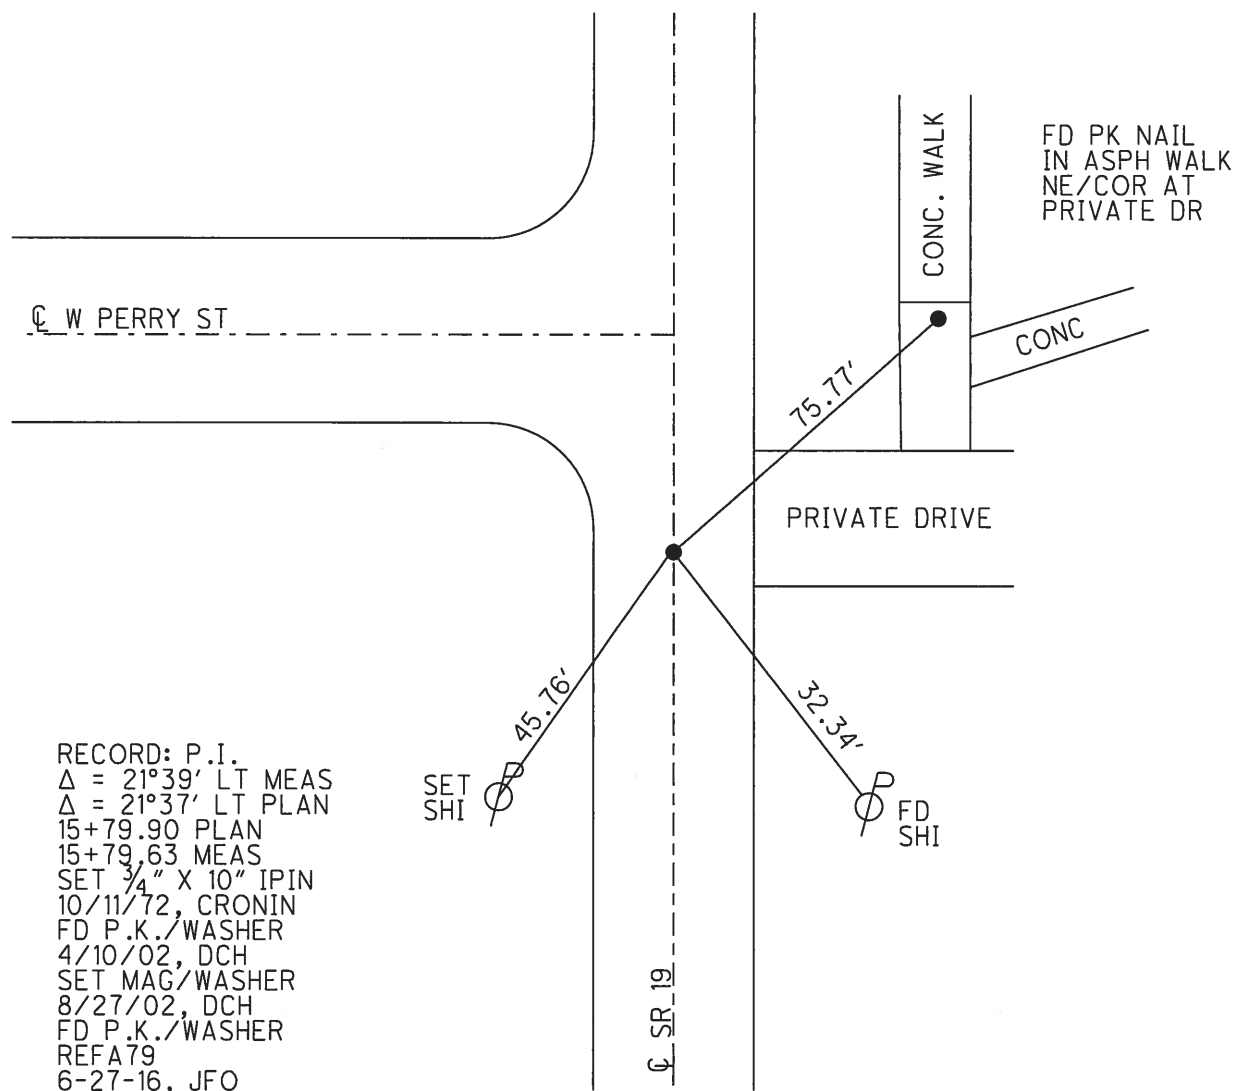


RECORD: P.I.
 $\Delta = 21^\circ 39'$ LT MEAS
 $\Delta = 21^\circ 37'$ LT PLAN
 15+79.90 PLAN
 15+79.63 MEAS
 SET $\frac{3}{4}$ " X 10" IPIN
 10/11/72, CRONIN
 FD P.K./WASHER
 4/10/02, DCH
 SET MAG/WASHER
 8/27/02, DCH
 FD P.K./WASHER
 REFA79
 6-27-16, JFO


O.D.O.T. DISTRICT 2 SURVEY OFFICE (USE ONLY)

PERSONNEL _____ REFERENCE NO. 79 A SHEET 1 OF 2
 NOTES ROUSOS _____ DATE 4/10/02 _____ ROUTE SR 19
 H.C. HOMAN _____ WEATHER SUNNY _____ COUNTY SENECA
 R.C. ROUSOS _____ TEMP. 50° _____ TOWNSHIP ADAMS
 _____ SECTION 5
 _____ T 3 N R 16 E

TYPE MONUMENT P.K./WASHER
 ON SURFACE - ~~BELOW~~ ON
 LEFT - ☉ PAV'T - RIGHT ON
_____ TO _____ EDGE PAVEMENT
 S.L.M. 1058+77
 GRID: NORTHING: _____ EASTING: _____

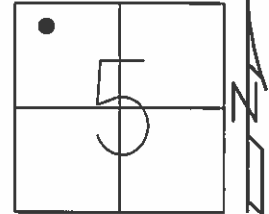

RECORD: P.I.
 $\Delta = 21^{\circ}39'$ LT MEAS
 $\Delta = 21^{\circ}37'$ LT PLAN
 15+79.90 PLAN
 15+79.63 MEAS
 SET $\frac{3}{4}$ " X 10" IRON ROD
 10/11/72, CRONIN
 SET MAG/WASHER
 8/27/02, DCH

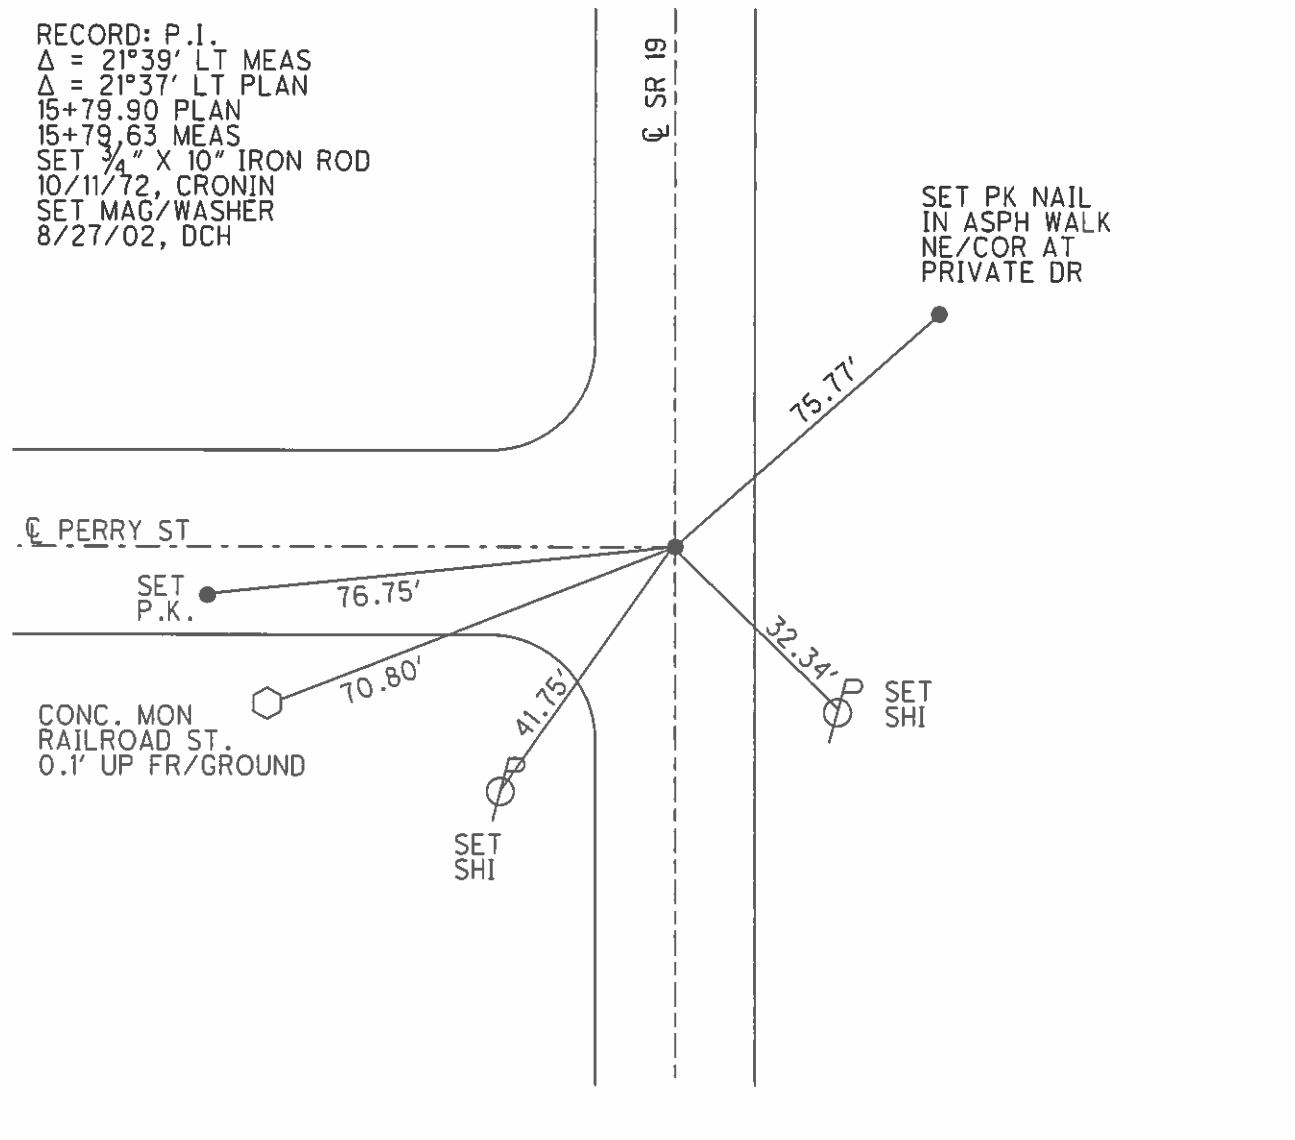

O.D.O.T. DISTRICT 2 SURVEY OFFICE

PERSONNEL

REFERENCE NO. 79-A SHEET 1 OF 2

NOTES ROUSOS

DATE 4-10-02

ROUTE SR 19

H.C. HOMAN

WEATHER SUNNY

COUNTY SENECA

R.C. ROUSOS

TEMP. 50°

TOWNSHIP ADAMS

SECTION 5

T 3 N R 16 E


TYPE MONUMENT PK NAIL & WASHER

ON SURFACE - BELOW ON

LEFT - Q PAV'T - RIGHT ON


TO EDGE PAVEMENT

S.L.M. 1058 + 77

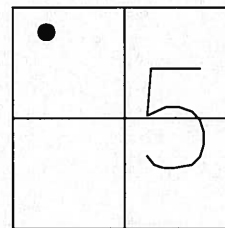

DELTA 21°39' LT MEAS
 DELTA 21°37' LT PLAN
 PI 15+79.90 PLAN
 15+79.63 MEAS
 SET 3/4" X 10" IRON ROD

SET MAG NAIL
 & WASHER
 8-27-02 DCH

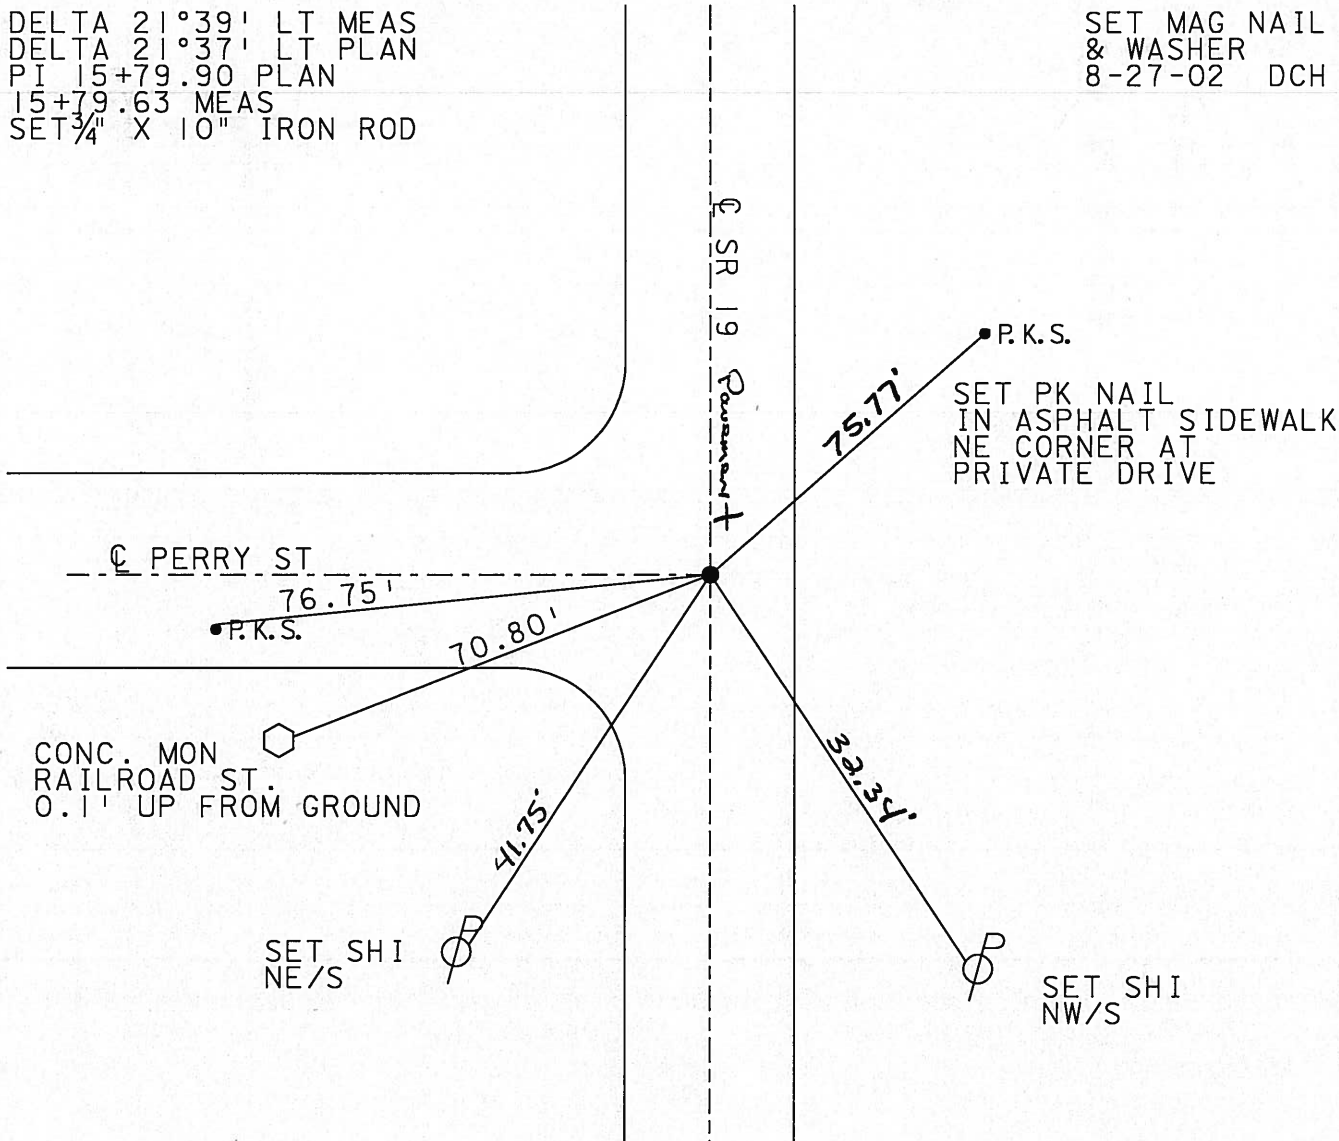

PERSONNEL TITLE PERSONNEL TITLE

Ash
Cranin
Ripple
Anderson

COUNTY Seneca DATE 10/11/72

S. R. #19 (I.C.H 515) WEATHER overcast

SEC. TEMP. 68°

DESCRIPTION Ties for Control Points - Republic - North JOB NO.

LEFT CENTER LINE RIGHT

