


O.D.O.T. DISTRICT 2 SURVEY OFFICE (USE ONLY)

PERSONNEL _____ REFERENCE NO. 81 SHEET 27 OF 27

NOTES RHOADES DATE 6-4-18 ROUTE SR 19
 H.C. O'DONNELL WEATHER CLOUDY COUNTY SENECA
 R.C. TRENKA TEMP. 64° TOWNSHIP ADAMS
 _____ SECTION 5
 _____ T 3 N R 16 E


TYPE MONUMENT MAG/WASHER
 ON SURFACE - ~~BELOW~~ ON
~~LEFT - C~~ PAV'T - ~~RIGHT~~ ON
TO EDGE PAVEMENT
 S.L.M. 1068+49.11

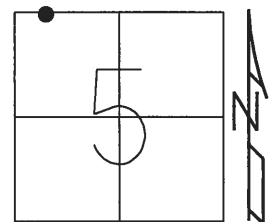

GRID: NORTHING: 579776.275 EASTING: 1816711.192

RECORD:
 $\Delta = 0^\circ 02' 00''$ RT
 STA.26+74.85
 P.K./WASHER ATOP
 MINE SPIKE OVER
 "X" CUT IN BRICK
 10/11/72, CRONIN
 FD P.K./WASHER
 4/10/02, DCH
 SET MAG/WASHER
 8/27/02, DCH
 FD R.R. SPIKE
 REF81
 6-27-16, JFO
 SET MAG/WASHER
 BY COORD
 6-4-18, JFO

NOTE: SAN 19 REF 1

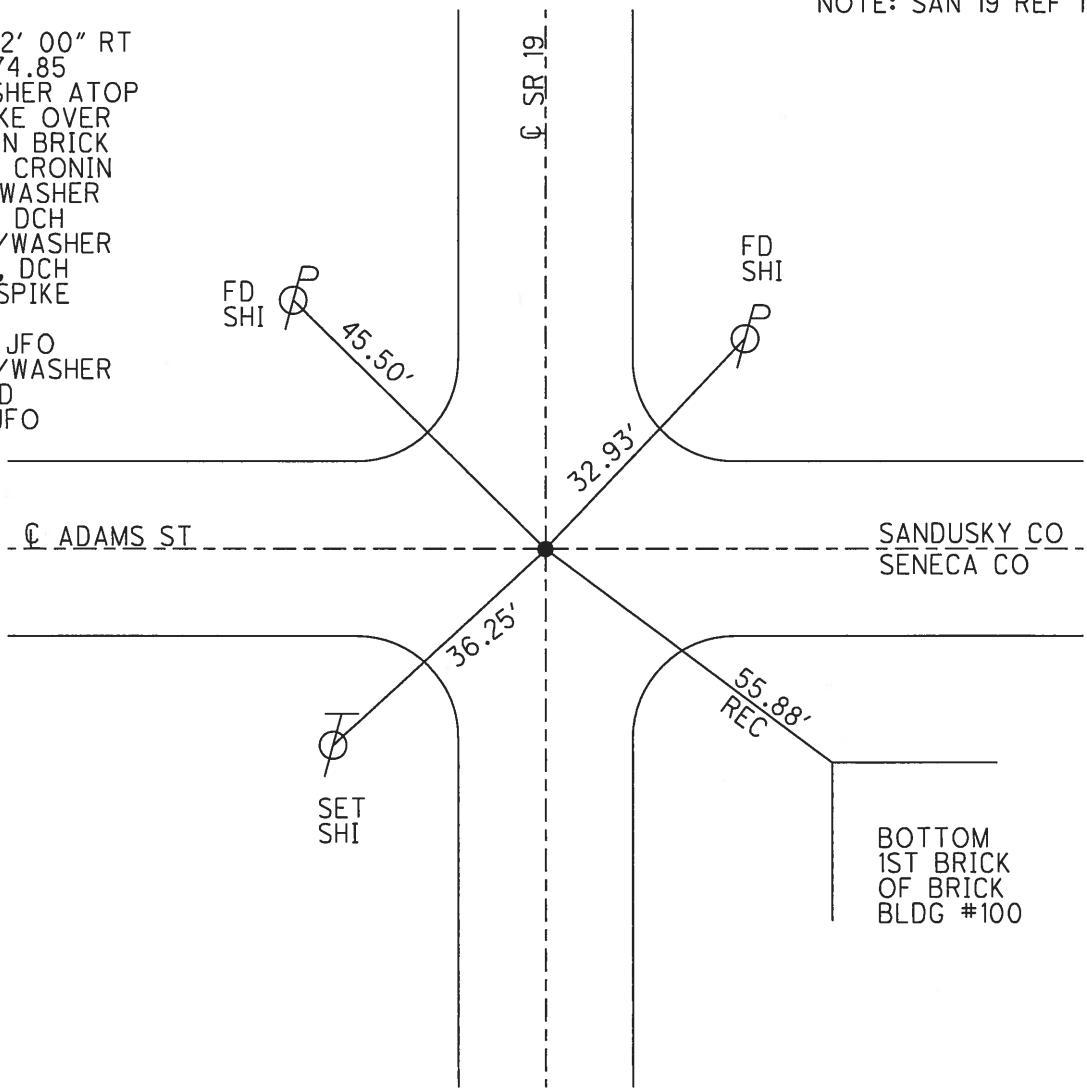


O.D.O.T. DISTRICT 2 SURVEY OFFICE (USE ONLY)

PERSONNEL _____ REFERENCE NO. 81 SHEET 2 OF 2


NOTES ROUSOS DATE 4/10/02 ROUTE SR 19
 H.C. HOMAN WEATHER SUNNY COUNTY SENECA
 R.C. ROUSOS TEMP. 50° TOWNSHIP ADAMS
 SECTION 5
 T 3 N R 16 E

TYPE MONUMENT P.K./WASHER
 ON SURFACE - ~~BELOW~~ ON
 LEFT - ☉ PAV'T - RIGHT ON
 - TO - EDGE PAVEMENT
 S.L.M. 1069+74

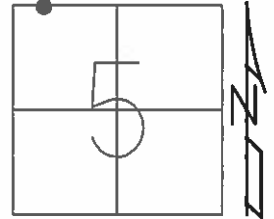

GRID: NORTHING: _____ EASTING: _____

RECORD:
 $\Delta = 00^{\circ}20'00''$ RT
 26+74.85
 P.K./WASHER OVER
 MINE SPIKE OVER
 "X" CUT IN BRICK
 10/11/72, CRONIN
 SET MAG/WASHER
 8/27/02, DCH

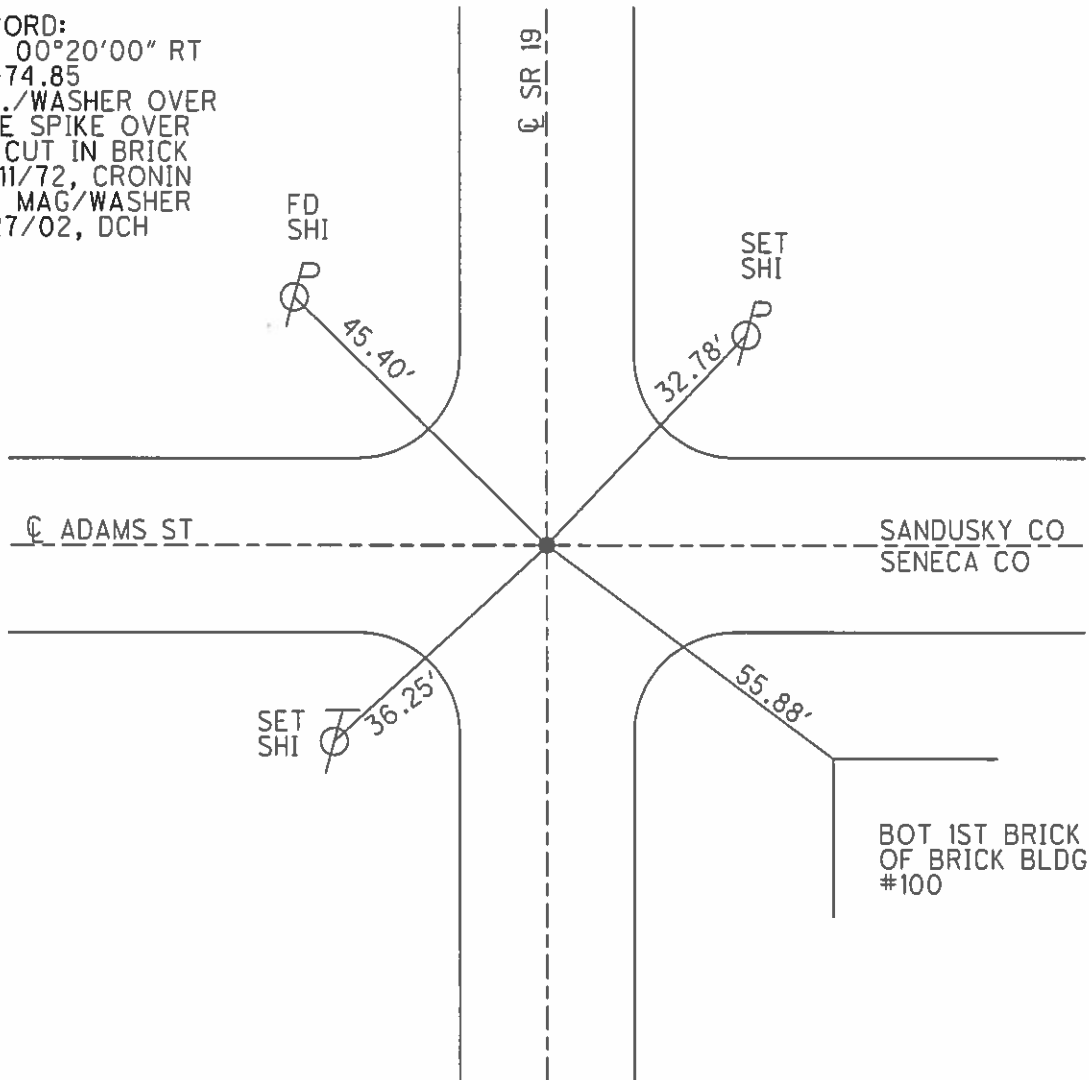

O.D.O.T. DISTRICT 2 SURVEY OFFICE

PERSONNEL _____

REFERENCE NO. 81

SHEET 2 OF 2

NOTES ROUSOS

DATE 4-10-02

ROUTE SR 19

H.C. HOMAN

WEATHER SUNNY

COUNTY SENECA

R.C. ROUSOS

TEMP. 50°

TOWNSHIP ADAMS

SECTION 5

T 3 N R 16 E


TYPE MONUMENT PK/WASHER

ON SURFACE - ~~BELOW~~ ON SURFACE


~~LEFT - Q~~ PAV'T - ~~RIGHT~~ ON CENTERLINE

TO EDGE PAVEMENT

S.L.M. 1069+74

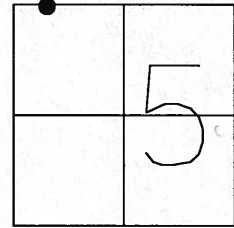

SET MAG NAIL
& WASHER
8-27-02 DCH

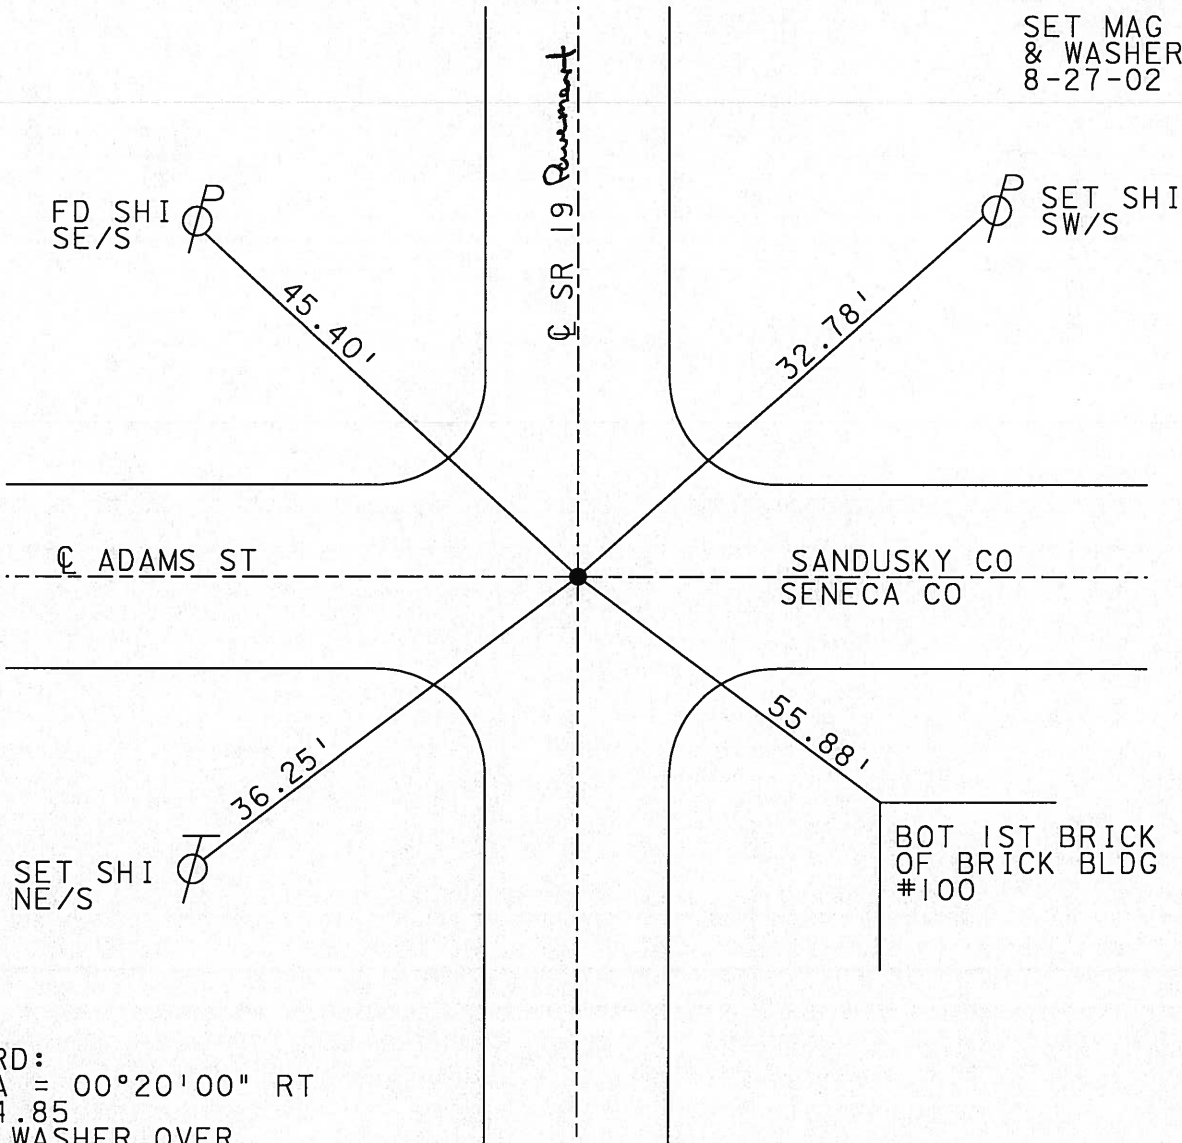

RECORD:
DELTA = 00°20'00" RT
26+74.85
PK & WASHER OVER
MINE SPIKE OVER
"X" CUT IN BRICK

