


SHEET NO. 1/5  
 COUNTY SENECA DATE 3/9/81  
 WEATHER cloudy  
 S. R. U.S. #23  
 SEC. 0.00 TEMP. 40°  
 JOB NO. 025910

PERSONNEL TITLE PERSONNEL TITLE  
BRUNN  
RIFFLE  
GEYMAN

DESCRIPTION Guard Rail Log CENTER LINE RIGHT LEFT



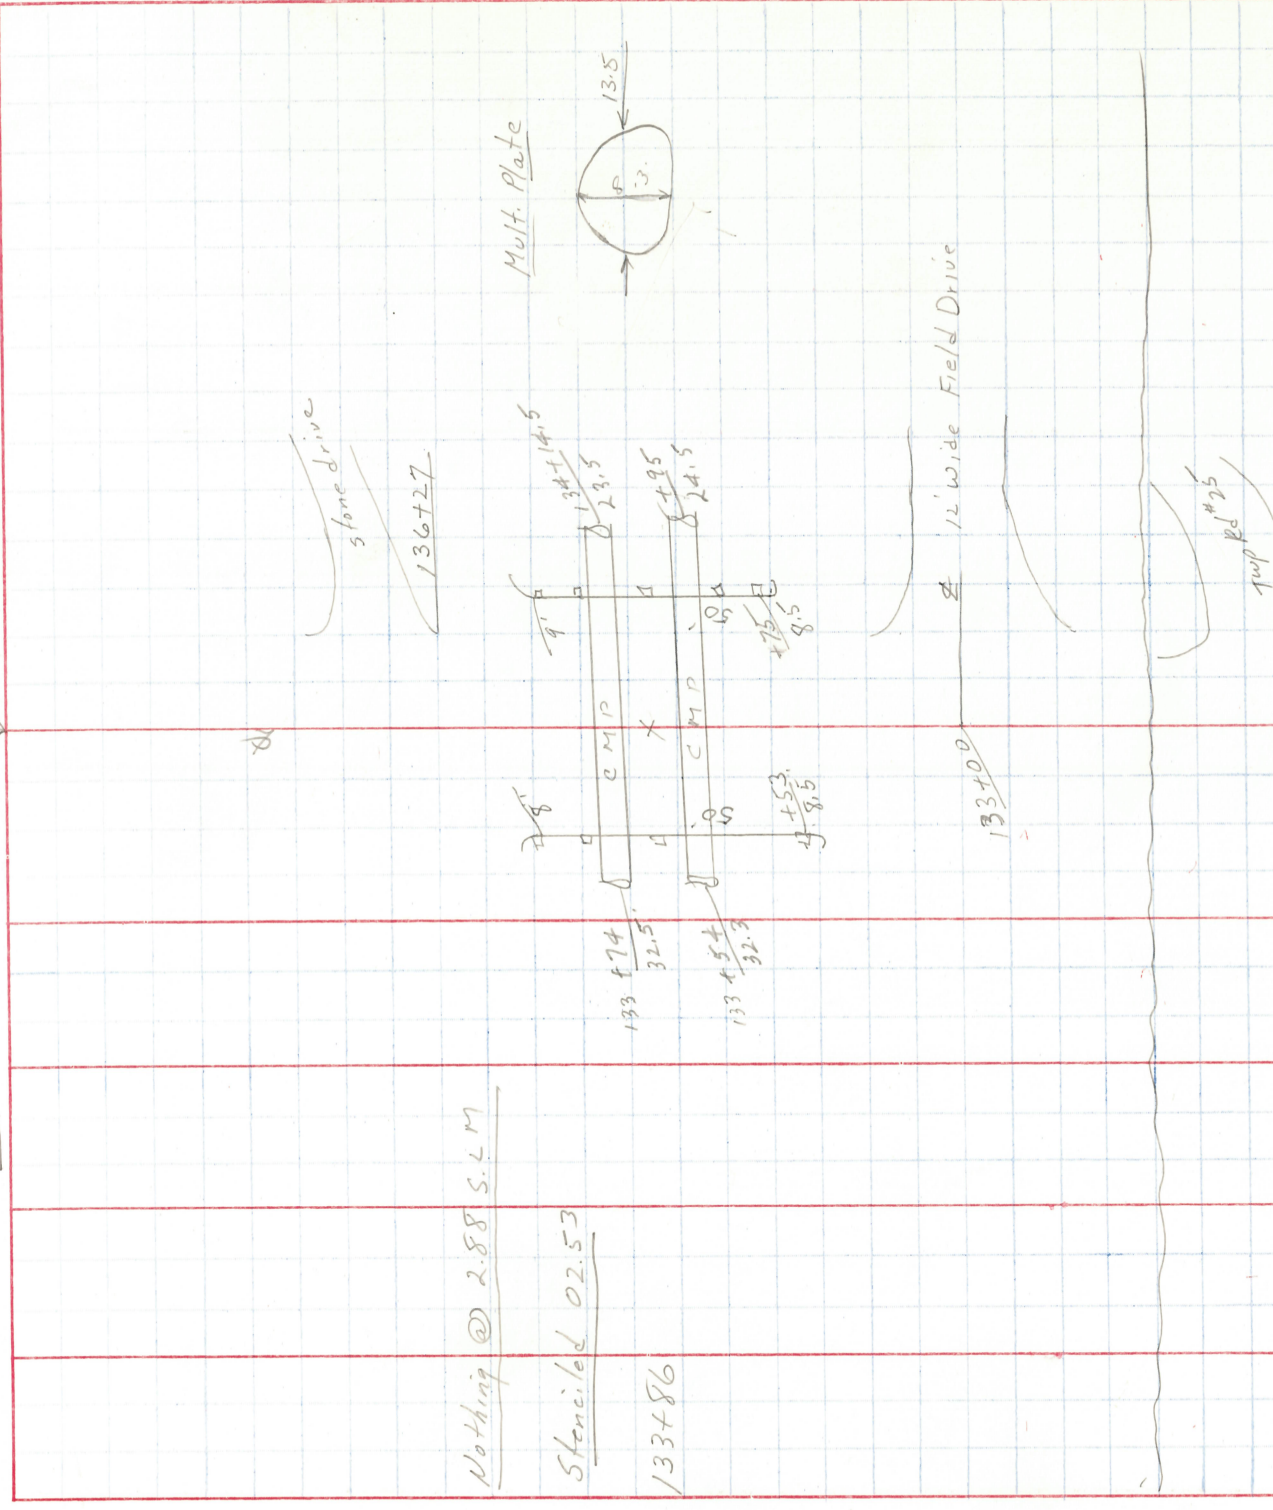



SHEET NO. 4/5

DATE 3/10/81

COUNTY SENECA

TITLE

PERSONNEL

TITLE

PERSONNEL

CRONIN

RIPPLE

GEYMAN

S. R. U.S. # 23

WEATHER OVERCAST

TEMP. 37°

SEC. 0.00


JOB NO. 025910

DESCRIPTION Guard Rail beg - Topo

RIGHT

CENTER LINE

LEFT

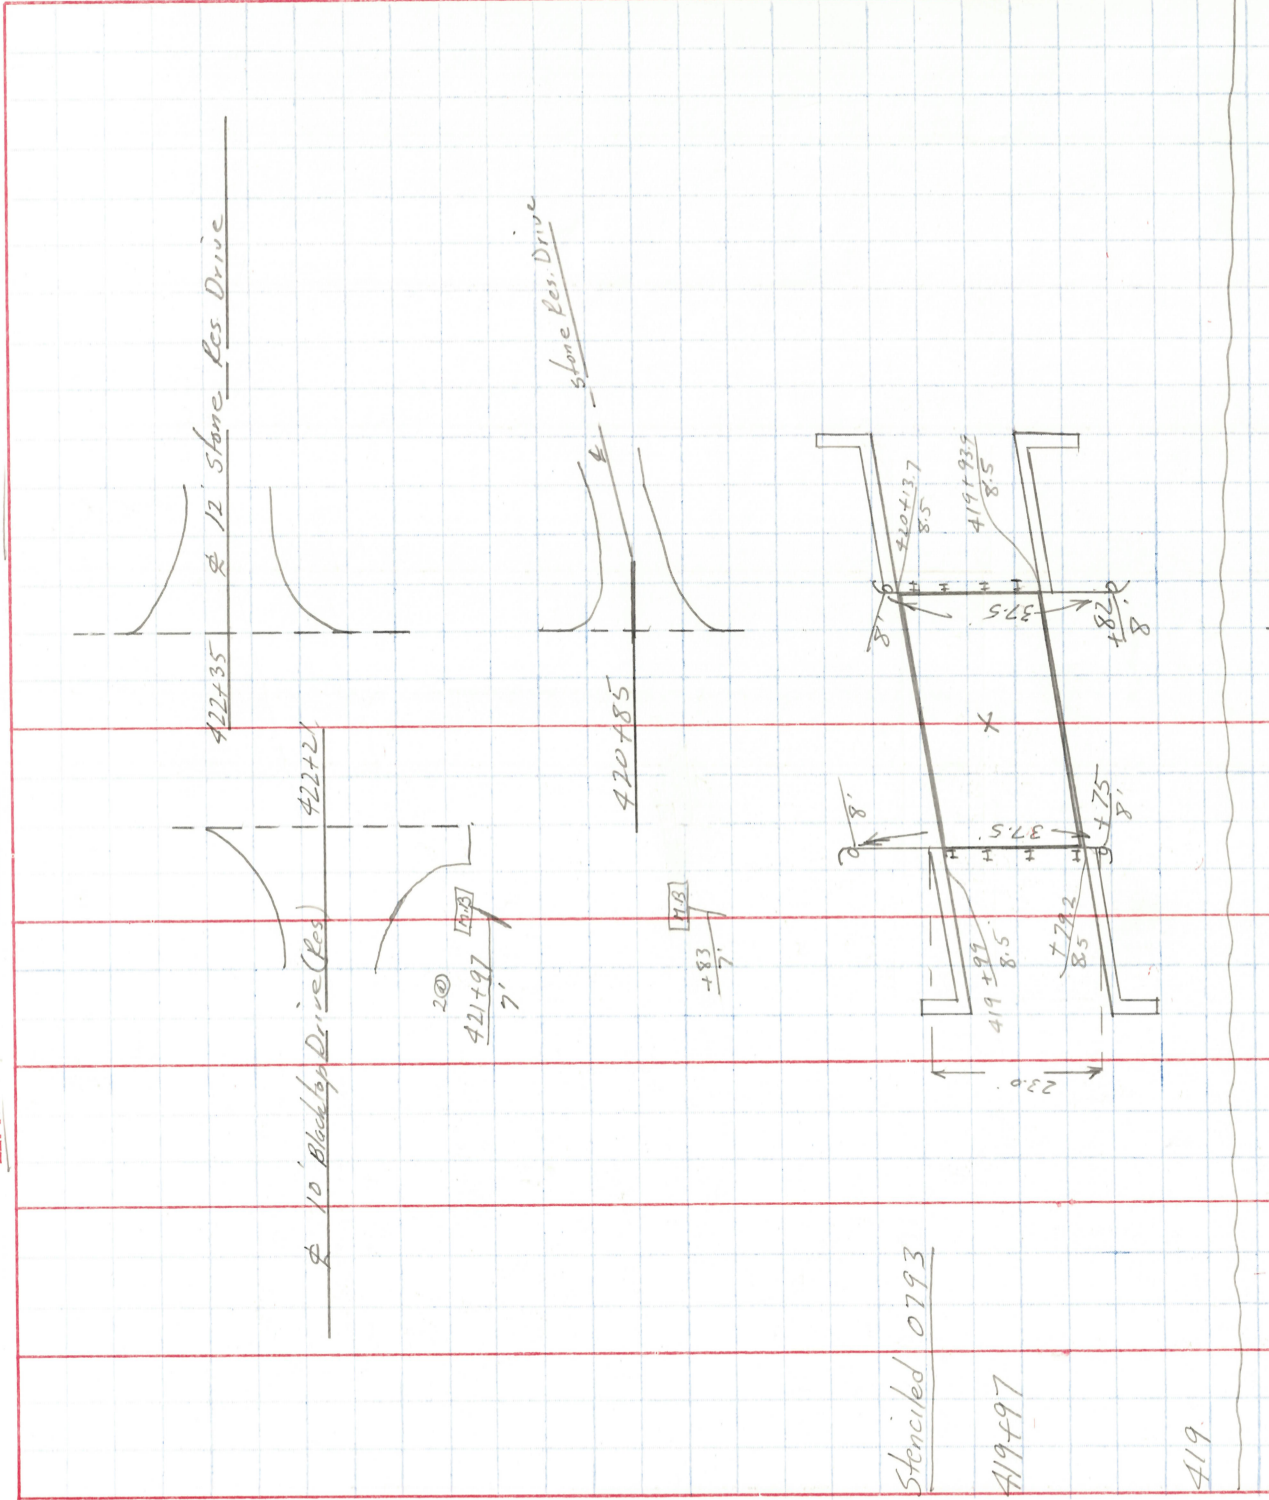

Stenciled 0793

419+97


419

SHEET NO. 5/5  
COUNTY SENECA  
DATE 3/10/81  
WEATHER OVERCAST  
TEMP. 40°

PERSONNEL TITLE  
CRONIN  
RIPPLE  
GEYMAN

S. R. V.S. #23  
SEC. 0.00  
JOB NO. 025910

DESCRIPTION Guard Rail Log - Top  
LEFT CENTER LINE RIGHT

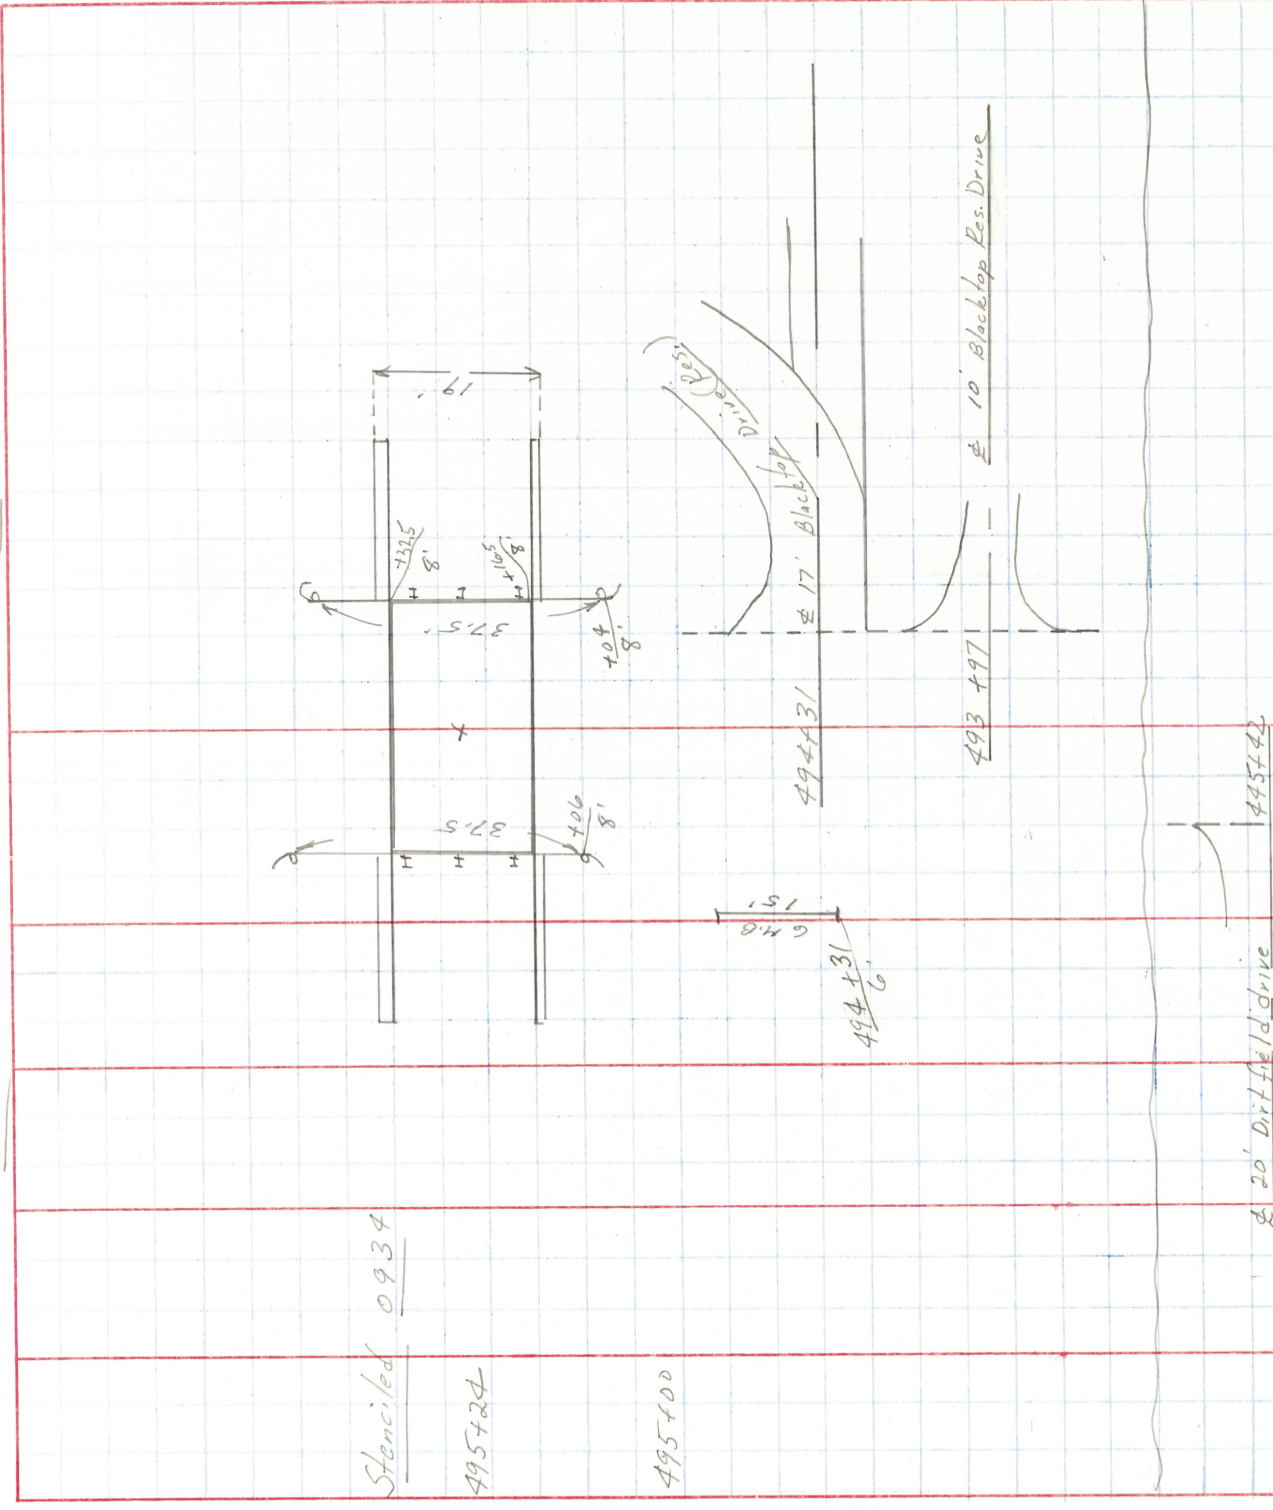

PERSONNEL TITLE PERSONNEL TITLE COUNTY SENECA DATE 3/18/81  
CRONIN WINDY  
RIPPLE SUNNY-COOL  
COYMAN S. R. U.S. # 23  
 SEC. 0.00 TEMP. 23°

JOB NO. 025910

DESCRIPTION X-SECTIONS CENTER LINE RIGHT

DESCRIPTION	LEFT	CENTER LINE	RIGHT
89+00	8.3 33	4.7 3 berr	2.7 10
89+38	2.1 19 11.0 19.4 2.1 2.6 3.6	4.8 3 4.4 0	3.0 11 6.3 19 2.2 22 FL-92"
89+75	8.3 31 9.1 28 2.5 7	4.5 3 4.2 9	2.7 9 8.2 4.4 4.7 4.9 5.0 5.0
133+20	10.0 49 10.8 41 11.9 41 3.7	2.1 3 2.3 0	5.3 9 8.3 2.2 3.1 3.4 3.8 5.4 7.0
133+86	12.4 35 15.6 35 16.2 51 6.3	1.6 4 1.7 0	3.4 0 3.7 3.5 7 1.9 1.9 5.6 8.9 12.6 2.8 2.8 15.8 2.8 3.0 3.0 14.4 3.0 4.3 12.8 6.2 13.1 5.2
133+74 Lt.		16.70	Flow Line 83x13.5± Mult. Plate
133+54 Lt.		16.54	"
134+145 Rt.		16.70	"
133+95 Rt.		16.74	"
242+75	5.1 24 6.0 18 4.3 11 3.7 6 3.6 0 E.P.	3.3 3 3.1 0 E.P.	4.1 8 6.3 18 6.7 2.0 5.1 2.4

ON Skew

PERSONNEL TITLE PERSONNEL TITLE COUNTY SEVECA DATE 3/18/81  
 CROWN  
 RIPPLE  
 GEYMAN  
 S. R. U.S. # 23 WEATHER sunny-cold  
 SEC. 0.00 TEMP. 23°

DESCRIPTION X - Sections CENTER LINE RIGHT JOB NO. 025910

DESCRIPTION	LEFT	CENTER LINE	RIGHT	JOB NO.													
258+45	55 25	68 21	73 20	70 19	66 16	39 8	32 3	312 0	3.12 E.P.	308 0	324 3	3.8 6	59 17	70 21	68 23	54 28	
258+90										315 0	3.30 3	3.95 8.7	Topc/v.				
259+30										316 0	3.3 3	4.0 8	6.6 19	6.8 21	5.9 28		
335+75	53 39	56 32	58 29	58 29	44 21	22 10	18 3	18 0	E.P.	267 0	28 3	3.6 9	48 15	5.3 17	4.7 22		
336+50										266 0	28 3	4.11 11	Topc/v.				
392+50	42 39	52 33	57 30	56 29	39 21	18 10	15 3	158 0		264 0	28 3	3.7 8	5.5 19	4.9 24			
392+94										222 0	23 3	3.1 10	47 19	4.3 21	2.1 28		
393+50										304 0	3.17 3	3.62 8.5	Topc/v.				
404+25	51 25	57 21	60 20	60 20	40 28	41 10	3.6 3	3.42 0		3.5 0	3.7 3	4.4 10	6.9 25	8.4 38	9.3 41	8.6 44	2.5 54
404+745										234 0	3.8 8	6.4 18	6.6 20	6.2 22	6.0 34		
										306 0	3.2 3	3.63 8.5	Topc/v.				

SHEET NO. 3/3

PERSONNEL TITLE PERSONNEL TITLE COUNTY SENECA DATE 3/19/81  
CRONIN WINDY  
RIPPLE WEATHER OVERCAST - SNOW  
GEYMAN

DESCRIPTION X - Sections CENTER LINE RIGHT JOB NO. 025910  
 LEFT

DESCRIPTION	LEFT	CENTER LINE	RIGHT
443+50	$\frac{6.7}{31}$ $\frac{7.6}{27}$ $\frac{8.2}{24}$ $\frac{8.1}{22}$ $\frac{4.6}{9}$	$\frac{4.0}{3}$ $\frac{3.8}{0}$ E.P. $\frac{3.9}{3}$ $\frac{3.78}{0}$	$\frac{3.78}{0}$ E.P. $\frac{4.0}{3}$ $\frac{4.6}{8}$ $\frac{2.2}{19}$ $\frac{2.3}{21}$ $\frac{2.2}{23}$ $\frac{2.0}{31}$
443+74	$\frac{4.26}{8.5}$ <i>Top coil</i>	$\frac{3.9}{3}$ $\frac{3.78}{0}$	$\frac{4.29}{8.5}$ <i>Top coil</i>
444+12	$\frac{5.3}{34}$ $\frac{7.4}{29}$ $\frac{7.4}{27}$ $\frac{7.9}{21}$ $\frac{4.5}{8}$	$\frac{3.9}{3}$ $\frac{3.73}{0}$	$\frac{3.9}{3}$ $\frac{4.6}{11}$ $\frac{6.4}{17}$ $\frac{6.8}{18}$ $\frac{6.4}{19}$ $\frac{6.1}{24}$
495+00	$\frac{4.1}{27}$ $\frac{5.7}{22}$ $\frac{6.6}{22}$ $\frac{6.6}{20}$ $\frac{5.9}{19}$ $\frac{3.8}{9}$	$\frac{3.2}{3}$ $\frac{2.89}{0}$	$\frac{2.81}{0}$ E.P. $\frac{2.9}{3}$ $\frac{3.3}{5}$ $\frac{4.1}{12}$ $\frac{6.4}{23}$ $\frac{6.3}{25}$ $\frac{5.4}{30}$
495+70	$\frac{4.9}{26}$ $\frac{6.0}{22}$ $\frac{6.3}{20}$ $\frac{6.2}{18}$ $\frac{4.0}{8}$	$\frac{3.0}{3}$ $\frac{2.85}{0}$	$\frac{2.80}{0}$ E.P. $\frac{3.0}{3}$ $\frac{3.56}{8}$ $\frac{3.05}{0}$ $\frac{3.2}{3}$ $\frac{4.2}{9}$ $\frac{2.0}{21}$ $\frac{2.3}{26}$ $\frac{8.1}{29}$ $\frac{2.2}{29}$ $\frac{6.5}{33}$