

O.D.O.T. DISTRICT 2 SURVEY OFFICE (USE ONLY)

PERSONNEL

REFERENCE NO. 1

SHEET 1 OF 22

NOTES O'DONNELL

DATE 5/11/21

ROUTE US 23

H.C. AUBLE

WEATHER SUNNY

COUNTY SENECA

R.C. NIESE

TEMP. 45°

TOWNSHIP BIG SPRING

SECTION 32

DWG BY RHOADES PID 85264

T 1 N R 13 E

TYPE MONUMENT SM.R.R.SPIKE

~~ON SURFACE~~ - BELOW 2"

OFFSET ☉ PAVEMENT 1.0' ~~±~~ : RT

- TO - EDGE PAVEMENT


STATION: 0+00

HORIZ.DATUM: NAD83 2011


GEOID: NAVD88 2012A

GRID: NORTHING: 484173.153

EASTING: 1724824.340

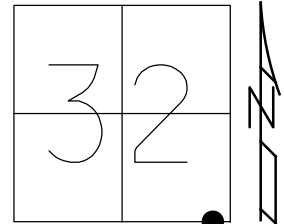

RECORD:
 SET P.K./WASHER
 10/31/89, SWH
 9/01/09
 FD R.R. SPIKE
 REF1
 4/15/19, JFO
 8/16/19, JFO
 FD SM.R.R.SPIKE
 2" DOWN
 5/11/21, JFO
 SET MAG/WASHER
 12/10/21, DSA

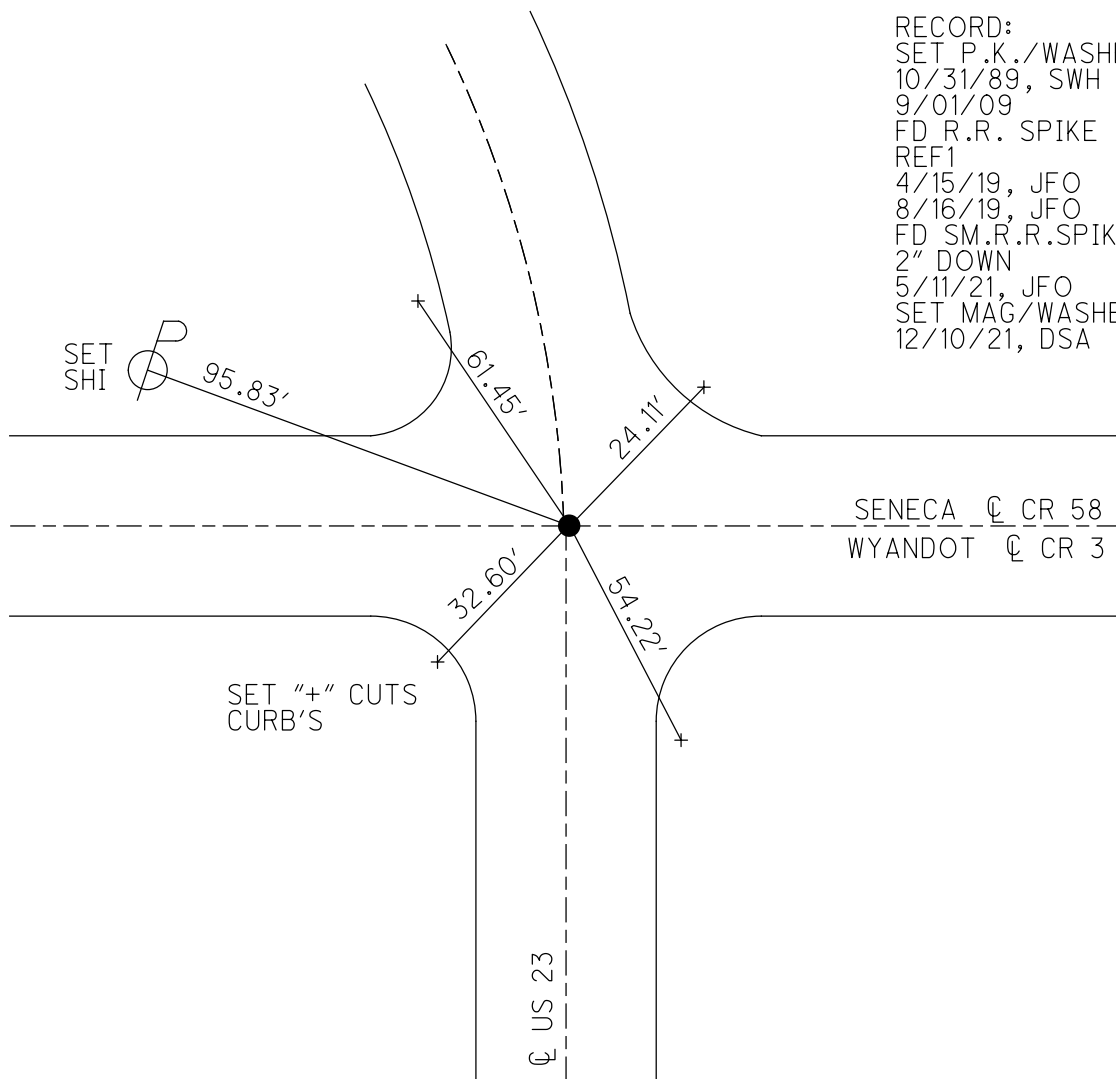

O.D.O.T. DISTRICT 2 SURVEY OFFICE (USE ONLY)

PERSONNEL

REFERENCE NO. 1

SHEET 1 OF 22

NOTES LOEHRKE

DATE 7/19/89

ROUTE US 23

H.C. HOFFMAN

WEATHER CLOUDY

COUNTY SENECA

R.C. BARNHISEL

TEMP. 75°

TOWNSHIP BIG SPRING

SECTION 32

DWG BY NASON

PID PT-SEN19

T 1 N R 13 E

TYPE MONUMENT SM. R.R. SPIKE

ON SURFACE - ~~BELOW~~ ON

OFFSET CL PAVEMENT 1.0' ~~ET~~ : RT

- TO 0 EDGE PAVEMENT


STATION: 0+00

HORZ. DATUM: NAD83 (2011)


GEOID: 2012A

GRID: NORTHING: 484173.153

EASTING: 1724824.340

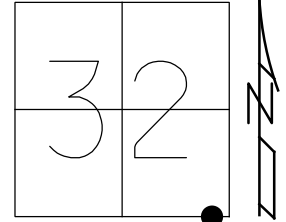


RECORD:
 SET P.K./WASHER
 10/31/89, SWH
 9/01/09
 FD R.R. SPIKE
 REF1
 4/15/19, JFO
 8/16/19, JFO

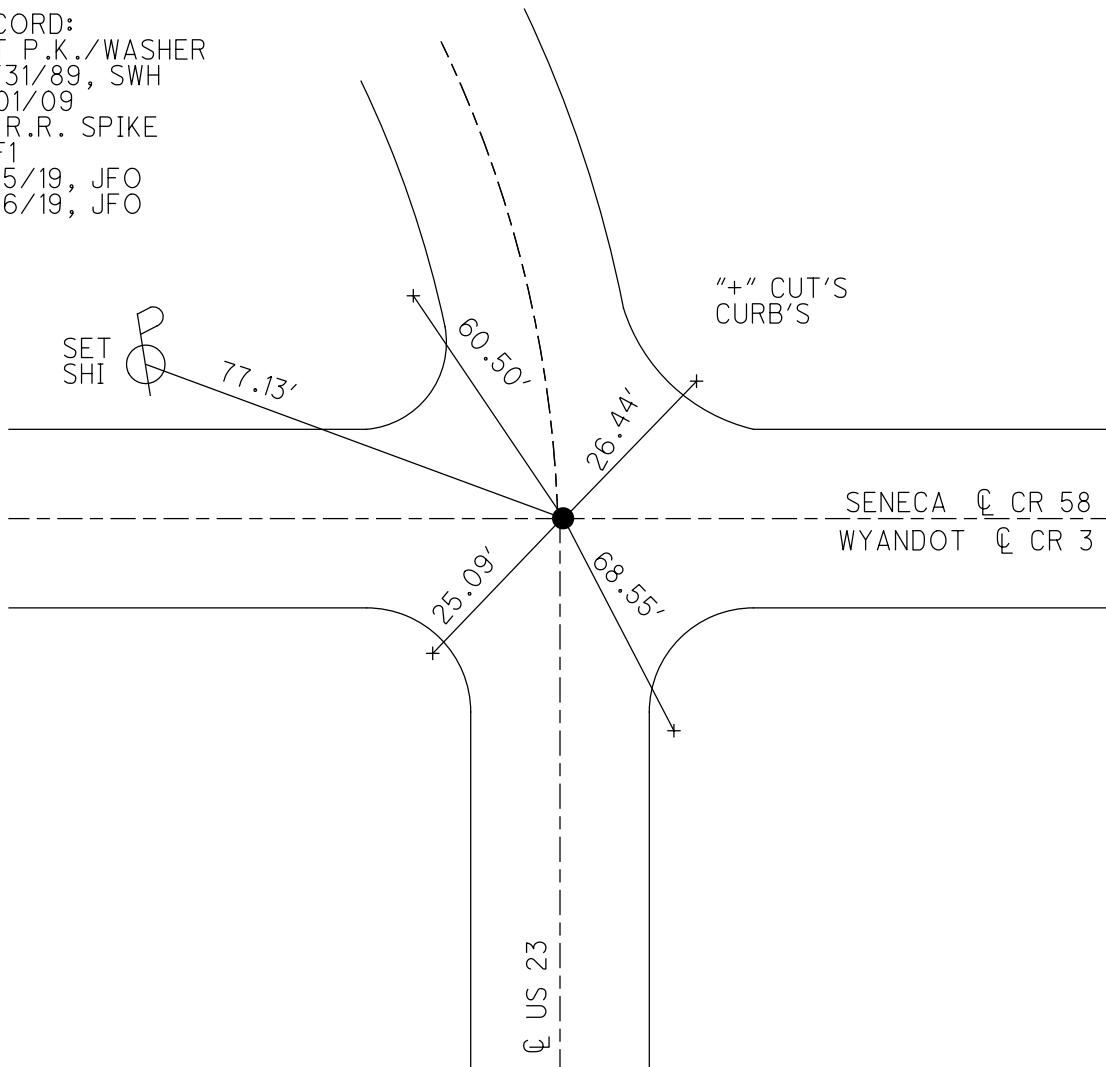

O.D.O.T. DISTRICT 2 SURVEY OFFICE (USE ONLY)


PERSONNEL _____ REFERENCE NO. 1 SHEET 1 OF 22
 NOTES LOEHRKE DATE 7-19-89 ROUTE US 23
 H.C. HOFFMAN WEATHER CLOUDY COUNTY SENECA
 R.C. BARNHISEL TEMP. +75 TOWNSHIP BIG SPRING
 SECTION 32
 T 1 N R 13 E

TYPE MONUMENT SM. R.R. SPIKE
 ON SURFACE - ~~BELOW~~ ON SURFACE
~~LEFT~~ - Q PAV'T - RIGHT 1.0'
 TO EDGE PAVEMENT
 S.L.M. 0+00
 GRID: NORTHING: _____ EASTING: _____

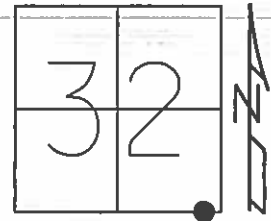

RECORD

10-31-89 SWH
 SET P.K./WASHER
 09-01-09
 FD.

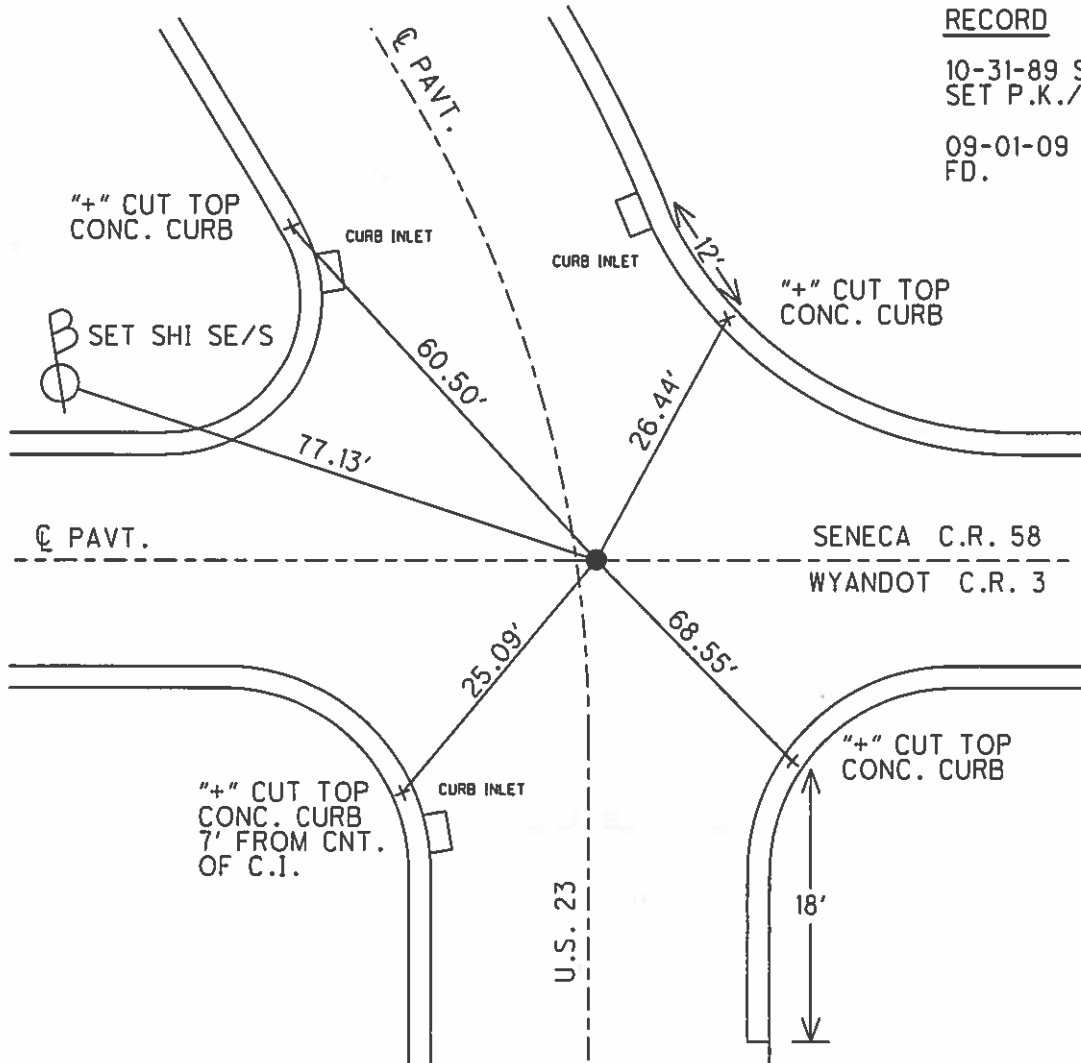

O.D.O.T. DISTRICT 2 SURVEY OFFICE

PERSONNEL _____

REFERENCE NO. 1

SHEET _____ OF _____

NOTES LOEHARKE

H.C. Hoffman

R.C. BARNHISEL

DATE 7-19-89

WEATHER CLOUDY

TEMP. +75

ROUTE U.S. 23

COUNTY Seneca

TOWNSHIP Big Spring

SECTION 32

T _____ R _____

TYPE MONUMENT Sm. R.R. Spike




Set P.K./WASHER
10-21-89 SWH

ON SURFACE - BELOW Yes

~~LEFT~~ - & PAV'T. - RIGHT 1.0

TO EDGE PAVEMENT

S.L.M. 0 +00

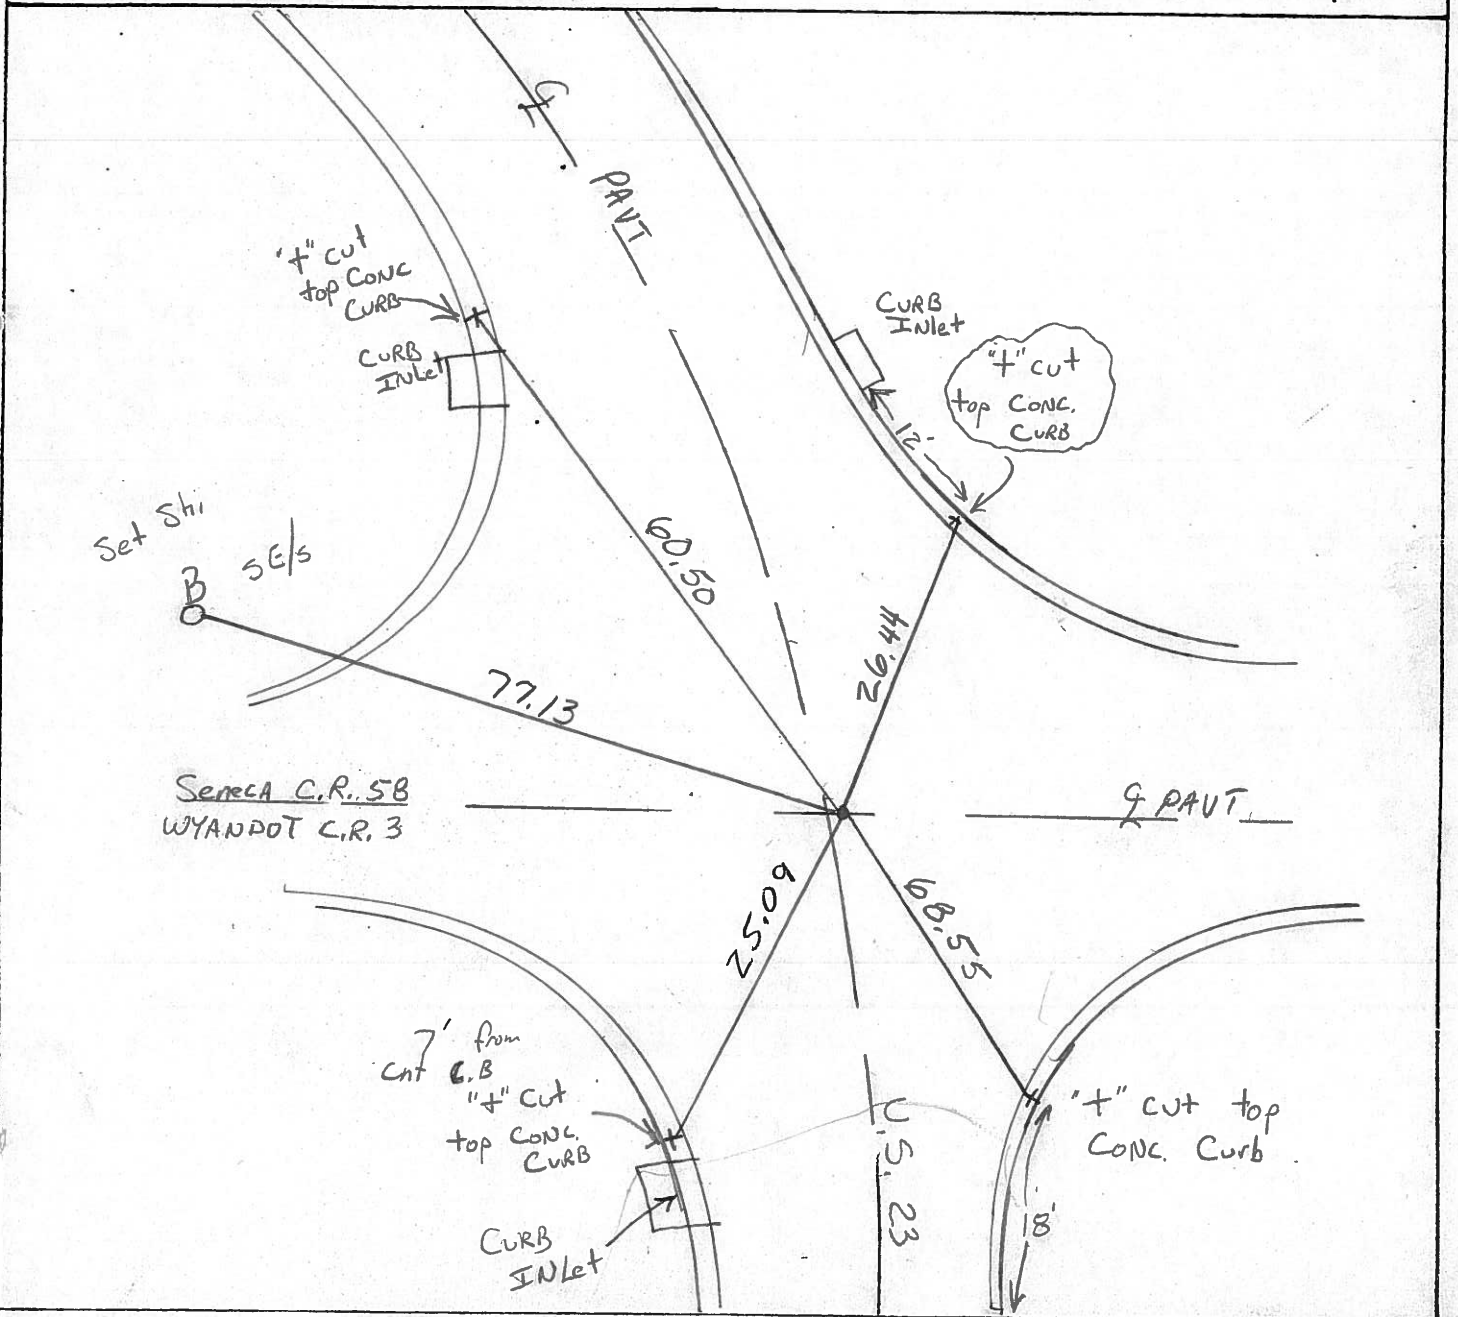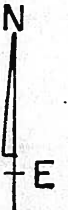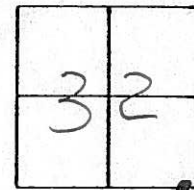

O.D.O.T. DISTRICT 2 SURVEY OFFICE

SHEET

OF

County Seneca S.R. 45.23

Township Big Spring

Section 32

T N, R E

Personnel Hoffman


Householder

1

Date 6-22-81

Weather cloudy


Temp. +70°

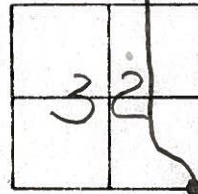

Fd. Nail @ surface
@ ctr. of PAUTS.


PROJECT STA = 0+00

SET SMALL R.R. SPK. 9-29-81 S.W.H.

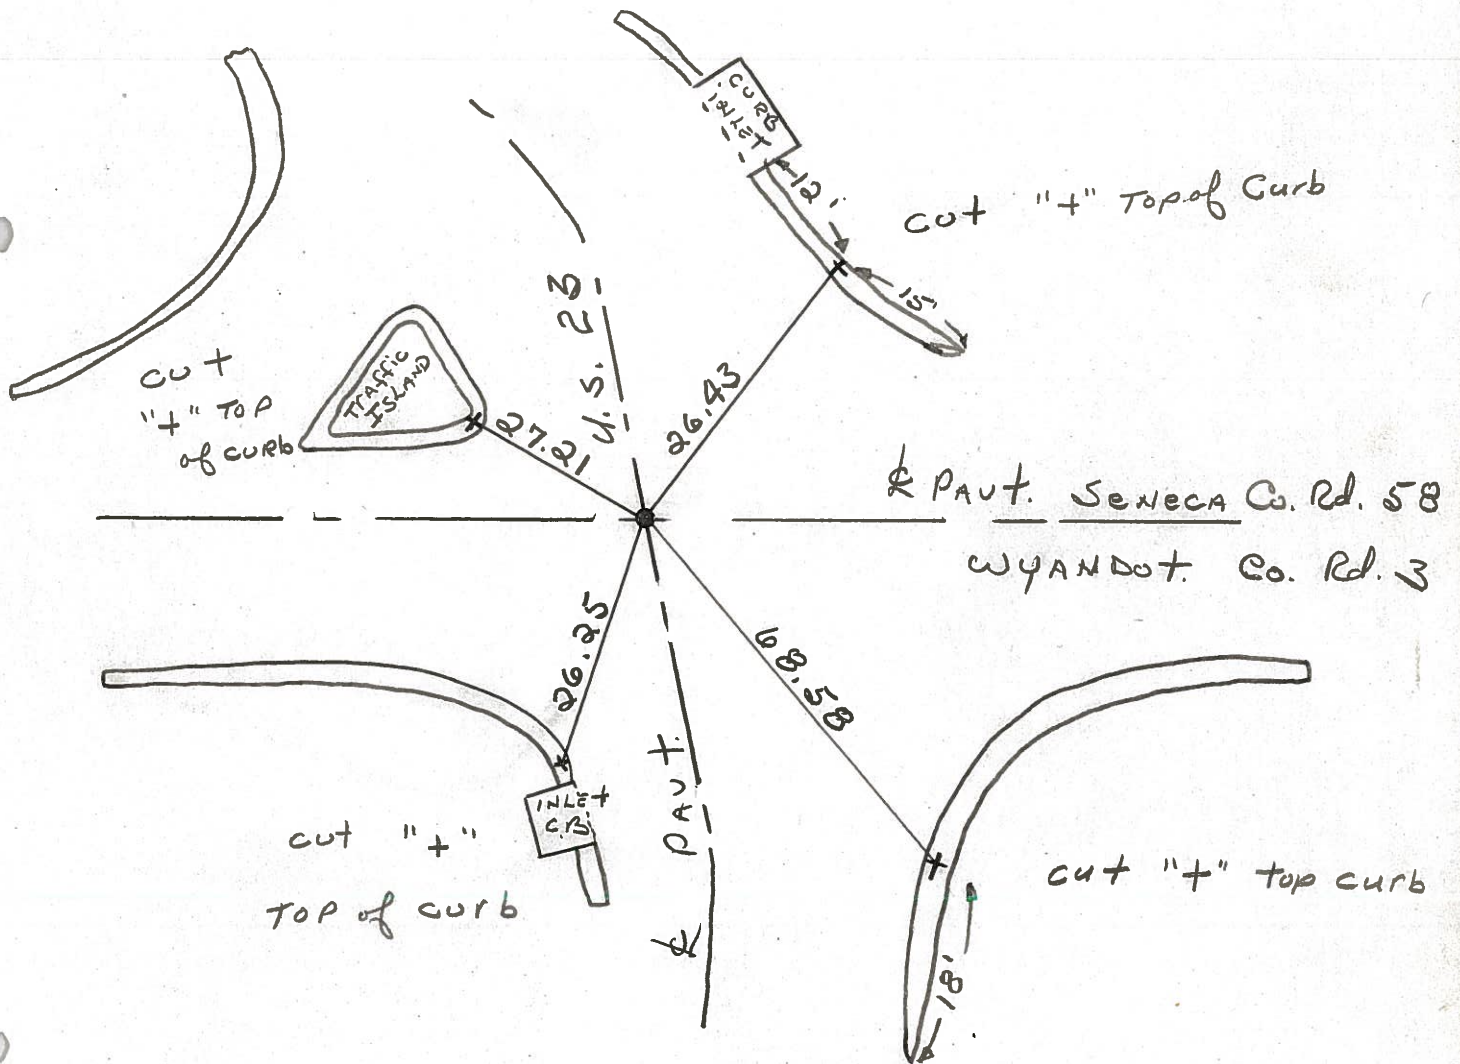


PERSONNEL	TITLE	PERSONNEL	TITLE	COUNTY	DATE
<u>Schneider</u>				<u>SARCOGA</u>	<u>8-25-</u>
<u>Mosser</u>				S. R. <u>U.S. 23</u>	WEATHER <u>Hot</u>
<u>Barbour</u>				SEC. <u>Wyandot Co Line N.</u>	TEMP. <u>90°</u>
<u>Potts</u>					
DESCRIPTION	<u>Ties for Control Points</u>			JOB NO.	
	LEFT	CENTER LINE	RIGHT		


P.I. (5) X
 54+60.69
 Fd. P.K. Nail

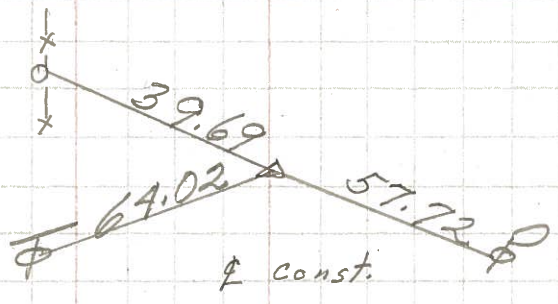


P.I. (4) X
 35+58.82
 P.K. Nail

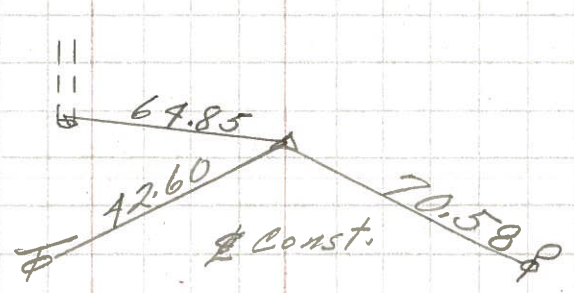


P.I. (3) X
 30+16.32
 Fd. P.K. Nail

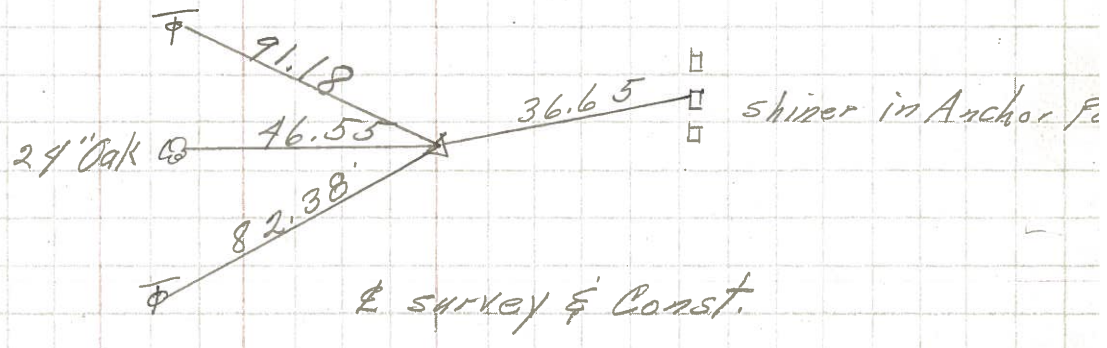

P.I. (2) X
 17+98.63
 $\Delta = 42^\circ 55' \text{ Rt.}$
 Small spk.

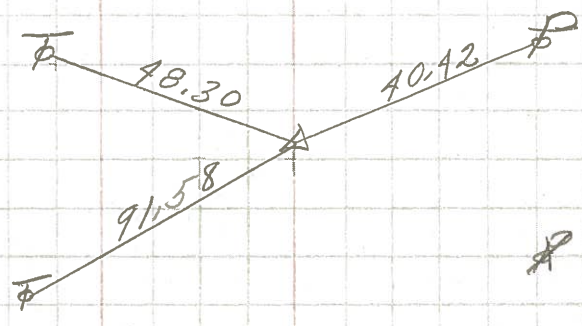

0+00 (1) X
 did not find

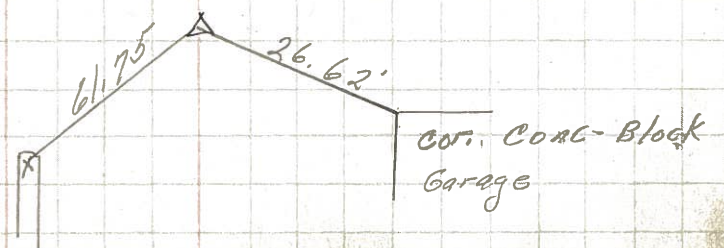

PERSONNEL TITLE PERSONNEL TITLE

COUNTY DATE

S. R. #23

WEATHER

SEC. TEMP.

DESCRIPTION

Wyandot - Seneca Co. line

JOB NO.

E. of U.S. #23

