

O.D.O.T. DISTRICT 2 SURVEY OFFICE (USE ONLY)

PERSONNEL

REFERENCE NO. 2

SHEET 2 OF 22

NOTES O'DONNELL

DATE 5/11/21

ROUTE US 23

H.C. AUBLE

WEATHER SUNNY

COUNTY SENECA

R.C. NIESE

TEMP. 45°

TOWNSHIP BIG SPRING

SECTION 32

DWG BY RHOADES

PID 85264

T 1 N R 13 E

TYPE MONUMENT BOLT SPIKE/WASHER

~~ON SURFACE~~ - BELOW 1"

OFFSET \varnothing PAVEMENT 1.9' ~~ET~~ : RT

7.9' TO EAST EDGE PAVEMENT


STATION: 17+98.63

HORIZ.DATUM: NAD83 2011


GEOID: NAVD88 2012A

GRID: NORTHING: 485571.705

EASTING: 1723716.087

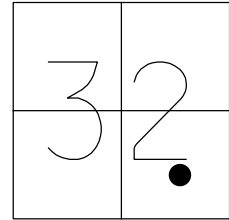


RECORD: P.I.
 STA. 17+98.63
 $\Delta = 42^\circ 55'$ RT
 D = 4'
 R = 1432.69'
 T = 563.13'
 L = 1072.92'
 E = 106.72'
 FD BOLT
 1955
 FD BOAT SPIKE/WASHER
 1" DOWN
 REF2
 1/6/20, JFO

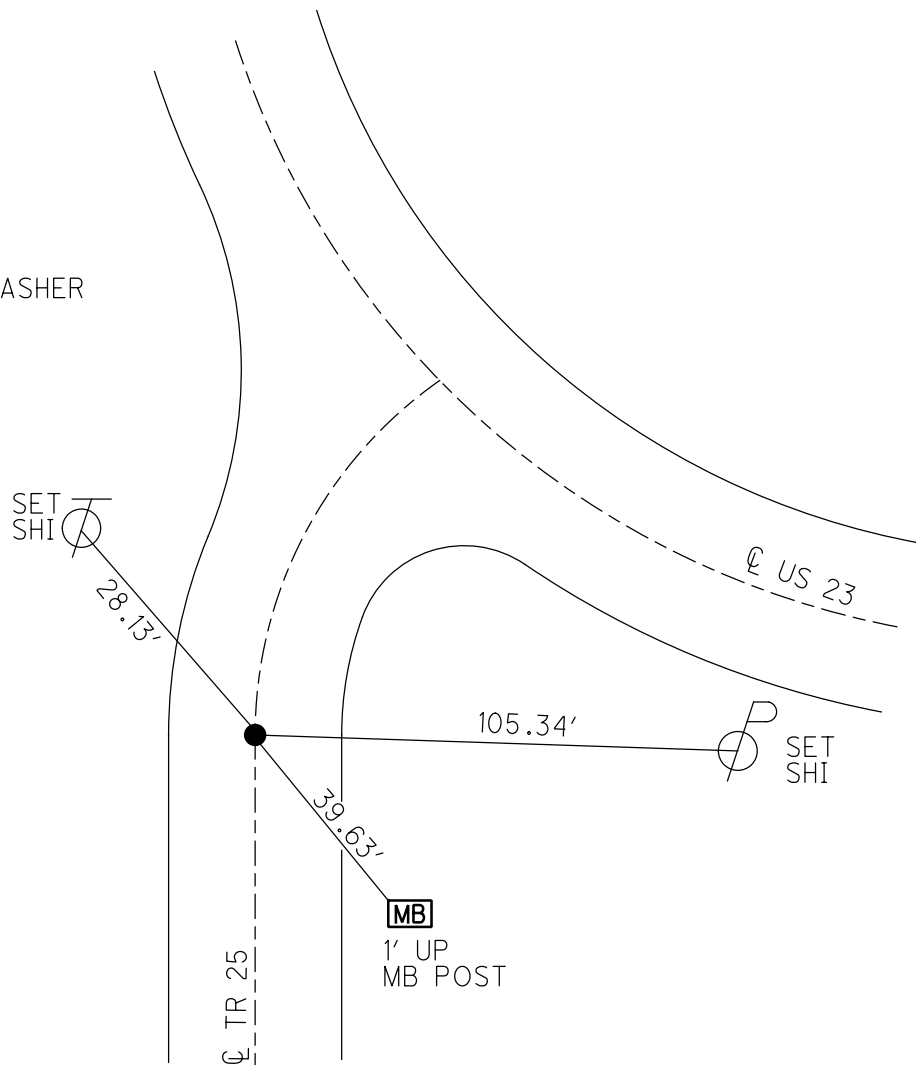

O.D.O.T. DISTRICT 2 SURVEY OFFICE (USE ONLY)


PERSONNEL _____ REFERENCE NO. 2 SHEET 2 OF 22
 NOTES LOEHRKE DATE 7/19/89 ROUTE US 23
 H.C. HOFFMAN WEATHER CLOUDY COUNTY SENECA
 R.C. BARNHISEL TEMP. 75° TOWNSHIP BIG SPRING
 _____ SECTION 32
 DWG BY NASON PID PT-SEN19 T 1 N R 13 E

TYPE MONUMENT BOLT SPIKE/WASHER
 ON SURFACE - ~~BELOW~~ ON _____
 OFFSET C PAVEMENT 1.9' RT : RT
7.9' TO EAST EDGE PAVEMENT
 STATION: 17+98.63

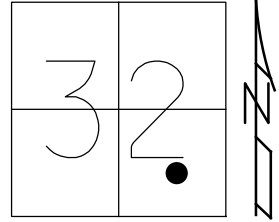

HORIZ.DATUM: _____ GEOID: _____
 GRID: NORTHING: _____ EASTING: _____

RECORD: P.I.
 STA. 17+98.63
 $\Delta = 42^\circ 55' \text{ RT}$
 $D = 4^\circ$
 $R = 1432.69'$
 $T = 563.13'$
 $L = 1072.92'$
 $E = 106.72'$
 FD BOLT
 1955

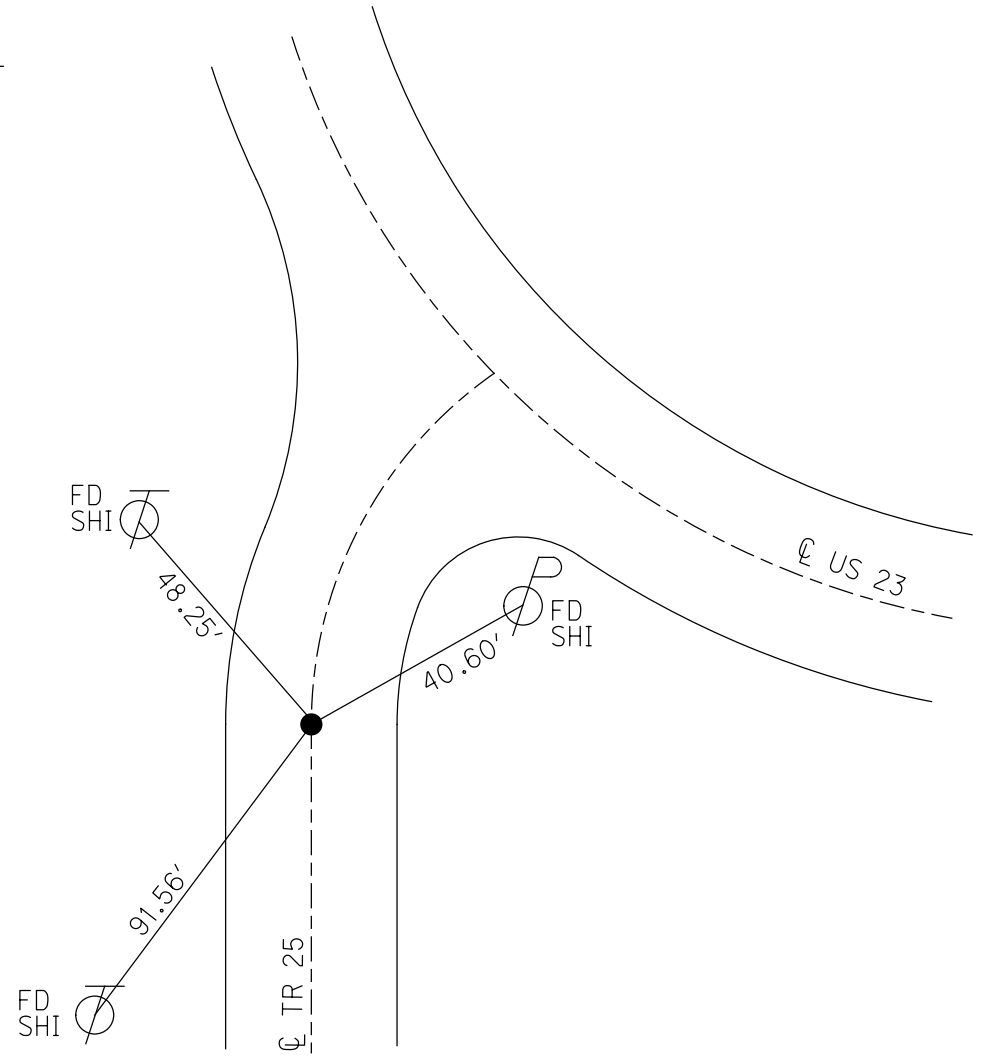

O.D.O.T. DISTRICT 2 SURVEY OFFICE (USE ONLY)

PERSONNEL	REFERENCE NO.	<u>2</u>	SHEET	<u>2</u>	OF	<u>22</u>
NOTES	<u>LOEHRKE</u>	DATE	<u>7-19-89</u>	ROUTE	<u>US 23</u>	
H.C.	<u>HOFFMAN</u>	WEATHER	<u>CLOUDY</u>	COUNTY	<u>SENECA</u>	
R.C.	<u>BARNHISEL</u>	TEMP.	<u>+75</u>	TOWNSHIP	<u>BIG SPRING</u>	
				SECTION	<u>32</u>	
				T	<u>1</u>	R
					<u>N</u>	<u>13</u>
					<u>E</u>	

TYPE MONUMENT BOLT SPIKE/WASHER


ON SURFACE - ~~BELOW~~ ON SURFACE

~~LEFT~~ - Q PAV'T - RIGHT 1.9'

7.9' TO EAST EDGE PAVEMENT


S.L.M. _____

GRID: NORTHING: _____ EASTING: _____

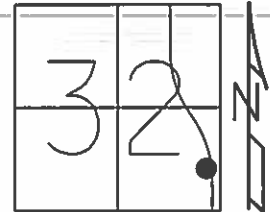

REC. P.I. STA. 17+98.63

$\Delta = 42'55'$ RT.

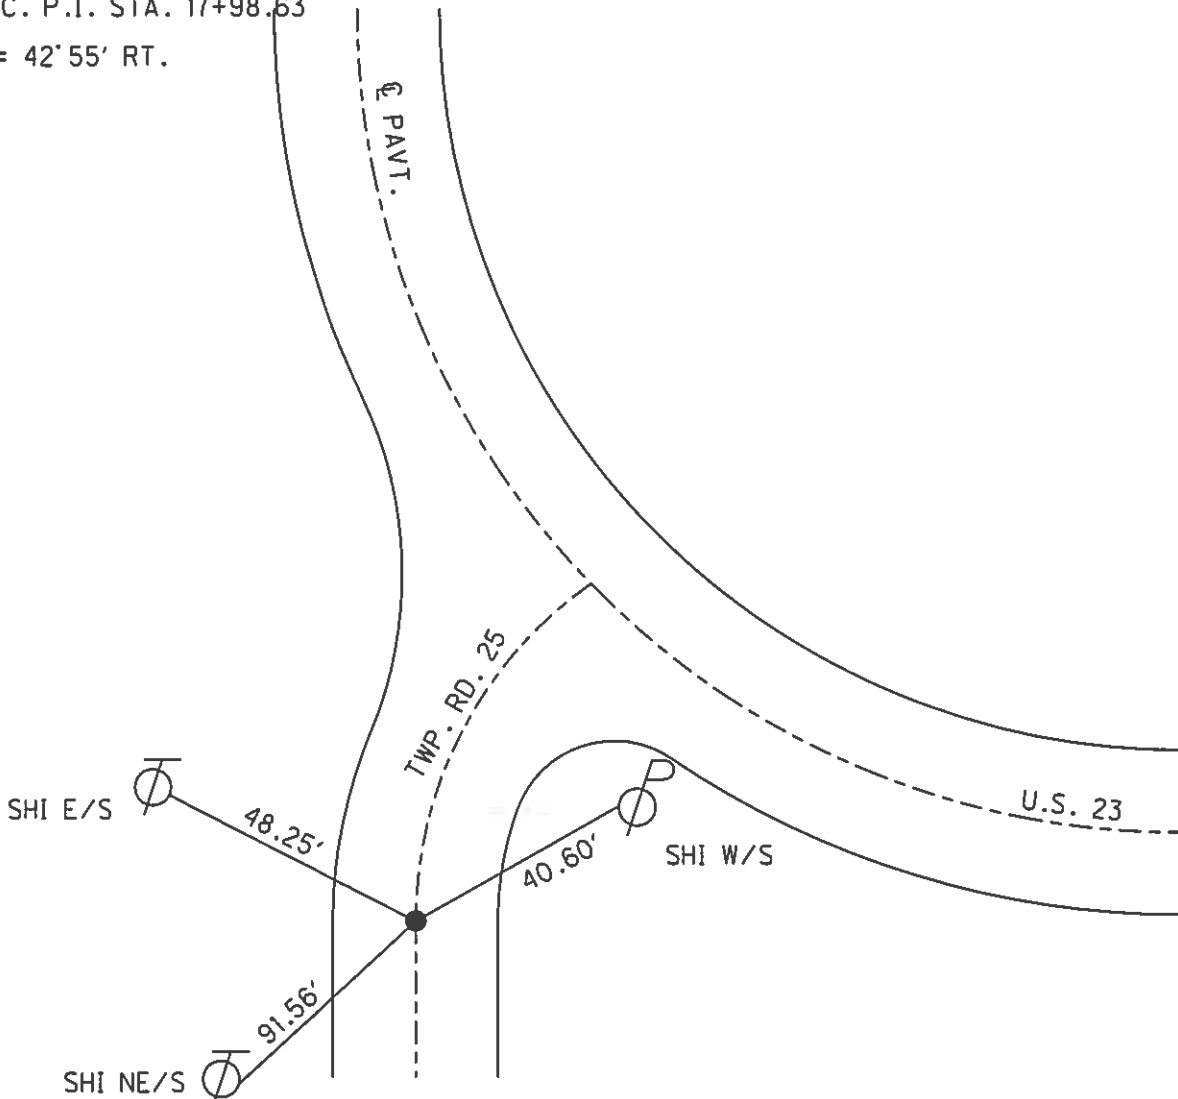

O.D.O.T. DISTRICT 2 SURVEY OFFICE

PERSONNEL _____

REFERENCE NO. 2

SHEET _____ OF _____

NOTES LOEHRKE

H.C. HOFFMAN

R.C. BARNHUSEL

DATE 7-19-89

WEATHER CLOUDY

TEMP. +75

ROUTE U.S. 23

COUNTY SENECA

TOWNSHIP BIG SPRING

SECTION 32

T. _____ R. _____


TYPE MONUMENT Bolt SPIKE/WASHER

ON SURFACE - ~~BELOW~~ Yes


~~LEFT~~ - & PAV'T. - RIGHT 1.9

7.9 TO EAST EDGE PAVEMENT

S.L.M. _____

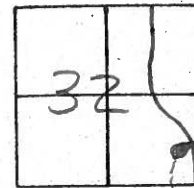

Rec. P.I. sta 17+98.63
 $\Delta = 42^\circ - 55' R+$

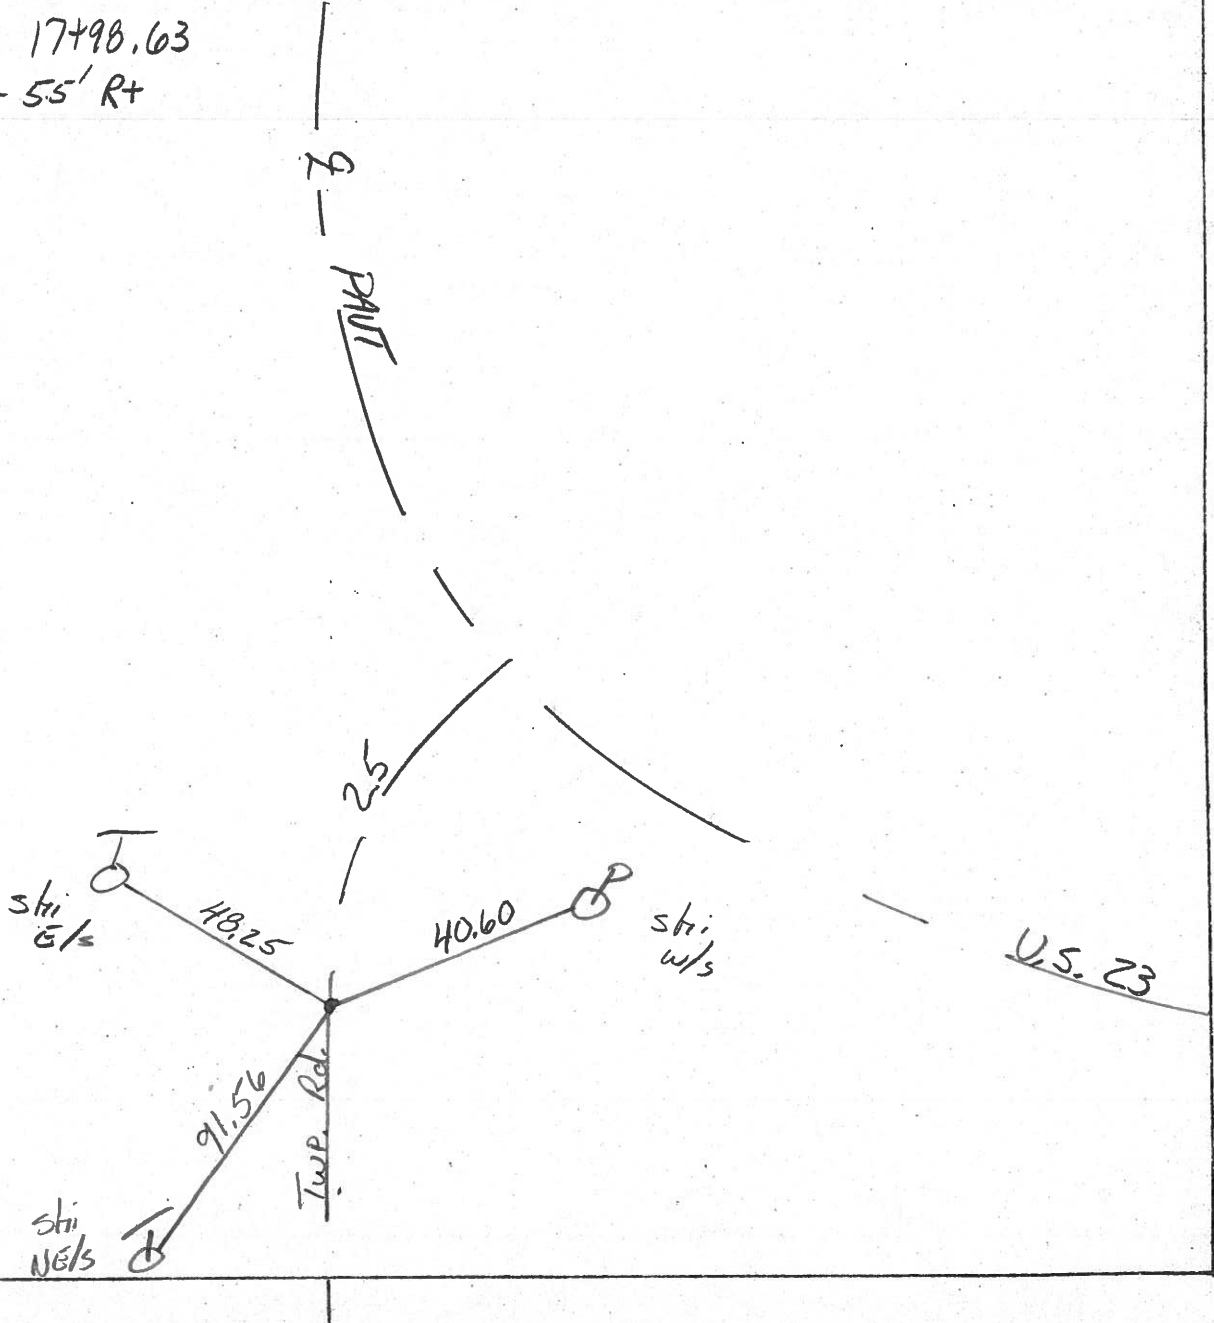

County Seneca S.R.-U.S. 23

Date 6-22-81

Township Big Spring

Weather Cloudy


Section 32

Temp. +70°

T N, R E

Personnel HOFFMAN
Householder


②

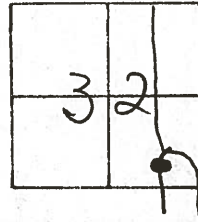

Fd. Small Bolt Spk/washer @ Surface

7.9' to E. Edge Paut.
9.7' to W. Edge Paut.
of Twp. Rd. 25


P.I. STA. 17+98.63₂
Δ = 42°-55' Rt. → REC.

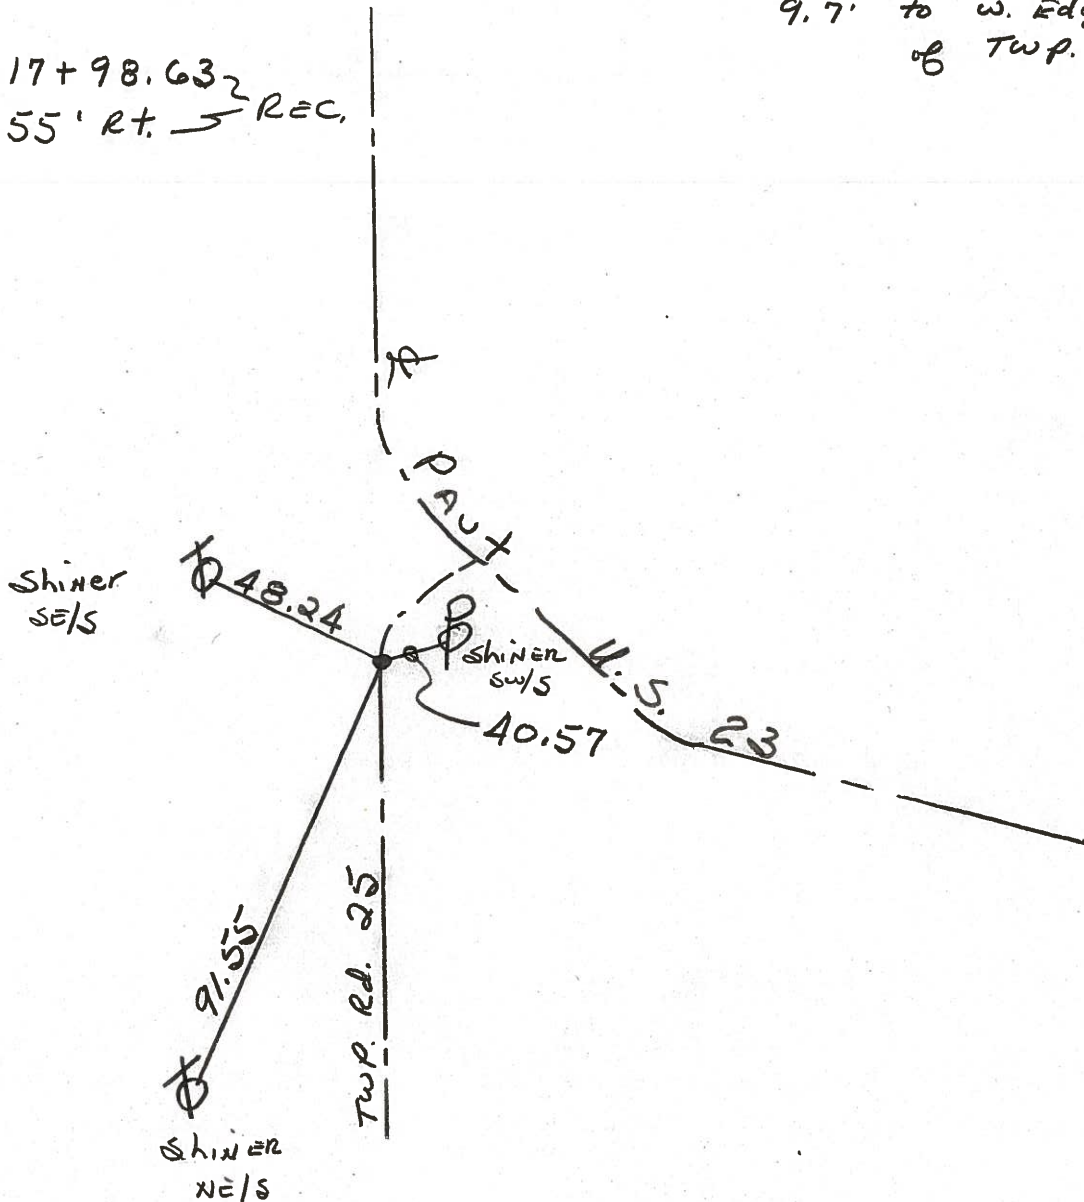


PERSONNEL	TITLE	PERSONNEL	TITLE	COUNTY	DATE	WEATHER	TEMP.
Schneider				Sarocca	8-25-	Hot	90°
Mosser				S. R. U.S. 23			
Barbour				SEC. Wyandot Co Line N.			
Potts							

DESCRIPTION: Ties for Control Points


P.I. (5) X
 54+60.69
 Fd. P.K. Nail

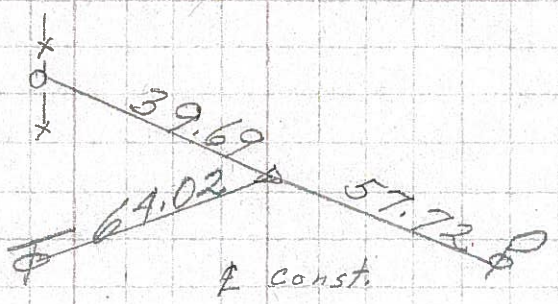


P.I. (4) X
 35+58.82
 P.K. Nail

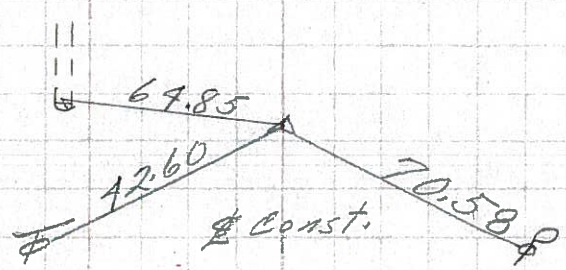

P.I. (3) X
 30+16.32
 Fd. P.K. Nail

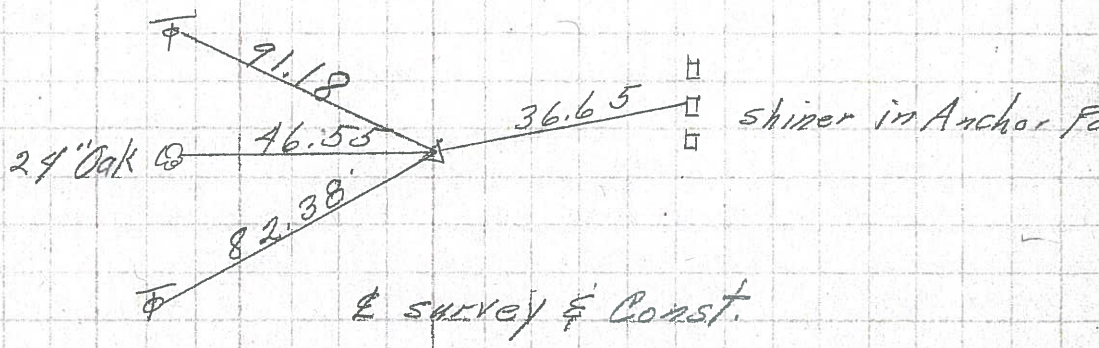

P.I. (2) X
 17+98.63
 $\Delta = 42^\circ 55'$ Rt.
 Small spk.

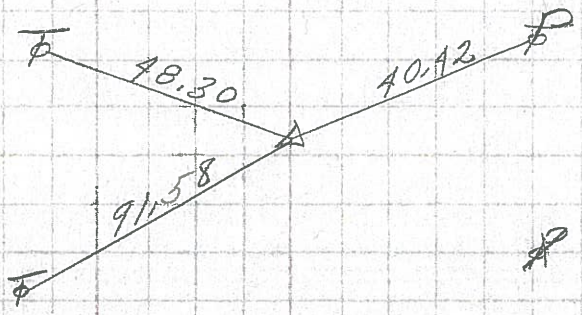

0+00 (1) X
 did not find

