



O.D.O.T. DISTRICT 2 SURVEY OFFICE (USE ONLY)

PERSONNEL \_\_\_\_\_ REFERENCE NO. 3 SHEET 3 OF 22  
 NOTES O'DONNELL DATE 10/26/18 ROUTE US 23  
 H.C. AUBLE WEATHER CLOUDY COUNTY SENECA  
 R.C. NIESE TEMP. 43° TOWNSHIP BIG SPRING  
 DWG BY RHOADES PID 85264 SECTION 32  
 T 1 N R 13 E

TYPE MONUMENT SM.R.R.SPIKE  
~~ON SURFACE~~ - BELOW 3"  
 OFFSET CL PAVEMENT ON LT : RT  
12.4' TO LT EDGE PAVEMENT  
 STATION: 30+16.32

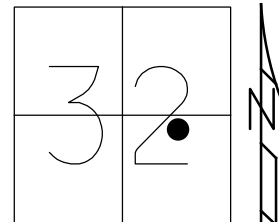


HORZ.DATUM: NAD83 2011 GEOID: NAVD88 2012A  
 GRID: NORTHING: 486842.076 EASTING: 1723704.728

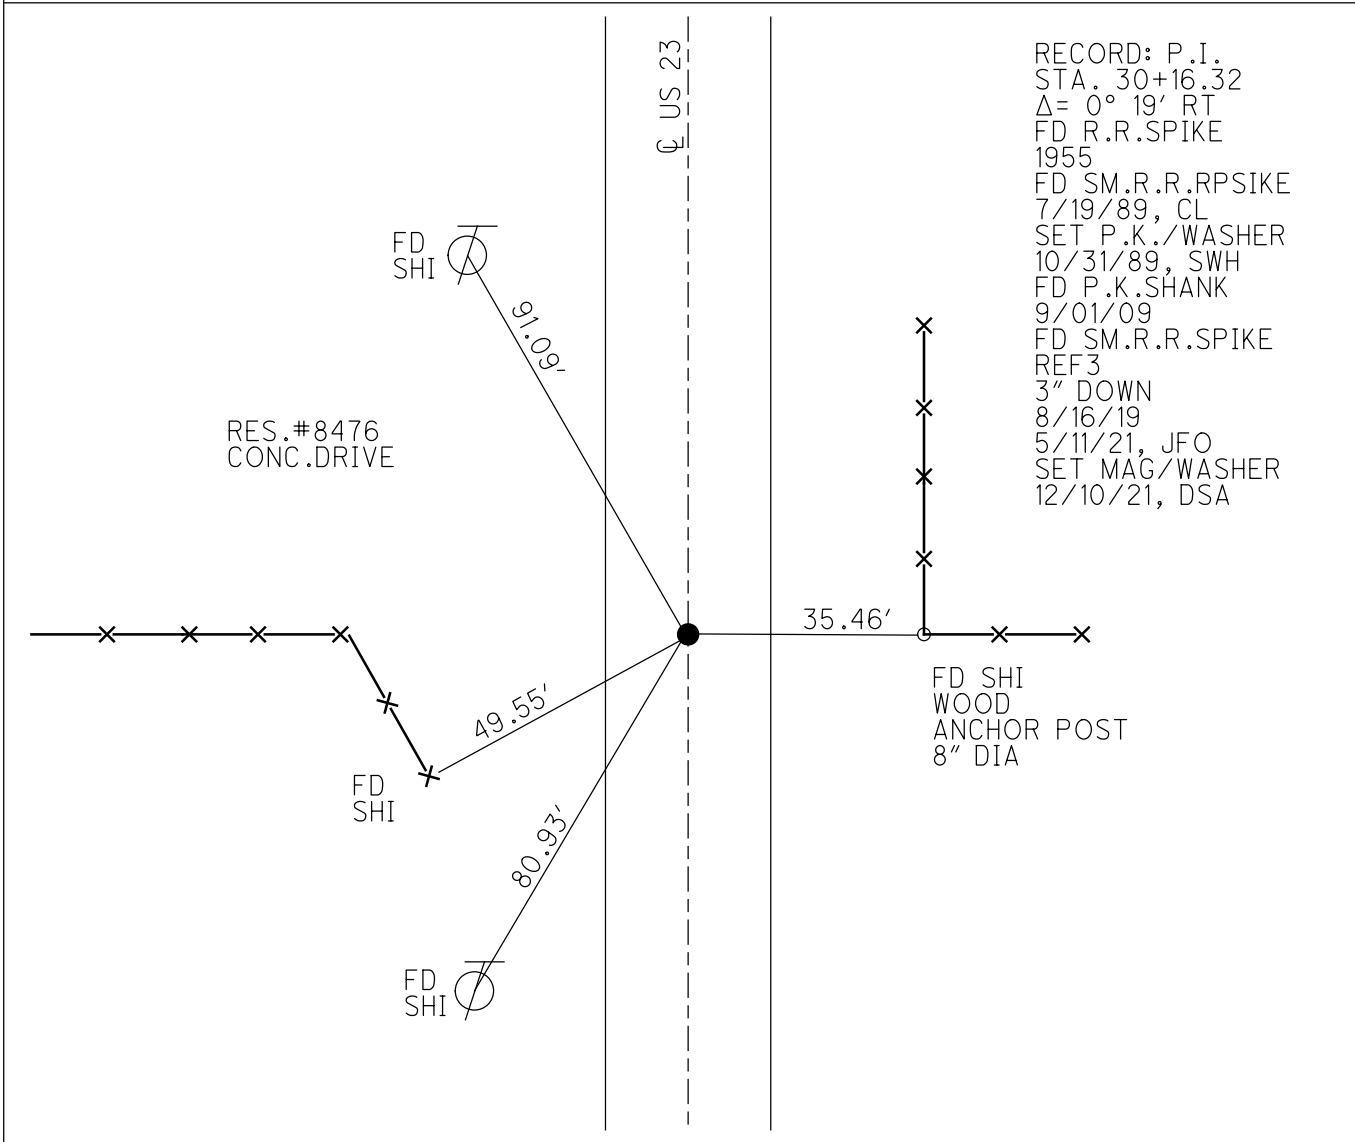


O.D.O.T. DISTRICT 2 SURVEY OFFICE (USE ONLY)

PERSONNEL \_\_\_\_\_ REFERENCE NO. 3 SHEET 3 OF 22  
 NOTES ELKHECHEN DATE 10/26/18 ROUTE US 23  
 H.C. LEU WEATHER CLOUDY COUNTY SENECA  
 R.C. ELKHECHEN TEMP. 43° TOWNSHIP BIG SPRING  
 DWG BY NASON PID PT-SEN19 SECTION 32  
 T 1 N R 13 E

TYPE MONUMENT SM. R.R. SPIKE  
~~ON SURFACE~~ - BELOW 3"  
 OFFSET Q PAVEMENT ON LT : RT  
12.4' TO LT EDGE PAVEMENT  
 STATION: 30+16.32

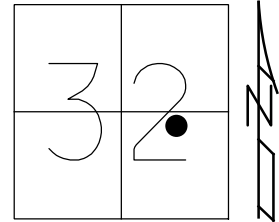

HORZ. DATUM: NAD83 (2011) GEOID: 2012A  
 GRID: NORTHING: 486842.076 EASTING: 1723704.728

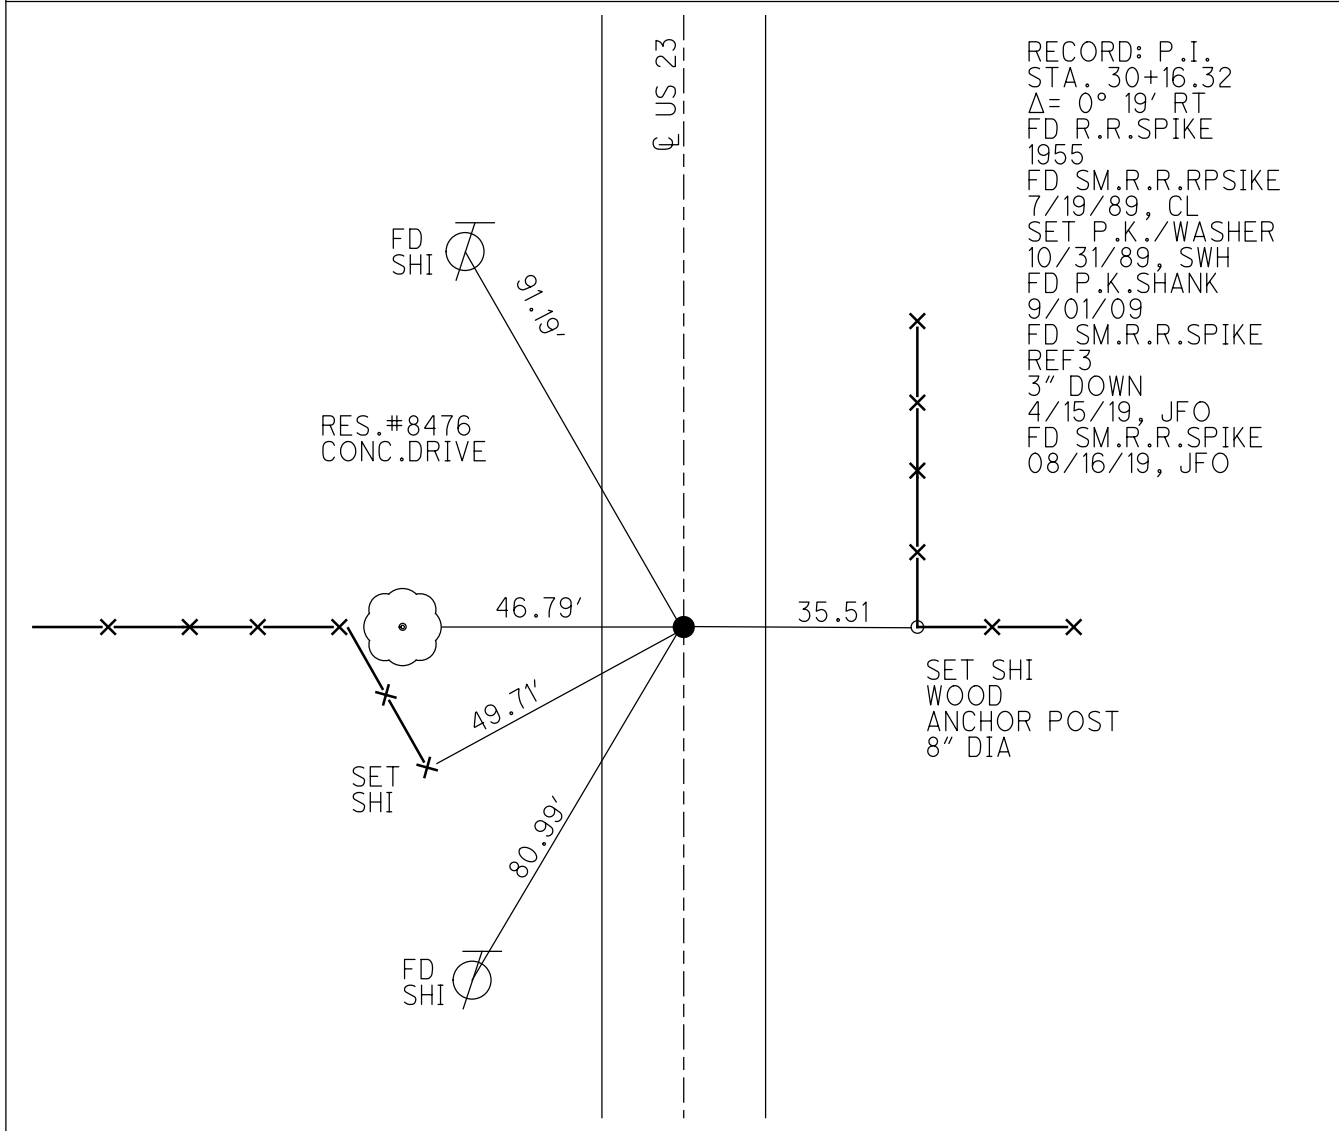


RECORD: P.I.  
 STA. 30+16.32  
 $\Delta = 0^\circ 19' RT$   
 FD R.R.SPIKE  
 1955  
 FD SM.R.R.RPSIKE  
 7/19/89, CL  
 SET P.K./WASHER  
 10/31/89, SWH  
 FD P.K.SHANK  
 9/01/09  
 FD SM.R.R.SPIKE  
 REF3  
 3" DOWN  
 4/15/19, JFO  
 FD SM.R.R.SPIKE  
 08/16/19, JFO

O.D.O.T. DISTRICT 2 SURVEY OFFICE (USE ONLY)

PERSONNEL \_\_\_\_\_ REFERENCE NO. 3 SHEET 3 OF 22  
 NOTES LOEHRKE DATE 7-19-89 ROUTE US 23  
 H.C. HOFFMAN WEATHER CLOUDY COUNTY SENECA  
 R.C. BARNHISEL TEMP. +75 TOWNSHIP BIG SPRING  
 SECTION 32  
 T 1 N R 13 E

TYPE MONUMENT SM. R.R. SPIKE  
 ON SURFACE - ~~BELOW~~ ON SURFACE  
~~LEFT~~ - C PAV'T - ~~RIGHT~~ YES  
12.4' TO LT. EDGE PAVEMENT  
 S.L.M. 30+22

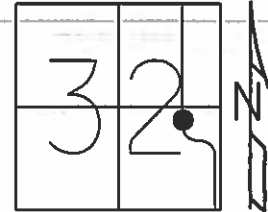


GRID: NORTHING: \_\_\_\_\_ EASTING: \_\_\_\_\_

RECORD

REC. P.I. STA. 17+98.63

10-31-89 SWH  
 SET P.K./WASHER  
 09-01-09  
 FD. SHANK

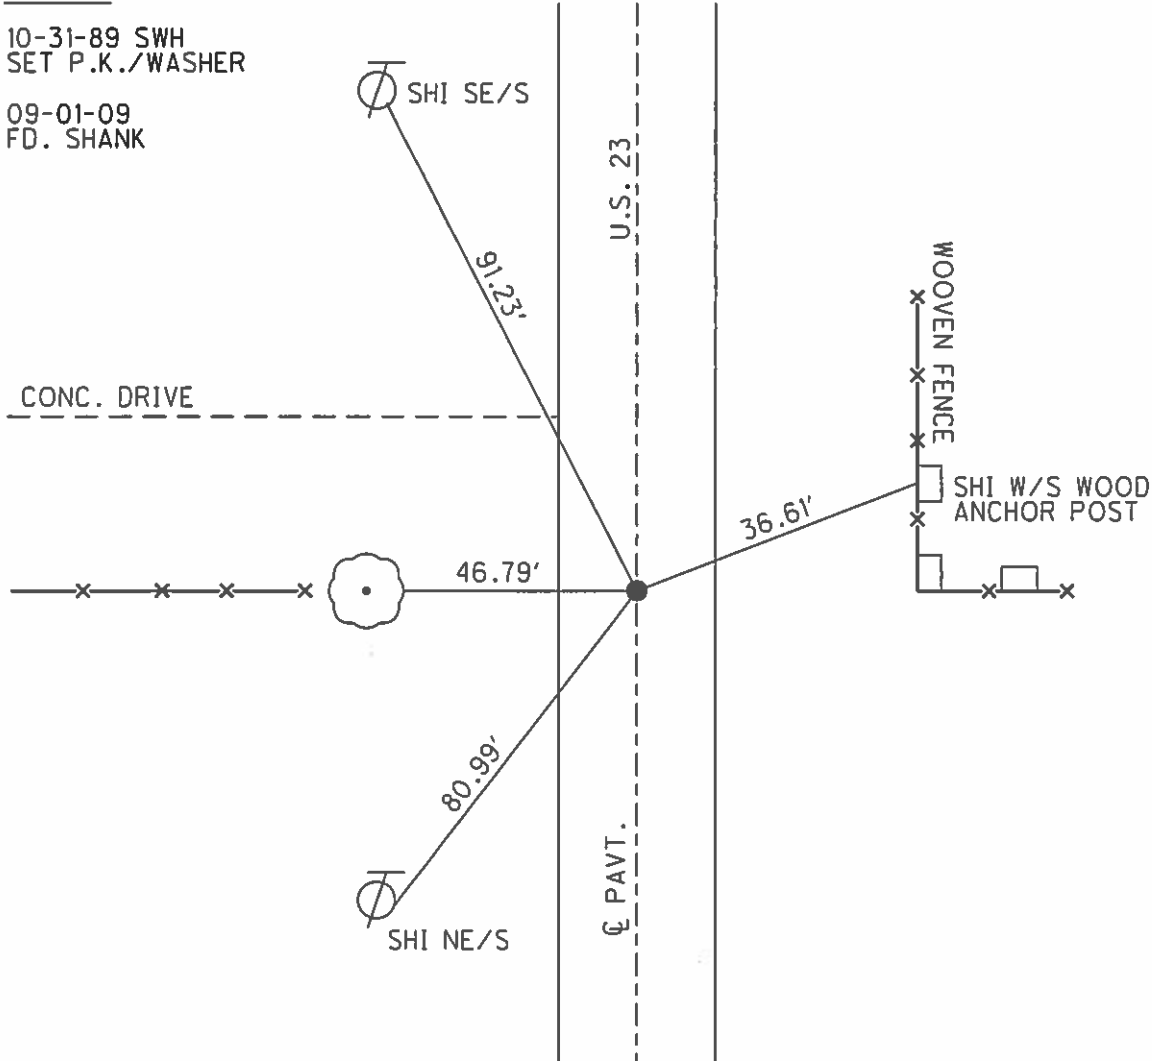

O.D.O.T. DISTRICT 2 SURVEY OFFICE

PERSONNEL

REFERENCE NO. 3

SHEET      OF     

NOTES LOEHRKE

H.C. Hoffman

DATE 7-19-89

ROUTE U.S. 23

R.C. BARNHISEL

WEATHER Cloudy

COUNTY Seneca

TEMP. +75

TOWNSHIP Big Spring

SECTION 32

T      R     

TYPE MONUMENT Sm. R.R. Spike


Set P.K./WASHER  
10-31-89 SWH

ON SURFACE - ~~BELOW~~ Yes


LEFT - ~~C~~ PAV'T. - ~~RIGHT~~ Yes

12.4 TO Lt. EDGE PAVEMENT

S.L.M. 30 ± 22

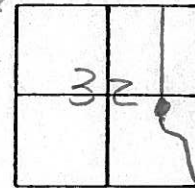

Rec: P.I. Sta 30+16.32

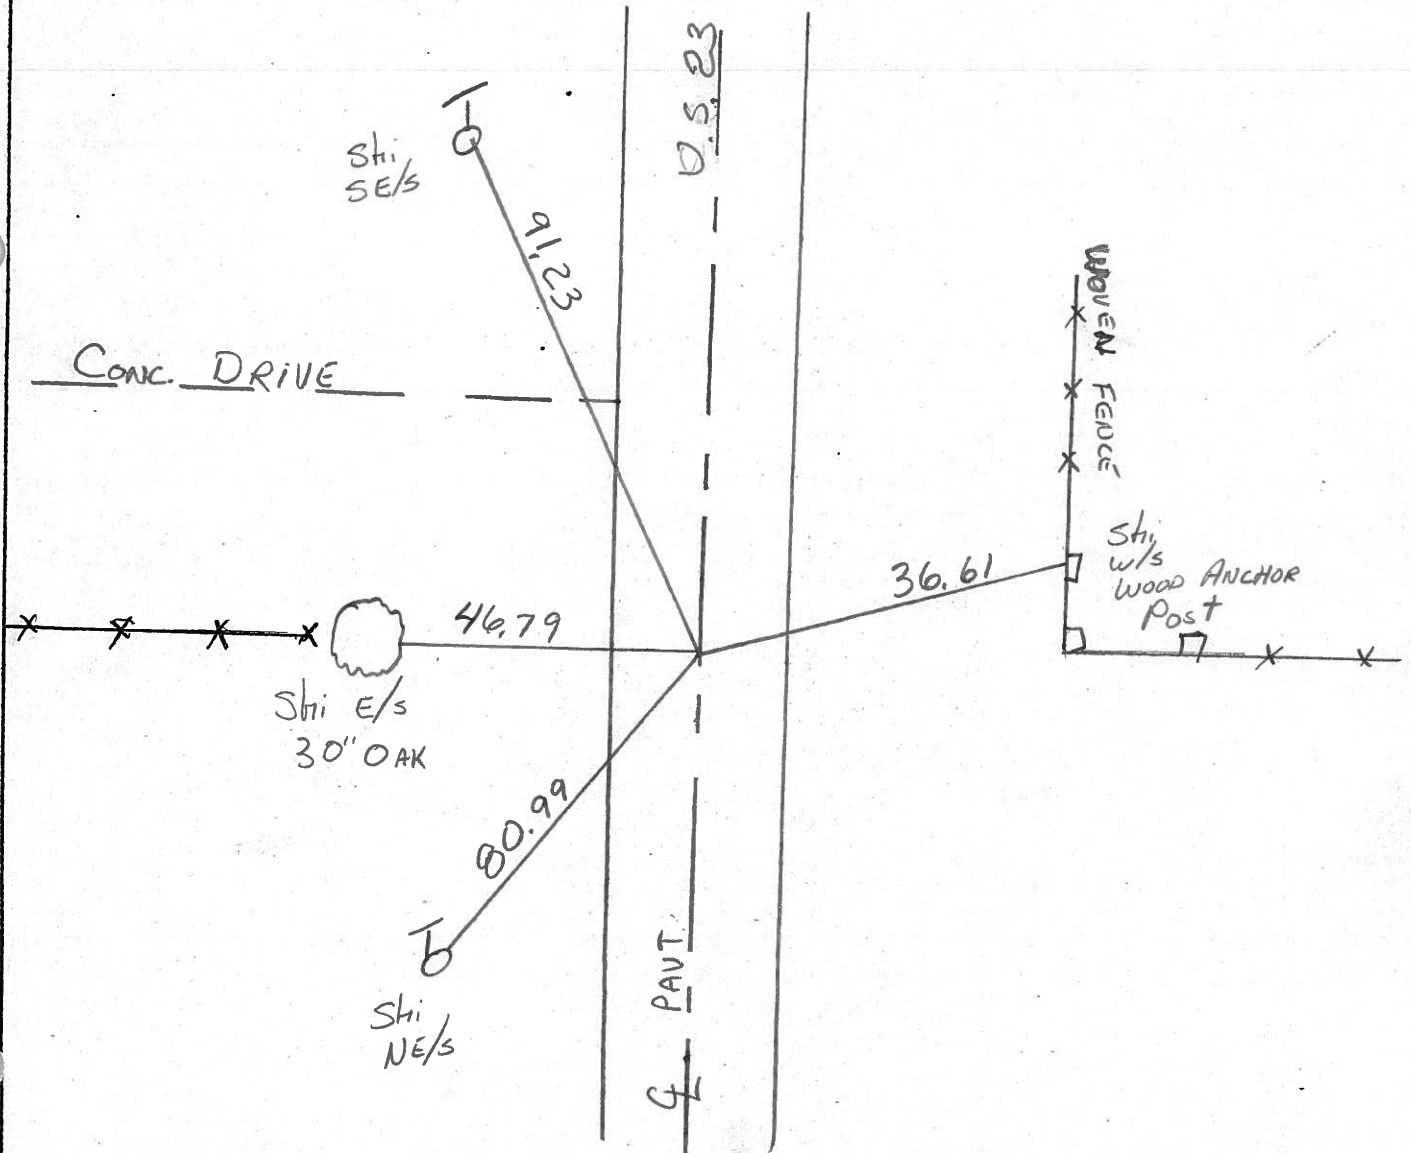

County Seneca S.R. 4.5.23

Township Big Spring

Section 32


T N, R E

Personnel Hoffman  
Householder

Date 6-22-81

Weather cloudy

Temp. +70°

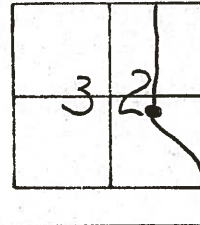


#3

Fd. P.K. Nail/washer @ surface  
@ Ctr. of Paut.

PROJECT STA. ± 30+29

SET SMALL R.R. SPK.  
9-29-81 S.W.H.

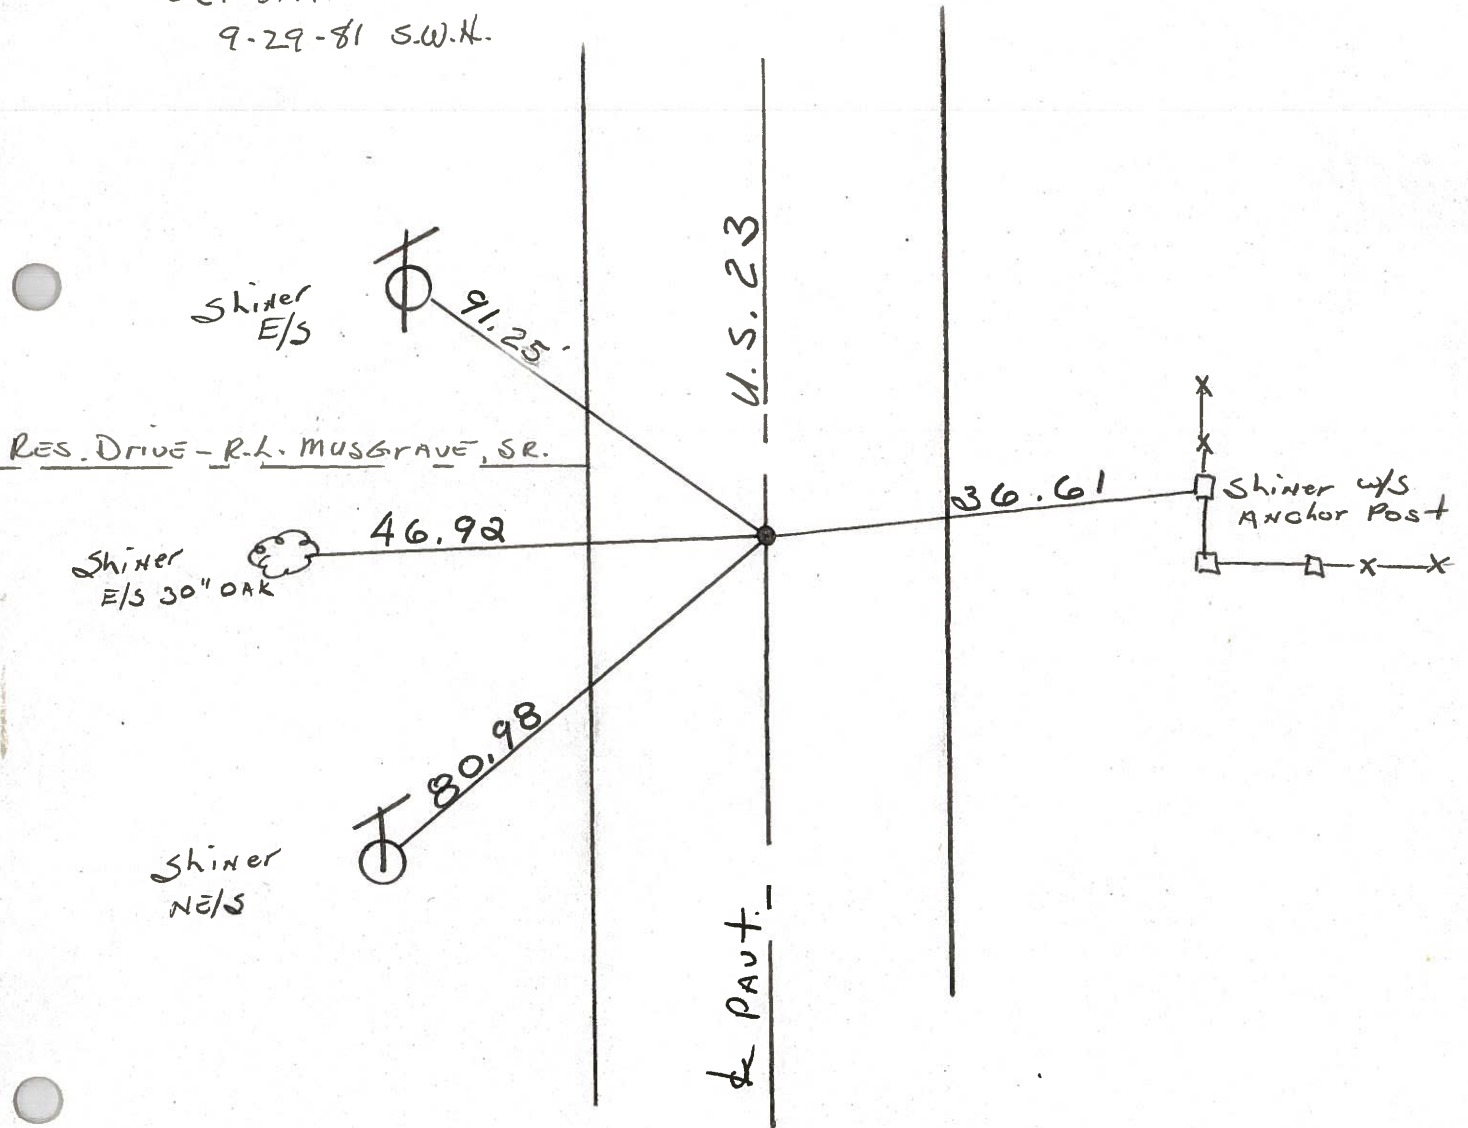

P.I. STA. 30 + 16.32 - REC.

PERSONNEL TITLE PERSONNEL TITLE

Schneider

COUNTY Saratoga

DATE 8-25-

Messer

S. R. U.S. 23

WEATHER Hot

Barbour

SEC. Wyandot Co Line N.

TEMP 90°

Potts

DESCRIPTION Ties for Control Points


JOB NO.

LEFT


CENTER LINE

RIGHT


P.I. **(5)** X  
 54+60.69  
 Fd. P.K. Nail

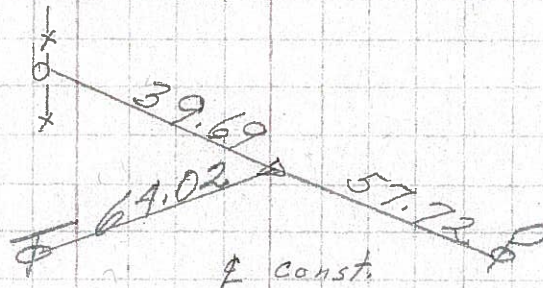


P.I. **(4)** X  
 35+58.82  
 P.K. Nail

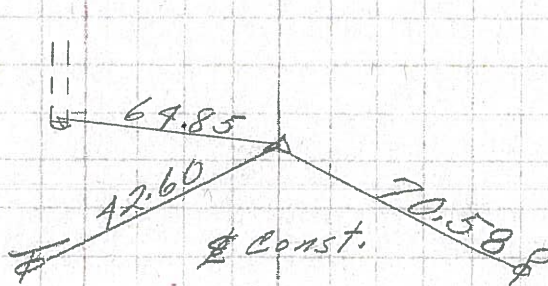

P.I. **(3)** X  
 30+16.32  
 Fd. P.K. Nail

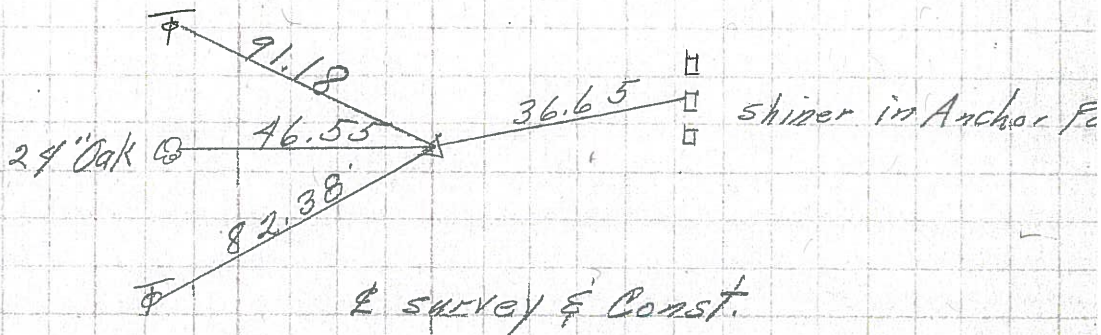

P.I. **(2)** X  
 17+98.63  
 $\Delta = 42^\circ 55' \text{ Rt.}$   
 5 mark spk.

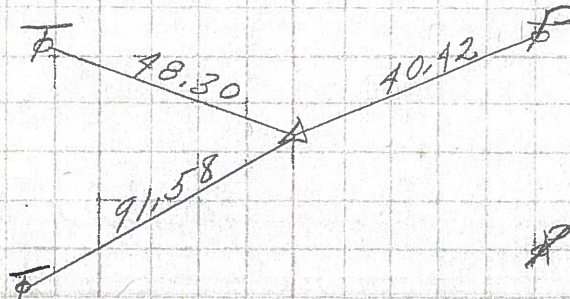

0+00 **(1)** X  
 did not find

