

O.D.O.T. DISTRICT 2 SURVEY OFFICE (USE ONLY)

PERSONNEL \_\_\_\_\_ REFERENCE NO. 4 SHEET 4 OF 22

NOTES O'DONNELL DATE 5/11/21 ROUTE US 23  
 H.C. AUBLE WEATHER SUNNY COUNTY SENECA  
 R.C. NIESE TEMP. 45° TOWNSHIP BIG SPRING

SECTION 32  
 T 1 N R 13 E

DWG BY RHOADES PID 85264

TYPE MONUMENT SM.R.R.SPIKE

ON ~~SURFACE~~ - BELOW 3.5"

OFFSET  $\varnothing$  PAVEMENT ON LT : RT

11.6' TO LT EDGE PAVEMENT


STATION: 35+58.82

HORZ.DATUM: NAD83 2011

GEOID: NAVD88 2012A

GRID: NORTHING: 487384.500

EASTING: 1723699.994

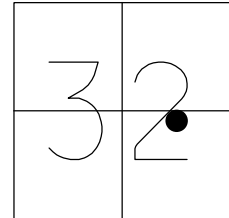

FIELD DR

$\varnothing$  US 23

SET BARN  
SPIKE

69.04'

SET  
SHI

42.58'

67.73'

FD  
SHI

RECORD: P.I.  
 STA. 35+58.82  
 SET P.K./WASHER  
 10/31/89, SWH  
 FD P.K./WASHER  
 9/01/09  
 FD SM.R.R.SPIKE  
 REF4  
 3 1/2" DOWN  
 4/15/19  
 8/16/19  
 5/11/21, JFO  
 SET MAG/WASHER  
 12/10/21, DSA

O.D.O.T. DISTRICT 2 SURVEY OFFICE (USE ONLY)

PERSONNEL \_\_\_\_\_

REFERENCE NO. 4

SHEET 4 OF 22

NOTES ELKHECHEN

DATE 10/26/18

ROUTE US 23

H.C. LEU

WEATHER CLOUDY

COUNTY SENECA

R.C. ELKHECHEN

TEMP. 43°

TOWNSHIP BIG SPRING

DWG BY NASON

PID PT-SEN19

SECTION 32

T 1 N R 13 E

TYPE MONUMENT SM. R.R. SPIKE

ON ~~SURFACE~~ - BELOW 3.5"

OFFSET CL PAVEMENT ON LT : RT

11.6' TO LT. EDGE PAVEMENT


STATION: 35+58.82

HORIZ.DATUM: NAD83 (2011)

GEOID: 2012A

GRID: NORTHING: 487384.500

EASTING: 1723699.994

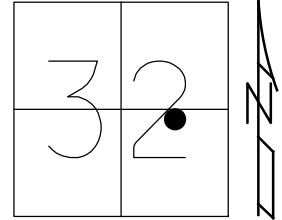

SET SAWCUT  
10" FR/END  
12" RMP

FD  
SHI



66.00'

42.62'

67.80'




SET  
SHI

RECORD: P.I.  
STA. 35+58.82  
SET P.K./WASHER  
10/31/89, SWH  
FD P.K./WASHER  
9/01/09  
FD SM.R.R.SPIKE  
REF4  
3 1/2" DOWN  
4/15/19, JFO  
8/16/19, JFO

O.D.O.T. DISTRICT 2 SURVEY OFFICE (USE ONLY)


PERSONNEL \_\_\_\_\_ REFERENCE NO. 4 SHEET 4 OF 22  
 NOTES LOEHRKE DATE 07-19-89 ROUTE US 23  
 H.C. HOFFMAN WEATHER CLOUDY COUNTY SENECA  
 R.C. BARNHISEL TEMP. +75 TOWNSHIP BIG SPRING  
 \_\_\_\_\_ SECTION 32  
 \_\_\_\_\_ T 1 N R 13 E

TYPE MONUMENT SM. R.R. SPIKE  
 ON SURFACE - ~~BELOW~~ ON SURFACE  
 LEFT - Q PAV'T - ~~RIGHT~~ YES  
11.6' TO LT. EDGE PAVEMENT  
 S.L.M. 35+66  
 GRID: NORTHING: \_\_\_\_\_ EASTING: \_\_\_\_\_

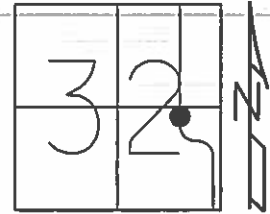

REC. P.I. STA. 35+58.82

RECORD  
 10-31-89 SWH  
 SET P.K./WASHER  
 09-01-09  
 FD.

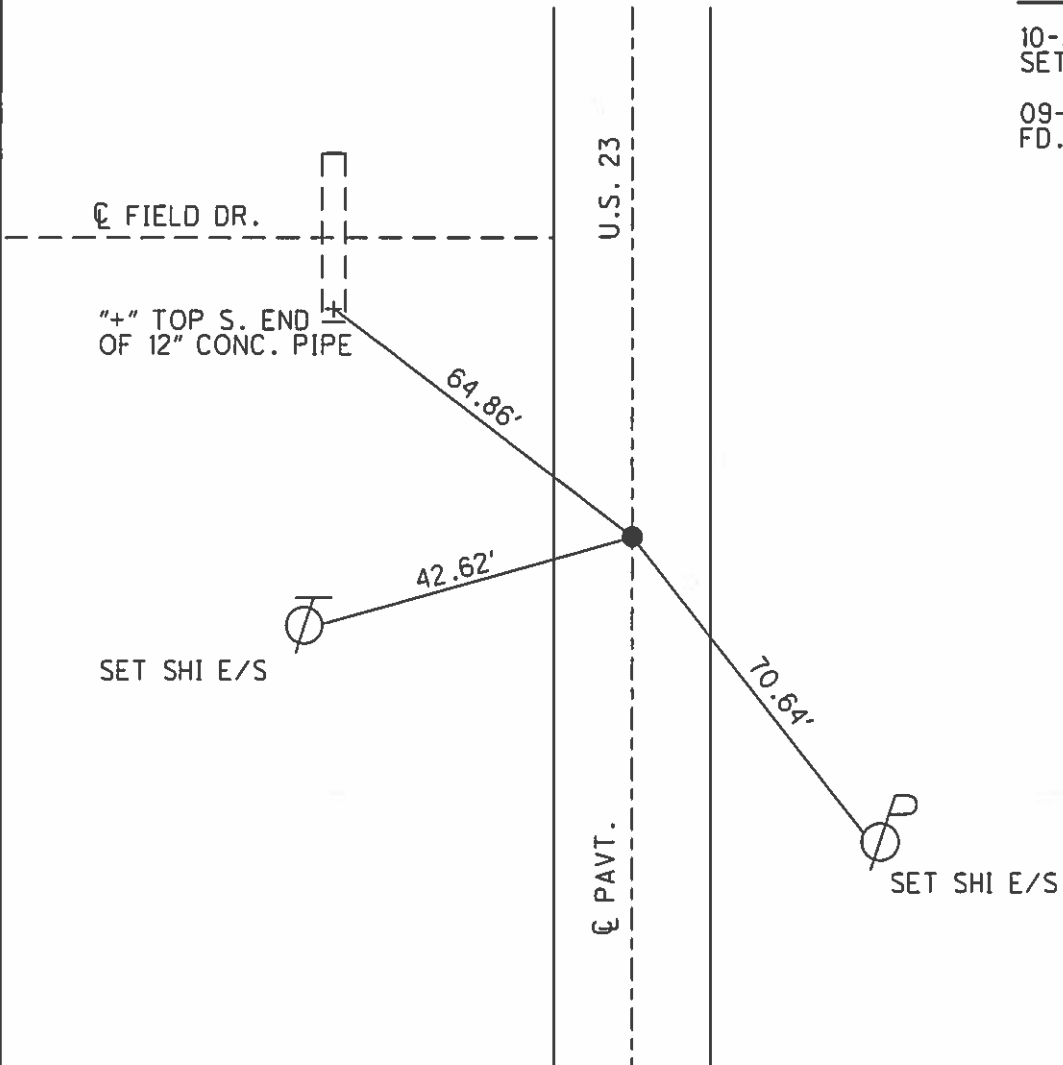

O.D.O.T. DISTRICT 2 SURVEY OFFICE

PERSONNEL

REFERENCE NO. 4

SHEET      OF     

NOTES LOEHRKE

H.C. HOPFMAN

R.C. BARNHISEL

DATE 7-19-89

WEATHER CLOUDY

TEMP. +75

ROUTE U.S. 23

COUNTY SENNECA

TOWNSHIP BIG SPRING

SECTION 32

T      R     



TYPE MONUMENT Sm. R.R. SPIKE Set P.K./WASHER

ON SURFACE - BELOW Yes 10-31-89 SWM


~~LEFT~~ - & PAV'T. - ~~RIGHT~~ Yes

11.6 TO LT EDGE PAVEMENT

S.L.M. 35+66

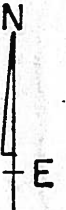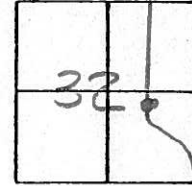

REC. P.I. STA 35+58.82

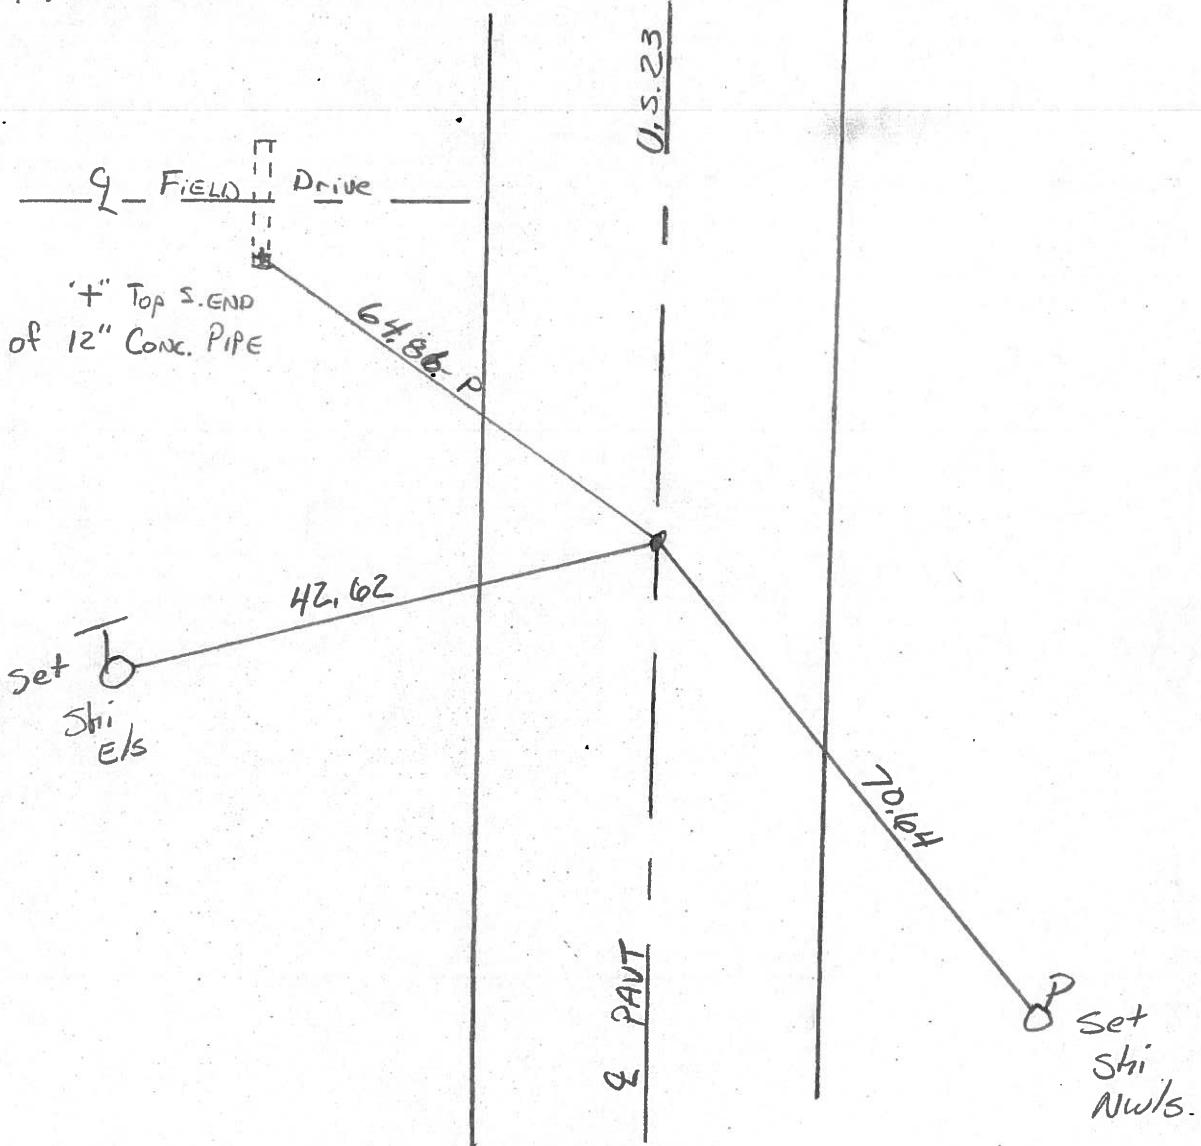

O.D.O.T. DISTRICT 2 SURVEY OFFICE

SHEET

OF

County Seneca S.R.-4.5.23

Township Big Spring

Section 32

T N, R E

Personnel Hoffman


Householder

Date 6-22-81

Weather cloudy

Temp. +70°


# 4

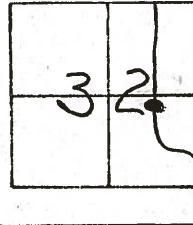

Fd. P.K. Nail/washer @ surface @ ctr. of PAVT.

PROJECT STA. 35+72

SET. SMALL R.R. SPK. 9-29-81 SWH

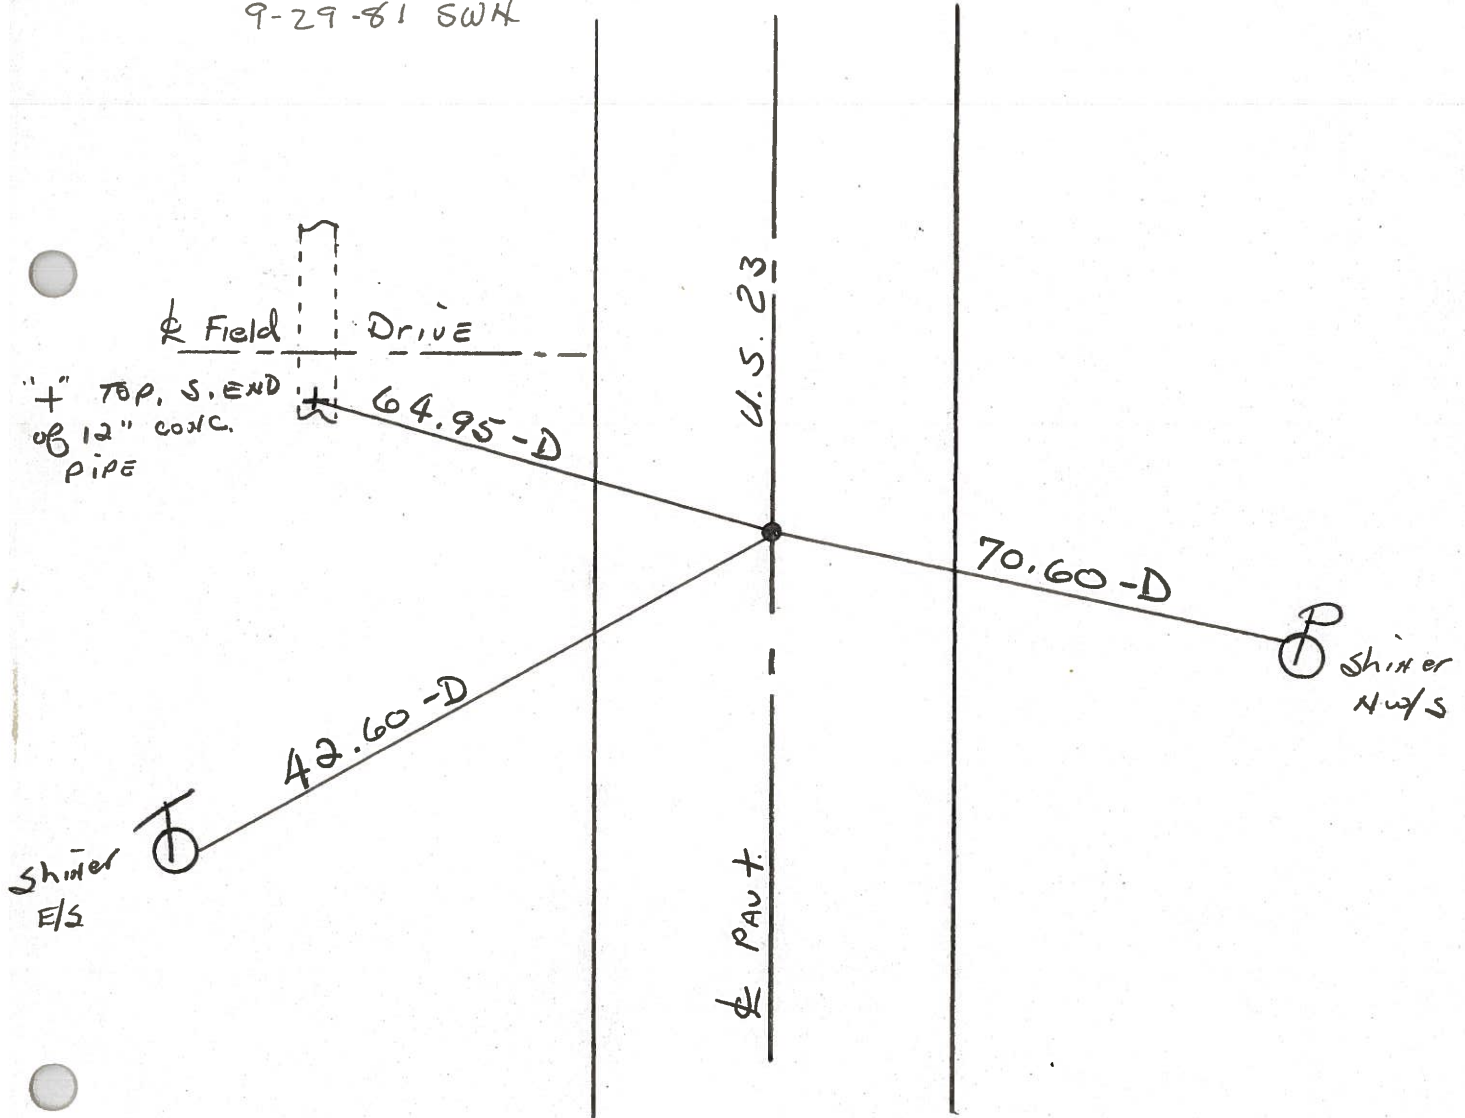


P.I. STA. 35+58.82 - REC




PERSONNEL	TITLE	PERSONNEL	TITLE	COUNTY	DATE	WEATHER	TEMP.
Schneider				Saroca	8-25-	Hot	90°
Mosser				S. R. U.S. 23			
Barbour				SEC. Wyandot Co Line N.			
Potts							

DESCRIPTION Ties for Control Points JOB NO. \_\_\_\_\_


P.I. (5) X  
54+60.69  
Fd. P.K. Nail

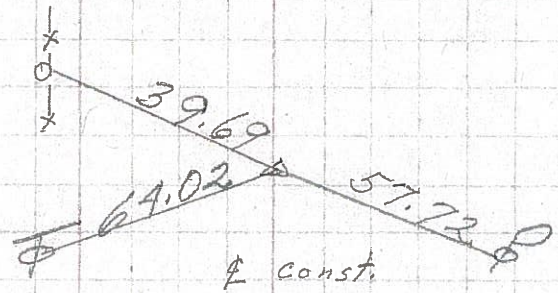


P.I. (4) X  
35+58.82  
P.K. Nail

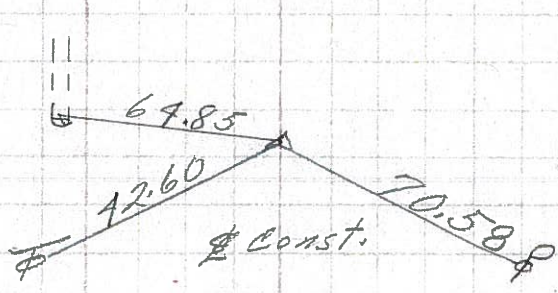

P.I. (3) X  
30+16.32  
Fd. P.K. Nail

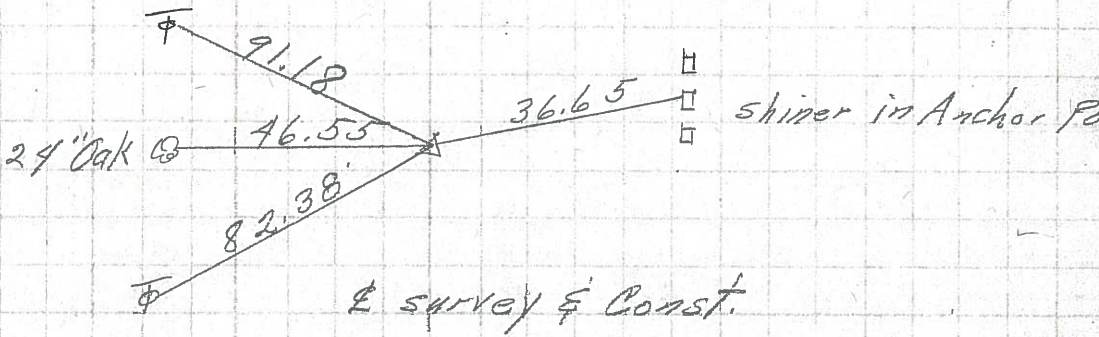

P.I. (2) X  
17+98.63  
 $\Delta = 42^\circ 55' \text{ Rt.}$   
5 mark spk.

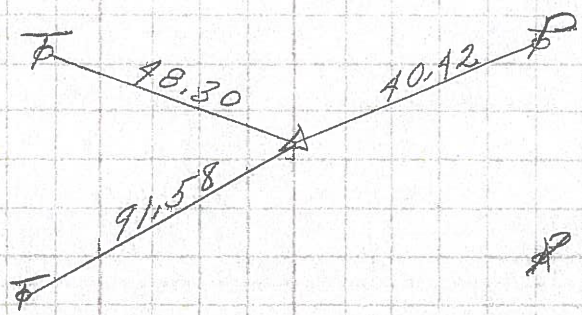

0+00 (1) X  
did not find

