


O.D.O.T. DISTRICT 2 SURVEY OFFICE (USE ONLY)


PERSONNEL \_\_\_\_\_ REFERENCE NO. 6 SHEET 6 OF 22  
 NOTES O'DONNELL DATE 5/11/21 ROUTE US 23  
 H.C. AUBLE WEATHER SUNNY COUNTY SENECA  
 R.C. NIESE TEMP. 45° TOWNSHIP BIG SPRING  
 DWG BY RHOADES PID 85264 SECTION 32  
 T 1 N R 13 E

TYPE MONUMENT SM.R.R.SPIKE  
 ON ~~SURFACE~~ - BELOW 3"  
 OFFSET 0.4' LT : RT  
12.9' TO LT EDGE PAVEMENT  
 STATION: 56+58.97

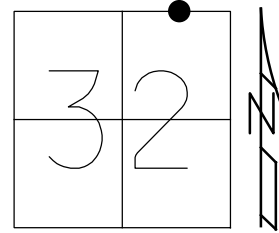

HORZ.DATUM: NAD83 2011 GEOID: NAVD88 2012A  
 GRID: NORTHING: 489484.544 EASTING: 1723689.304


RECORD:  
 STA.56+58.97  
 $\Delta = 0^\circ 52' RT$   
 FD R.R.SPIKE  
 1955  
 FD SM.R.R.SPIKE  
 3" DOWN  
 7/19/89, CL  
 SET P.K./WASHER  
 10/31/89, SWH  
 FD P.K./WASHER  
 9/01/09  
 FD SM.R.R.SPIKE  
 3" DOWN  
 REF6  
 8/16/19  
 5/11/21, JFO  
 SET MAG/WASHER  
 12/10/21, DSA

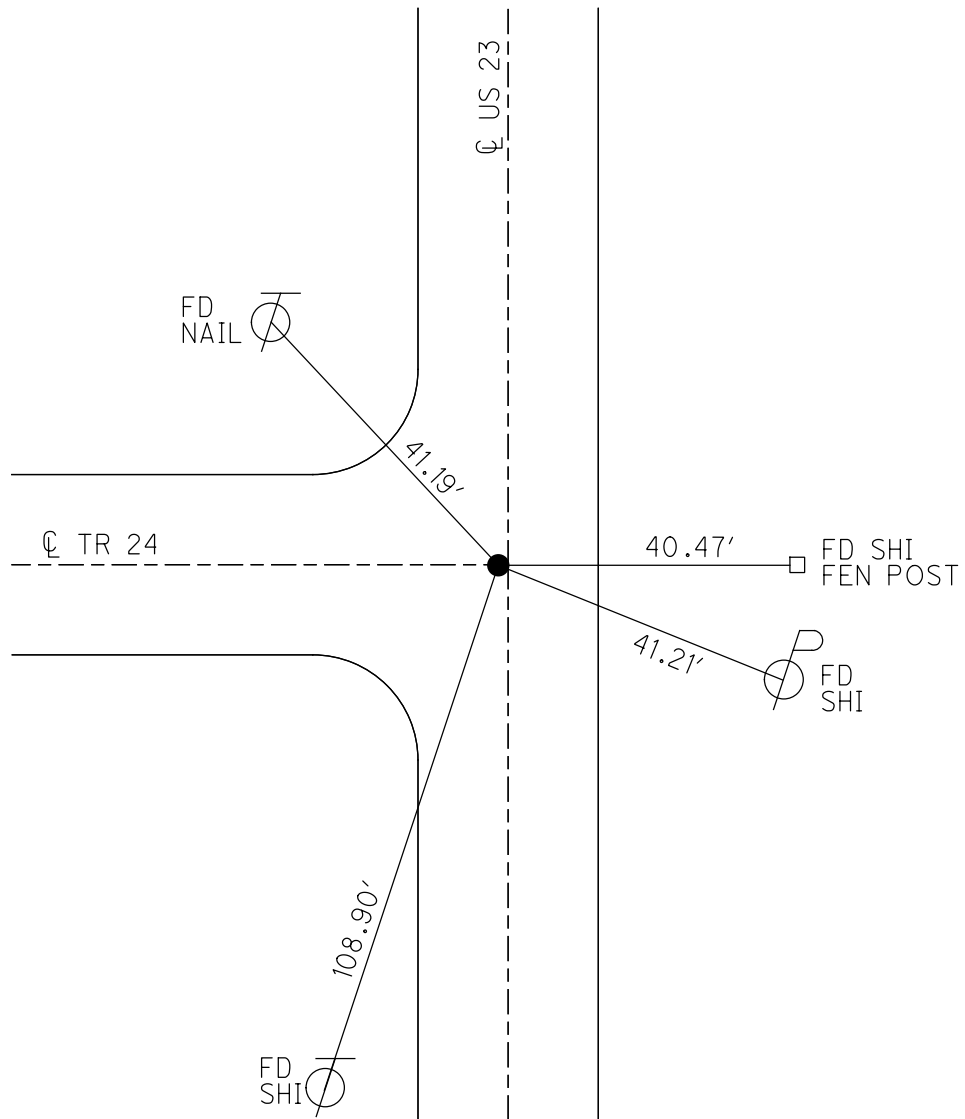

O.D.O.T. DISTRICT 2 SURVEY OFFICE (USE ONLY)


PERSONNEL \_\_\_\_\_ REFERENCE NO. 6 SHEET 6 OF 22  
 NOTES ELKHECHEN DATE 10/29/18 ROUTE US 23  
 H.C. LEU WEATHER CLOUDY COUNTY SENECA  
 R.C. MILLER TEMP. 43° TOWNSHIP BIG SPRING  
 DWG BY NASON PID PT-SEN19 SECTION 32  
 T 1 N R 13 E

TYPE MONUMENT SM. R.R.SPIKE  
 ON ~~SURFACE~~ - BELOW 3"  
 OFFSET  $\varnothing$  PAVEMENT 0.4' LT : RT  
12.9' TO LT. EDGE PAVEMENT  
 STATION: 56+58.97

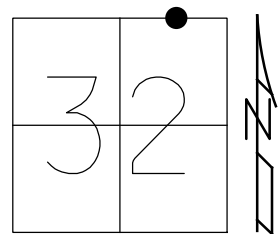

HORZ.DATUM: NAD83 (2011) GEOID: 2012A  
 GRID: NORTHING: 489484.544 EASTING: 1723689.304


RECORD:  
 STA. 56+58.97  
 $\Delta = 0^\circ 52' RT$   
 FD R.R.SPIKE  
 1955  
 FD SM.R.R.SPIKE  
 3" DOWN  
 7/19/89, CL  
 SET P.K./WASHER  
 10/31/89, SWH  
 FD P.K./WASHER  
 9/01/09  
 FD SM.R.R.SPIKE  
 3" DOWN  
 REF6  
 8/16/19, JFO

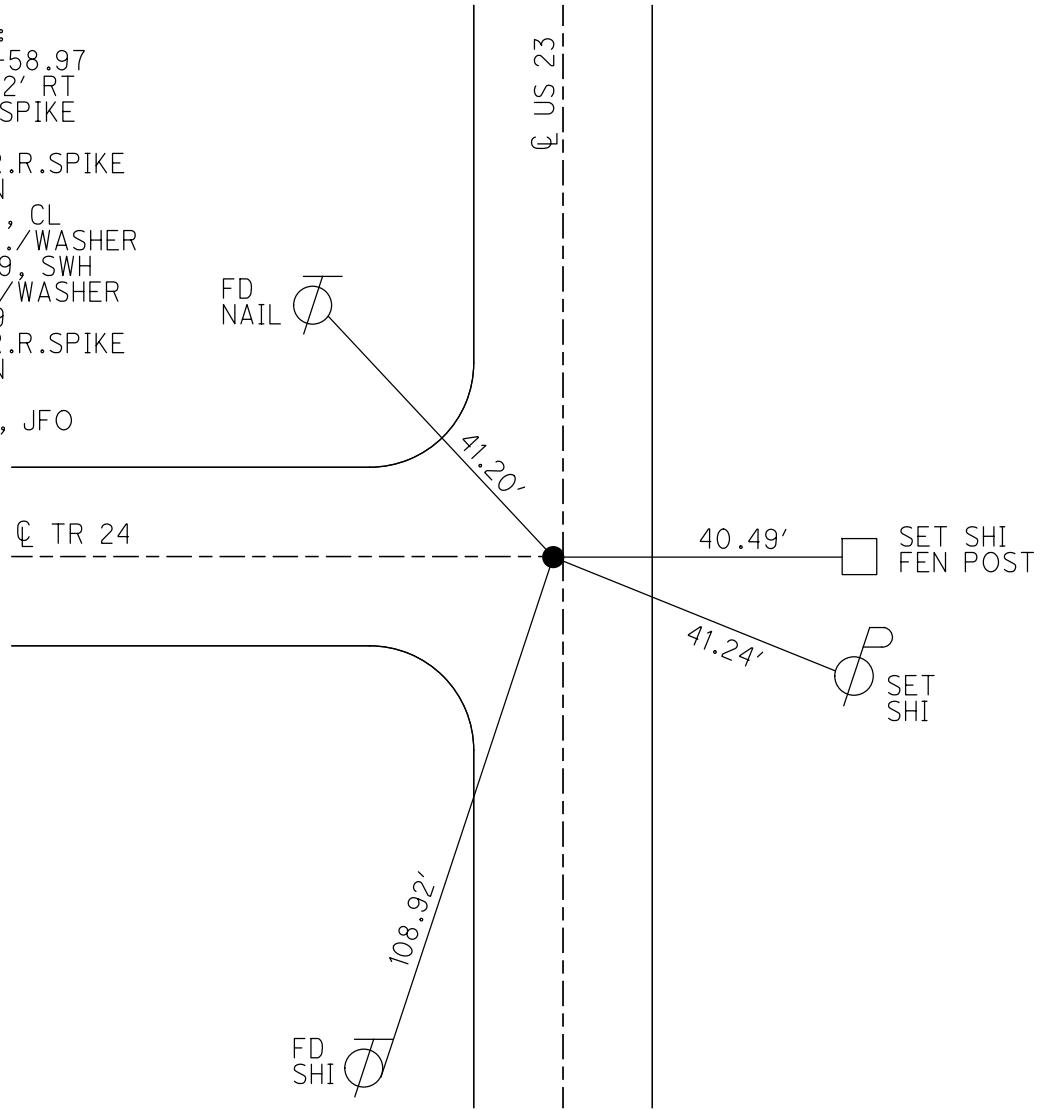

O.D.O.T. DISTRICT 2 SURVEY OFFICE (USE ONLY)

PERSONNEL \_\_\_\_\_ REFERENCE NO. 6 SHEET 6 OF 22  
 NOTES LOEHRKE DATE 07-19-89 ROUTE US 23  
 H.C. HOFFMAN WEATHER CLOUDY COUNTY SENECA  
 R.C. BARNHISEL TEMP. +75 TOWNSHIP BIG SPRING  
 SECTION 32  
 T 1 N R 13 E


TYPE MONUMENT SM. R.R. SPIKE  
 ON SURFACE - ~~BELOW~~ ON SURFACE  
 LEFT - ☉ PAV'T - ~~RIGHT~~ 0.6'  
12.9' TO LT. EDGE PAVEMENT  
 S.L.M. 56+71

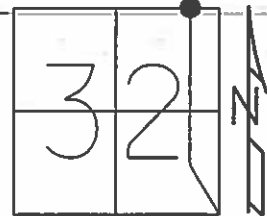

GRID: NORTHING: \_\_\_\_\_ EASTING: \_\_\_\_\_

REC. P.I. STA. 56+58.97

RECORD  
 10-31-89 SWH  
 SET P.K./WASHER  
 09-01-09  
 FD.

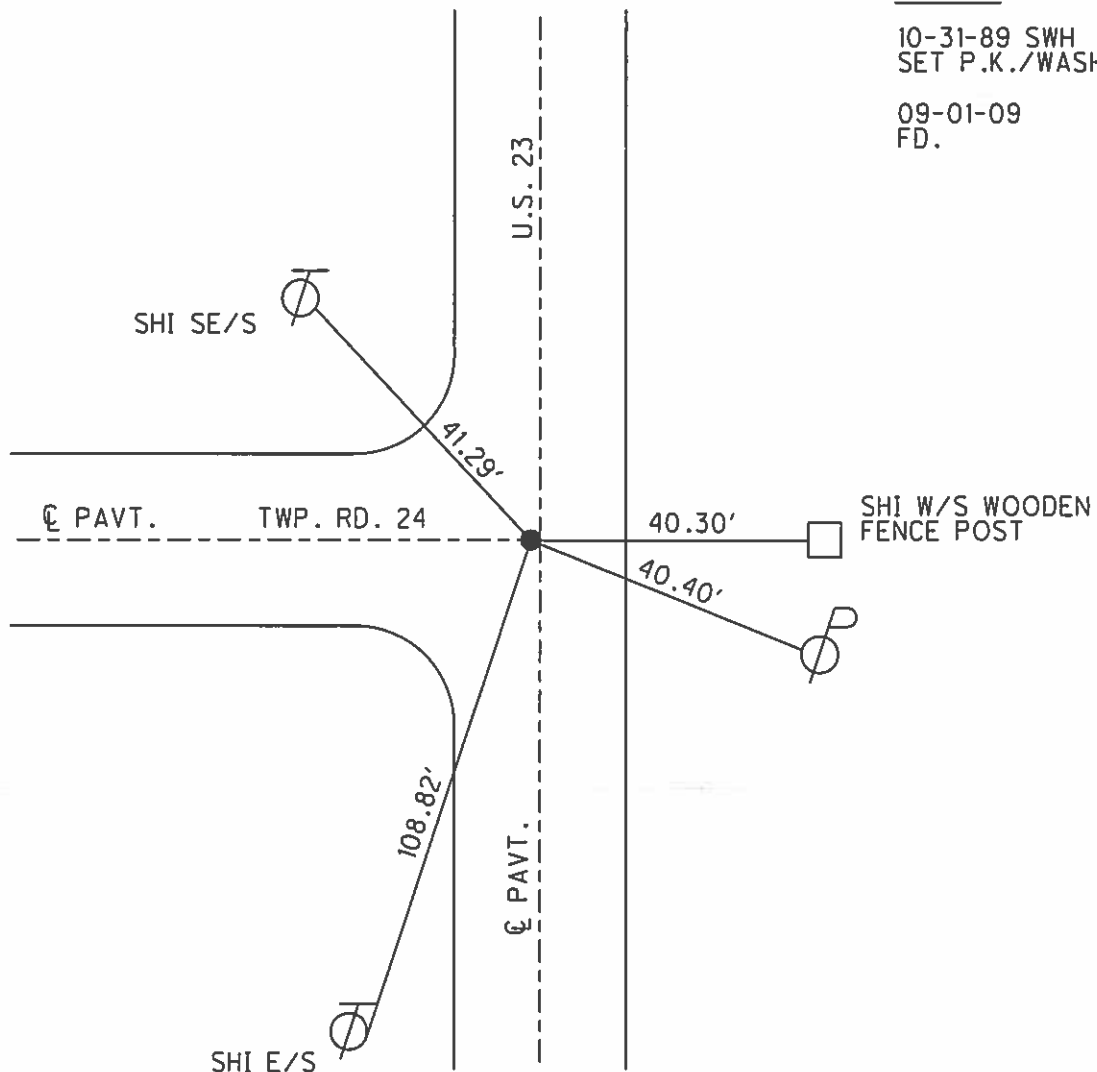

O.D.O.T. DISTRICT 2 SURVEY OFFICE

PERSONNEL

REFERENCE NO. 6

SHEET \_\_\_ OF \_\_\_

NOTES LOEHRKE

H.C. Hoffman

R.C. BARUNISEL

DATE 7-19-89

WEATHER Cloudy

TEMP. +75

ROUTE U.S. 23

COUNTY SENECA

TOWNSHIP BIG SPRING

SECTION 32

T \_\_\_ R \_\_\_

TYPE MONUMENT 3m. R.R. SPIKE


Set P.K./WASHER  
10-31-89 SWK

ON SURFACE - BELOW Yes


LEFT - ~~Q~~ PAV'T. - ~~RIGHT~~ 0.6' Lt

12.9 TO Rt EDGE PAVEMENT

S.L.M. 56+71

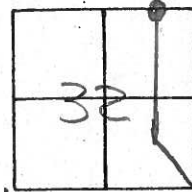

Rec. P.I. Sta 56+58.97

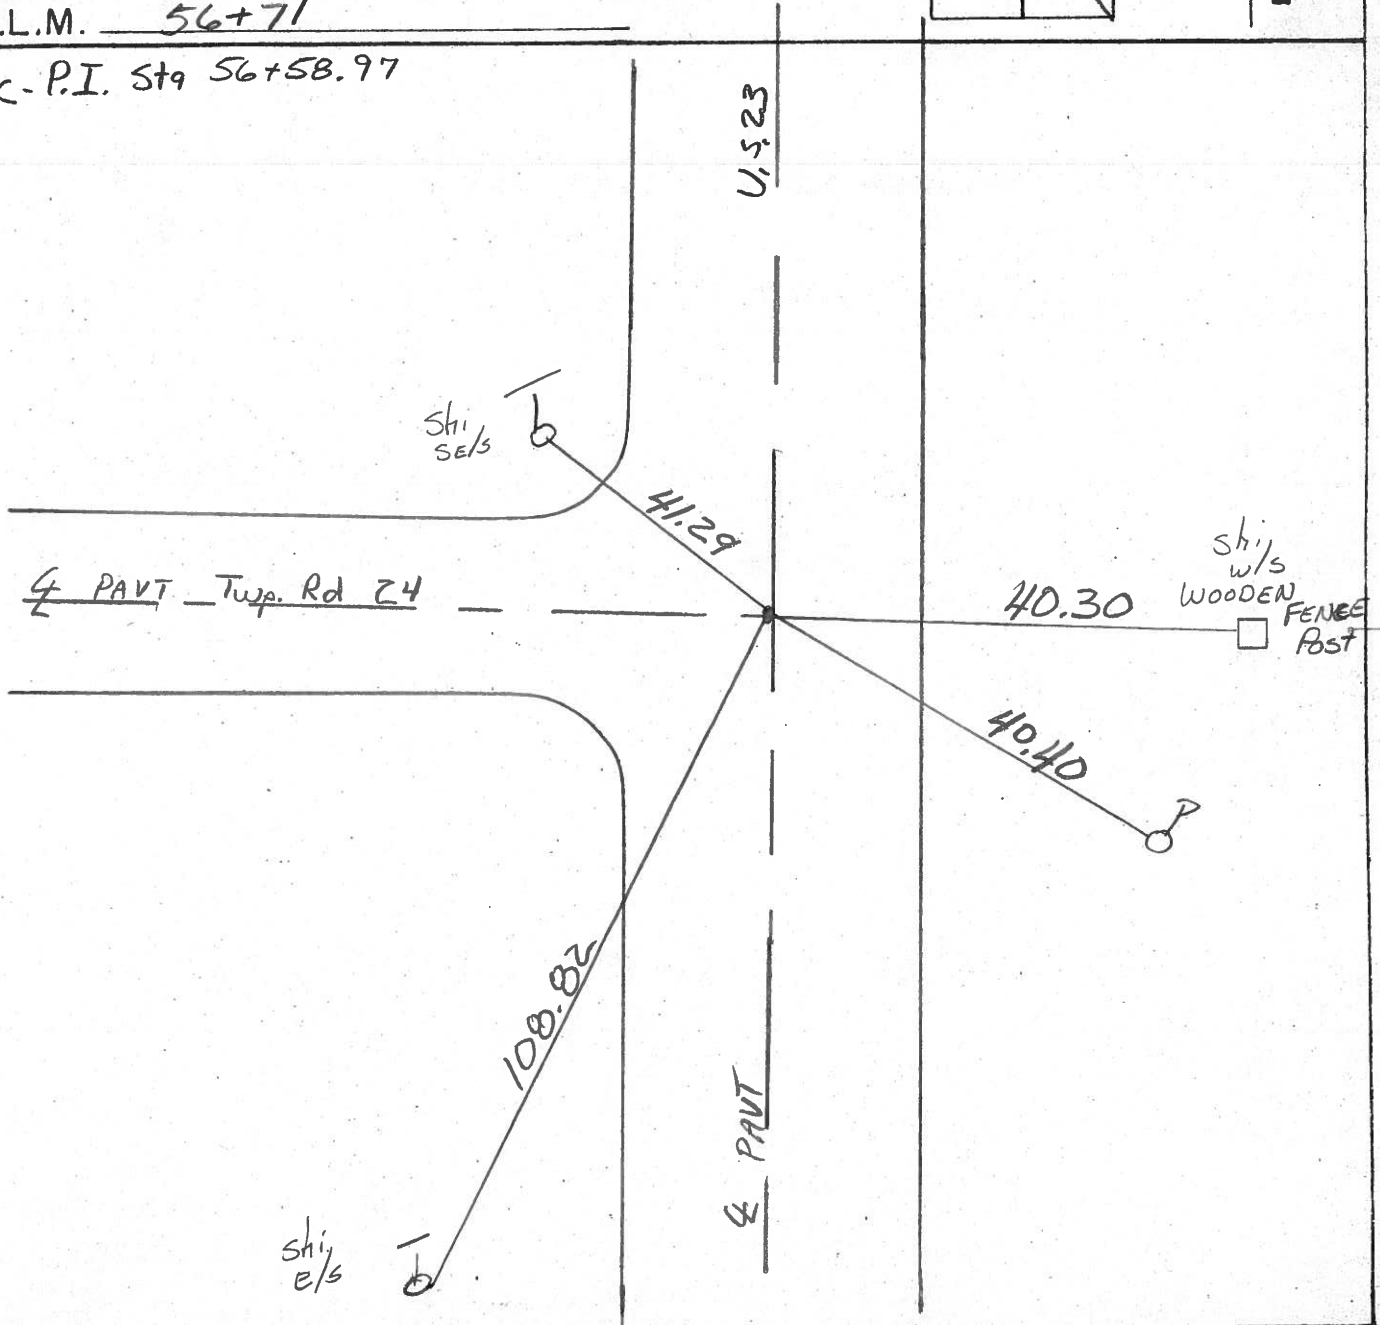

O.D.O.T. DISTRICT 2 SURVEY OFFICE

SHEET

OF

County Seneca S.R. 4.5.23

Date 6-22-81

Township Big Spring


Weather cloudy

Section 32

Temp. +70°

T N, R E

Personnel Hoffman

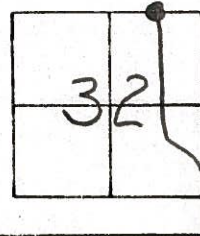


Householder

#6

Rd. P. K. Nail/washer @ surface  
12' to E. Edge PAUT.

Project Sta. ± 56+78

SET SMALL R.R. SPK.  
9-29-81 SWH

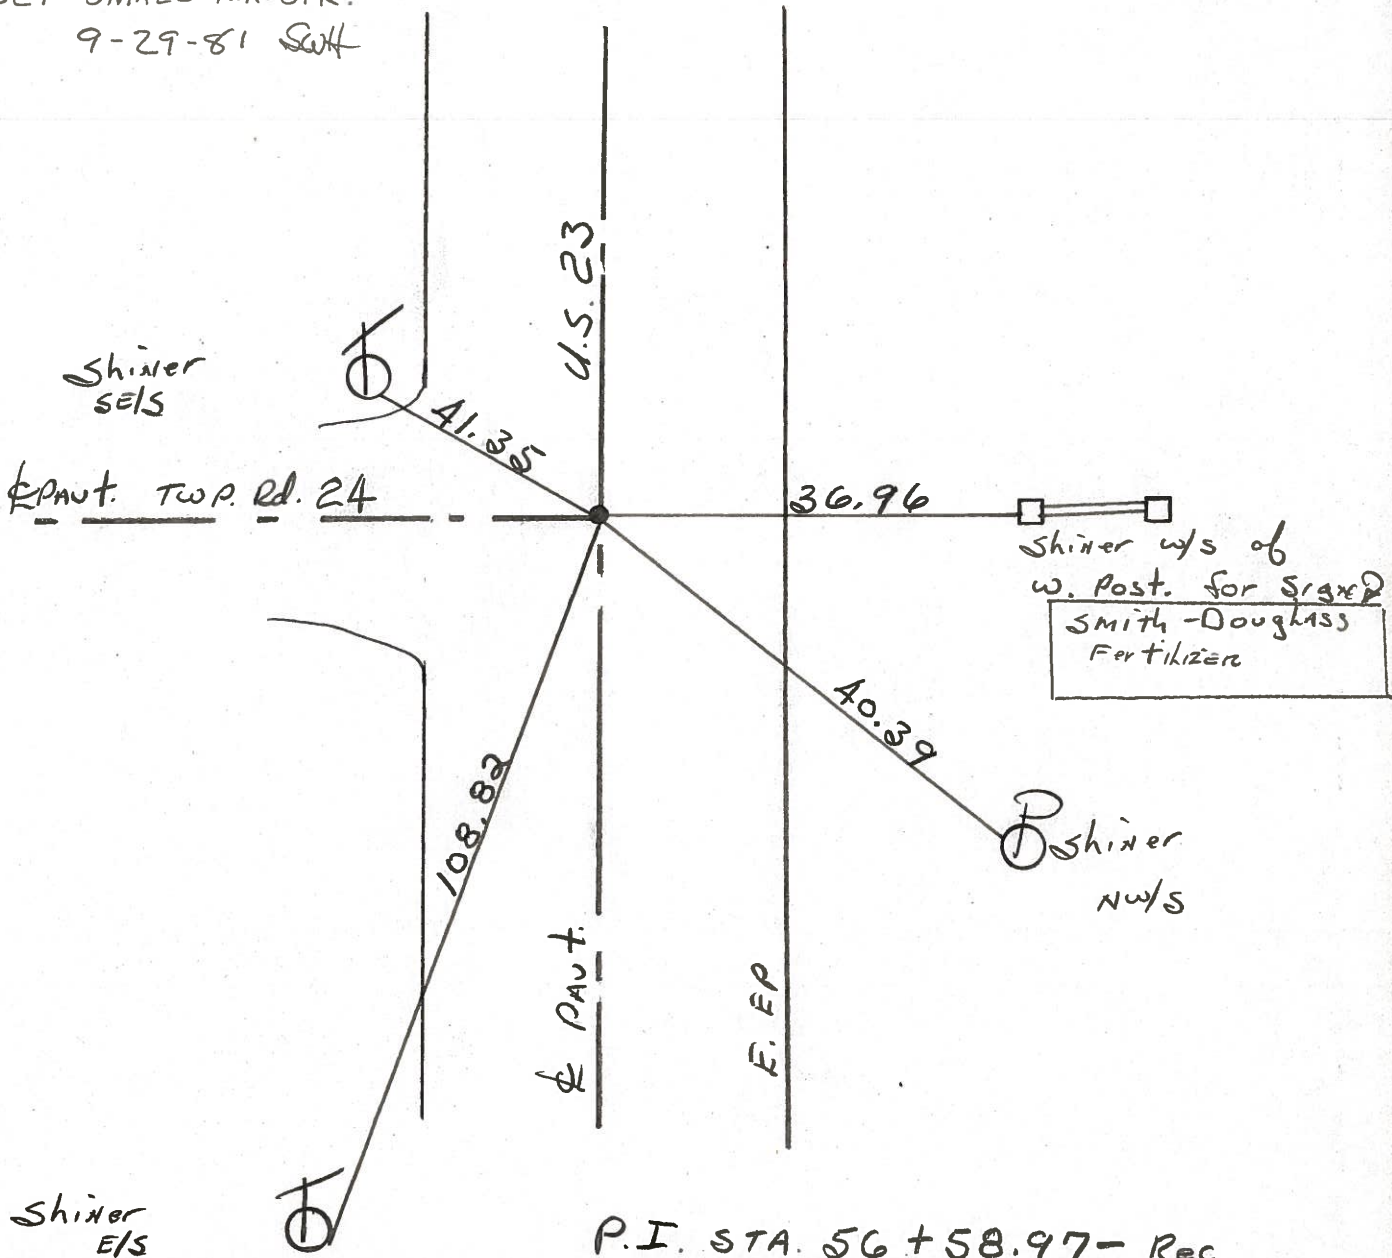


P.I. STA. 56+58.97 - Rec



PERSONNEL	TITLE	PERSONNEL	TITLE	COUNTY	Seneca	DATE	8-25-61
Schneider				S. R.	U.S. 23	WEATHER	Hot
Masser				SEC.	Wyandot Co. Line N.	TEMP.	90°
Barbour							
Potts							
DESCRIPTION				Ties for Control Points		JOB NO.	


P.I. (9) X  
 95+46.81  
 $\Delta = 70^\circ 14' \text{ Lt.}$   
 Fd. N. & S. 3" down

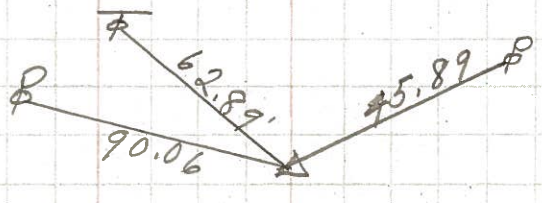

COULD NOT FIND  
 S.H.  
 6-22-81

Survey


P.I. (5) X  
 93+90.53  
 Fd. P.K. Nail  
 $\Delta = 59^\circ 30' \text{ Lt.}$

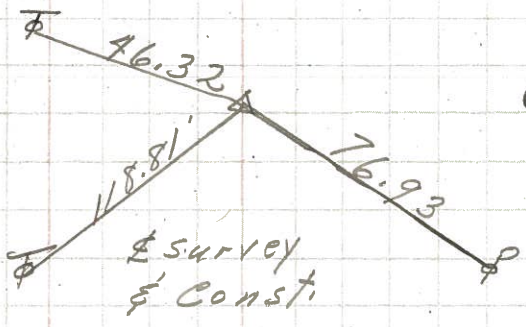

COULD NOT FIND  
 S.H.  
 6-22-81


Survey  
 & Const.

P.I. (7) X  
 67+42.27  
 P.K. Nail  
 Co. Rd. # 59

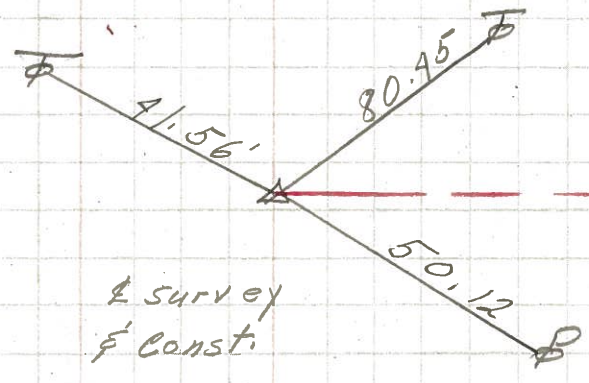

Survey  
 & Const.

P.I. (6) X  
 56+58.97  
 P.K. Nail

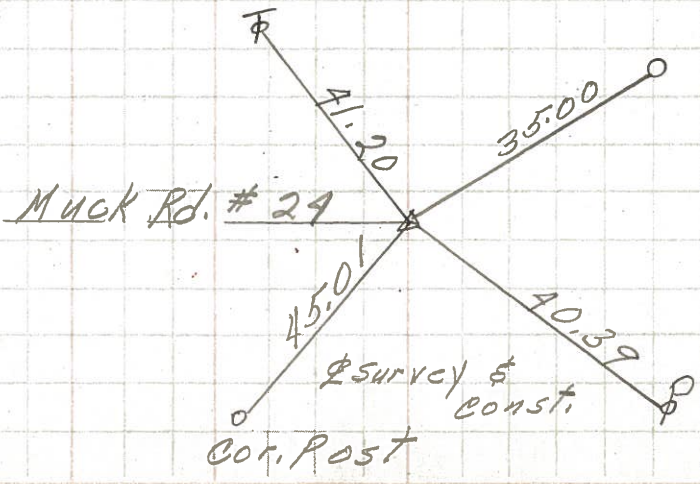

Cor. Post

MUCK Rd. # 29

Survey  
 & Const.

Cor. Post