


O.D.O.T. DISTRICT 2 SURVEY OFFICE (USE ONLY)


PERSONNEL _____ REFERENCE NO. 7 SHEET 7 OF 22
 NOTES O'DONNELL DATE 5/11/21 ROUTE US 23
 H.C. AUBLE WEATHER SUNNY COUNTY SENECA
 R.C. NIESE TEMP. 45° TOWNSHIP BIG SPRING
 DWG BY RHOADES PID 85264 SECTION 29
 T 1 N R 13 E

TYPE MONUMENT P.K.NAIL
 ON SURFACE - ~~BELOW~~ ON _____
 OFFSET \bar{C} PAVEMENT 0.5' LT : RT
11.3' TO LT EDGE PAVEMENT
 STATION: 67+42.27

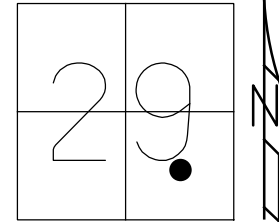

HORZ.DATUM: NAD83 2011 GEOID: NAVD88 2012A
 GRID: NORTHING: 490567.747 EASTING: 1723702.566

RECORD: P.I.
 STA. 67+42.27
 $\Delta = 0^\circ 05' \text{ LT}$
 FD R.R.SPIKE
 1955
 SET P.K./WASHER
 10/31/89, SWH
 FD SM.R.R.SPIKE
 7/19/89, CL
 FD P.K.SHANK
 9/01/09
 FD P.K.NAIL
 REF7
 4/15/19
 8/10/19
 5/11/21, JFO
 SET MAG/WASHER
 12/10/21, DSA

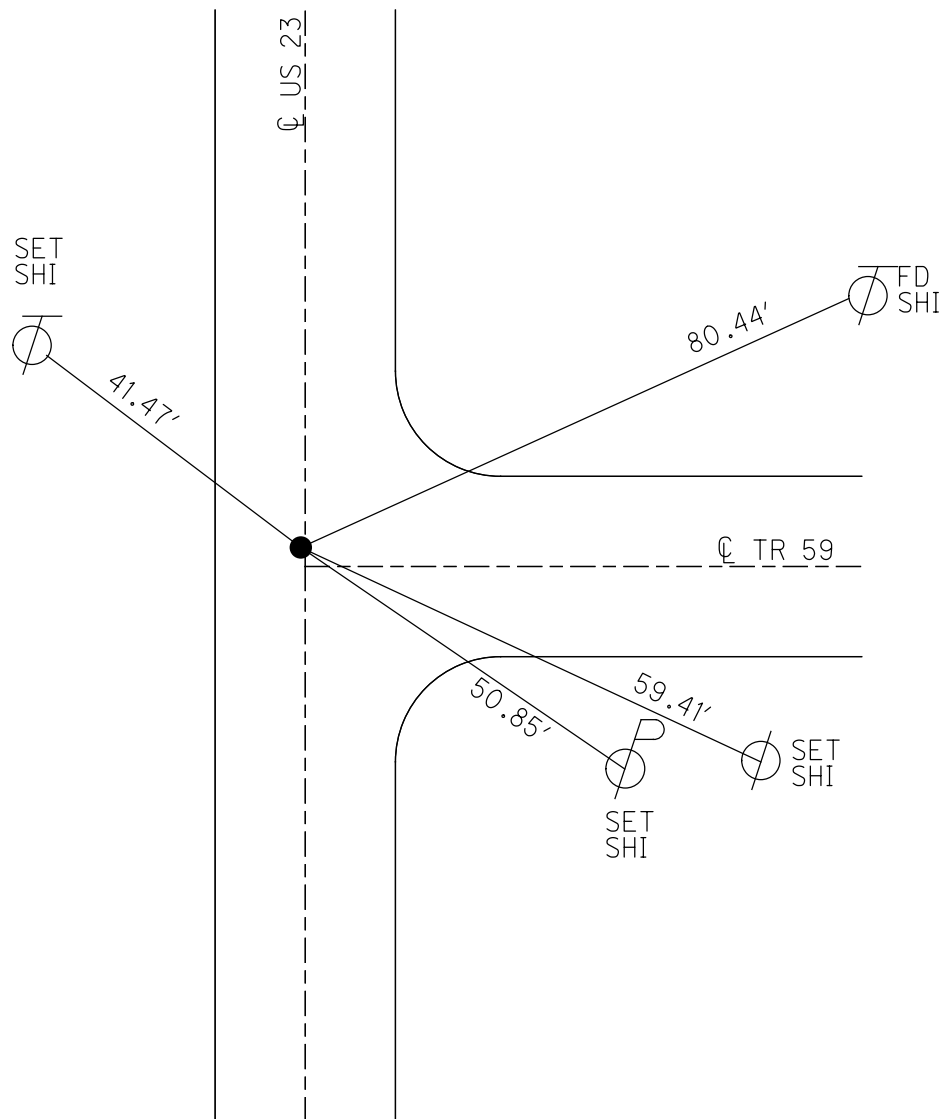

O.D.O.T. DISTRICT 2 SURVEY OFFICE (USE ONLY)

PERSONNEL

REFERENCE NO. 7

SHEET 7 OF 22

NOTES LOEHRKE

DATE 7/19/89

ROUTE US 23

H.C. HOFFMAN

WEATHER CLOUDY

COUNTY SENECA

R.C. BARNHISEL

TEMP. 75°

TOWNSHIP BIG SPRING

SECTION 29

DWG BY NASON

PID PT-SEN19

T 1 N R 13 E

TYPE MONUMENT SM.R.R.SPIKE

ON SURFACE - ~~BELOW~~ ON

OFFSET \varnothing PAVEMENT 0.5' LT : ~~RT~~

11.3' TO LT. EDGE PAVEMENT


STATION: 67+42.27

HORZ.DATUM: NAD83 (2011)


GEOID: 2012A

GRID: NORTHING: 490567.747

EASTING: 1723702.566

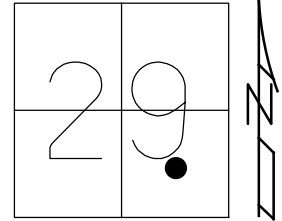

RECORD: P.I.
 STA. 67+42.27
 $\Delta = 0^\circ 05' \text{ LT}$
 FD R.R.SPIKE
 1955
 SET P.K./WASHER
 10/31/89, SWH
 FD SM.R.R.SPIKE
 7/19/89, CL
 FD P.K.SHANK
 9/01/09
 FD P.K.NAIL
 REF7
 4/15/19, JFO
 8/10/19, JFO

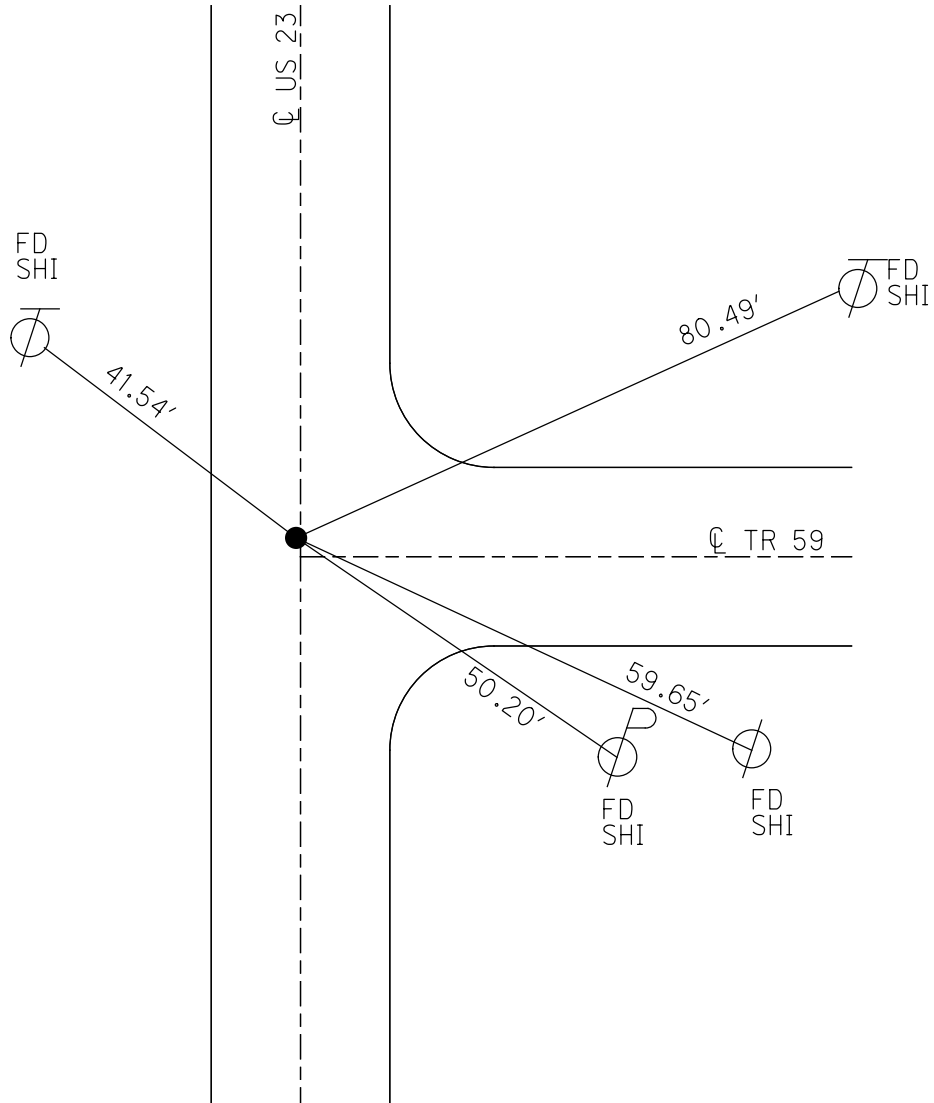

O.D.O.T. DISTRICT 2 SURVEY OFFICE (USE ONLY)

PERSONNEL _____ REFERENCE NO. 7 SHEET 7 OF 22
 NOTES LOEHRKE DATE 07-19-89 ROUTE US 23
 H.C. HOFFMAN WEATHER CLOUDY COUNTY SENECA
 R.C. BARNHISEL TEMP. +75 TOWNSHIP BIG SPRING
 SECTION 29
 T 1 N R 13 E


TYPE MONUMENT SM. R.R. SPIKE

ON SURFACE - ~~BELOW~~ ON SURFACE

LEFT - ☉ PAV'T - ~~RIGHT~~ 0.5' LT., 2.3' N. OF ☉ C.R. 59
11.3' TO LT. EDGE PAVEMENT

S.L.M. 67+57

GRID: NORTHING: _____ EASTING: _____

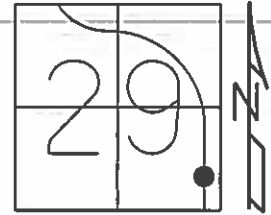


REC. P.I. STA. 67+42.27

RECORD

10-31-89 SWH
 SET P.K./WASHER

09-01-09
 FD. SHANK

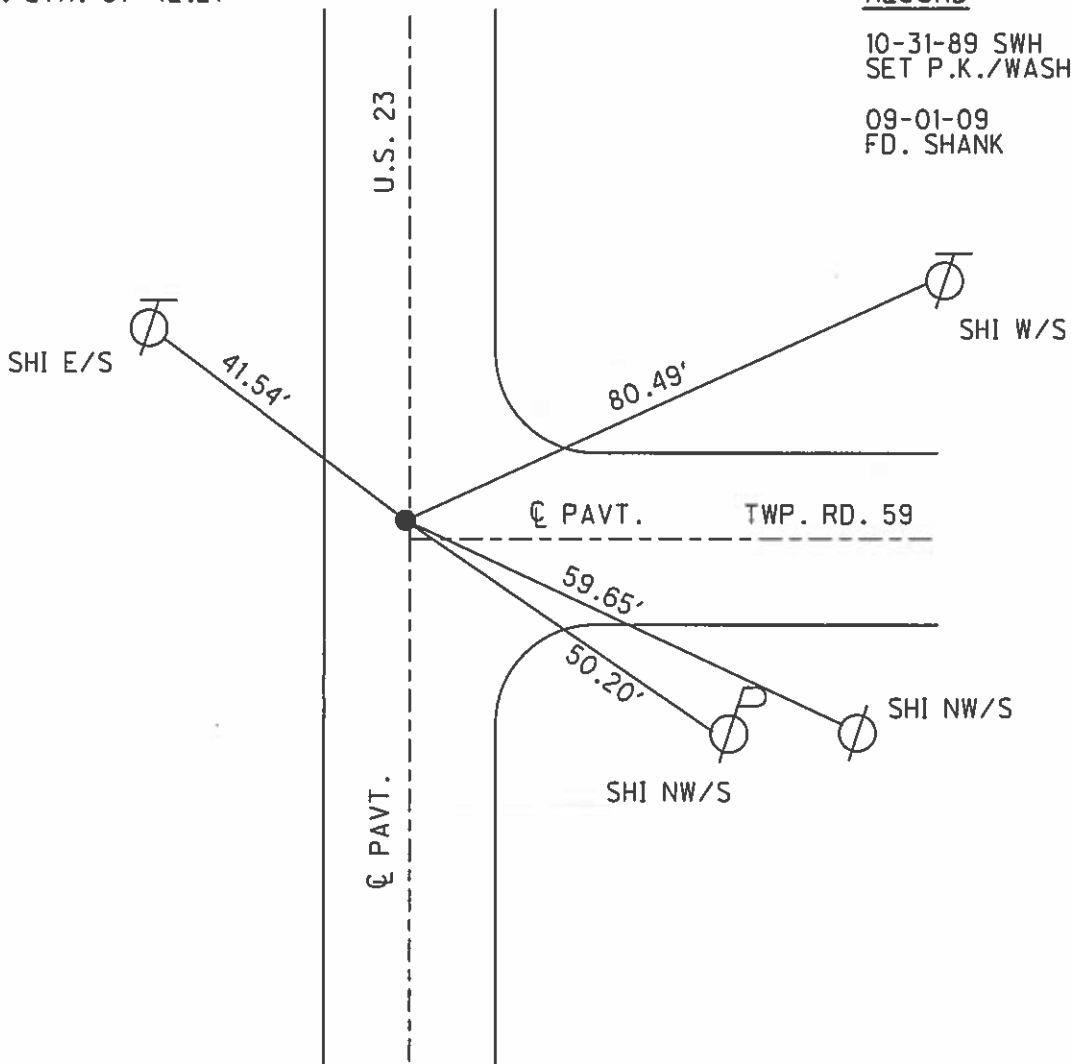

O.D.O.T. DISTRICT 2 SURVEY OFFICE

PERSONNEL

REFERENCE NO. 7

SHEET OF

NOTES LOEHRKE

H.C. Hoffman

R.C. BARNHISEL

DATE 7-19-89

WEATHER CLOUDY

TEMP. +75

ROUTE U.S. 23

COUNTY Seneca

TOWNSHIP BIG SPRING

SECTION 29

T R

TYPE MONUMENT Sm R.R. Spike

*Set P.K./WASHER
10-31-89 SWK*


ON SURFACE - BELOW Yes

LEFT-~~C~~ PAV'T. - RIGHT 0.5' Lt


*2.3 NoP
Q Rd EAST*

11.3 TO Lt EDGE PAVEMENT

S.L.M. 67+57

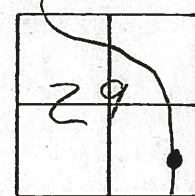

REC. - P.I. Sta 67+42.27

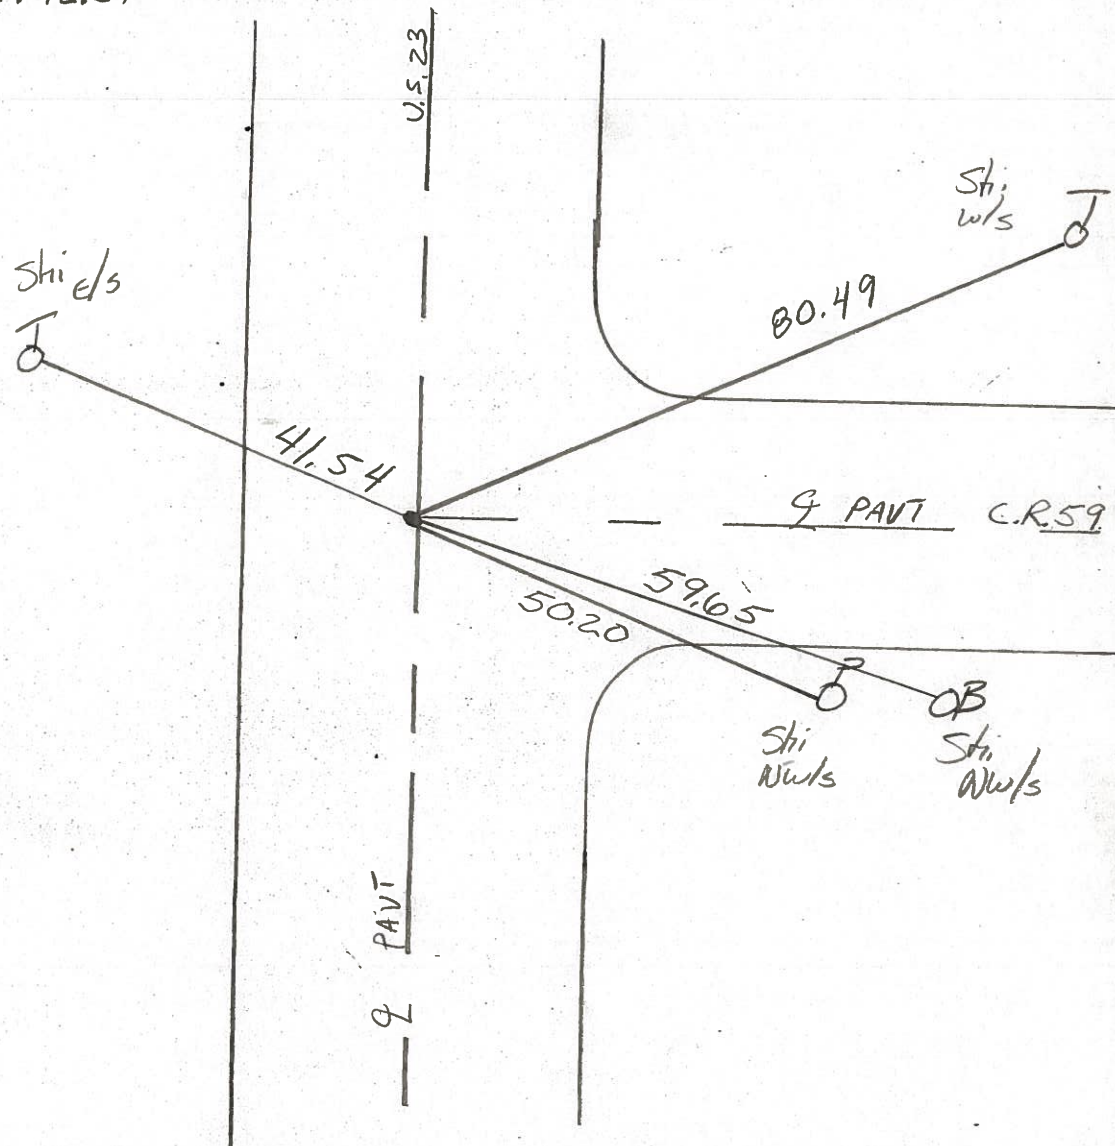

O.D.O.T. DISTRICT 2 SURVEY OFFICE

SHEET

OF

County Seneca S.R. U.S. 23

Township Big Spring

Section 29

T N, R E

Personnel Hoffman


Householder

Date 6-22-81

Weather cloudy

Temp. +70°

#7

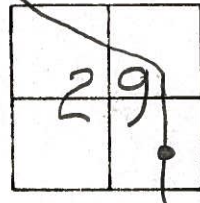


Fd. P.K. Nail/washer @ surface @ ctr. of PAUTS.

Project STA. ± 67+63

SET SMALL R.R. SPK.

9-29-81 SWH

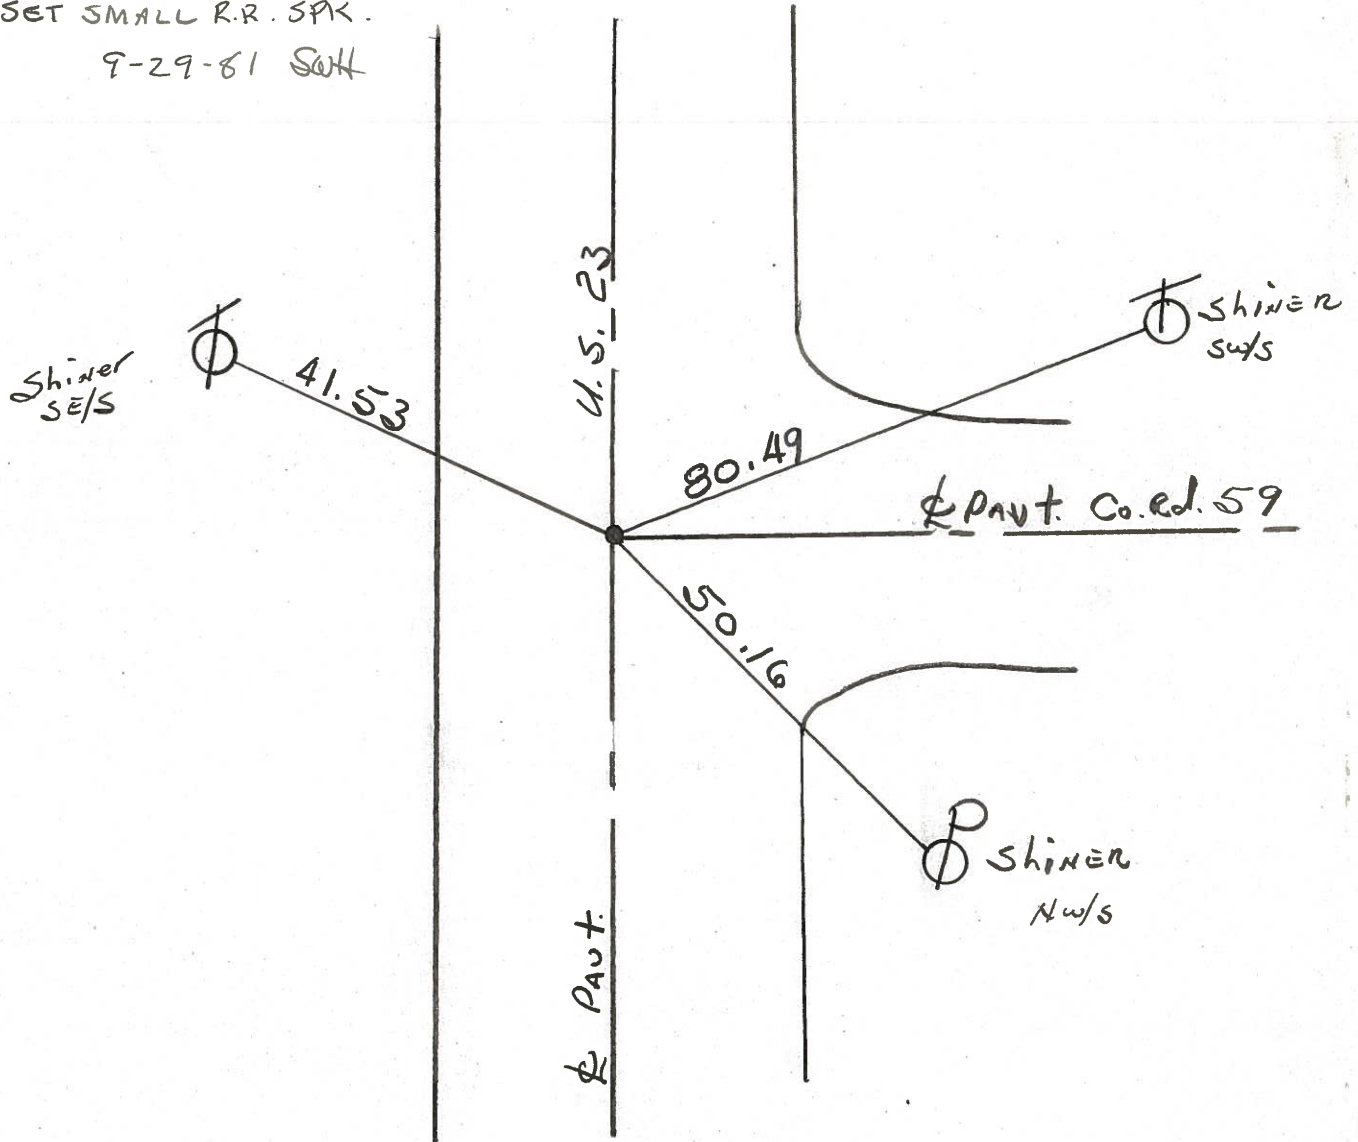

P.I. STA. 67+42.27-Rec.

PERSONNEL	TITLE	PERSONNEL	TITLE	COUNTY	DATE	WEATHER	TEMP
Schneider				Seneca	8-25-69	Hot	90°
Mosser				U.S. 23			
Barbour				Wyandot Co. Line N.			
Potts							

DESCRIPTION Ties for Control Points JOB NO. _____

