

O.D.O.T. DISTRICT 2 SURVEY OFFICE (USE ONLY)

PERSONNEL

REFERENCE NO. 7 A

SHEET 8 OF 22

NOTES O'DONNELL

DATE 5/11/21

ROUTE US 23

H.C. AUBLE

WEATHER SUNNY

COUNTY SENECA

R.C. NIESE

TEMP. 45°

TOWNSHIP BIG SPRING

SECTION 29

DWG BY RHOADES PID 85264

T 1 N R 13 E


TYPE MONUMENT SM.R.R.SPIKE

ON ~~SURFACE~~ - BELOW 3.5"

OFFSET 0.5'  $\text{C}$  PAVEMENT LT : ~~RT~~

11.1' TO LT EDGE PAVEMENT

STATION: 83+42.33

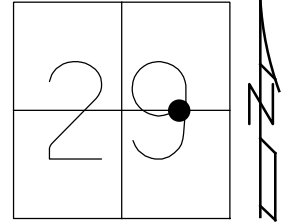


HORIZ.DATUM: NAD83 2011

GEOID: NAVD88 2012A

GRID: NORTHING: 492170.057

EASTING: 1723721.813

RECORD: P.O.T.  
 STA.83+42.33  
 FD R.R.SPIKE  
 1955  
 FD SM.R.R.SPIKE  
 7/19/89, CL  
 SET P.K./WASHER  
 10/31/89, SWH  
 FD P.K./WASHER  
 9/01/09  
 FD SM.R.R.SPIKE  
 3.5" DOWN  
 REFA7  
 8/16/19  
 5/11/21, JFO  
 SET MAG/WASHER  
 12/10/21, DSA

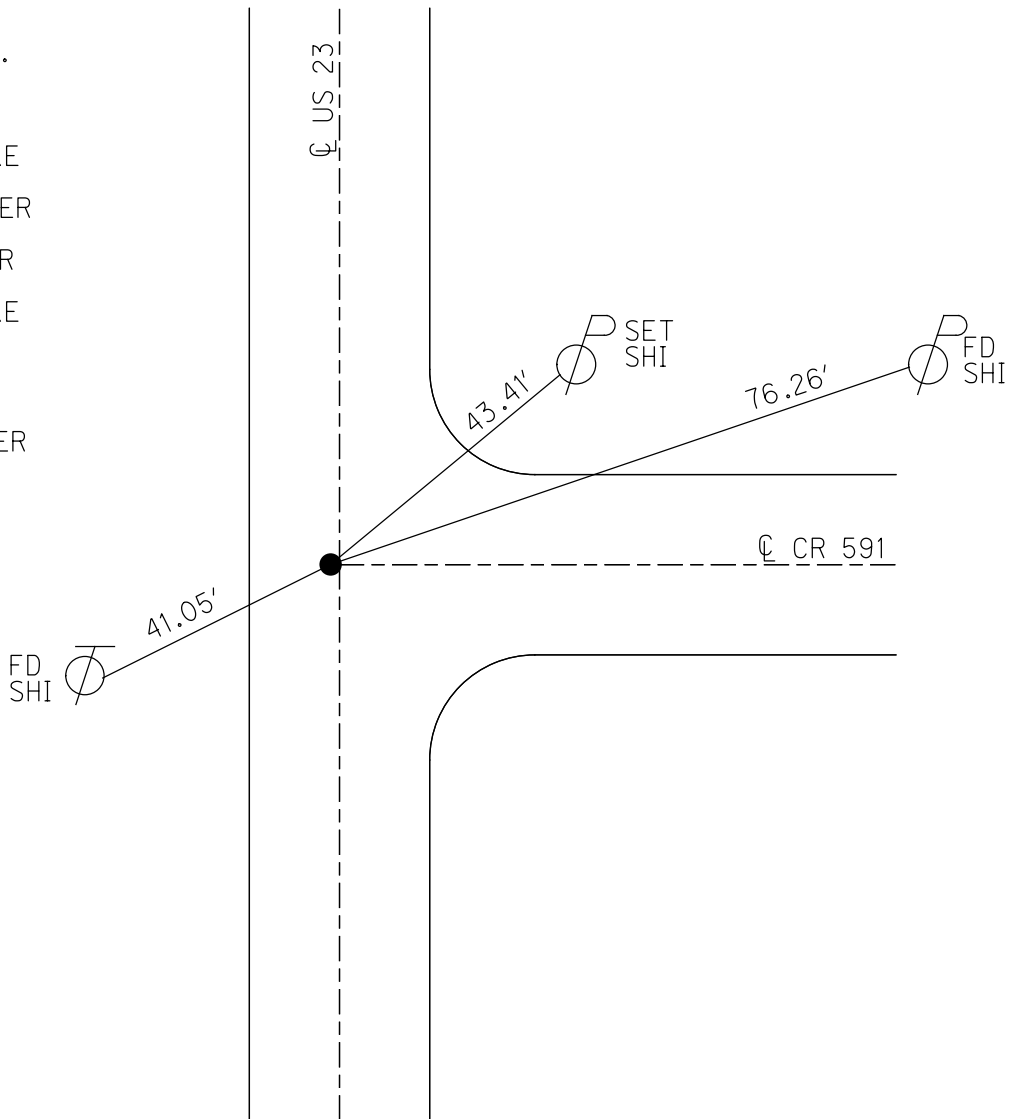

O.D.O.T. DISTRICT 2 SURVEY OFFICE (USE ONLY)

PERSONNEL

REFERENCE NO. 7 A

SHEET 8 OF 22

NOTES ELKHECHEN

DATE 10/29/18

ROUTE US 23

H.C. LEU

WEATHER CLOUDY

COUNTY SENECA

R.C. MILLER

TEMP. 43°

TOWNSHIP BIG SPRING

DWG BY NASON

PID PT- SEN19

SECTION 29

T 1 N R 13 E

TYPE MONUMENT SM.R.R.SPIKE

ON ~~SURFACE~~ - BELOW 3.5"

OFFSET 0.5' LT : ~~RT~~

11.1' TO LT EDGE PAVEMENT


STATION: 83+42.33

HORZ.DATUM: NAD83 (2011)


GEOID: 2012A

GRID: NORTHING: 492170.057

EASTING: 1723721.813

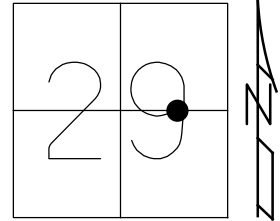


RECORD: P.O.T.  
 STA. 83+42.33  
 $\Delta = 0^{\circ} 00'$   
 FD R.R.SPIKE  
 1955  
 FD SM.R.R.SPIKE  
 7/19/89, CL  
 SET P.K./WASHER  
 10/31/89, SWH  
 FD P.K./WASHER  
 9/01/09  
 FD SM.R.R.SPIKE  
 3.5" DOWN  
 REFA7  
 8/16/19, JFO

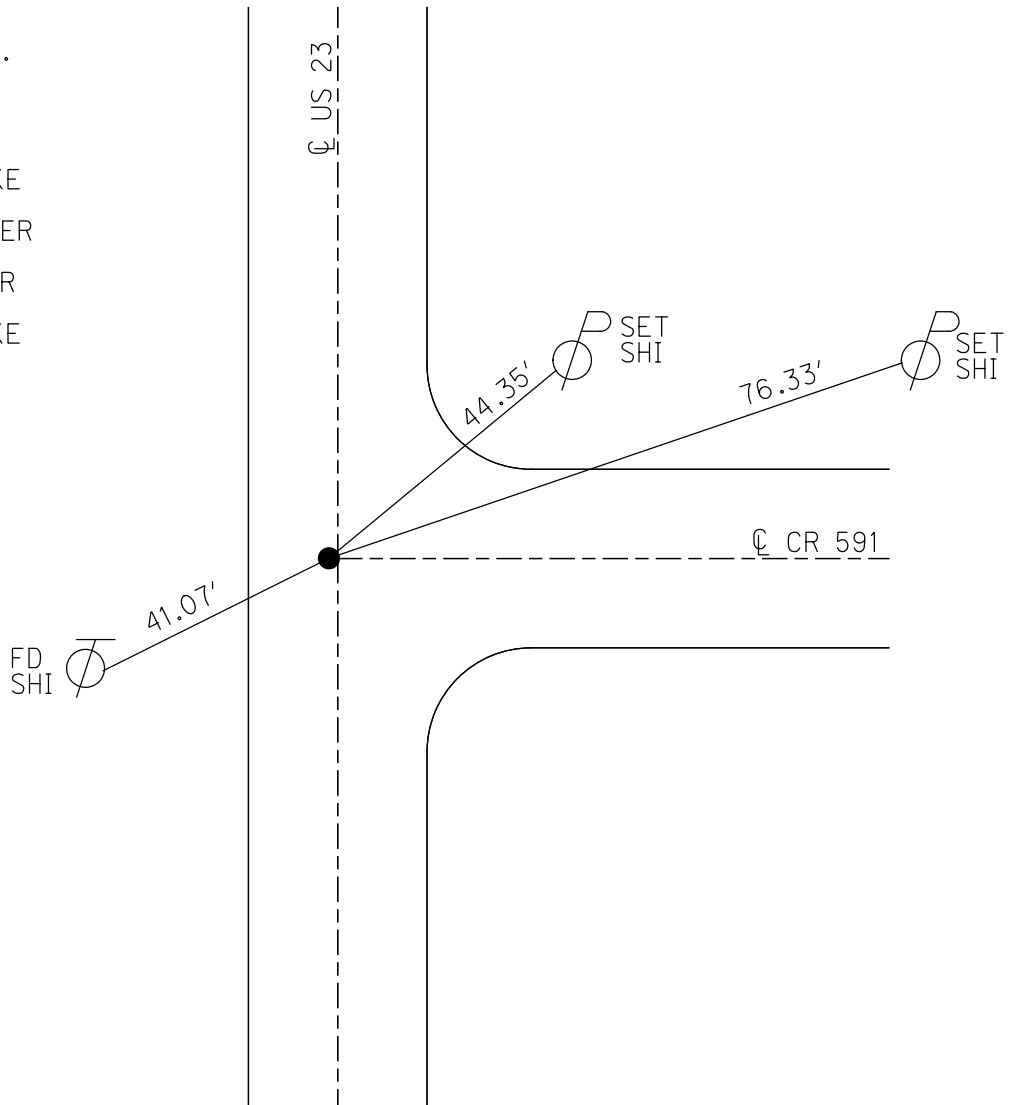

O.D.O.T. DISTRICT 2 SURVEY OFFICE (USE ONLY)


PERSONNEL \_\_\_\_\_ REFERENCE NO. 7-A SHEET 8 OF 22  
 NOTES LOEHRKE DATE 07-19-89 ROUTE US 23  
 H.C. HOFFMAN WEATHER CLOUDY COUNTY SENECA  
 R.C. BARNHISEL TEMP. +75 TOWNSHIP BIG SPRING  
 \_\_\_\_\_ SECTION 29  
 \_\_\_\_\_ T 1 N R 13 E

TYPE MONUMENT SM. R.R. SPIKE  
 ON SURFACE - ~~BELOW~~ ON SURFACE  
 LEFT - Q PAV'T - ~~RIGHT~~ 0.5'  
11.1' TO LT. EDGE PAVEMENT  
 S.L.M. 83+63  
 GRID: NORTHING: \_\_\_\_\_ EASTING: \_\_\_\_\_

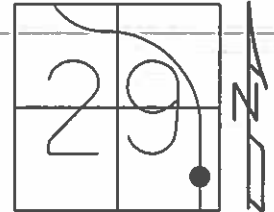

RECORD

10-31-89 SWH  
 SET P.K./WASHER  
 09-01-09  
 FD.

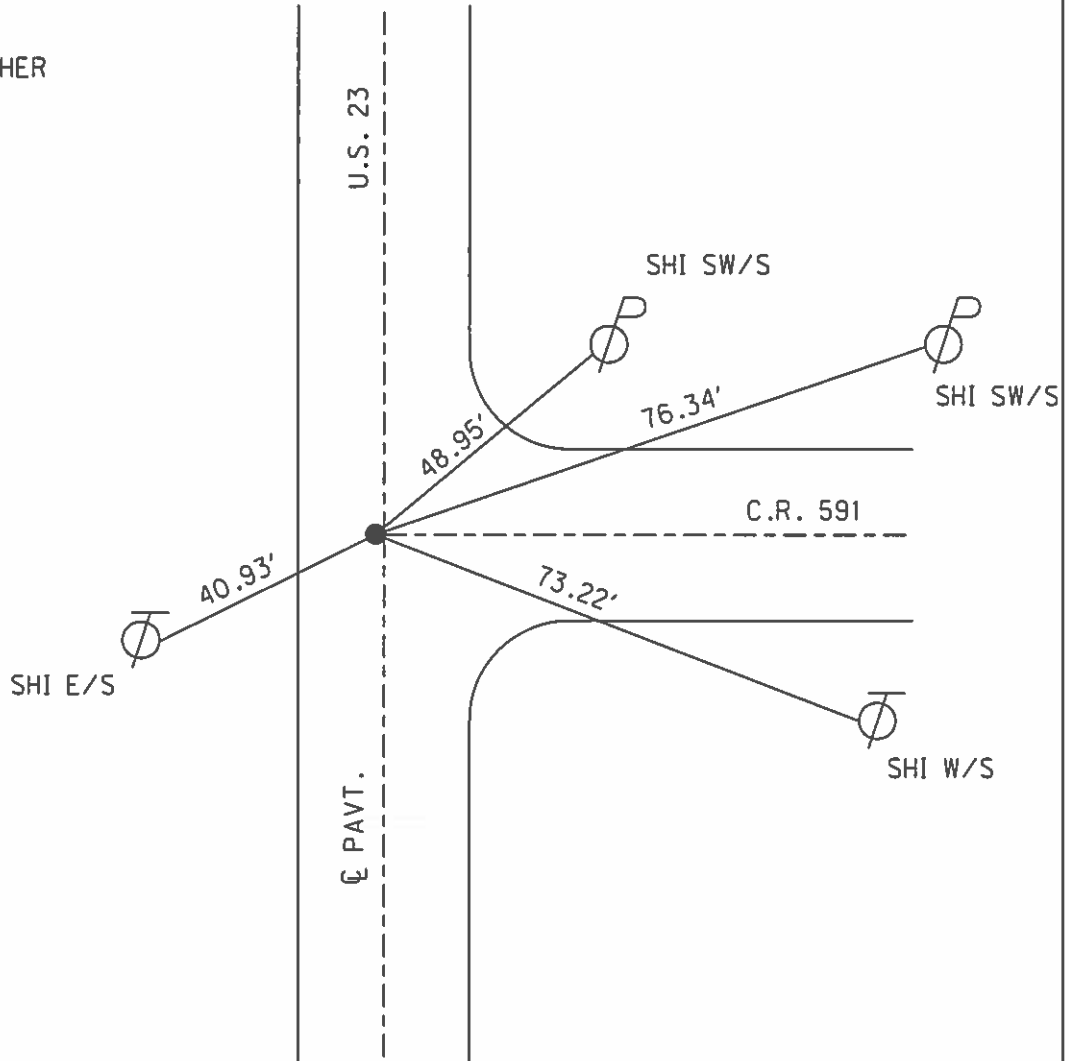

# O.D.O.T. DISTRICT 2 SURVEY OFFICE

PERSONNEL \_\_\_\_\_

REFERENCE NO. 7-A

SHEET \_\_\_\_\_ OF \_\_\_\_\_

NOTES LOEHRKE

H.C. Hoffman

DATE 7-19-89

ROUTE U.S. 23

R.C. BARNHISEL

WEATHER CLOUDY

COUNTY SENECA

TEMP. +75

TOWNSHIP BIG SPRING

SECTION 29

T \_\_\_\_\_ R \_\_\_\_\_

TYPE MONUMENT Sm R.R. Spike



Set P.K./WASHER  
10-31-89 SWH

ON SURFACE - BELOW Yes

LEFT - & PAV'T. - RIGHT 0.5 Lt

11.1 TO Lt EDGE PAVEMENT

S.L.M. 83 463

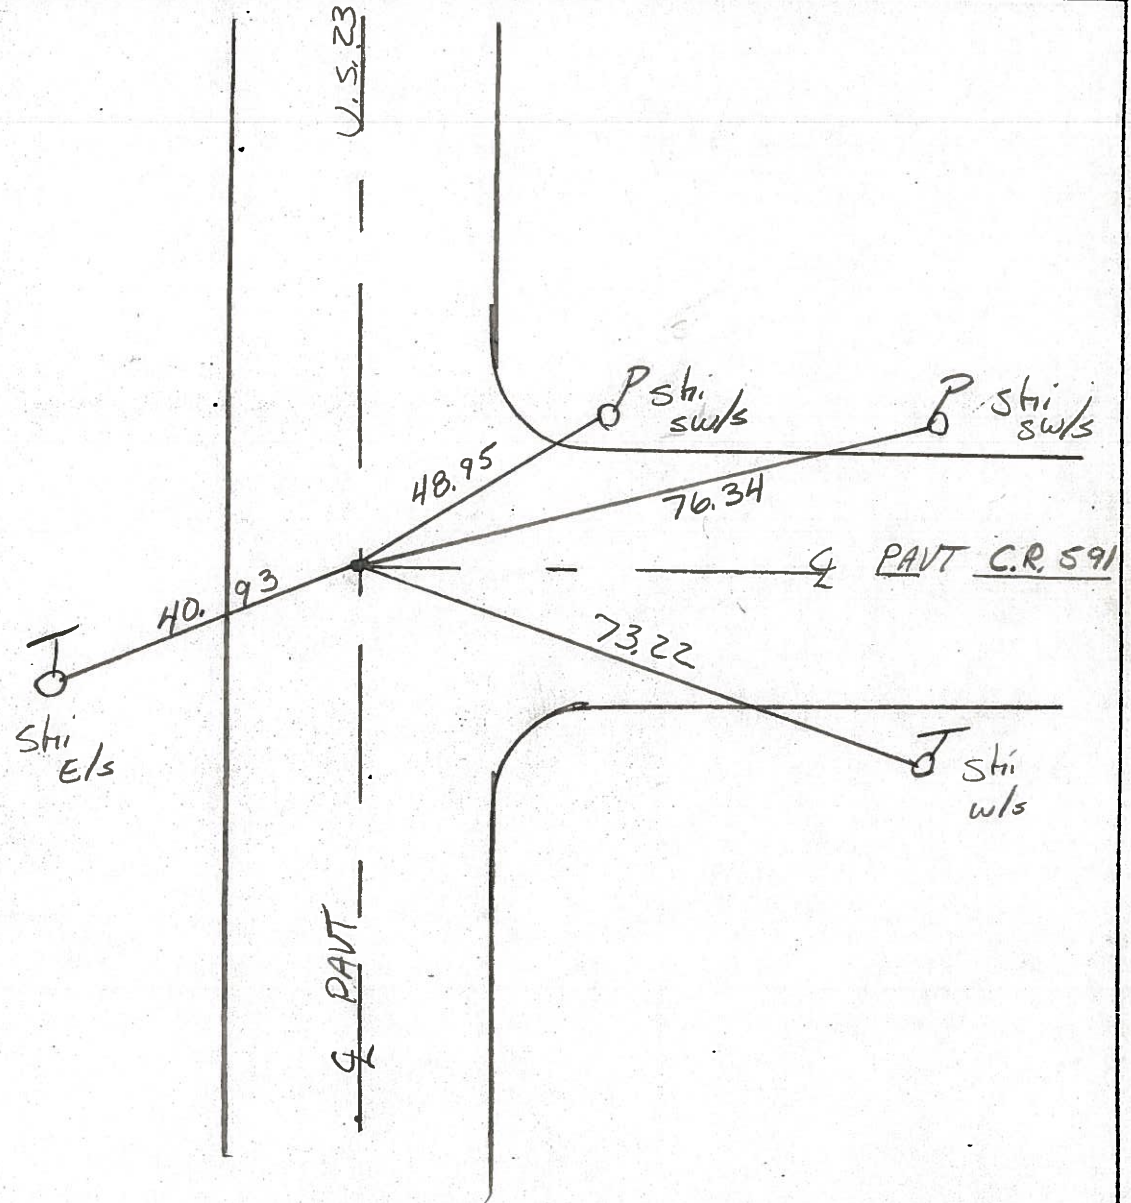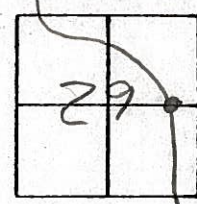

O.D.O.T. DISTRICT 2 SURVEY OFFICE

SHEET

OF

County Saxeca S.R. 4.5.23

Township Big Spring

Section 29

T N, R E


Personnel Hoffman  
Householder

Date 6-22-81

Weather Cloudy

Temp. +70°

#1A

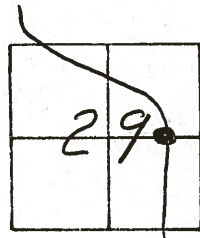

Fd. R.R. SPK. @ surface  
14.5' to. w. Edge paved berm

PROJECT STA. ± 83+72

SET SMALL R.R. SPK.  
9-30-81 SWH

