

O.D.O.T. DISTRICT 2 SURVEY OFFICE (USE ONLY)

PERSONNEL

REFERENCE NO. 8

SHEET 9 OF 22

NOTES SCHNEIDER

DATE 8/25/69

ROUTE US 23

H.C. MOSSER

WEATHER HOT

COUNTY SENECA

R.C. BARBOUR

TEMP. 90°

TOWNSHIP BIG SPRING

POTTS

SECTION 29

DWG BY NASON PID 85264

T 1 N R 13 E

TYPE MONUMENT P.K.NAIL

ON SURFACE - BELOW ON

OFFSET ϕ PAVEMENT LT : RT

TO EDGE PAVEMENT



STATION: 95+46.81

HORZ.DATUM:

GEOID:

GRID: NORTHING:

EASTING:

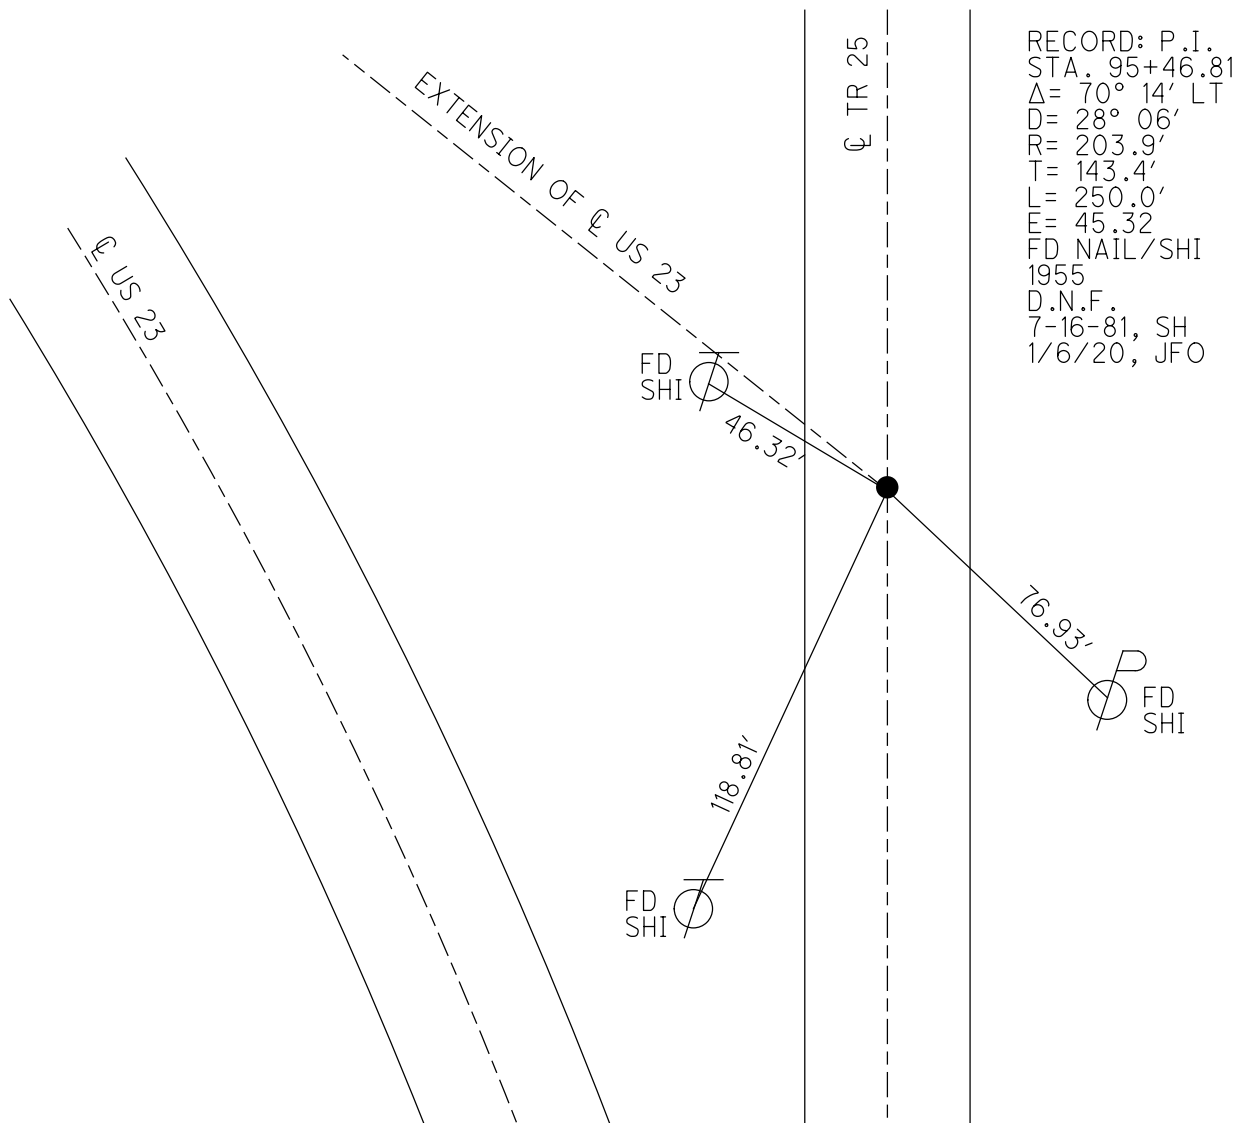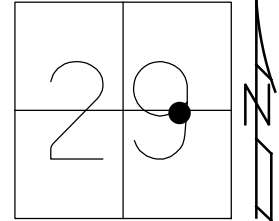

RECORD: P.I.
 STA. 95+46.81
 $\Delta = 70^\circ 14' \text{ LT}$
 $D = 28^\circ 06'$
 $R = 203.9'$
 $T = 143.4'$
 $L = 250.0'$
 $E = 45.32$
 FD NAIL/SHI
 1955
 D.N.F.
 7-16-81, SH
 1/6/20, JFO

O.D.O.T. DISTRICT 2 SURVEY OFFICE (USE ONLY)

PERSONNEL

REFERENCE NO. 8

SHEET 9 OF 22

NOTES SCHNEIDER

DATE 8/25/69

ROUTE US 23

H.C. MOSSER

WEATHER HOT

COUNTY SENECA

R.C. BARBOUR

TEMP. 90°

TOWNSHIP BIG SPRING

POTTS

DWG BY NASON

PID PT-SEN19

SECTION 29

T 1 N R 13 E

TYPE MONUMENT P.K.NAIL

ON SURFACE - BELOW ON

OFFSET ϕ PAVEMENT _____ LT : RT

_____ TO _____ EDGE PAVEMENT



STATION: 95+46.81

HORZ.DATUM: _____

GEOID: _____

GRID: NORTHING: _____


EASTING: _____

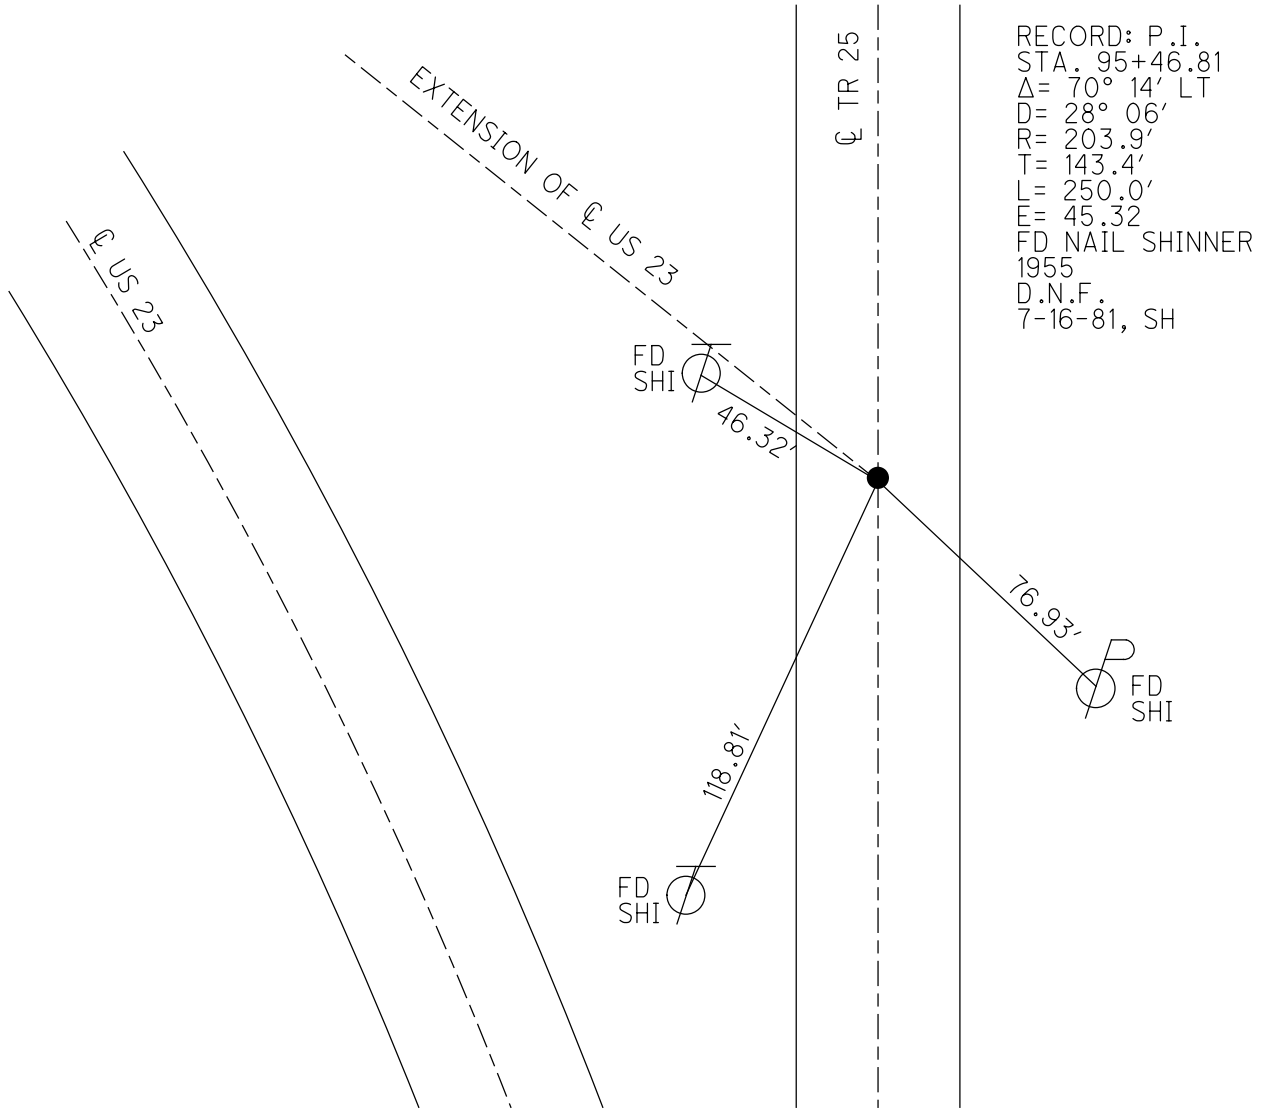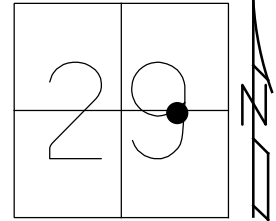

O.D.O.T. DISTRICT 2 SURVEY OFFICE (USE ONLY)

PERSONNEL _____ REFERENCE NO. 8 SHEET 9 OF 22
 NOTES SCHNEIDER DATE 08-25-69 ROUTE US 23
 H.C. MOSSER WEATHER HOT COUNTY SENECA
 R.C. BARBOUR TEMP. 90° F TOWNSHIP BIG SPRING
POTTS SECTION _____
 T 1 N R 13 E


TYPE MONUMENT FD. P.K. NAIL
 ON SURFACE - BELOW _____
 LEFT - \odot PAV'T - RIGHT _____
 _____ TO _____ EDGE PAVEMENT
 S.L.M. _____

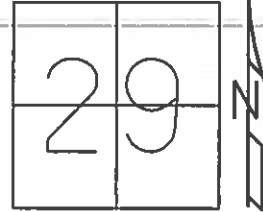

GRID: NORTHING: _____ EASTING: _____

REC. P.I. STA. 93+90.55
 $\Delta = 59' 30''$ LT.

RECORD
 07-16-81 S.H.
 COULD NOT FIND

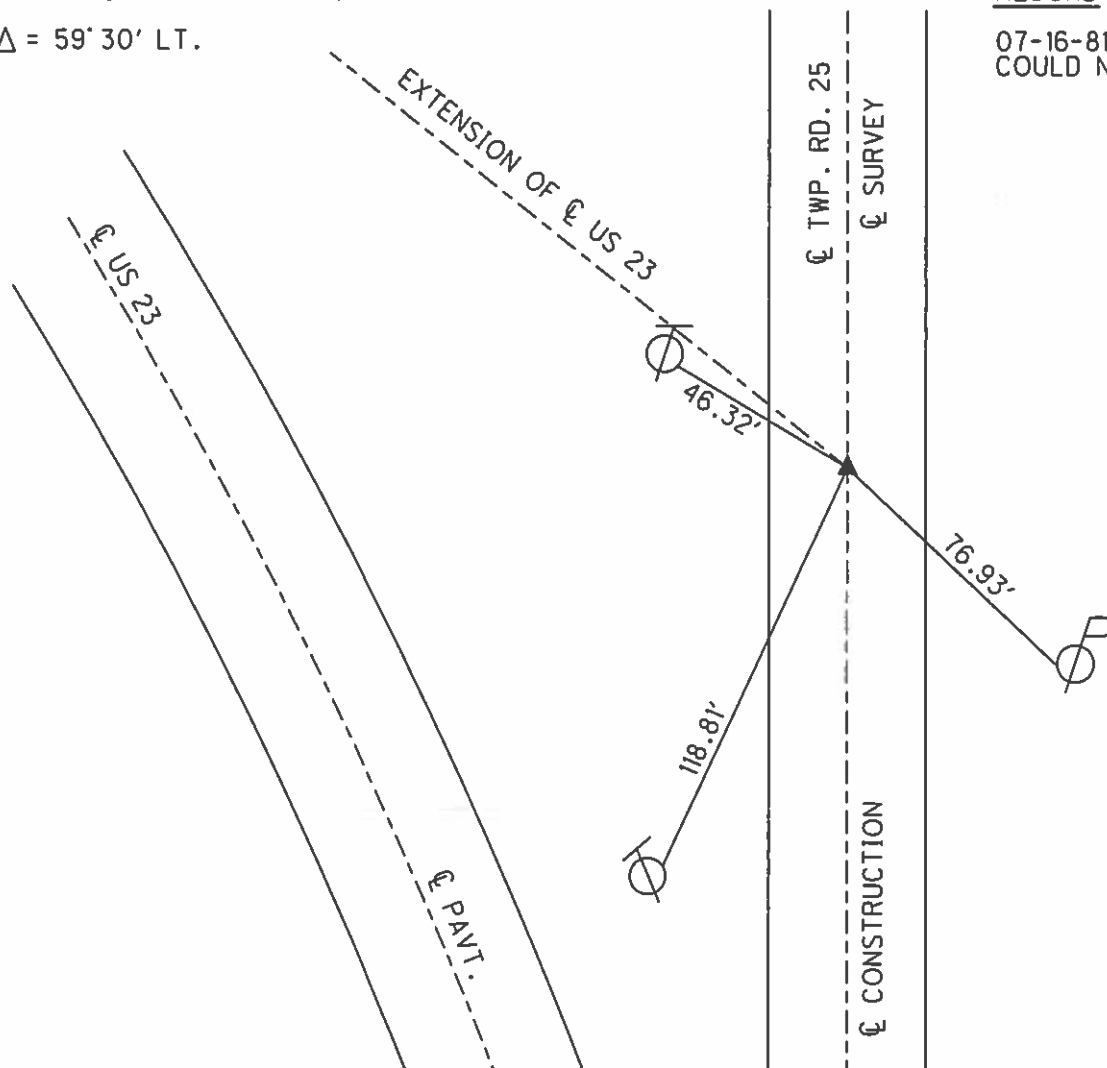

O.D.O.T. DISTRICT 2 SURVEY OFFICE

SHEET _____ OF _____

County S.P. U.S. 23

Date 8-25-69

Township _____


Weather HOT

Section _____

Temp. 90°

T N, R E

Personnel SCHNEIDER

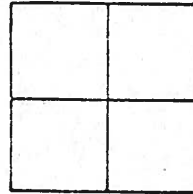

MOSSER

B. BROWN


OTT

8

P.I. 93+90.55

ED. P.K. 141

$\Delta = 59^{\circ} 30' \text{ LT.}$

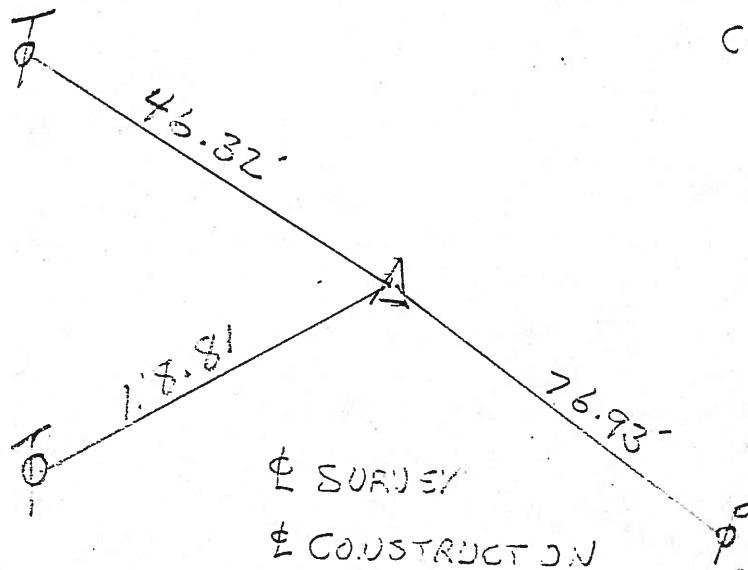

7-16-81
COULD NOT FIND

S.H.
DID NOT FIND

7-17-89
C.A.L.

⊕ SURVEY
⊕ CONSTRUCTION

OD.O.T. DISTRICT 2 SURVEY OFFICE

SHEET _____ OF _____

County _____ ~~S.P.~~ U.S. 23

Date _____ 8-25-69

Township _____

Weather _____ HOT

Section _____

Temp. _____ 90°

T_N, R_E


Personnel _____ SCHNEIDER

_____ MOSSER

_____ BARBOUR

_____ POTTS

8

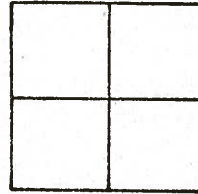


P.I 93+90.55

FD. P.K. NAIL

$\Delta = 59^{\circ} 30' \text{ LT.}$


7-16-81
COULD NOT FIND
S.H.

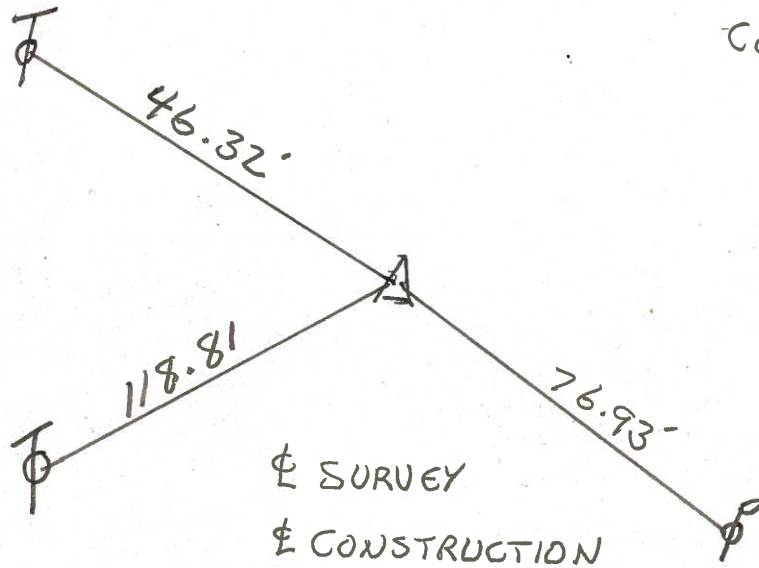

PERSONNEL	TITLE	PERSONNEL	TITLE	COUNTY	DATE
Schneider				Seneca	8-25-69
Mosser				S. R. U.S. 23	WEATHER Hot
Barbour				SEC Wyandot Co. Line N.	TEMP. 90°
Potts					


DESCRIPTION Ties for Control Points JOB NO. _____

P.I. (9) X
 95+46.81
 $\Delta = 70^{\circ} 14' Lt.$
 Fd. N. & S. 3" down

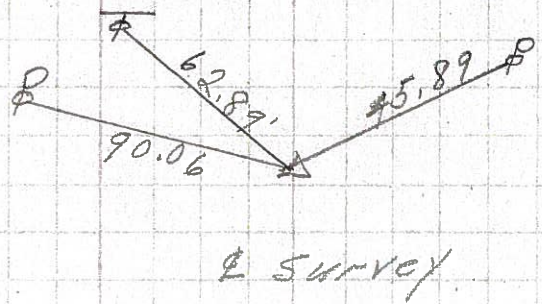


COULD NOT FIND S.H. 6-22-81

P.I. (8) X
 93+90.53
 Fd. P.K. Nail
 $\Delta = 59^{\circ} 30' Lt.$

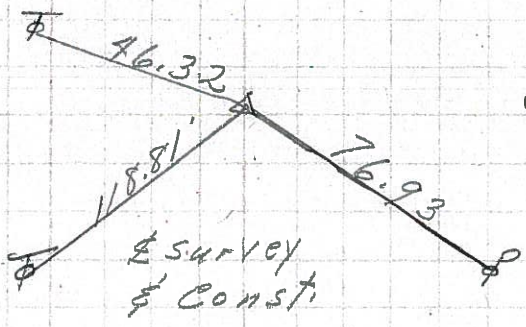


COULD NOT FIND S.H. 6-22-81

P.I. (7) X
 67+42.27
 P.K. Nail
 Co. Rd. # 59

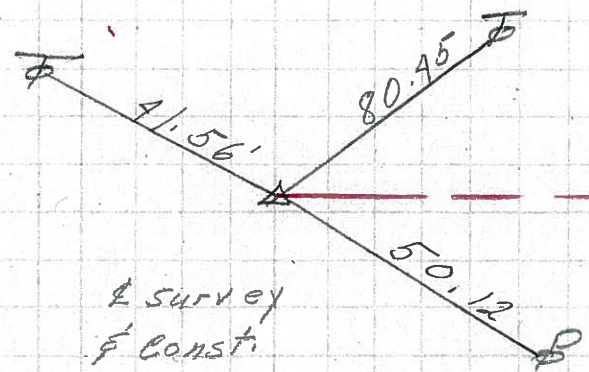

P.I. (6) X
 56+58.97
 P.K. Nail

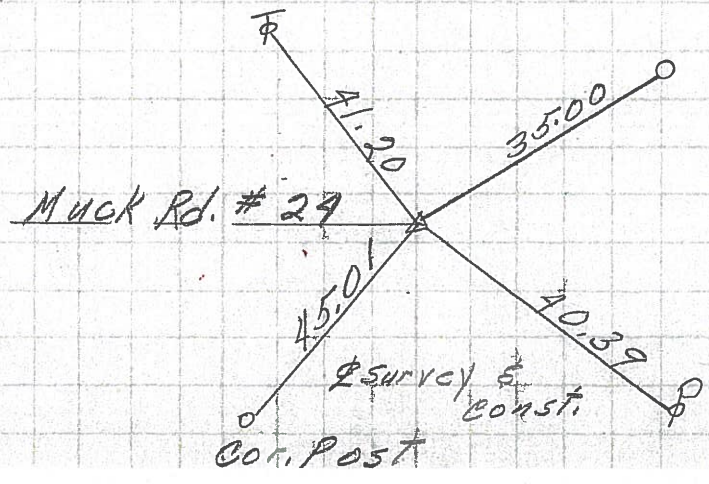

Cor. post