



O.D.O.T. DISTRICT 2 SURVEY OFFICE (USE ONLY)

PERSONNEL _____ REFERENCE NO. 9 SHEET 10 OF 22
 NOTES RHOADES DATE 1/6/20 ROUTE US 23
 H.C. O'DONNELL WEATHER WINDY COUNTY SENECA
 R.C. _____ TEMP. 38° TOWNSHIP BIG SPRING
 DWG BY RHOADES PID 85264 SECTION 19
 T 1 N R 13 E

TYPE MONUMENT 1 1/2" IPIPE
 ON ~~SURFACE~~ - BELOW 4"
 OFFSET \varnothing PAVEMENT _____ LT : RT
 _____ TO _____ EDGE PAVEMENT
 STATION: 142+04.54

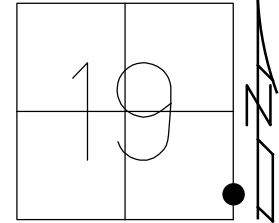

HORIZ.DATUM: NAD83 2011 GEOID: NAVD88 2012A
 GRID: NORTHING: 495614.791 EASTING: 1719769.268

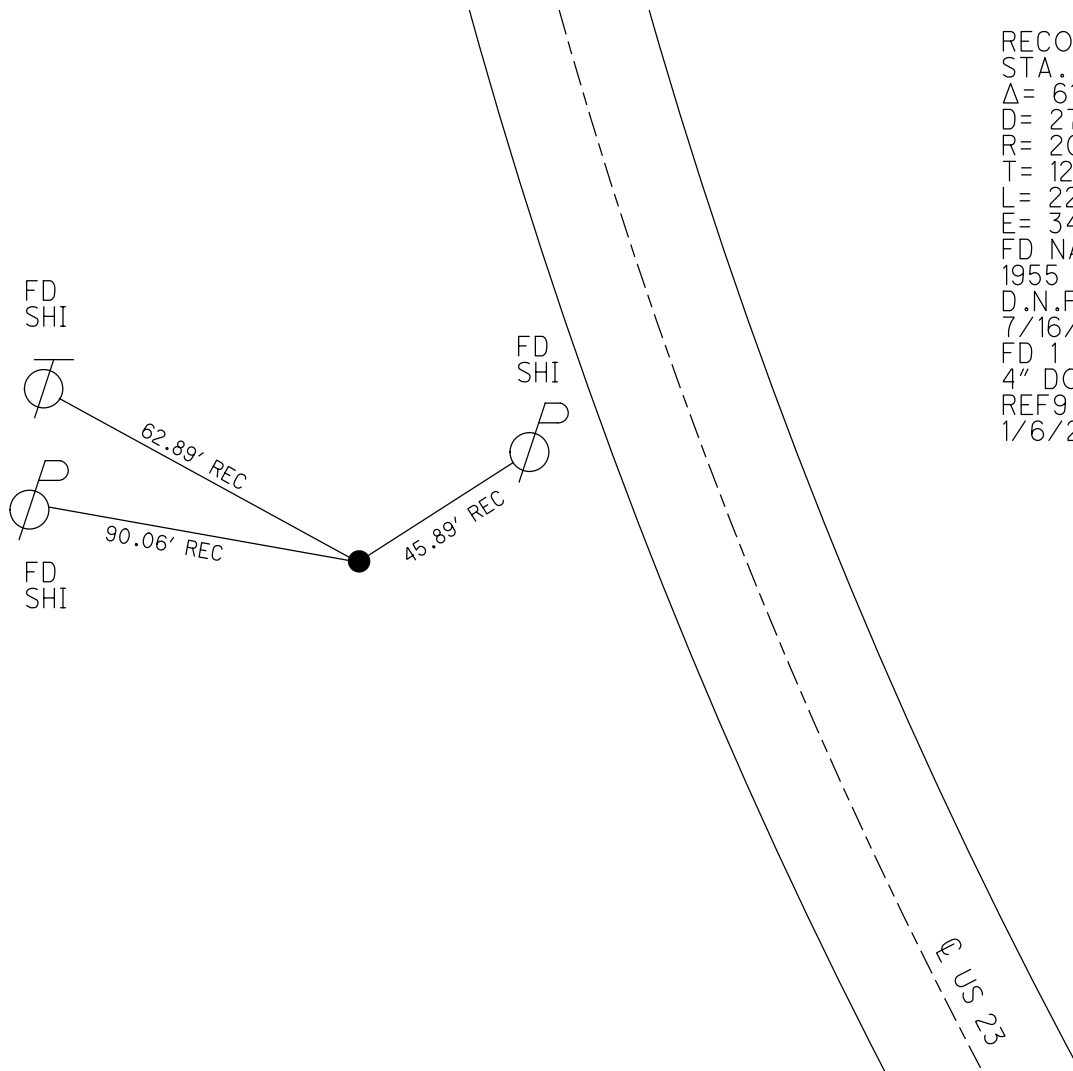

RECORD: P.I.
 STA. 142+04.54
 $\Delta = 61^\circ 44' RT$
 $D = 27^\circ 26'$
 $R = 208.82'$
 $T = 124.8'$
 $L = 225.0'$
 $E = 34.42'$
 FD NAIL/SHI
 1955
 D.N.F.
 7/16/81, SH
 FD 1 1/2" IPIPE
 4" DOWN
 REF9
 1/6/20, JFO

O.D.O.T. DISTRICT 2 SURVEY OFFICE (USE ONLY)

PERSONNEL

REFERENCE NO. 9

SHEET 10 OF 22

NOTES SCHNEIDER

DATE 8/25/69

ROUTE US 23

H.C. MOSSER

WEATHER HOT

COUNTY SENECA

R.C. BARBOUR
POTTS

TEMP. 90°

TOWNSHIP BIG SPRING

DWG BY NASON

PID PT-SEN19

SECTION 19

T 1 N R 13 E

TYPE MONUMENT NAIL/SHI

ON ~~SURFACE~~ - BELOW 3"

OFFSET \varnothing PAVEMENT _____ LT : RT

_____ TO _____ EDGE PAVEMENT



STATION: 142+04.54

HORZ. DATUM: _____

GEOID: _____

GRID: NORTHING: _____

EASTING: _____

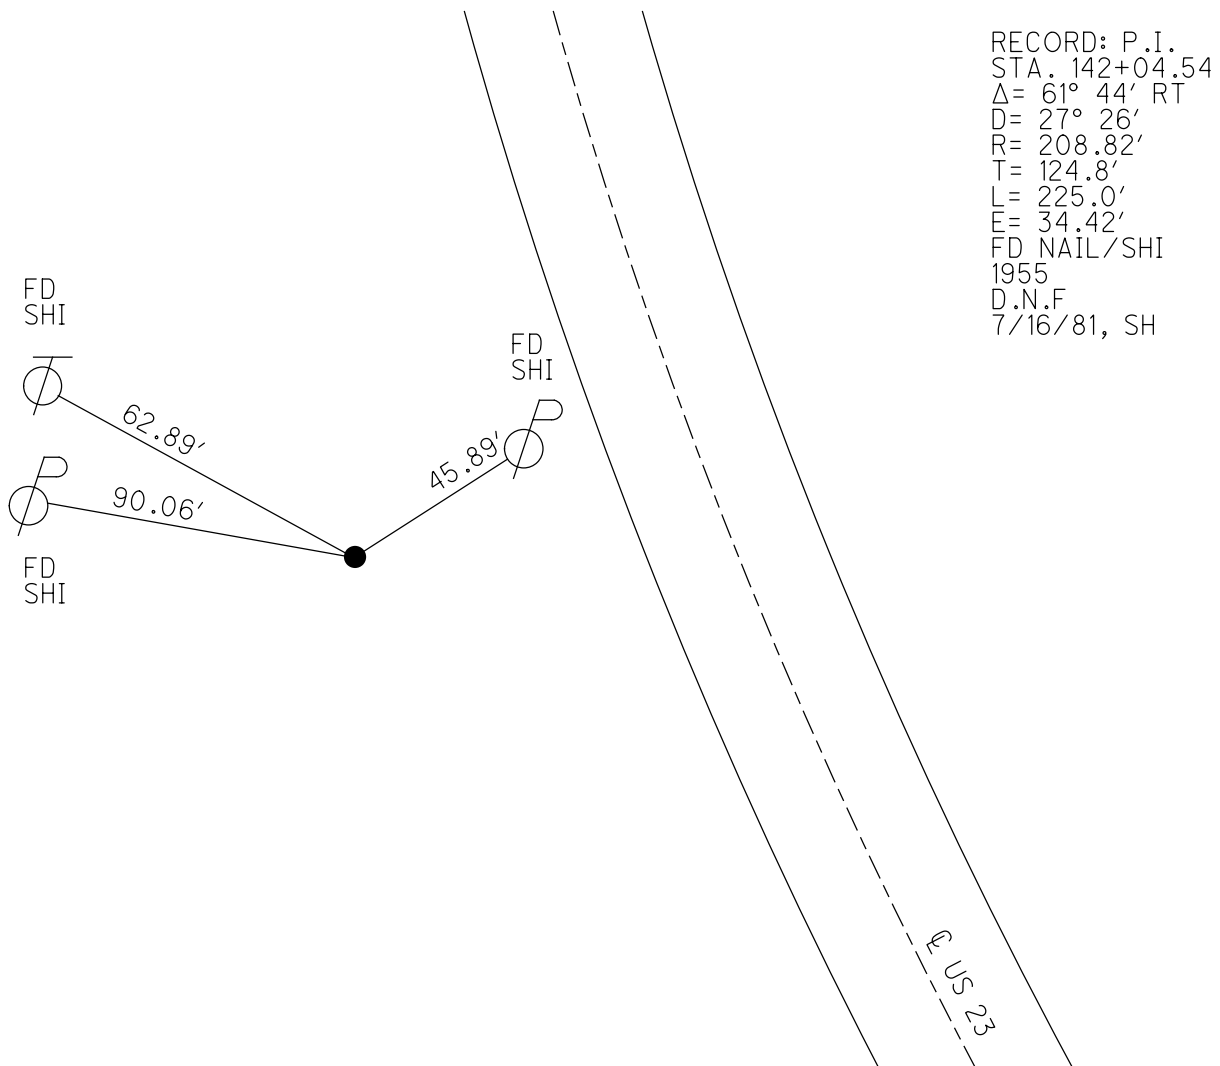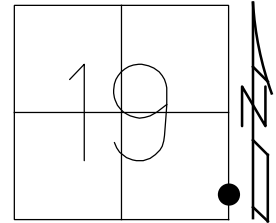

O.D.O.T. DISTRICT 2 SURVEY OFFICE (USE ONLY)

PERSONNEL _____ REFERENCE NO. 9 SHEET 10 OF 22
 NOTES SCHNEIDER DATE 08-25-69 ROUTE US 23
 H.C. MOSSER WEATHER HOT COUNTY SENECA
 R.C. BARBOUR TEMP. 90° F TOWNSHIP BIG SPRING
 _____ POTS _____ SECTION _____
 _____ T 1 N R 13 E

TYPE MONUMENT FD. NAIL & SHINER


~~ON SURFACE~~ - BELOW 3" BELOW

LEFT - ☉ PAV'T - RIGHT _____

_____ TO _____ EDGE PAVEMENT

S.L.M. _____

GRID: NORTHING: _____ EASTING: _____

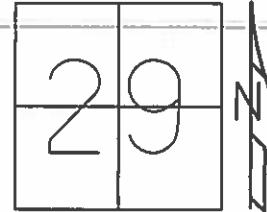


REC. P.I. STA. 95+46.81

$\Delta = 70' 14'$ LT.

RECORD

07-16-81 S.H.
 COULD NOT FIND

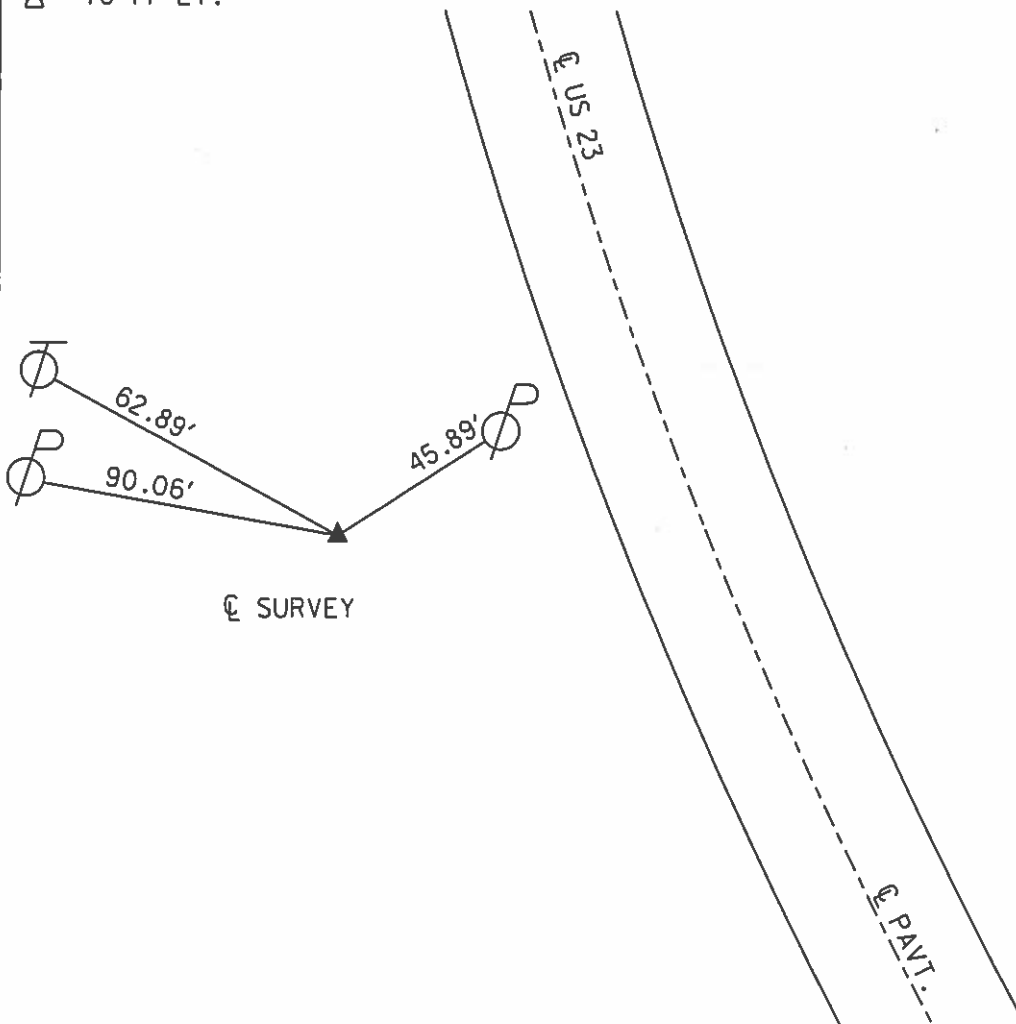

ODOT DISTRICT 2 SURVEY OFFICE

SHEET _____ OF _____

County SENECA S.R. 11.5.33

Date 7-25-87

Township _____


Weather 40.5

Section _____

Temp. 72°

T N, R E

Personnel SCHWEITZER

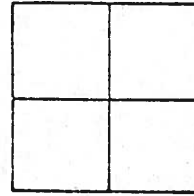

#9

P.I. 95 ± 46.81

$\Delta = 70^\circ - 14' LT.$

FD. N.E.S. 3" DOWN
VALE - SHINER


7-16-87
COULD NOT FIND

S. 4.

DO NOT FIND

7-17-89

C.A.L.

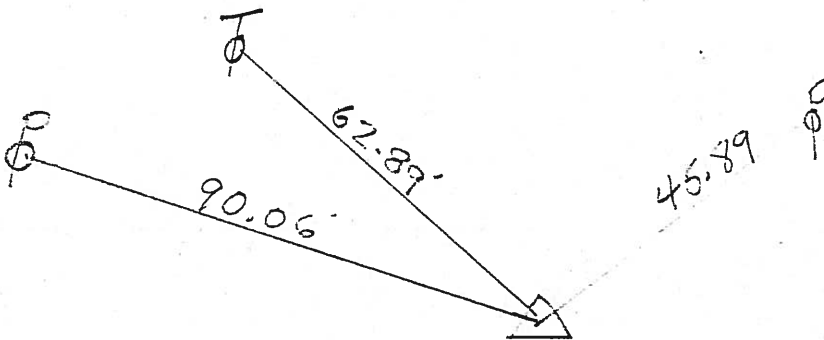

© SURVEY

ODOT. DISTRICT 2 SURVEY OFFICE

SHEET _____ OF _____

County SENECA - S.R. 11.5.23

Date 8-25-69

Township _____


Weather 1405

Section _____

Temp. 90°

T N, R E

Personnel SCHNEIDER

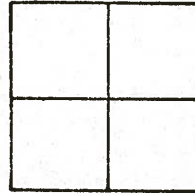

MOSSER

BARBOUR

POTTS

#9

P.I. 95+46.81

$\Delta = 70^{\circ} - 14' \text{ LT.}$


FD. N. & S. 3" DOWN

NAIL - SHINER

7-16-81

COULD NOT FIND

S.H.

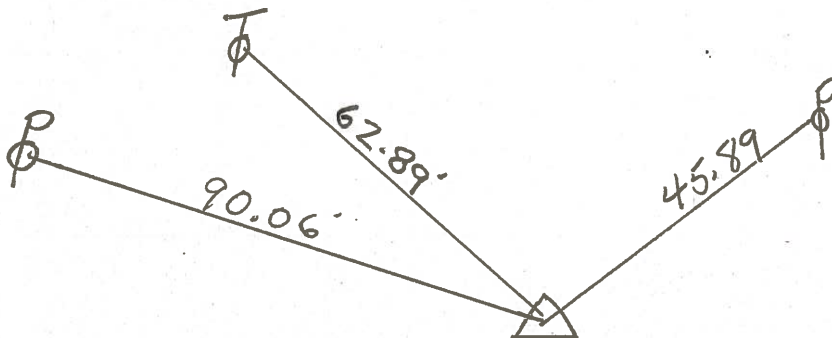

☉ SURVEY

PERSONNEL	TITLE	PERSONNEL	TITLE	COUNTY	<u>Seneca</u>	DATE	<u>8-25-69</u>
<u>Schneider</u>				S. R.	<u>U.S. 23</u>	WEATHER	<u>Hot</u>
<u>Masser</u>				SEC.	<u>Wyandot Co. Line N.</u>	TEMP.	<u>90°</u>
<u>Barbour</u>							
<u>Potts</u>							

DESCRIPTION Ties for Control Points JOB NO.

