

O.D.O.T. DISTRICT 2 SURVEY OFFICE (USE ONLY)

PERSONNEL

REFERENCE NO. 10

SHEET 11 OF 22

NOTES O'DONNELL

DATE 5/11/21

ROUTE US 23

H.C. AUBLE

WEATHER SUNNY

COUNTY SENECA

R.C. NIESE

TEMP. 45°

TOWNSHIP BIG SPRING

DWG BY RHOADES

PID 85264

SECTION 19

T 1 N R 13 E

TYPE MONUMENT MAG NAIL

ON SURFACE - ~~BELOW~~ ON

OFFSET 0.9' LT : RT

- TO - EDGE PAVEMENT 3.1' N. OF CR 6



STATION: 158+75.34

HORZ.DATUM: NAD83 2011

GEOID: NAVD88 2012A

GRID: NORTHING: 497514.536

EASTING: 1719754.865

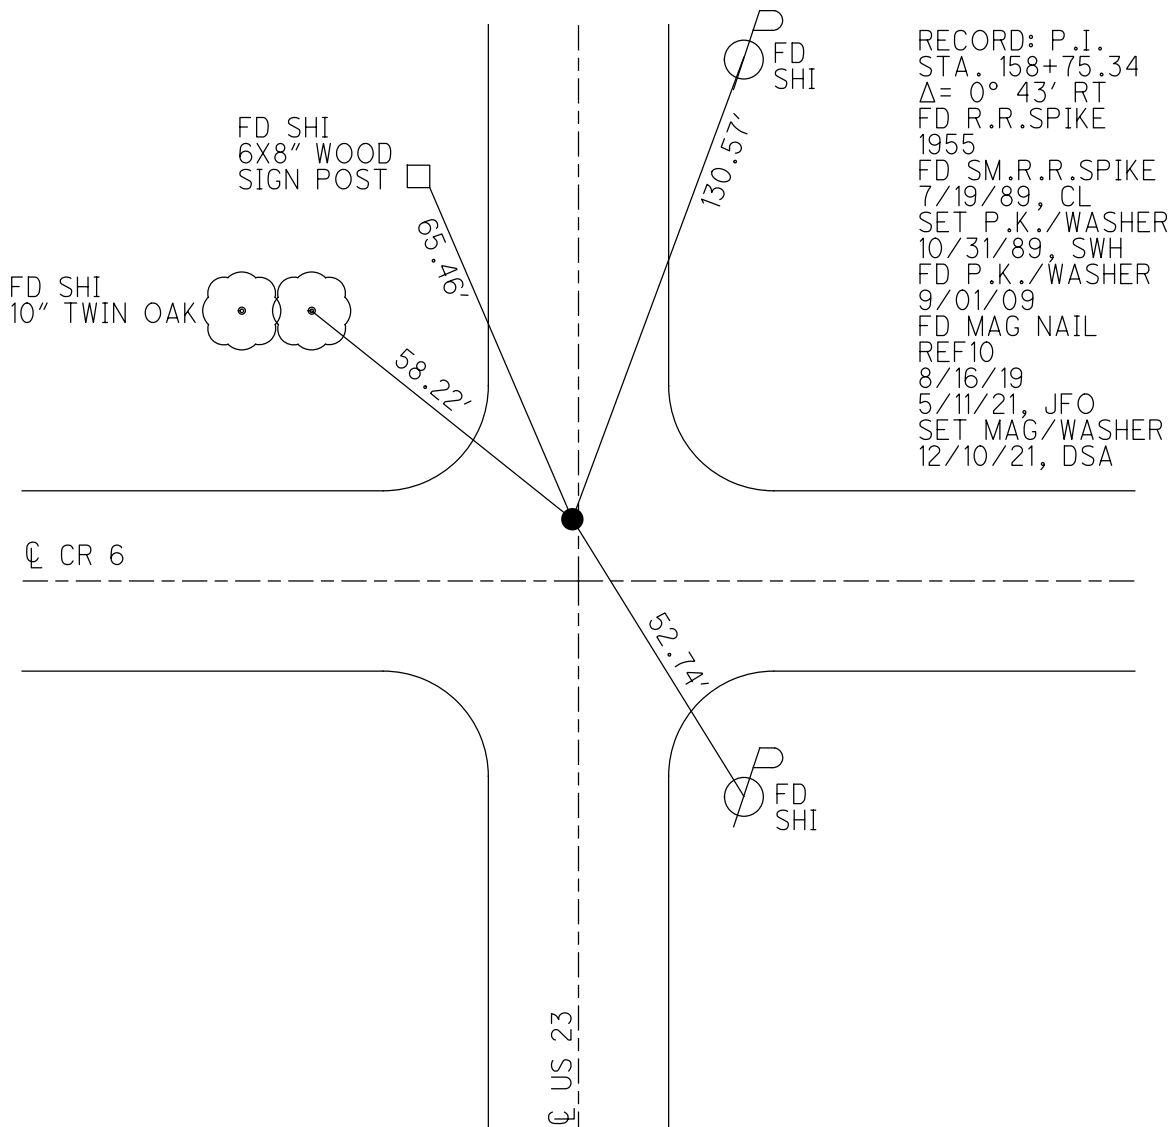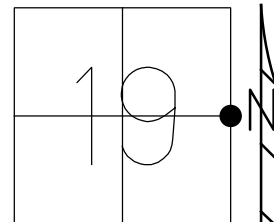

O.D.O.T. DISTRICT 2 SURVEY OFFICE (USE ONLY)

PERSONNEL

REFERENCE NO. 10

SHEET 11 OF 22

NOTES ELKHECHEN

DATE 10/29/18

ROUTE US 23

H.C. LEU

WEATHER CLOUDY

COUNTY SENECA

R.C. MILLER

TEMP. 43°

TOWNSHIP BIG SPRING

SECTION 19

DWG BY NASON

PID PT-SEN19

T 1 N R 13 E

TYPE MONUMENT MAG NAIL

ON SURFACE - ~~BELOW~~ ON _____

OFFSET C PAVEMENT 0.9' LT : ~~RT~~

- TO - EDGE PAVEMENT 3.1' N. OF C CR 6



STATION: 158+75.34

HORZ.DATUM: NAD83 (2011)

GEOID: 2012A

GRID: NORTHING: 497514.536

EASTING: 1719754.865

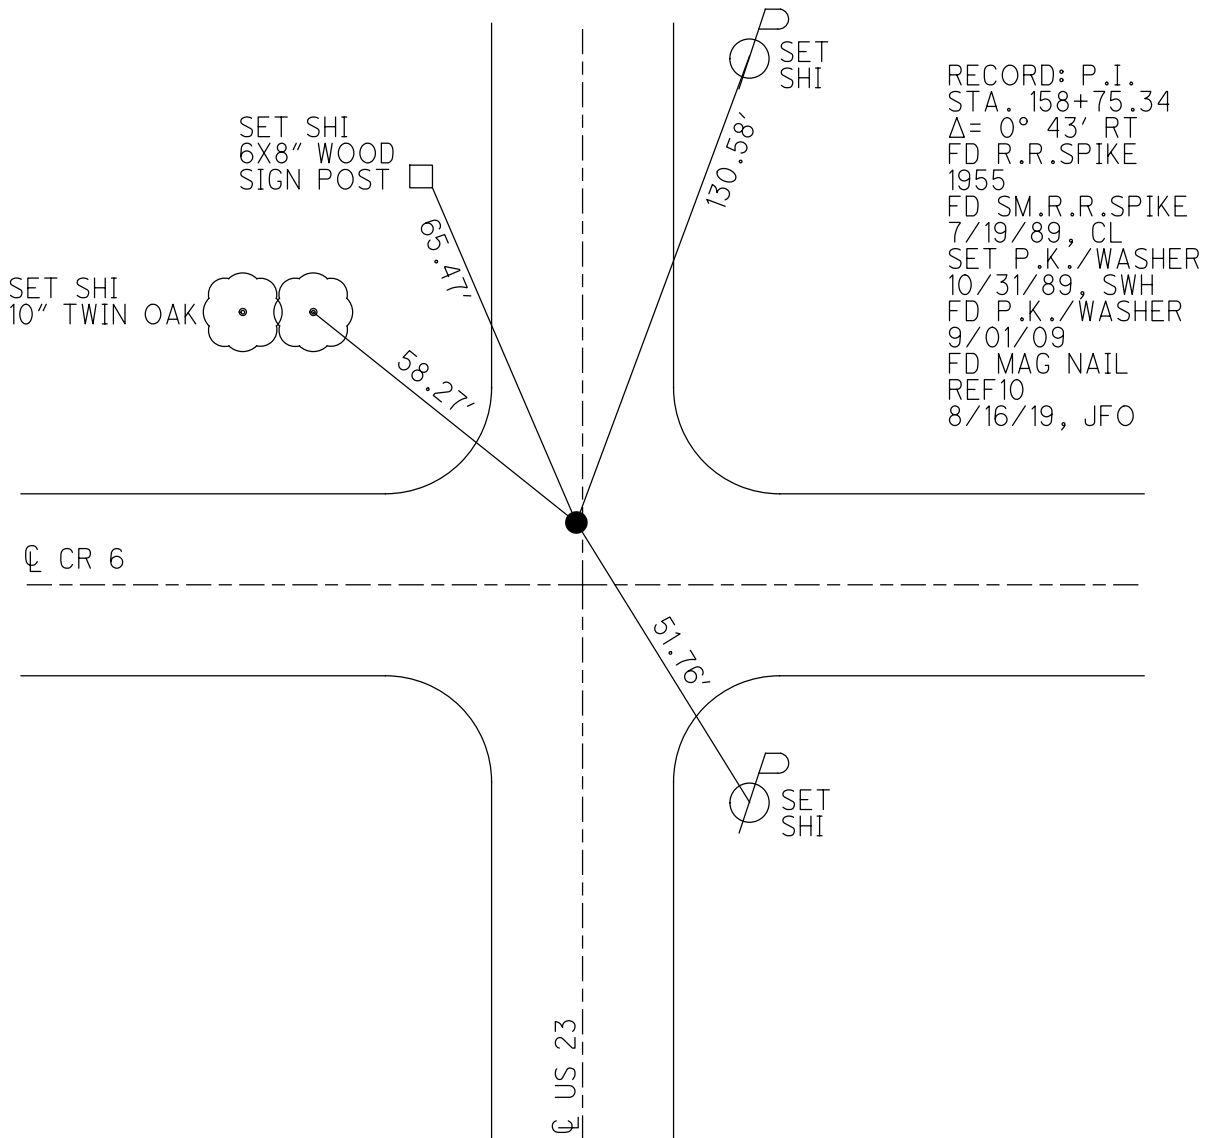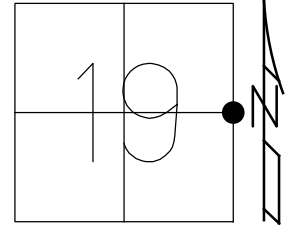


RECORD: P.I.
 STA. 158+75.34
 $\Delta = 0^\circ 43' RT$
 FD R.R.SPIKE
 1955
 FD SM.R.R.SPIKE
 7/19/89, CL
 SET P.K./WASHER
 10/31/89, SWH
 FD P.K./WASHER
 9/01/09
 FD MAG NAIL
 REF10
 8/16/19, JFO

O.D.O.T. DISTRICT 2 SURVEY OFFICE (USE ONLY)

PERSONNEL _____ REFERENCE NO. 10 SHEET 11 OF 22
 NOTES LOEHRKE DATE 07-19-89 ROUTE US 23
 H.C. HOFFMAN WEATHER CLOUDY COUNTY SENECA
 R.C. BARNHISEL TEMP. +75 TOWNSHIP BIG SPRING
 _____ SECTION 19
 _____ T 1 N R 13 E

TYPE MONUMENT SM. R.R. SPIKE
 ON SURFACE - ~~BELOW~~ ON SURFACE
 LEFT - ☉ PAV'T - ~~RIGHT~~ 0.6', 3.1' N. OF ☉ C.R. 6
 _____ TO _____ EDGE PAVEMENT
 S.L.M. _____ 156+70

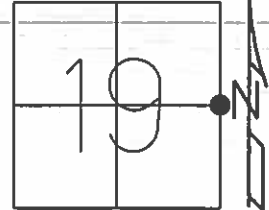


GRID: NORTHING: _____ EASTING: _____

REC. P.I. STA. 158+75.34

RECORD

10-31-89 SWH
 SET P.K./WASHER
 09-01-09
 FD.

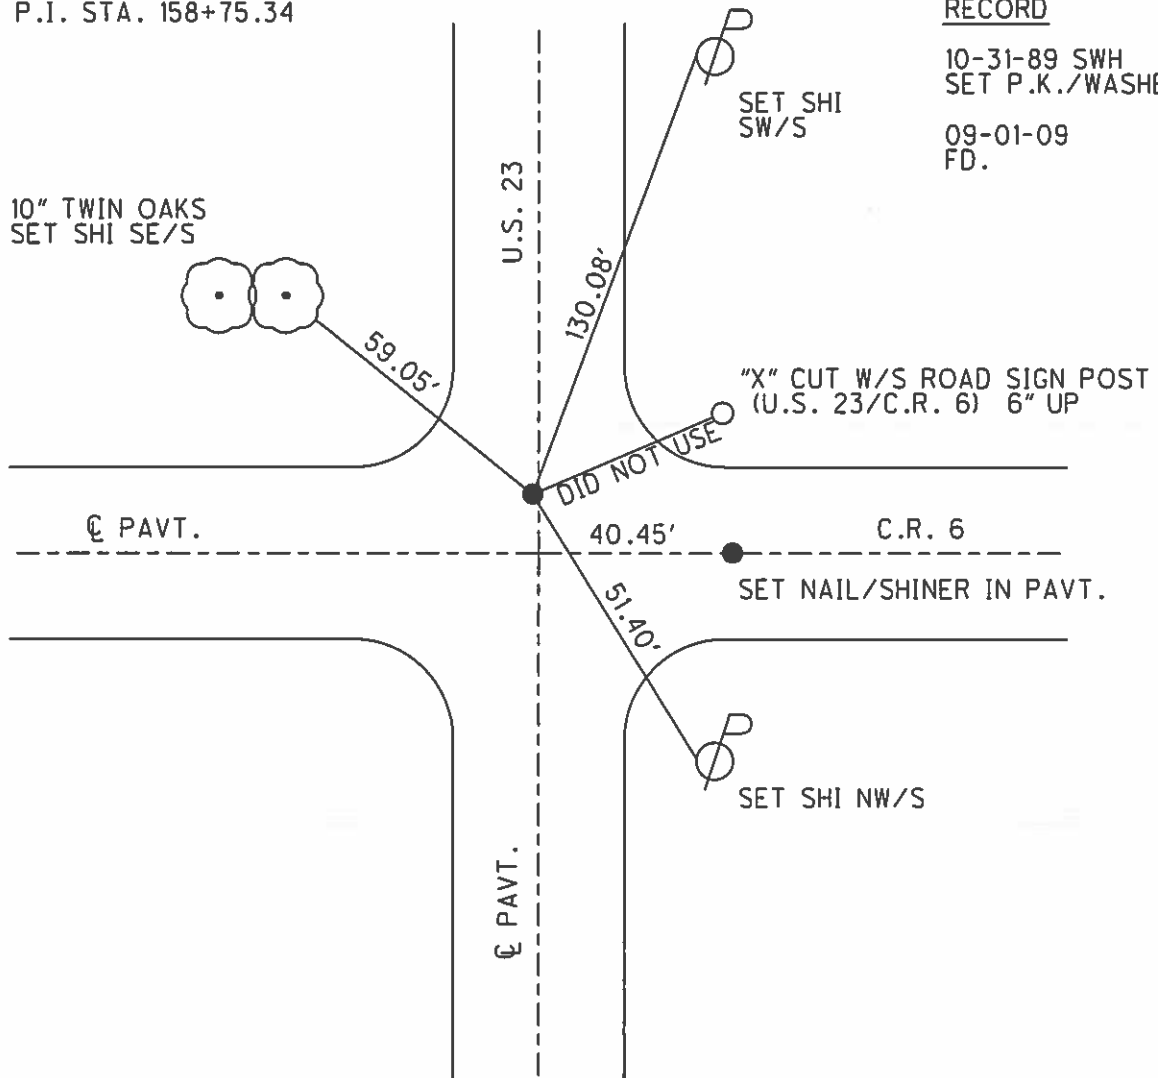

O.D.O.T. DISTRICT 2 SURVEY OFFICE

PERSONNEL

REFERENCE NO. 10

SHEET OF

NOTES LOEHARKE

H.C. Hoffman

R.C. BARNHSEL

DATE 7-19-89

WEATHER Cloudy

TEMP. +75

ROUTE U.S. 23

COUNTY SENECA

TOWNSHIP Big Spring

SECTION 19

T R

TYPE MONUMENT Sm. R.R. SPIKE

ON SURFACE - BELOW yes



LEFT- PAV'T. - RIGHT 0.6'

 TO EDGE PAVEMENT


S.L.M. 156 +70

Set P.R./washer
10-31-89 SWK

3.1 N. of
Rd EAST

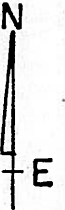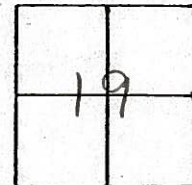

Rec. P.I. sta. 158+75.34

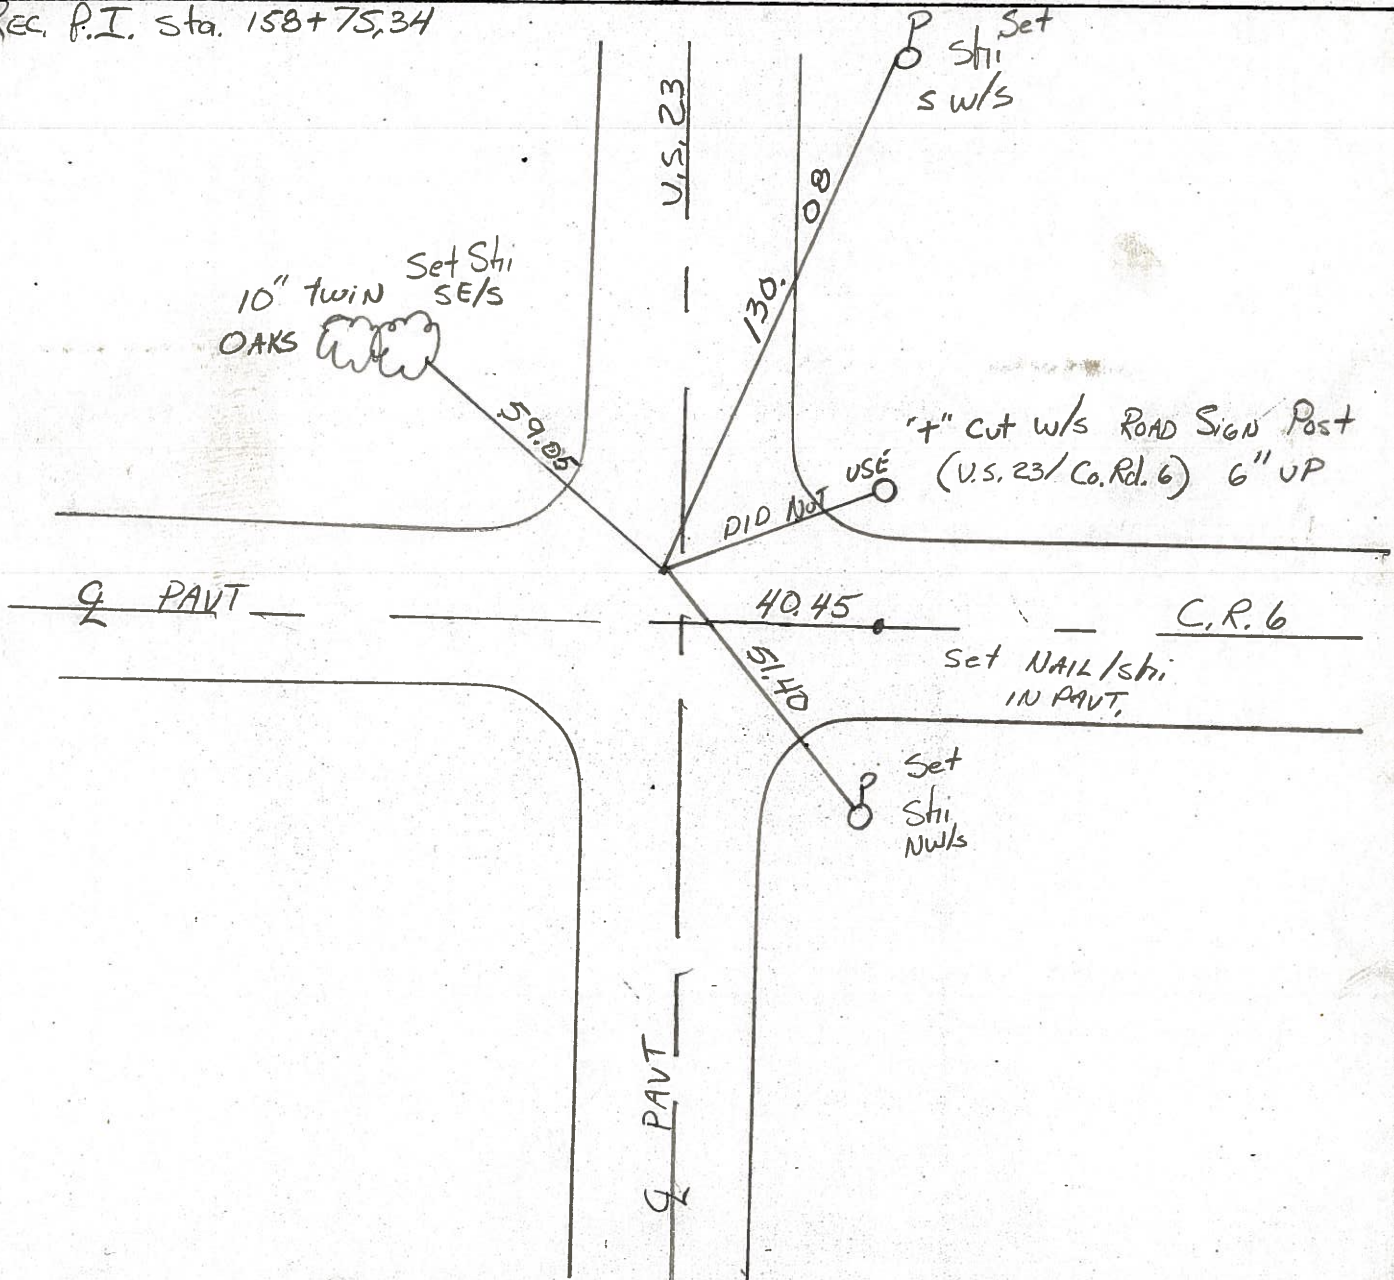

O.D.O.T. DISTRICT 2 SURVEY OFFICE

SHEET

OF

County Seneca S.R. -U.S. 23

Township Big Spring

Section 19

T N, R E


Personnel H.F.F. mad
Householder

#10

Date 6-22-81

Weather partly cloudy


Temp. +75°

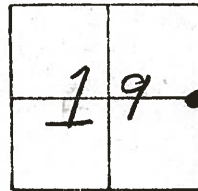

Fd. P.K. Nail @ surface
1' W. of & part of U.S. 23
± 8' N. of & part of Co. Rd. 6

Project STA ± 156+77

SET SMALL R.R. SPK.
10-29-81 SWH

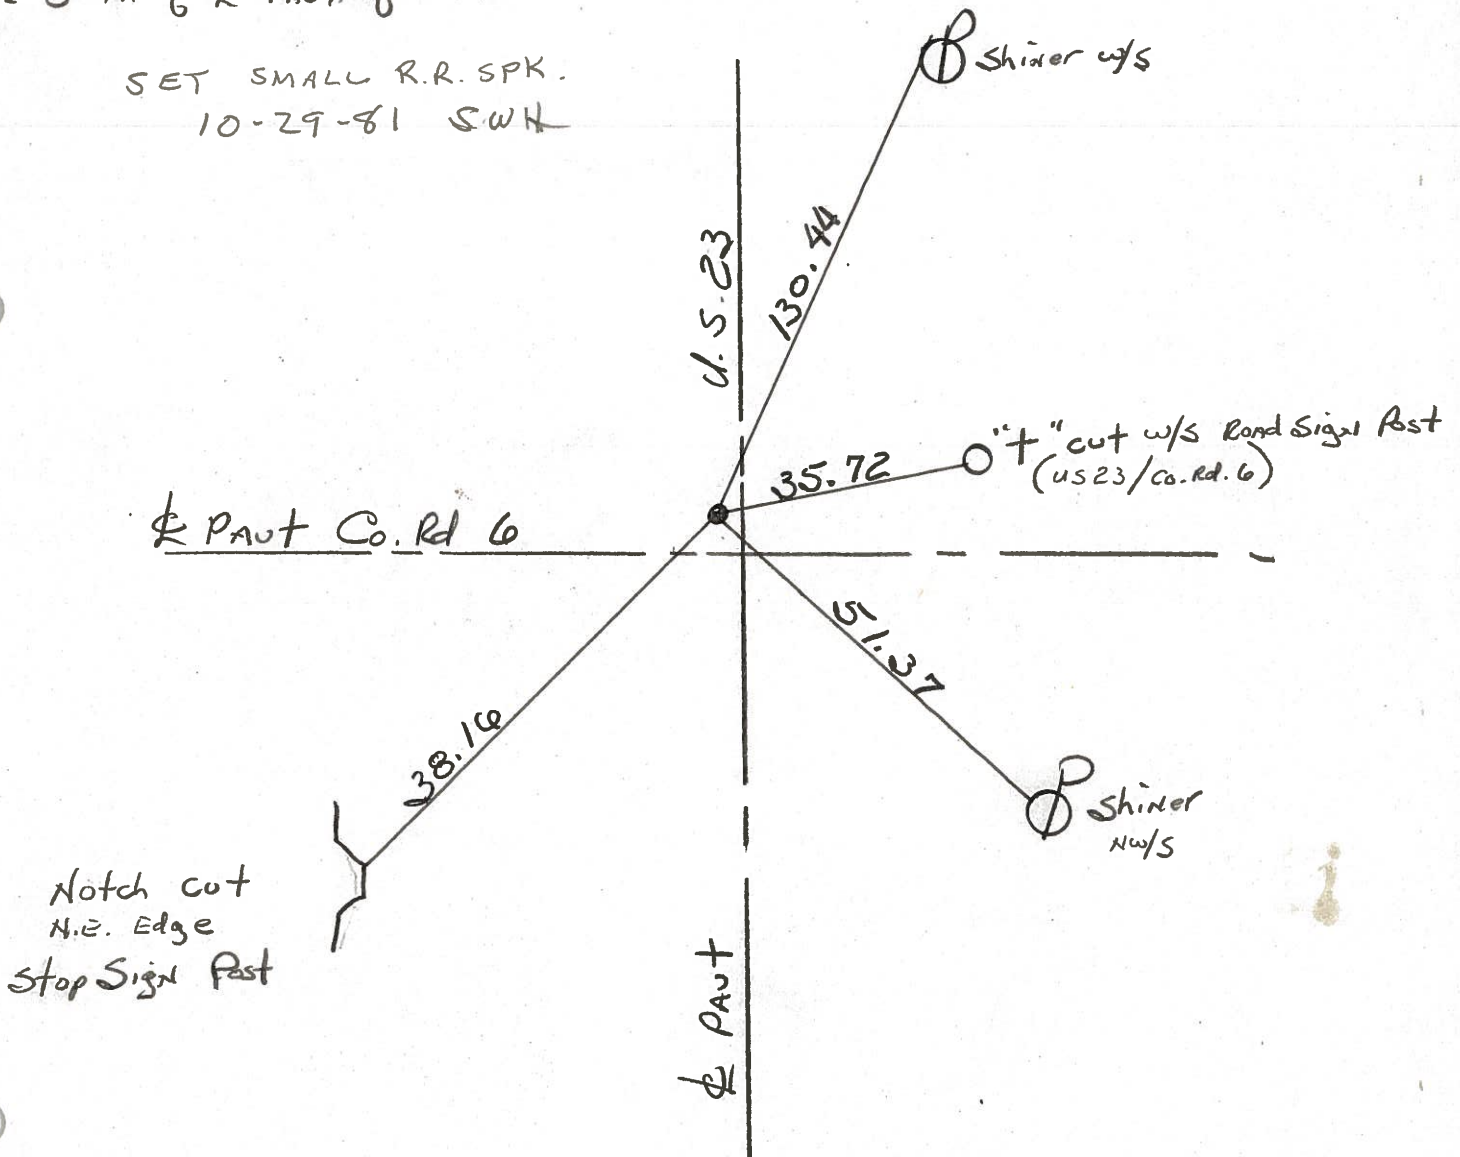

Notch cut
N.E. Edge
Stop Sign Post

P.I. STA. 158 + 75.34 - Rec.

| | | | | | | | |
|-----------|-------|-----------|-------|--------|---------------------|---------|-------|
| PERSONNEL | TITLE | PERSONNEL | TITLE | COUNTY | Seneca | DATE | 8-26- |
| Schneider | | | | S. R. | U.S. 23 | WEATHER | Fair |
| Mosser | | | | SEC. | Wyandot Co. Line N. | TEMP. | 80° |
| Barbour | | | | | | | |
| Potts | | | | | | | |

DESCRIPTION Ties for Control Points LEFT CENTER LINE RIGHT JOB NO.

