


O.D.O.T. DISTRICT 2 SURVEY OFFICE (USE ONLY)


PERSONNEL _____ REFERENCE NO. 27 SHEET 9 OF 17
 NOTES O'DONNELL DATE 5/12/21 ROUTE US 23
 H.C. AUBLE WEATHER SUNNY COUNTY SENECA
 R.C. NIESE TEMP. 50° TOWNSHIP LOUDON
 DWG BY RHOADES PID 85264 SECTION 19
 T 2 N R 19 E

TYPE MONUMENT P.K./WASHER
 ON SURFACE - ~~BELOW~~ ON
 OFFSET Q PAVEMENT 0.3' LT : ~~RT~~
11.6' TO LT EDGE PAVEMENT
 STATION: 462+86.19

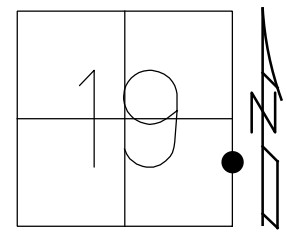

HORIZ.DATUM: NAD83 2011 GEOID: 2012A
 GRID: NORTHING: 527905.741 EASTING: 1720094.713


RECORD: P.I.
 STA 462.86.19
 $\Delta = 0^\circ 13' RT$
 FD SM.R.R.SPIKE
 7/24/89, CL
 SET P.K./WASHER
 11-3-1989, SWH
 FD P.K.NAIL
 10-26-06, DCH
 FD P.K./WASHER
 REF27
 10/26/18, JMR
 8/16/19
 5/12/21, JFO
 SET MAG/WASHER
 12/14/21, DSA

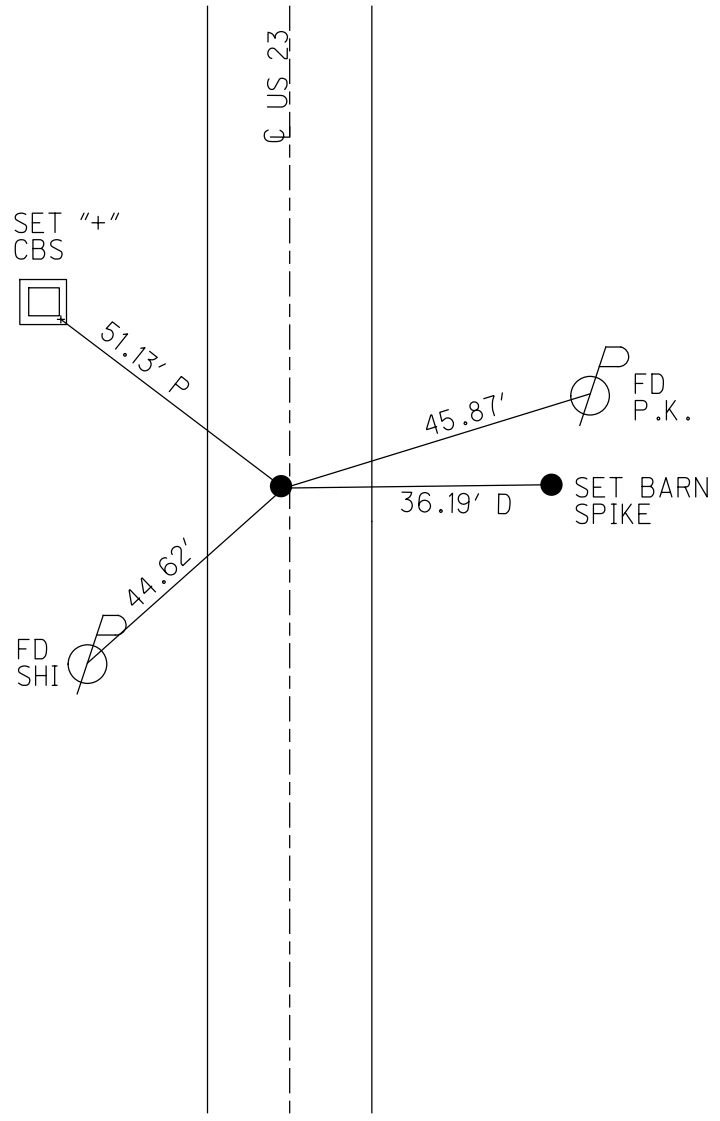

O.D.O.T. DISTRICT 2 SURVEY OFFICE (USE ONLY)


PERSONNEL _____ REFERENCE NO. 27 SHEET 5 OF 8
 NOTES HOMAN DATE 10-26-2006 ROUTE US 23
 H.C. HOMAN WEATHER SUNNY COUNTY SENECA
 R.C. MIKLOVIC TEMP. 35° F TOWNSHIP LOUDON
 _____ SECTION 19
 _____ T 2 N R 19 E

TYPE MONUMENT SM. RSPK
 ON SURFACE - ~~BELOW~~ ON _____
 LEFT - ☉ PAV'T - ~~RIGHT~~ 0.3'
11.6' TO LT. EDGE PAVEMENT
 S.L.M. 461+56

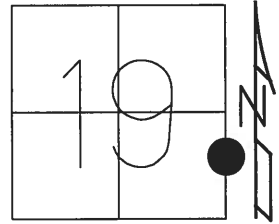

GRID: NORTHING: _____ EASTING: _____

RECORD: P.I.
 STA 462.86.19
 $\Delta = 0^\circ 13' RT$
 SET P.K./WASHER
 OVER SM.RSPK
 11-3-1989, SWH
 FD P.K.NAIL
 10-26-2006, DCH

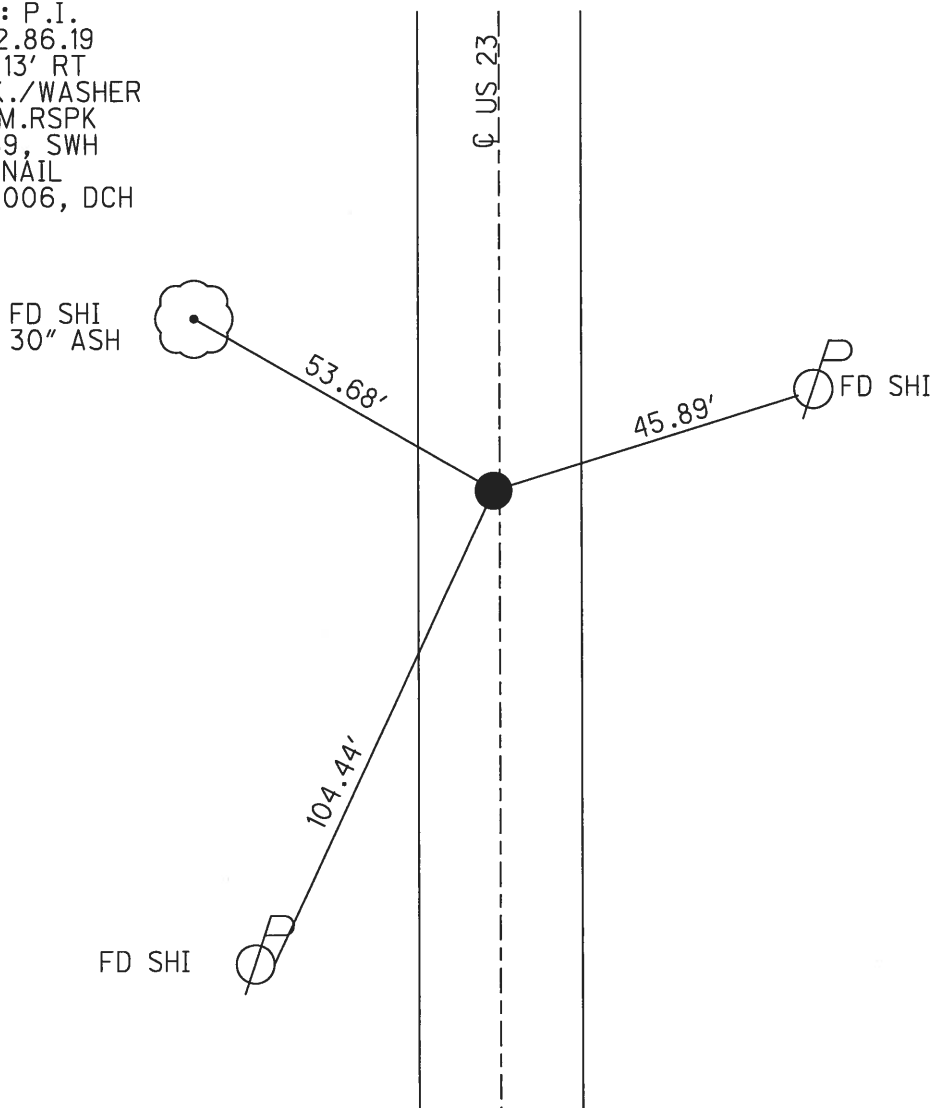

O.D.O.T. DISTRICT 2 SURVEY OFFICE

PERSONNEL

REFERENCE NO. 27

SHEET _____ OF _____

NOTES LOEHRKE Homan

H.C. Homan Homan

R.C. Barnes

Miklojic

DATE 10-26-06
7-24-89

WEATHER HOT - HAZY Sunny

TEMP. 81 35

ROUTE U.S. 23


COUNTY SENECA

TOWNSHIP LOUDON


SECTION 19

T _____ R _____

TYPE MONUMENT Small RR Spike PK Nail
 ON SURFACE - BELOW Yes Set P.K./WASHER
 LEFT - C PAV'T. - RIGHT 0.3 11-3-89 SWX
1160 Lt EDGE PAVEMENT
 S.L.M. 461 +56

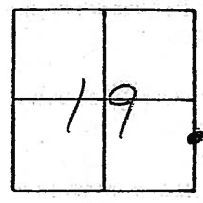

Rec. P.I. Sta 462+86.19
 $A = 0^{\circ}-13' \text{ Rt}$

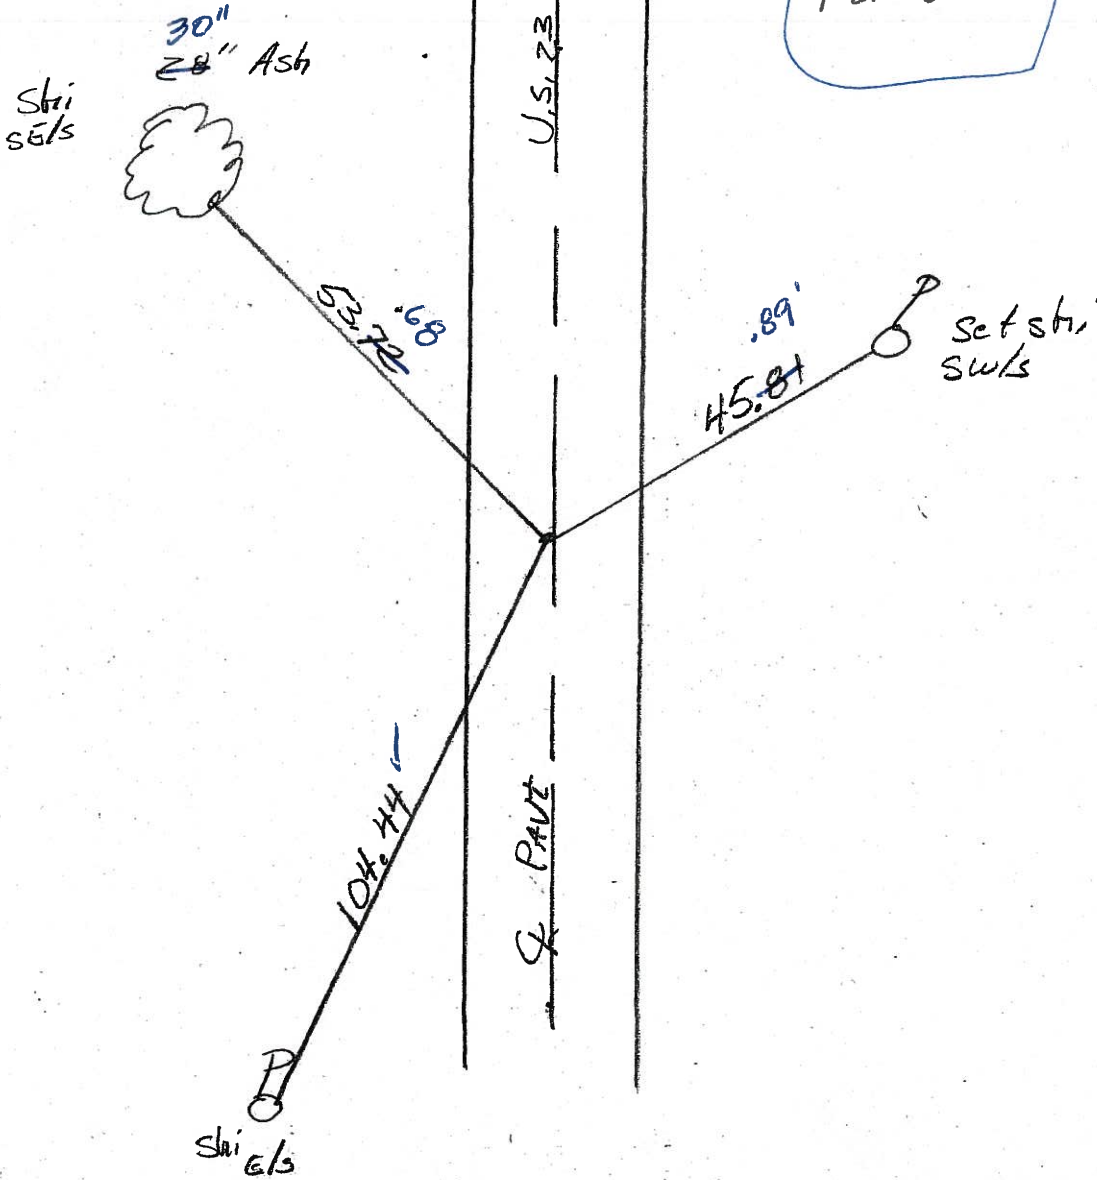

O.D.O.T. DISTRICT 2 SURVEY OFFICE

PERSONNEL _____

REFERENCE NO. 27

SHEET _____ OF _____

NOTES LOEHRKE

H.C. Hoffman

DATE 7-24-89

ROUTE U.S. 23

R.C. Barnhiser

WEATHER HOT-HAZY

COUNTY SENECA

TEMP. +81

TOWNSHIP LODON

SECTION 19

T _____ R _____

TYPE MONUMENT Small RR Spike


ON SURFACE - BELOW Yes

Set P.K./WASHER
11-3-89 SWX

LEFT - ~~C~~ PAV'T. - ~~RIGHT~~ 0.3


11/6 TO Lt EDGE PAVEMENT

S.L.M. 461 +56

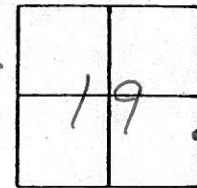

Rec. P.I. Sta 462+86.19

A = 0°-13' Rt

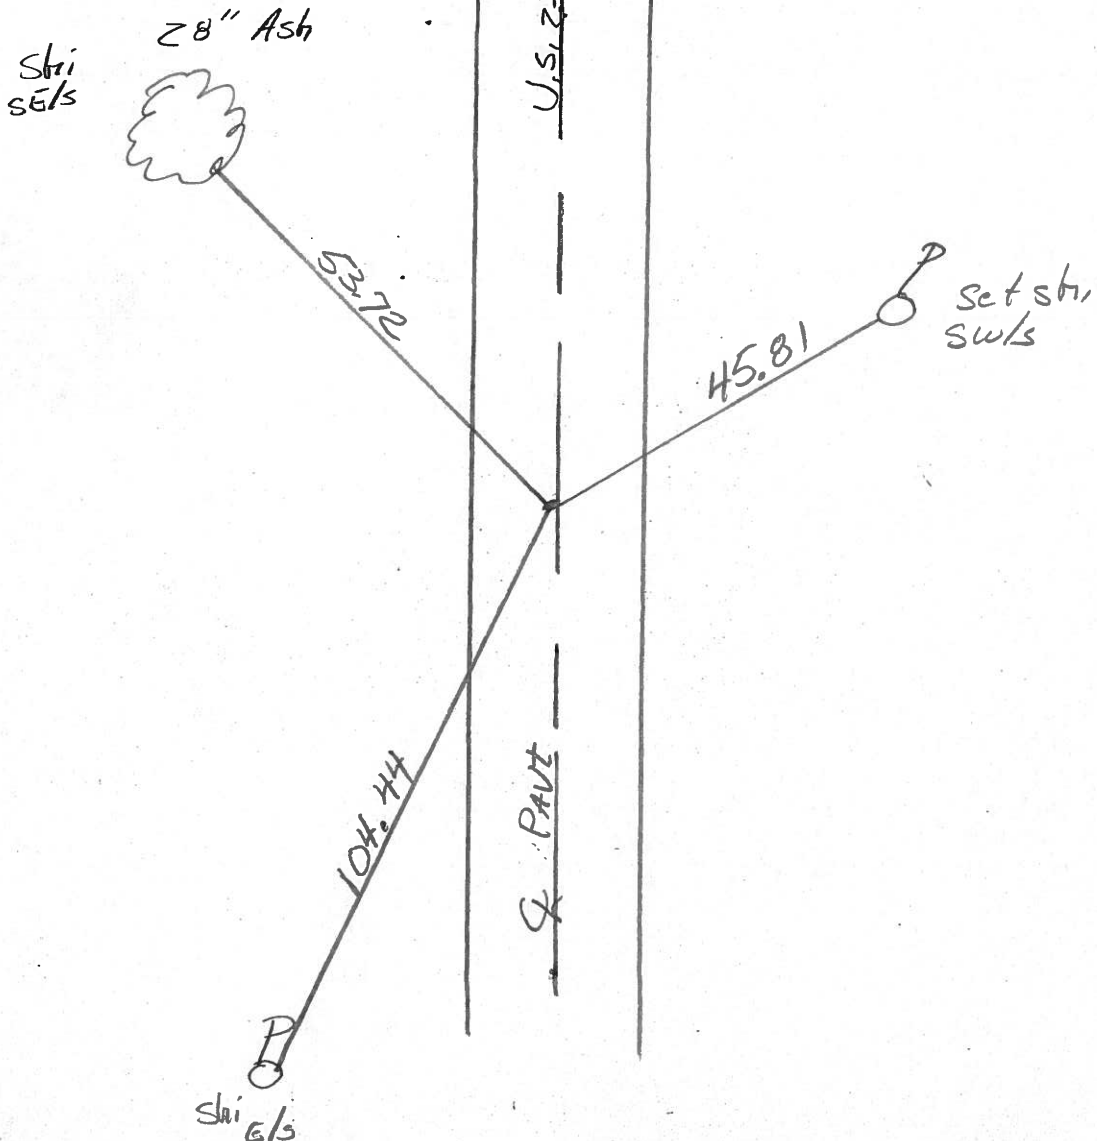

County Seneca S.R. U.S. 23

Township Loudon

Section 19

T N, R E

Personnel HOFFMAN


Householder

27

Date 6-23-81

Weather clear

Temp. +75°

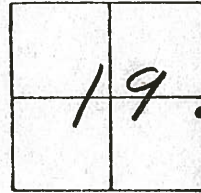


Fd. P.K. Nail/washer @ surface

Project STA ± 461+87

SET SMALL R.R. SPK.

8-27-81 SWH

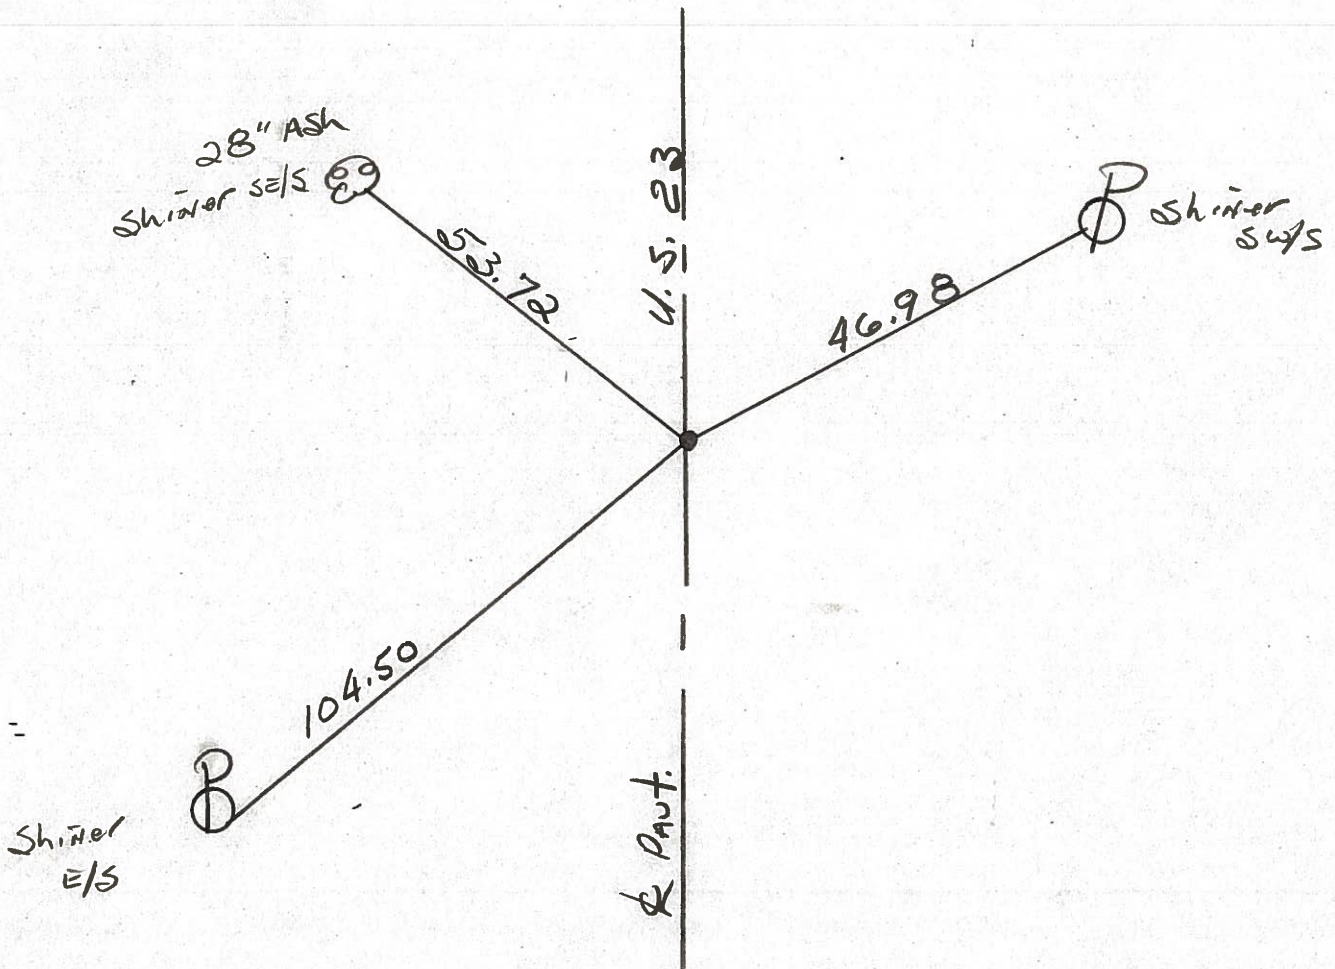


P.I. STA. 462+86.19 - Δ = 0° 13' Rt. ≈ Rec.


PERSONNEL	TITLE	PERSONNEL	TITLE	COUNTY	<u>Seneca</u>	DATE	<u>8-27-6</u>
<u>H. Schneider</u>				S. R.	<u>U.S. 23</u>	WEATHER	<u>Fair</u>
<u>E. Mosser</u>				SEC.	<u>Wyandot Co. line N.</u>	TEMP.	<u>70°</u>
<u>R. Barbour</u>							
<u>C. Potts</u>							

DESCRIPTION Ties for Control Points LEFT CENTER LINE RIGHT JOB NO.


27 X
 P.I.
 462+86.19
 $\Delta = 0^\circ 13' \text{ Rt.}$
 P.K. Nail

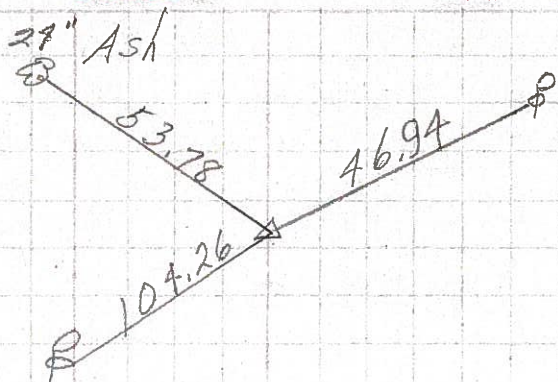

26 X
 P.I.
 499+90.74
 P.K. Nail

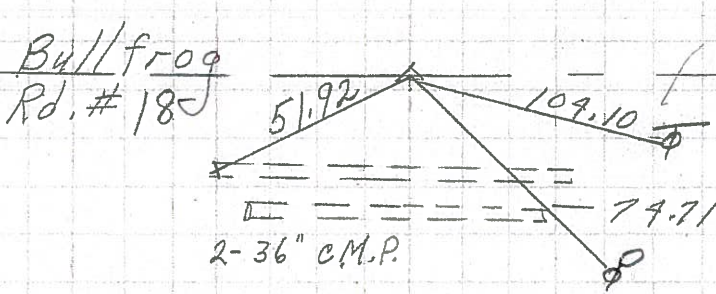

25-A X
~~25~~ X
 P.I.
 423+38.99
 $\Delta = 0^\circ 05' \text{ Lt.}$
 P.K. Nail

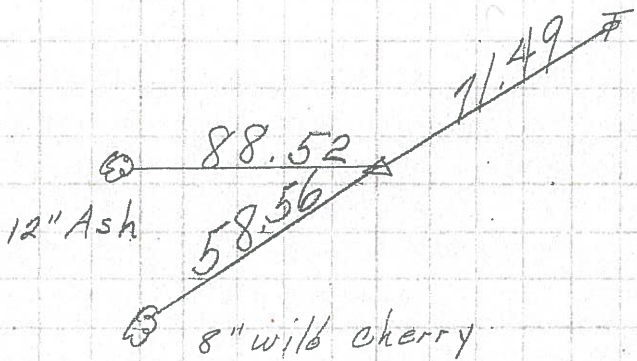

24 X
 P.I.
 396+88.69
 $\Delta = 0^\circ 07' \text{ Rt.}$
 P.K. Nail

