


O.D.O.T. DISTRICT 2 SURVEY OFFICE (USE ONLY)


PERSONNEL _____ REFERENCE NO. 30 A SHEET 13 OF 17
 NOTES O'DONNELL DATE 5/12/21 ROUTE US 23
 H.C. AUBLE WEATHER SUNNY COUNTY SENECA
 R.C. NIESE TEMP. 58° TOWNSHIP LOUDON
 DWG BY RHOADES PID 85264 SECTION 18
 T 2 N R 13 E

TYPE MONUMENT LG.R.R.SPIKE
~~ON SURFACE~~ - BELOW 4"
 OFFSET \odot PAVEMENT 0.9' ~~LT~~ : RT
10.9' TO RT EDGE PAVEMENT
 STATION: 528+26

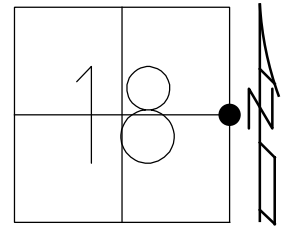

HORIZ.DATUM: NAD83 2011 GEOID: NAVD88 2012A
 GRID: NORTHING: 534559.055 EASTING: 1720130.603

RECORD:
 FD R.R.SPIKE
 7/24/89, CAL
 SET P.K./WASHER
 11/3/89, SWN
 FD P.K./WASHER
 REFA30
 1/7/20, JFO
 FD R.R.SPIKE
 4" DOWN
 5/12/21, DSA

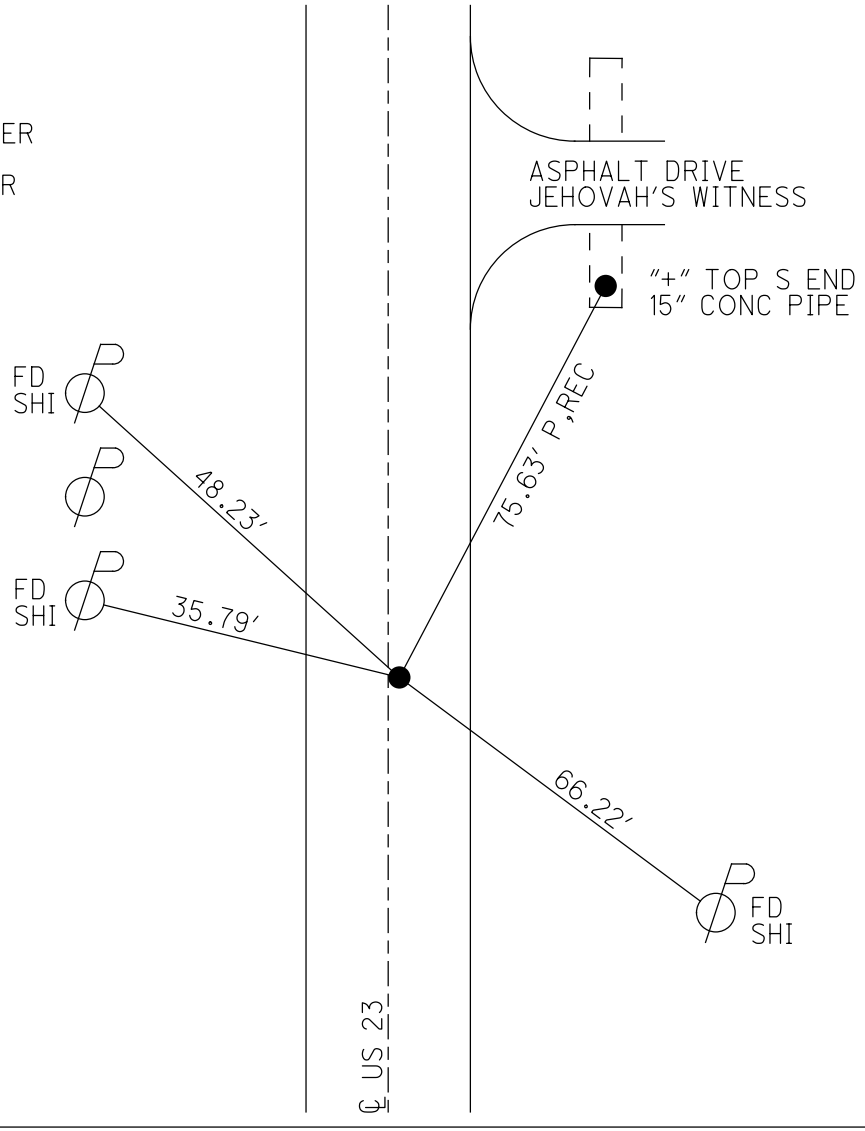

O.D.O.T. DISTRICT 2 SURVEY OFFICE (USE ONLY)

PERSONNEL

REFERENCE NO. 30 A

SHEET 13 OF 17

NOTES LOEHRKE

DATE 7/24/89

ROUTE US 23

H.C. HOFFMAN

WEATHER HOT/HUMID

COUNTY SENECA

R.C. BARNHISEL

TEMP. 85°

TOWNSHIP LOUDON

DWG BY NIESE

PID _____

SECTION 18

T 2 N R 13 E

TYPE MONUMENT R.R. SPIKE

ON SURFACE - ~~BELOW~~ ON

OFFSET Q PAVEMENT 0.9' ~~LT~~ : RT

10.9' TO RT EDGE PAVEMENT


STATION: 528+26

HORZ.DATUM: _____


GEOID: _____

GRID: NORTHING: _____

EASTING: _____

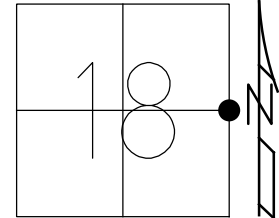

RECORD:
FD R.R. SPIKE
7/24/89, CAL
SET P.K./WASHER
11/3/89, SWN

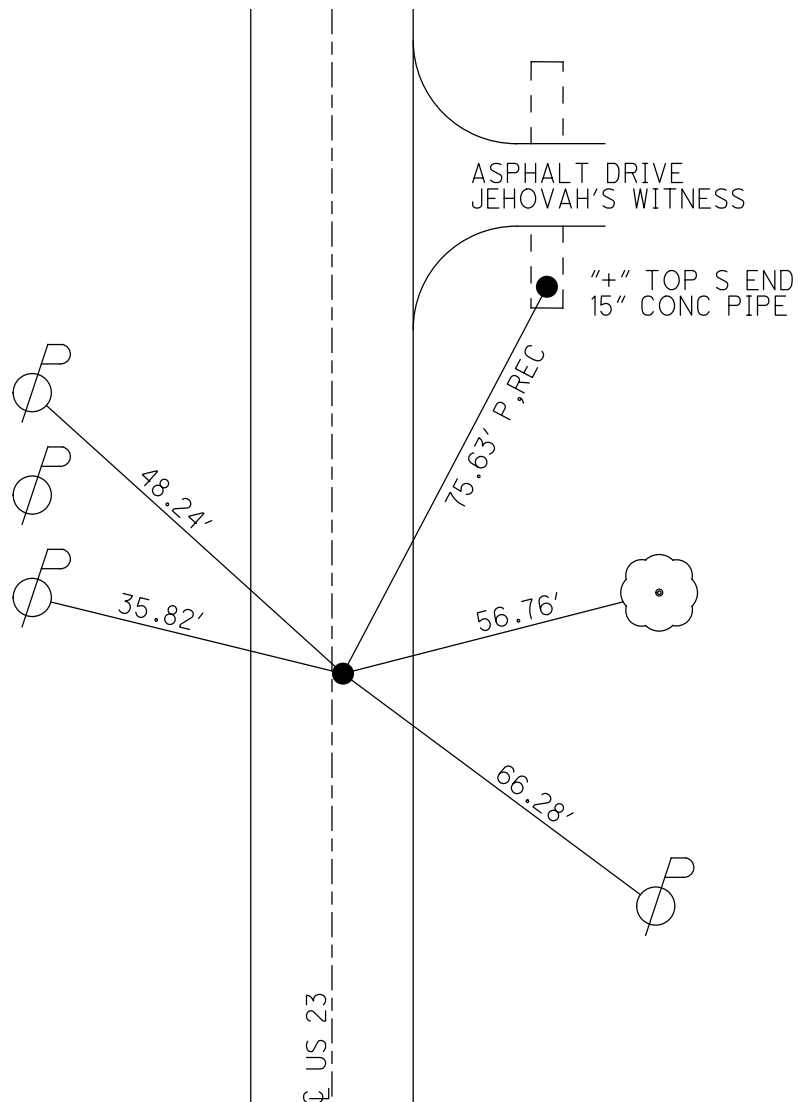

O.D.O.T. DISTRICT 2 SURVEY OFFICE

PERSONNEL _____

REFERENCE NO. 30-A

SHEET _____ OF _____

NOTES LOENKE

H.C. Hoffman

R.C. BARNHISEL

DATE 7-24-89

WEATHER Hot Humid

TEMP. +85

ROUTE U.S. 23

COUNTY SENECA

TOWNSHIP LOUDON

SECTION 18

T _____ R _____

TYPE MONUMENT R.R. Spike



ON SURFACE - BELOW Yes

LEFT - & PAV'T. - RIGHT 0.9 RT

0.9 TO RT EDGE PAVEMENT

S.L.M. 528+26

*set PL/wasina
11-3-89 SWN*

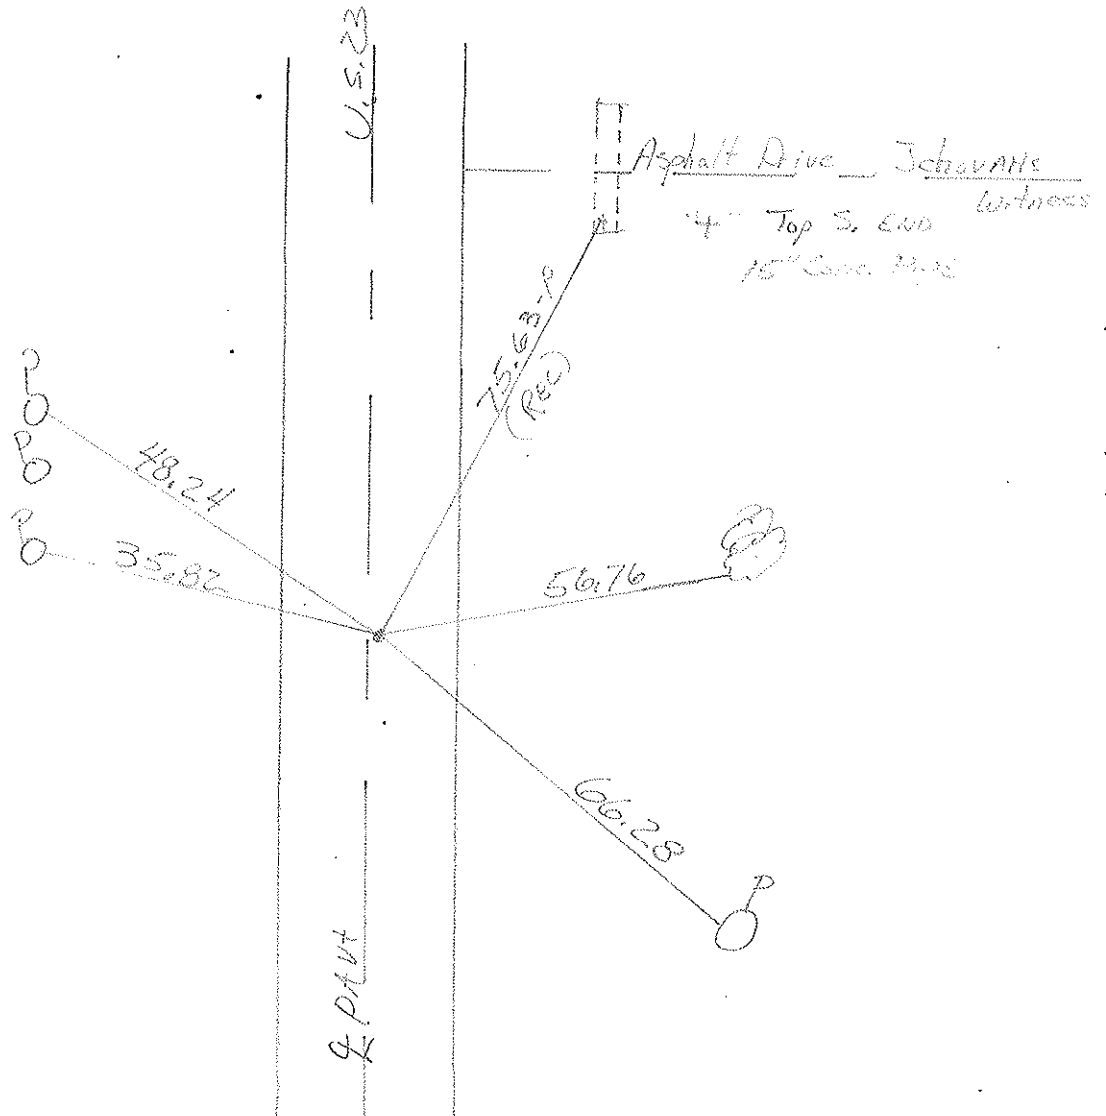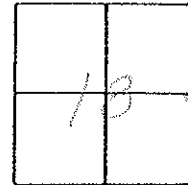

County Seneca S.R. 4.3.23

Township London

Section 18

T. N, R. E


Personnel HOFFMAN
Householder

#30-A

Date 6-24-81


Weather cloudy

Temp. +75°

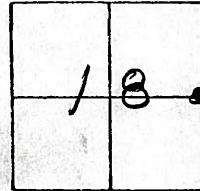

Fd. R.R. Spk @ SURFACE
0.5' E. of & PART.

PROJECT STA ± 528+63

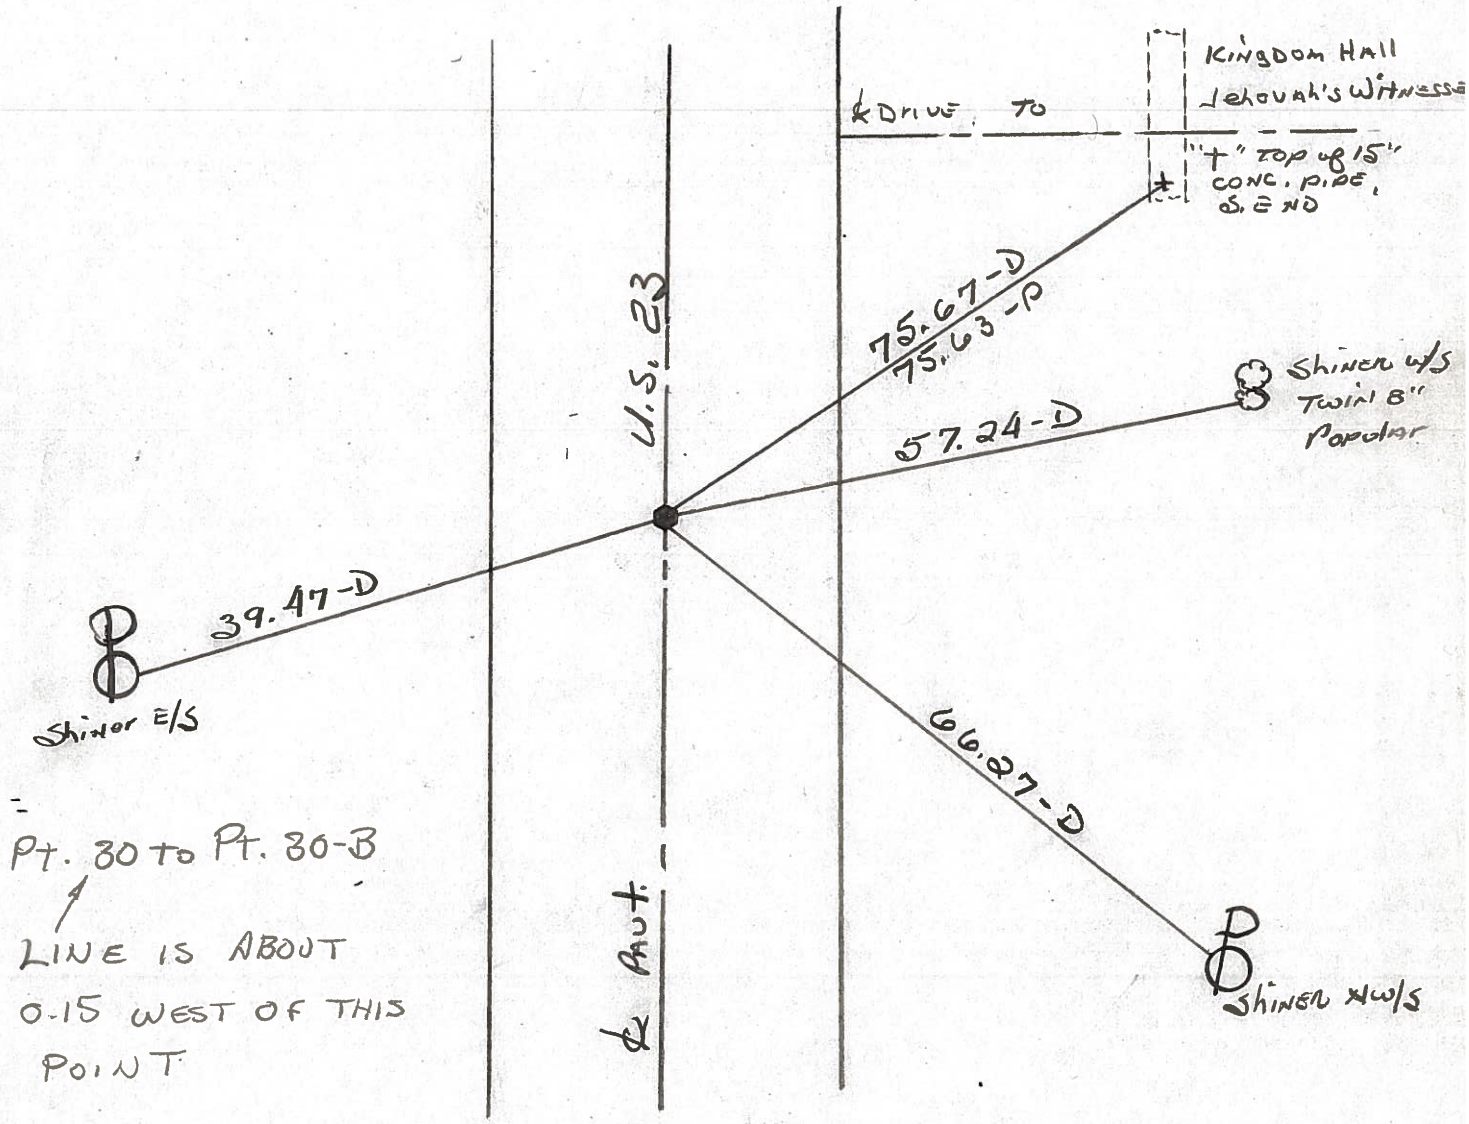

Pt. 30 to Pt. 30-B
LINE IS ABOUT
0.15 WEST OF THIS
POINT

529+36.92