

O.D.O.T. DISTRICT 2 SURVEY OFFICE (USE ONLY)

PERSONNEL

REFERENCE NO. CL1

NOTES BARRIERE DATE 10/3/25

H.C. MILLER WEATHER SUNNY

R.C. PRESTON-COLVIN TEMP. 75°

NIESE

DWG BY BARRIERE PID 101280

ROUTE US 23

COUNTY SENECA

TOWNSHIP LOUDON


SECTION 18

T 2 N R 13 E

TYPE MONUMENT MAG NAIL

ON SURFACE - BELOW ON

OFFSET $\oslash$ PAVEMENT ON

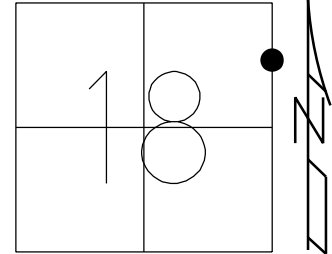

STATION: 532+55.00

HORIZ.DATUM: SEN OCCS/NAD83 (11) GEOID: 18

GRID: NORTHING: EASTING:

LDP: NORTHING: 303307.875 EASTING: 94717.049

RECORD:
FD MAG
5/15/25, JAM
SET MAG
SETREFCL1
10/3/25, JAM

