

O.D.O.T. DISTRICT 2 SURVEY OFFICE (USE ONLY)

PERSONNEL

REFERENCE NO. CL13

NOTES BARRIERE DATE 10/3/25
H.C. MILLER WEATHER SUNNY
R.C. PRESTON-COLVIN TEMP. 75°
NIESE

ROUTE US 23
COUNTY SENECA
TOWNSHIP LOUDON
SECTION 7
T 2 N R 13 E

DWG BY BARRIERE PID 101280

TYPE MONUMENT MAG NAIL/WASHER

ON SURFACE - BELOW ON


OFFSET CL PAVEMENT ON

STATION: 568+05

HORIZ.DATUM: SEN OCCS/NAD83 (11) GEOID: 18

GRID: NORTHING: EASTING:

LDP: NORTHING: 306802.211 EASTING: 94710.446

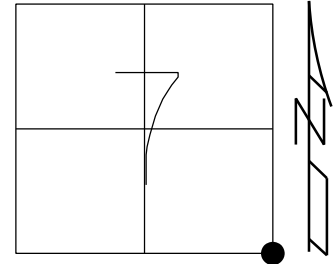

RECORD:
FD MAG
5/15/25, JAM
SET MAGR
SETCL13
10/3/25, JAM

