

O.D.O.T. DISTRICT 2 SURVEY OFFICE (USE ONLY)

PERSONNEL

REFERENCE NO. CL3

NOTES BARRIER DATE 10/3/25
H.C. MILLER WEATHER SUNNY
R.C. PRESTON-COLVIN TEMP. 75°
NIESE

ROUTE US 23
COUNTY SENECA
TOWNSHIP LOUDON
SECTION 7
T 2 N R 13 E

DWG BY BARRIER PID 101280

TYPE MONUMENT MAG NAIL/WASHER

ON SURFACE - BELOW ON


OFFSET Q PAVEMENT ON

STATION: 573+25

HORIZ.DATUM: SEN OCCS/NAD83 (11) GEOID: 18

GRID: NORTHING: EASTING:

LDP: NORTHING: 307322.968 EASTING: 94710.442

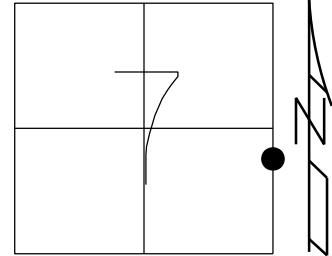

RECORD:
FD PK NAIL
5/15/25, JAM
SET MAG
SETCL3
10/3/25, JAM

2.2' UP
FEN POST
78.77'

2.2' UP
FEN POST
57.84'

 FD SHI
55.18'

 TOP BOLT
67.31'

Q US 23