

O.D.O.T. DISTRICT 2 SURVEY OFFICE (USE ONLY)

PERSONNEL


REFERENCE NO. CL4

NOTES BARRIERE DATE 10/3/25
H.C. MILLER WEATHER SUNNY
R.C. PRESTON-COLVIN TEMP. 75°
NIESE

ROUTE US 23
COUNTY SENECA
TOWNSHIP LOUDON
SECTION 7
T 2 N R 13 E

DWG BY BARRIERE PID 101280

TYPE MONUMENT MAG NAIL/WASHER
ON SURFACE - BELOW ON
OFFSET $\oslash$ PAVEMENT ON

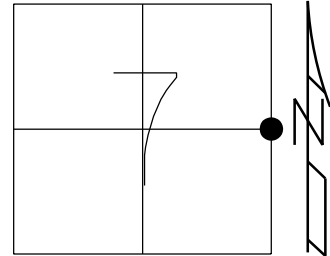

STATION: 581+46

HORIZ.DATUM: SEN OCCS/NAD83 (11) GEOID: 18

GRID: NORTHING: EASTING:

LDP: NORTHING: 308138.109 EASTING: 94710.06

RECORD:
FD HOLE
5/15/25, JAM
SET MAG
SETCL4
10/3/25, JAM

