

O.D.O.T. DISTRICT 2 SURVEY OFFICE (USE ONLY)

PERSONNEL

REFERENCE NO. 32

SHEET 1 OF 1

NOTES BARNHEISEL

DATE 7/10/97

ROUTE US 23

H.C. CANTERBURY

WEATHER SUNNY

COUNTY SENECA

R.C. WEAVER

TEMP. 70°

TOWNSHIP LOUDON

ROUSOS

SECTION 6

DWG BY RHOADES PID _____

T 2 N R 13 E

TYPE MONUMENT P.K./WASHER

ON SURFACE - BELOW 2'

OFFSET ☉ PAVEMENT ON _____ LT : RT

22' TO LT EDGE PAVEMENT


STATION: 694+49.8'

HORZ. DATUM: _____


GEOID: _____

GRID: NORTHING: _____

EASTING: _____

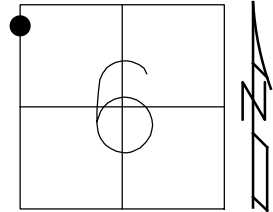

RECORD:
FD NAIL
7/20/78, BURNSIDE
FD P.K./WASHER
2" DOWN
7/10/97, MB
D.N.F.
7/21/17, JFO

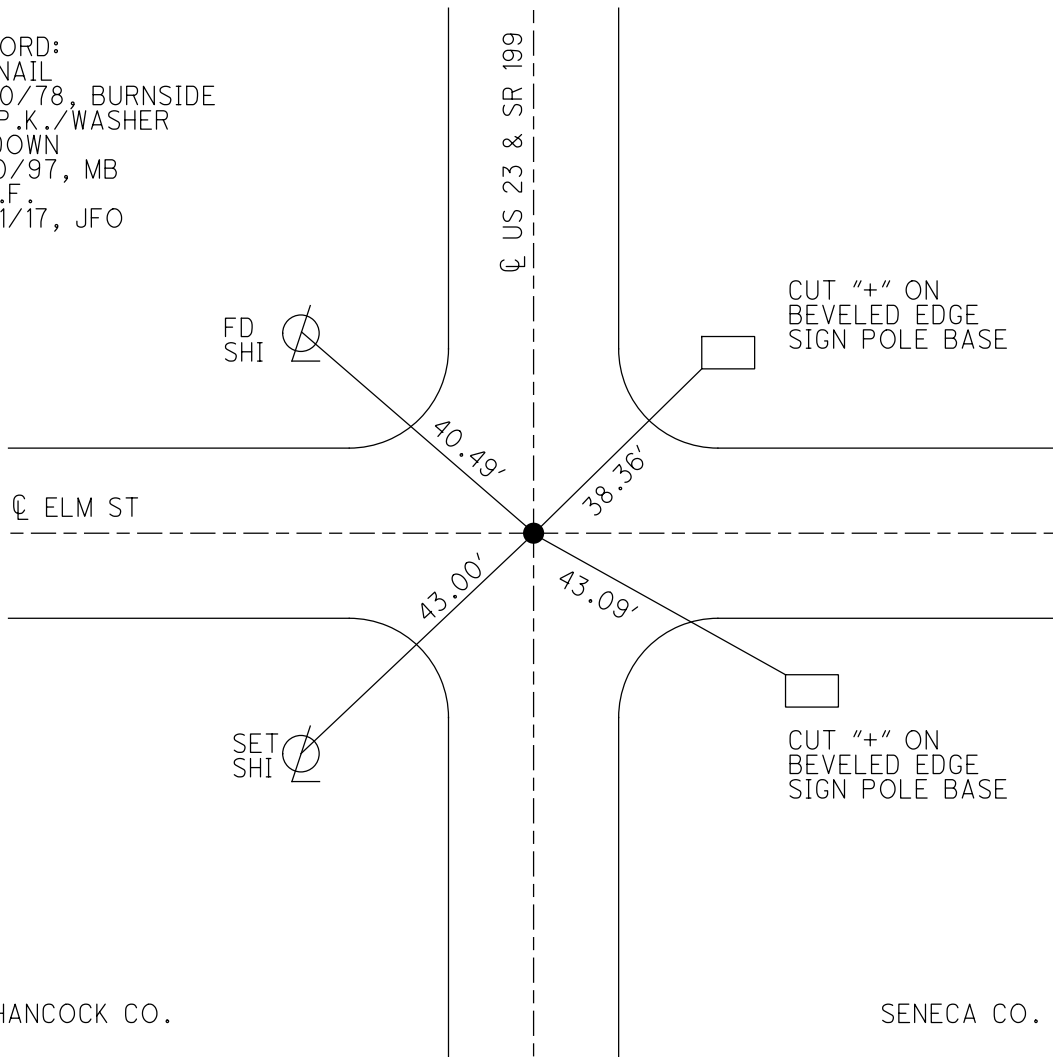

HANCOCK CO.

SENECA CO.

O.D.O.T. DISTRICT 2 SURVEY OFFICE

PERSONNEL

REFERENCE NO. _____

SHEET 1 OF 4
U.S. 23 - SR. 199

NOTES BARNHISEL

H.C. CANTERBURY

R.C. WEAVER

Roucos

DRAWN BY Roucos

DATE 7-10-97

WEATHER SUNNY

TEMP. 70


ROUTE SR 199

COUNTY Seneca-Wood

TOWNSHIP _____

SECTION _____

T _____ R _____

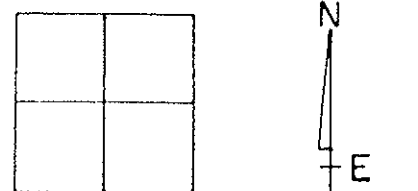

TYPE MONUMENT P.K. WASHER

ON SURFACE - BELOW 2" Below


LEFT- & PAW'T. - RIGHT & Pmnt.

22.0 TO EDGE PAVEMENT

S.L.M. 21+16.8

FND NAIL @ SURFACE
ORIGIN UNKNOWN

Set P.K. / WASHER
11-26-97
MC

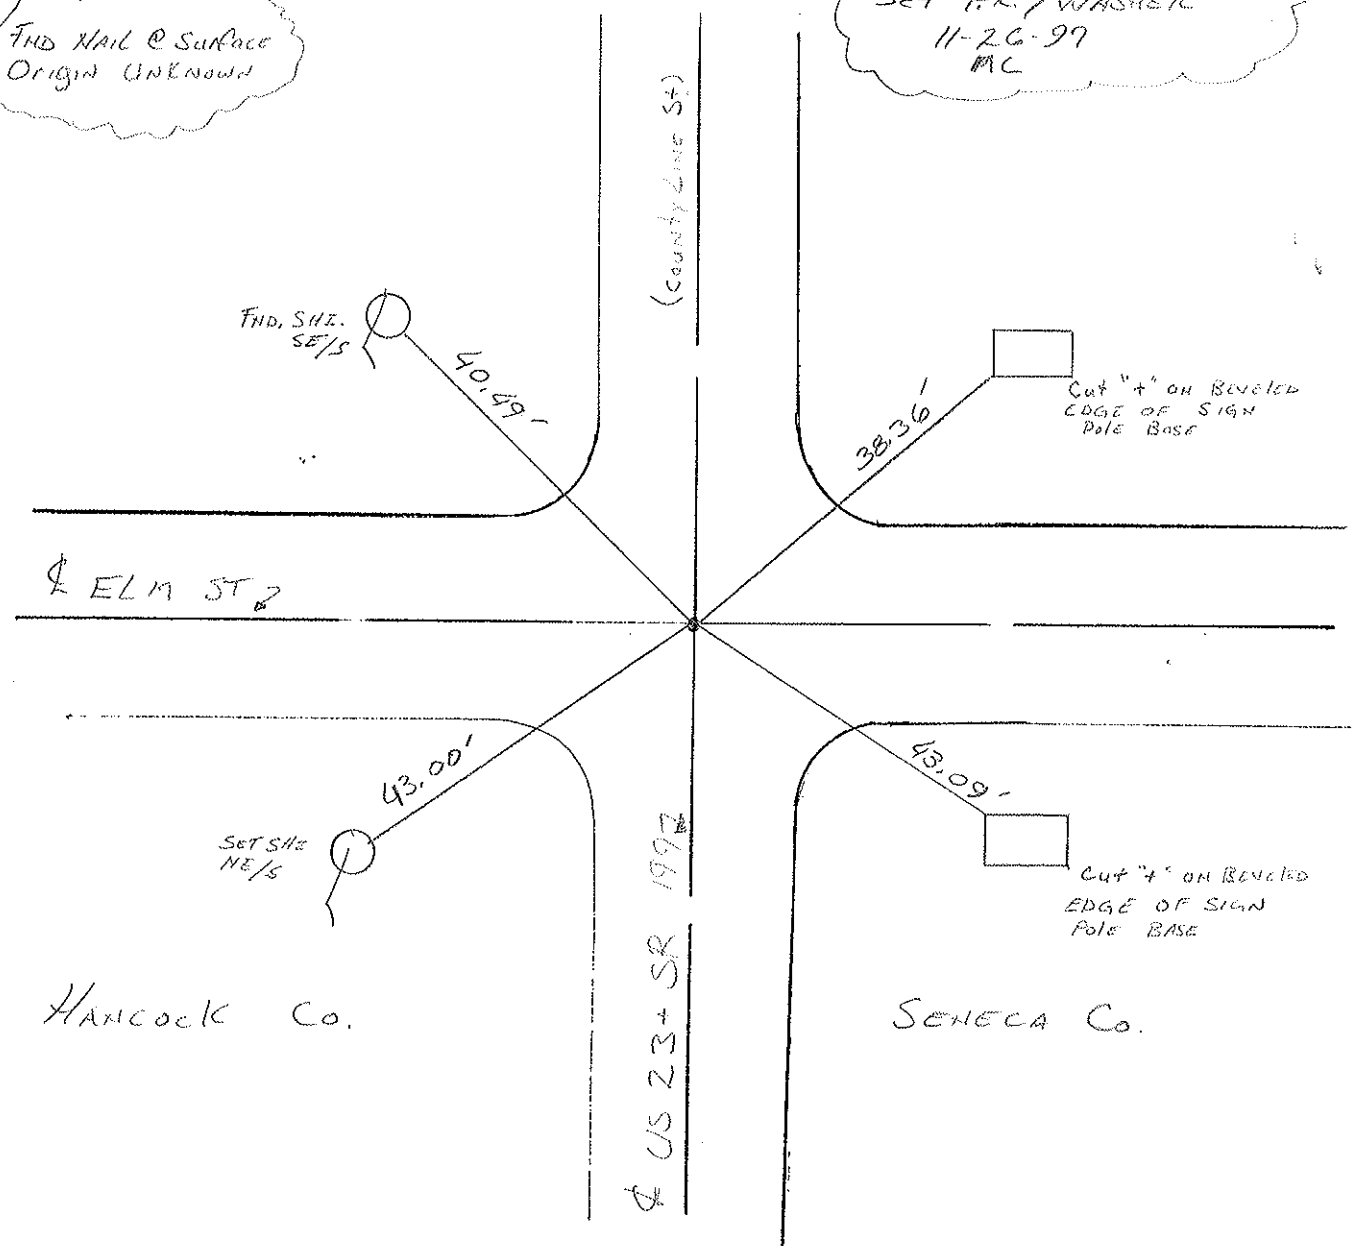

Resurveyed 1997

OD.O.T. DISTRICT 2 SURVEY OFFICE

Sht. 1 of 6
U.S. 23 - S.R. 199

County SENECA-WOOD

Date 7-20-78

Township _____


Weather CLEAR

Section _____

Temp. +88°

T N, R E

Personnel BURNSIDE

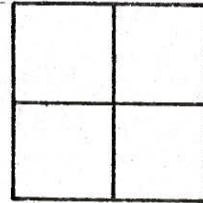

32

BOWERS

KNAPE

MEAD

FD. NAIL @ SURFACE
ORIGIN UNKNOWN

