


*RW checked
easements obtained
JAF
3/24/44*


Hulda Kern
R.F.D. #3
Tiffin, Ohio
EASEMENT RECORDED V 220, Pg 597
SEN. CO. RECORDS

Burton L. Adelsperger
Russell Adelsperger
Della M. Blue
R.F.D. #3
Tiffin, Ohio
RECORDED VOL 220 Pg 595
SEN CO REC.

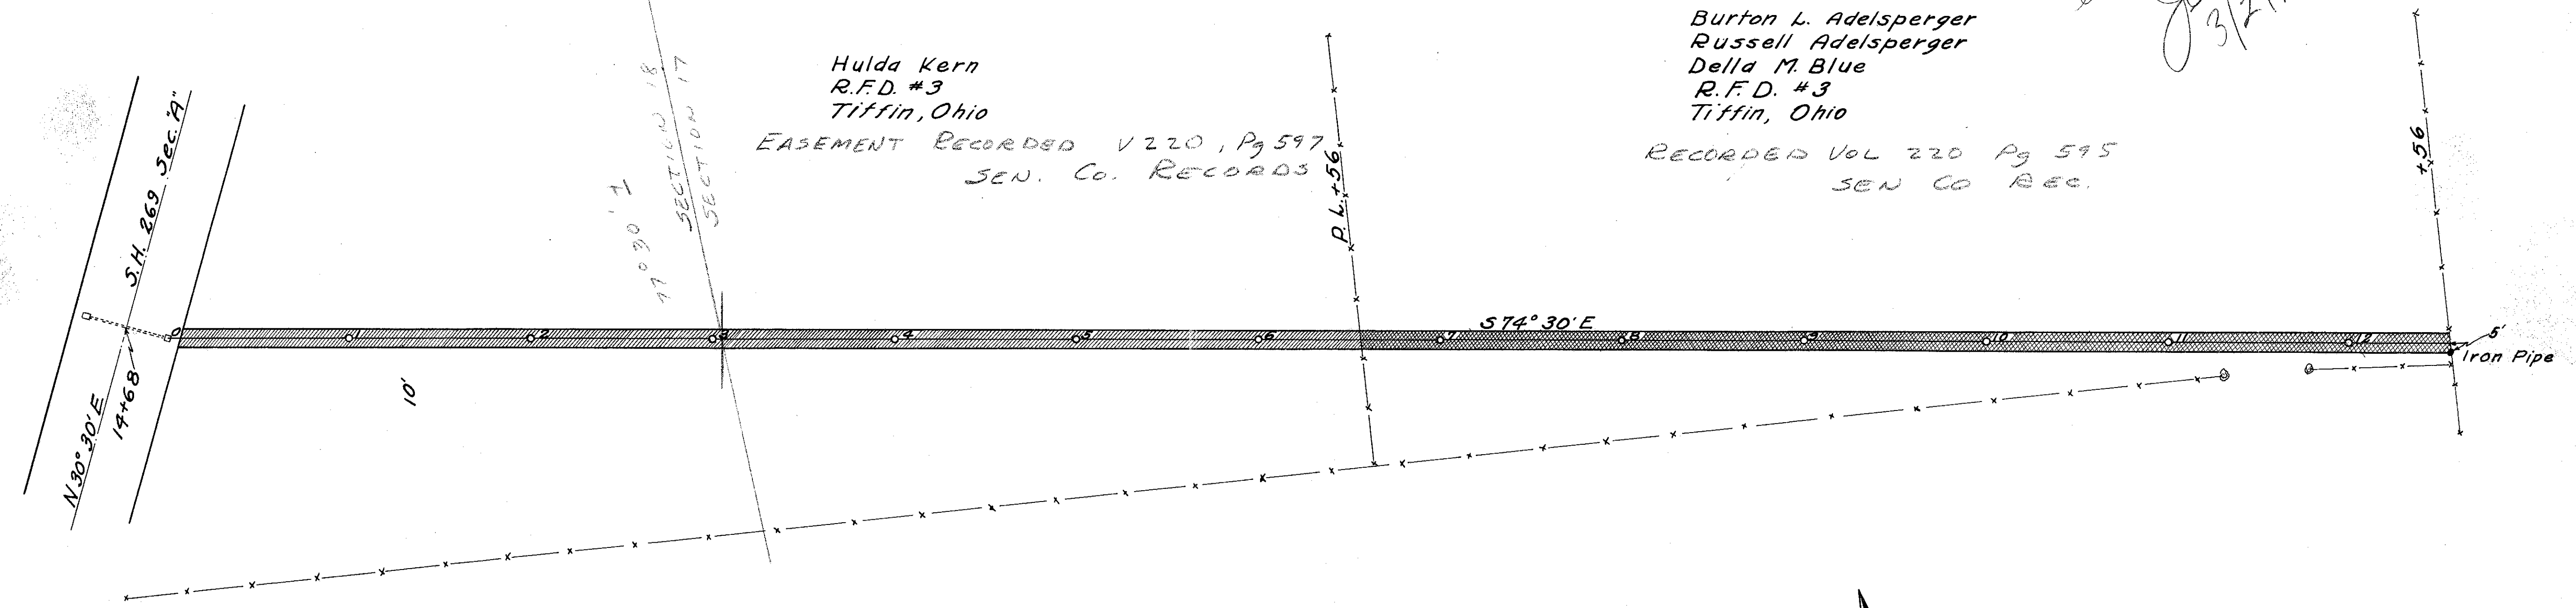

Burton L. Adelsperger
Russel Adelsperger
Della M. Blue
R.F.D. #3
Tiffin, Ohio

Charles L. Huffman
R.F.D. #4
Tiffin, Ohio

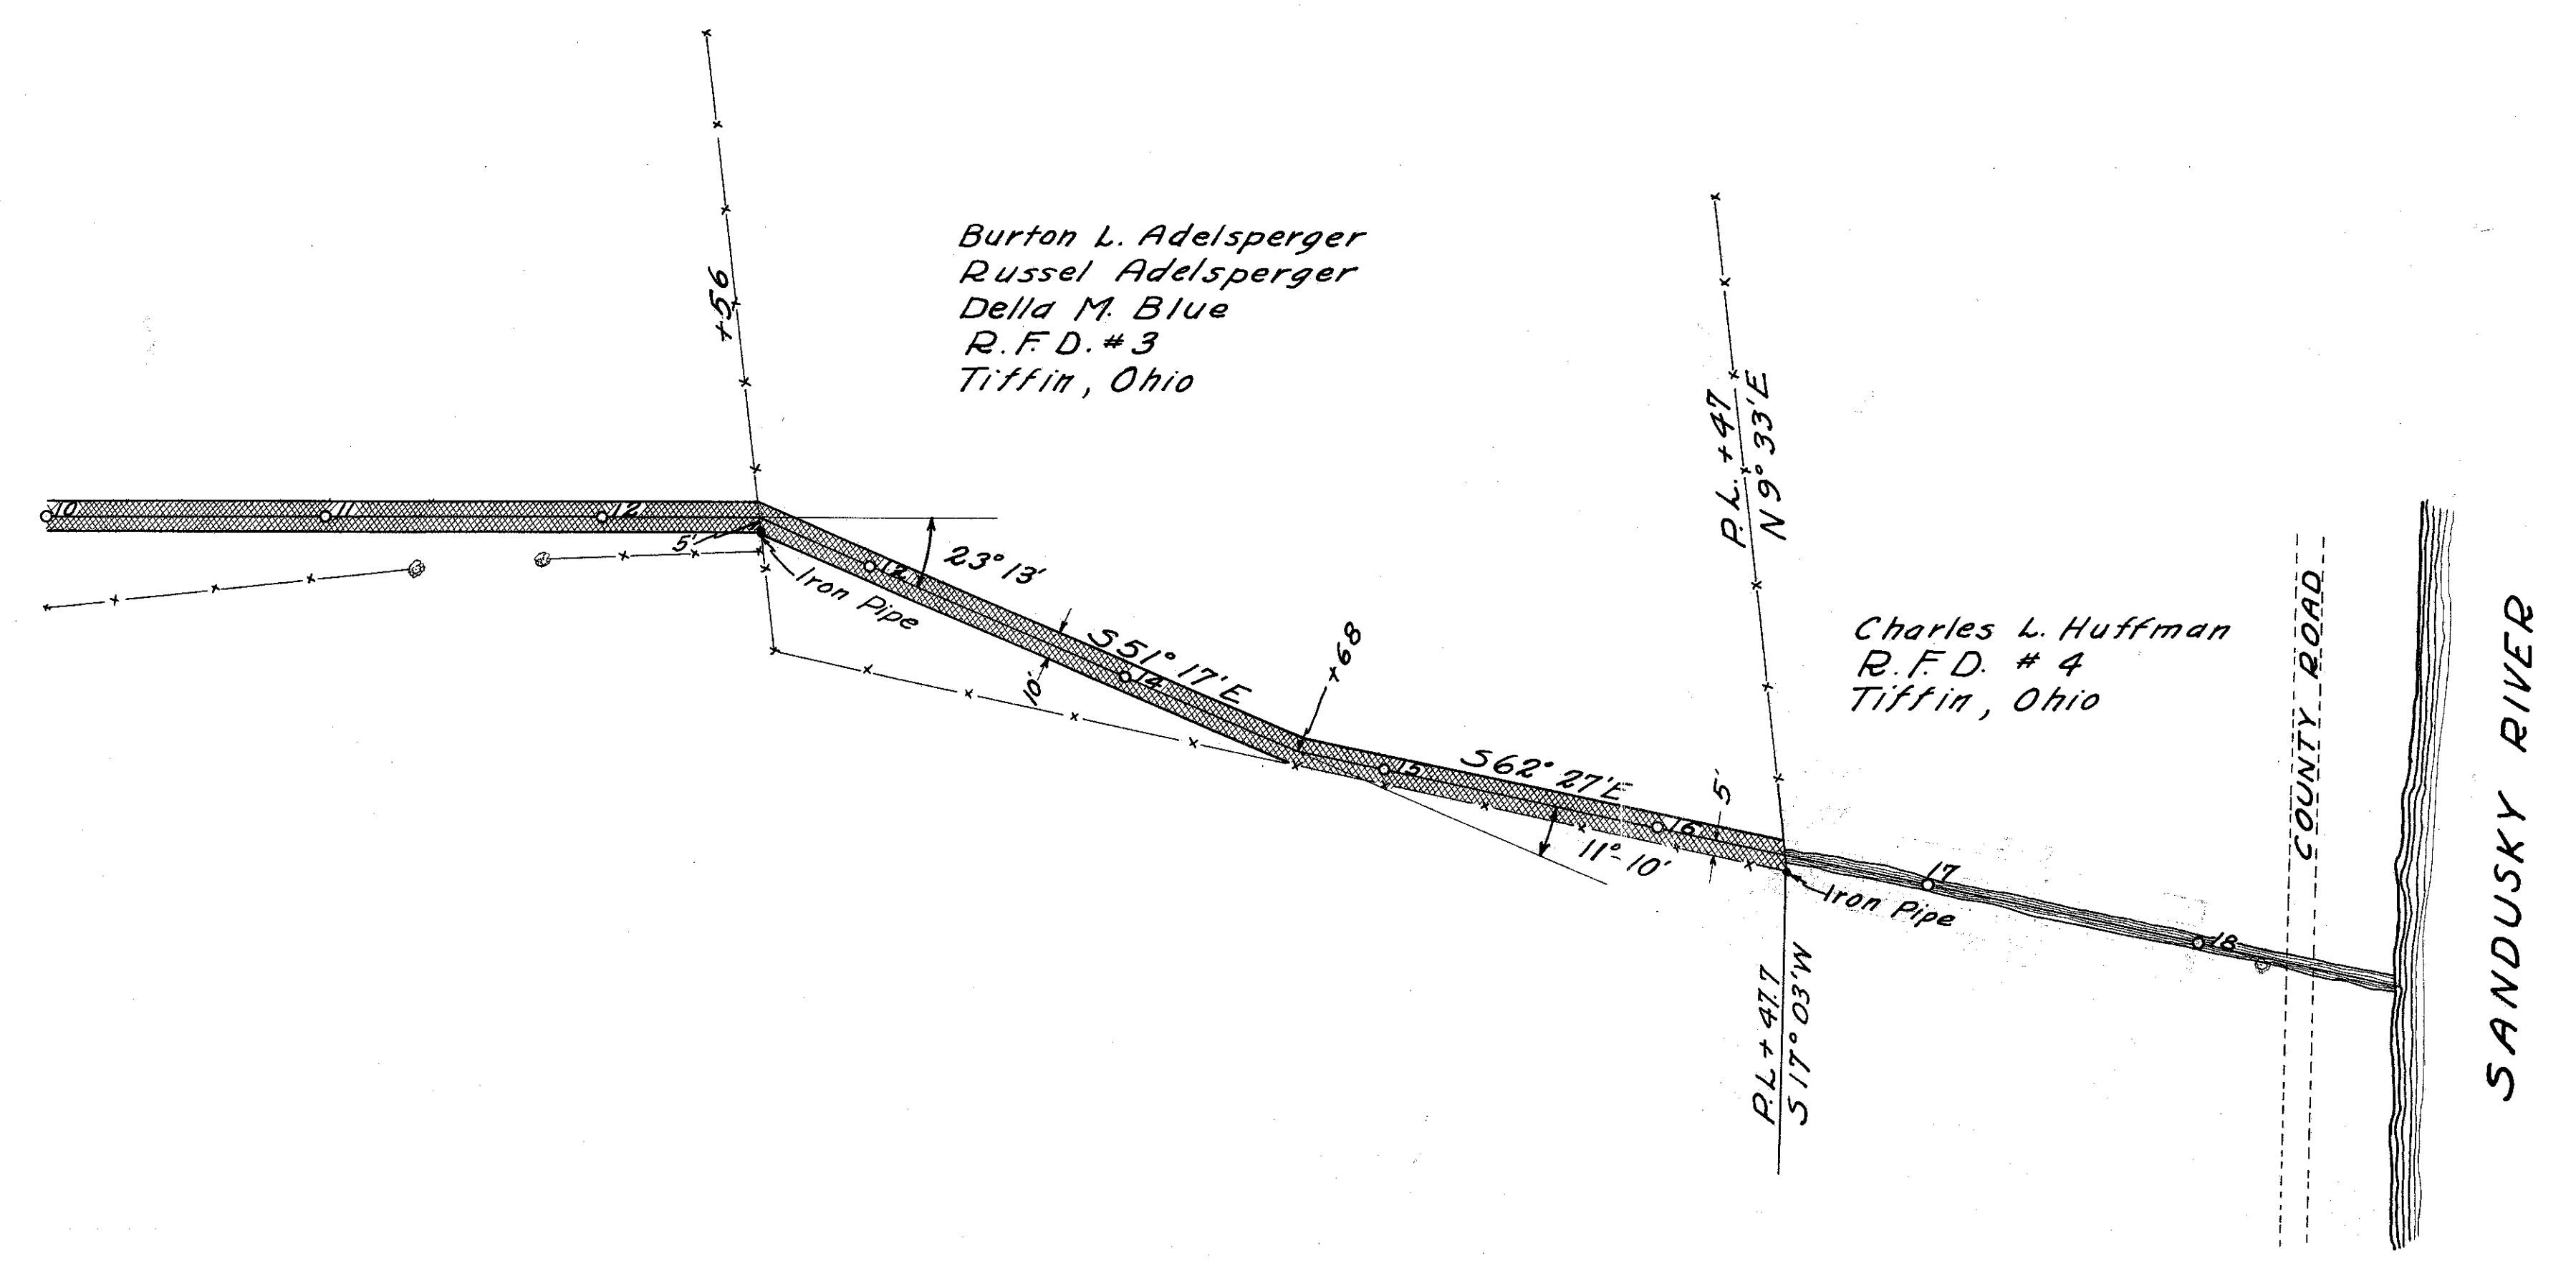

1791 A.M.C.
revised

RA053
45
G-16