

O.D.O.T. DISTRICT 2 SURVEY OFFICE (USE ONLY)

PERSONNEL _____ REFERENCE NO. 7 SHEET 7 OF 41
 NOTES RHOADES DATE 4/26/17 ROUTE SR 53
 H.C. O'DONNELL WEATHER SUNNY COUNTY SENECA
 R.C. RHOADES TEMP. 64° TOWNSHIP SENECA
 _____ SECTION 33
 _____ T 1 N R 14 E

TYPE MONUMENT P.K./WASHER


ON SURFACE - ~~BELOW~~ ON

~~LEFT~~ - CL PAV'T - RIGHT 2.3'


6.6' TO RT EDGE PAVEMENT

S.L.M. 56+23.73

Grid: Northing: 488446.977 Easting: 1762652.494

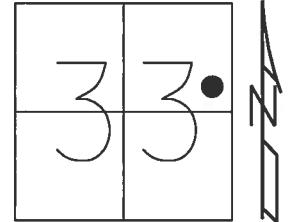

RECORD:
 STA. 56+27.80
 P.K./WASHER ATOP
 P.K./WASHER ATOP
 BOAT SPIKE/WASHER
 FD P.K./WASHER
 6/24/97, MC
 SET P.K./WASHER
 10/6/97, MC
 FD P.K./WASHER
 REF7
 4/27/16, JFO
 SET MAG/WASHER
 NEWREF7
 9/5/17, JFO

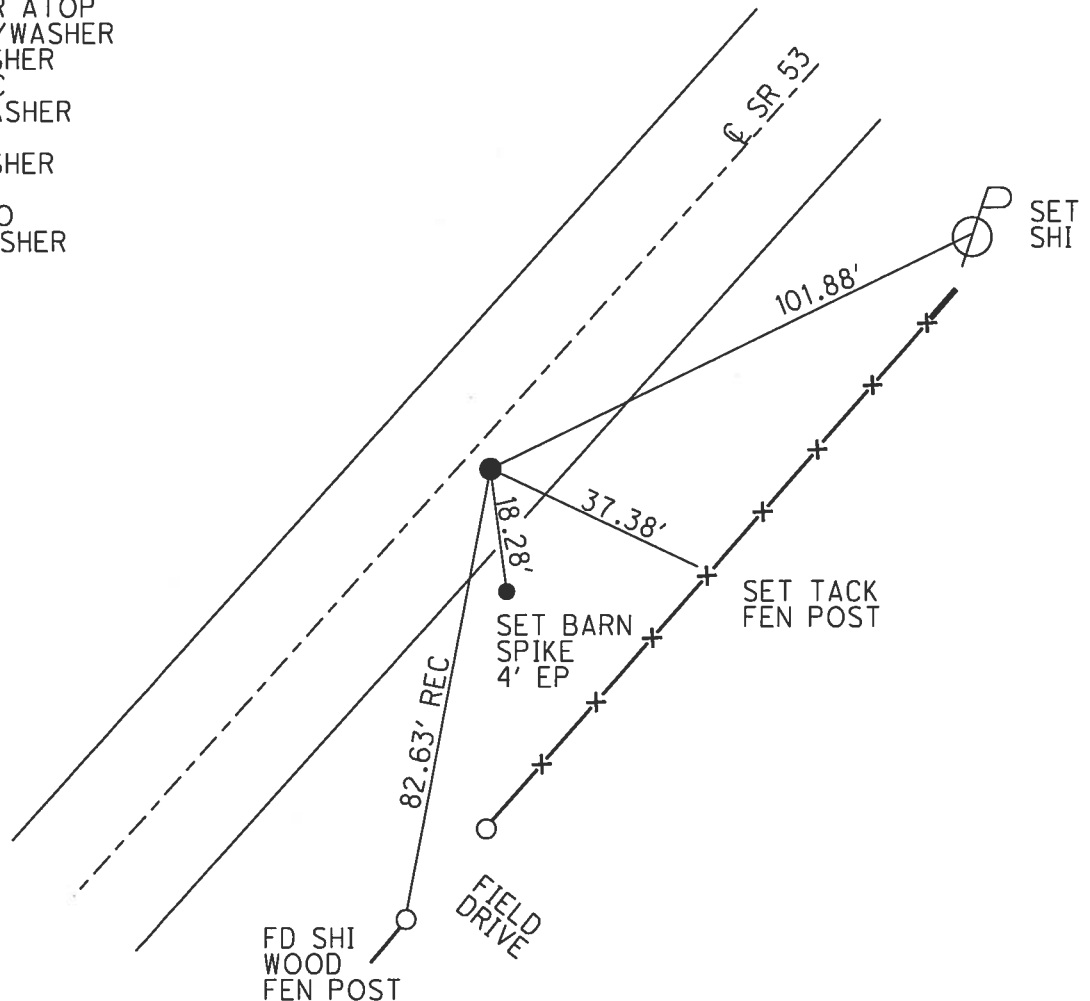

O.D.O.T. DISTRICT 2 SURVEY OFFICE

PERSONNEL

REFERENCE NO. 7

SHEET 7 OF 34

NOTES Canterbury

H.C. Rousos

R.C. Canterbury

M. Weaver

ROUSOS - DRAWING

DATE 6/24/99

WEATHER Sunny

TEMP. 89°

ROUTE #53

COUNTY SENECA

TOWNSHIP SENECA

SECTION _____

T 1 N R 14 E


TYPE MONUMENT P.K. & WASHER

ON SURFACE - BELOW Surface

LEFT - 0 PAVT. - RIGHT 2.3' RT

6.6' TO RT. EDGE PAVEMENT

S.L.M. 1+717.07 SLK

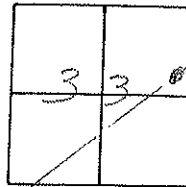

Reset P.K. & Washer
10/6/99
M.R.C.


RECORD:

P.Z

SG + 27.80

PK & Washer ATOP SAME

ATOP BOAT SKI & WASHER

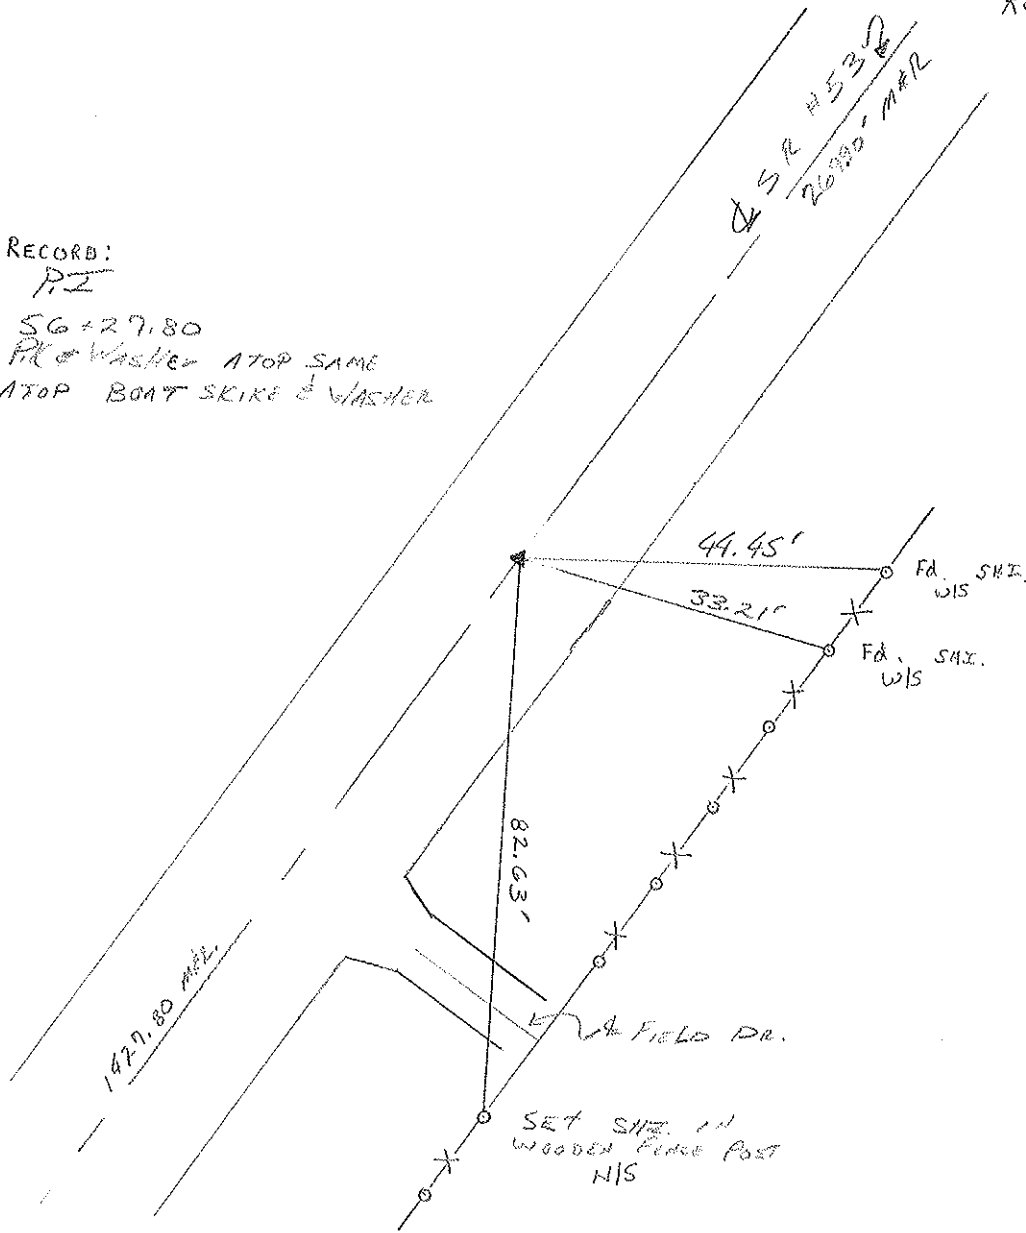

O.D.O.T. DISTRICT 2 SURVEY OFFICE

PERSONNEL


NOTES ORONIN
 H.C. RIPPLE
 R.C. BARBOUR
GEYMAN

REFERENCE NO. 7
 DRAWN 10/27/89
 DATE 8/30/88
 WEATHER SUNNY
 TEMP. 70°


SHEET 7 OF

ROUTE #53
 COUNTY SENECA
 TOWNSHIP SENECA
 SECTION
 T 1 N R 14 E

TYPE MONUMENT P.K. & WASHER
 ON SURFACE - BELOW
 LEFT - & PAV'T. - RIGHT 2.5'
 TO EDGE PAVEMENT
 S.L.M. 1.0659

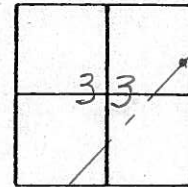


P.I.
56+27.80
P.K. & WASHER ATOP SAME
ATOP BOAT SPIKE & WASHER

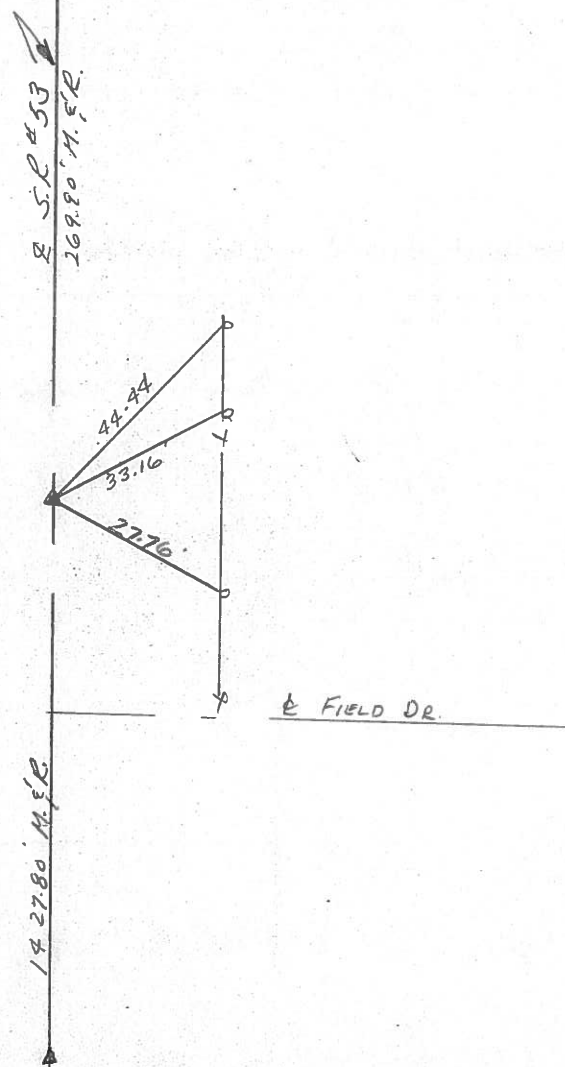

| PERSONNEL | TITLE | PERSONNEL | TITLE |
|-----------|-------|-----------|-------|
| Cronin | | Schneider | |
| Ripple | | Messer | |
| Geyman | | Barbour | |

COUNTY Seneca DATE 12/8/75
 S. R. 53 WEATHER sunny
 SEC. I.C.H #266 "F" TEMP. 36°
Field Bk # 23

DESCRIPTION Ties for Control Points JOB NO. _____

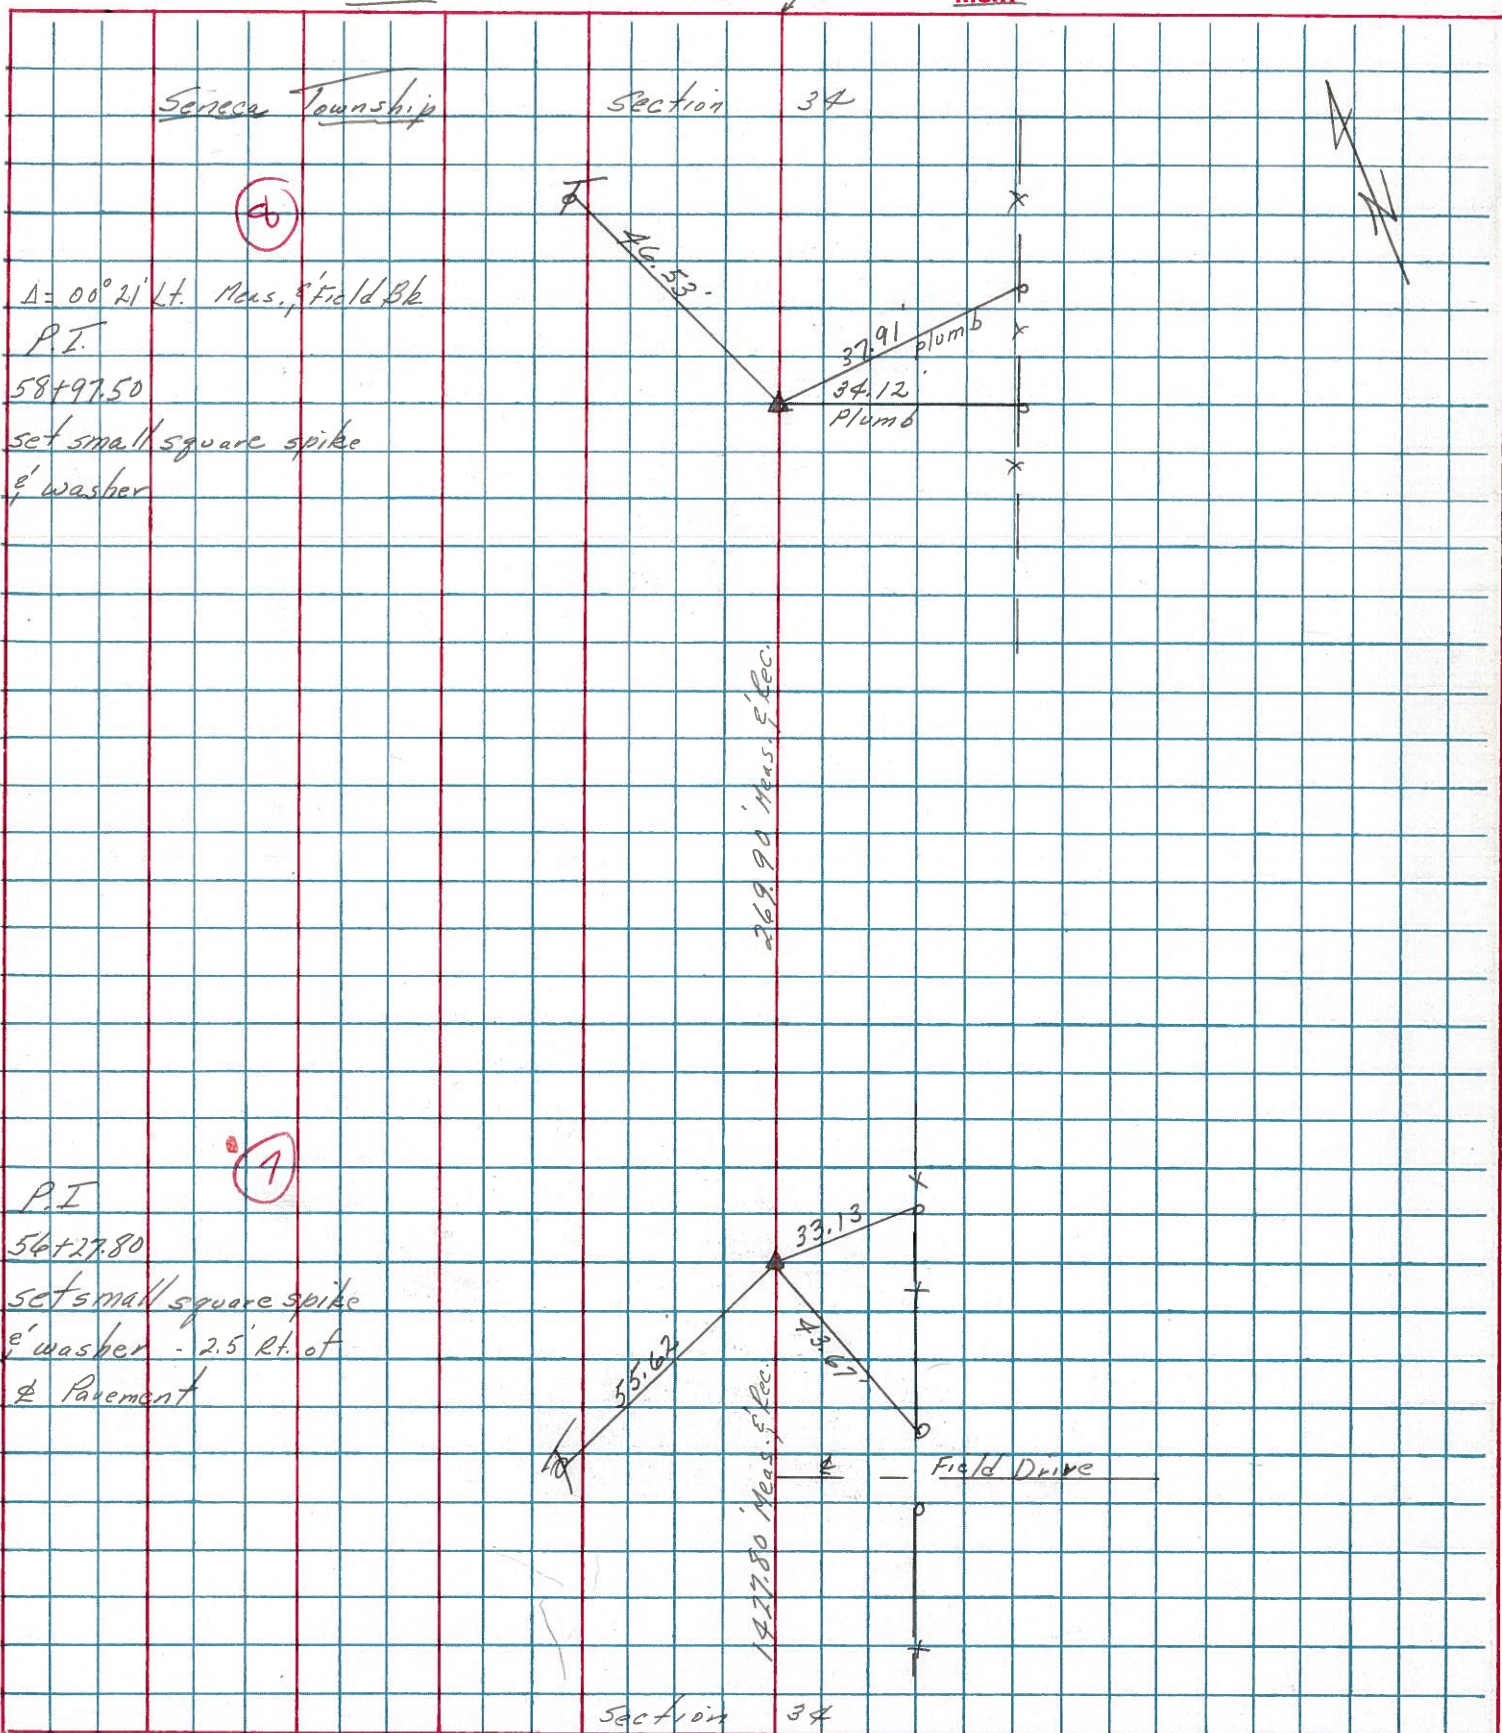

PERSONNEL TITLE PERSONNEL TITLE


COUNTY Seneca DATE 1-17-63

S. R. # 53 WEATHER

SEC. 01d 53 TEMP.

DESCRIPTION LEFT CENTER LINE RIGHT JOB NO.

STA. 78+00
R.R. SPIKE on E. of R/W
#117

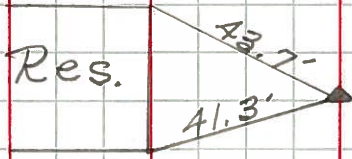

STA. 71+20.5
#116




STA. 63+31.5
#115



STA. 56+17.6
#114



STA. 48+16.3
R.R. SPIKE on E.
#113

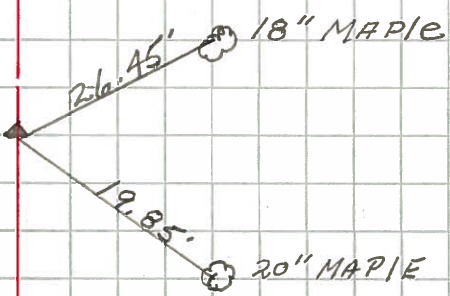

STA. 40+00
R.R. SPIKE on E. R/W
#112

