



O.D.O.T. DISTRICT 2 SURVEY OFFICE (USE ONLY)

PERSONNEL _____ REFERENCE NO. 10 SHEET 10 OF 41
 NOTES RHOADES DATE 4/26/17 ROUTE SR 53
 H.C. O'DONNELL WEATHER SUNNY COUNTY SENECA
 R.C. RHOADES TEMP. 64° TOWNSHIP SENECA
 _____ SECTION 27
 _____ T 1 N R 14 E

TYPE MONUMENT P.K./WASHER
 ON SURFACE - ~~BELOW~~ ON _____
 LEFT - ☉ PAV'T - RIGHT ON _____
9.2' TO RT EDGE PAVEMENT
 S.L.M. 71+19.49
 Grid: Northing: 489720.964 Easting: 1763436.659

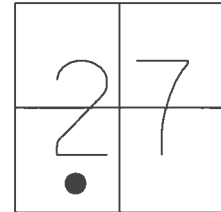

RECORD: P.I.
 STA. 71+23.80
 P.K./WASHER ATOP
 BOAT SPIKE/WASHER
 FD P.K./WASHER
 2" DOWN
 6/24/97, MC
 SET P.K./WASHER
 10/6/97, MC
 FD P.K./WASHER
 REF10
 6/2/16, JFO
 SET MAG/WASHER
 NEWREF10
 9/5/17, JFO

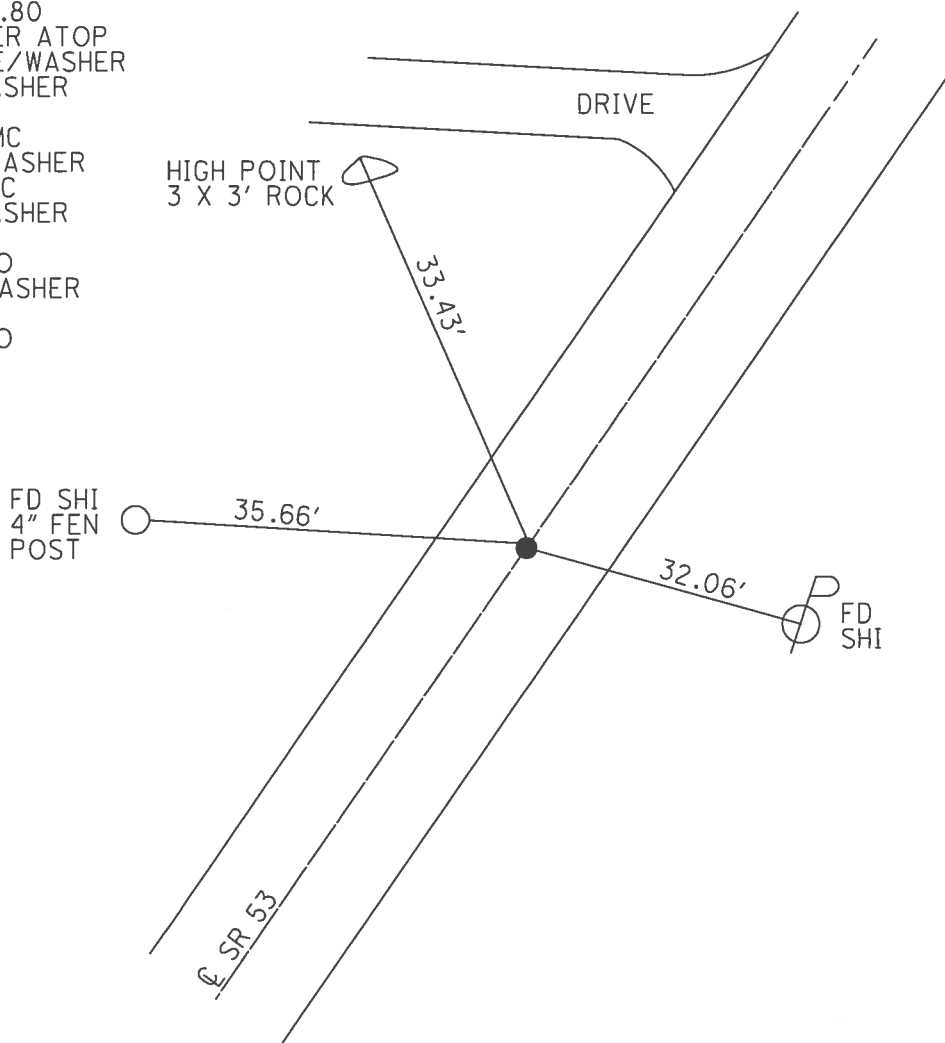

O.D.O.T. DISTRICT 2 SURVEY OFFICE

PERSONNEL

REFERENCE NO. 10

SHEET 10 OF 34

NOTES Carterbury

H.C. Rousos

R.C. Carterbury

W. WEAVER

ROUSOS - DRAWING

DATE 6/24/99

WEATHER Sunny

TEMP. +90°

ROUTE #53

COUNTY SENECA

TOWNSHIP SENECA

SECTION 29

T. 1 N. R. 14 E.


TYPE MONUMENT P.K. # WASHER

~~ON SURFACE~~ - BELOW 2" BELOW

~~LEFT - & PAV'T. - RIGHT~~ ON &


9.2' TO RT EDGE PAVEMENT

S.L.M. Z + 178.05 SLK

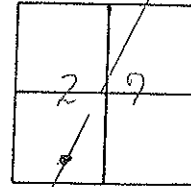

RESET P.K. # WASHER
10/6/99
ARC

RECORD:
P.K.
71-23.80
P.K. # WASHER AT OP BOAT
SPIRE & WASHER

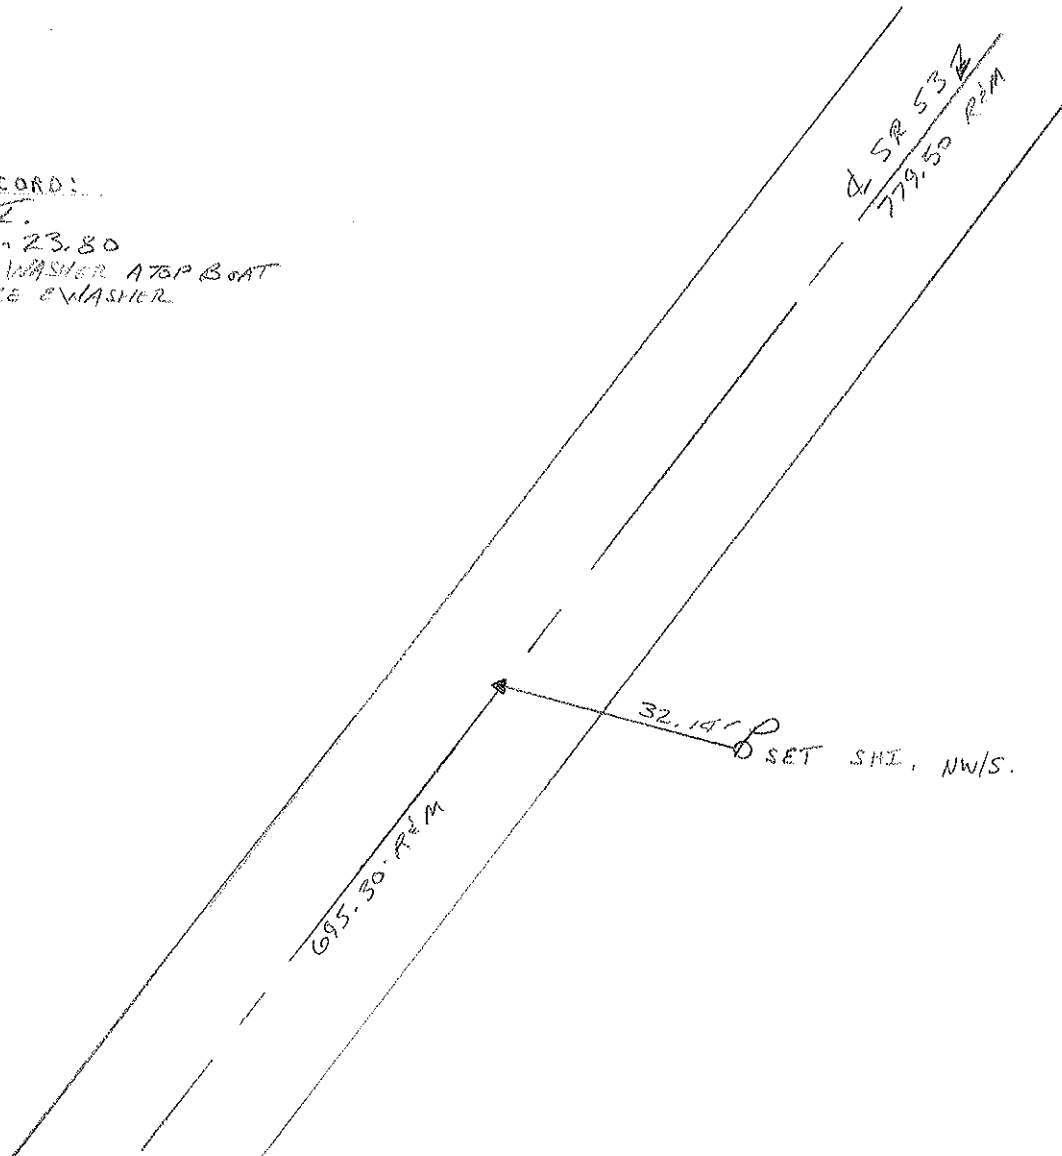

O.D.O.T. DISTRICT 2 SURVEY OFFICE

PERSONNEL

REFERENCE NO. 10

SHEET 10 OF

NOTES CROWIN

DRAWN 10/27/89

H.C. RIPPLE

DATE 8/30/88

ROUTE # 53

R.C. BARBOUR

WEATHER SUNNY

COUNTY SENECA

GEYMAN

TEMP. 70°

TOWNSHIP SENECA

SECTION 27

T 1 N R 14E


TYPE MONUMENT P.K. & WASHER

ON SURFACE - BELOW 2"

LEFT - ☉ PAV'T. - RIGHT

TO EDGE PAVEMENT

S.L.M. 1.3492

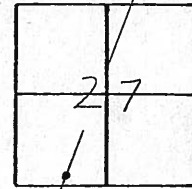

P.I.
91+23.80
P.K. WASHER ATOP BOAT
SPIKE & WASHER

sign post
 0.6' up


59.12'

2 S.R. 053
 779.50' R.F.M.

32.74' PLUMB
 33.26' S. LINE

52.90'

695.30' R.F.M.

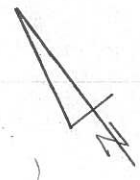

PERSONNEL	TITLE	PERSONNEL	TITLE
Cronin		Schneider	
Ripple		Mosser	
Geyman		Barbour	

COUNTY Seneca

DATE 12/8/75

S. R. #53


WEATHER Sunny

SEC. I.C.H. #266 "F"
Field Bb #23

TEMP. 36°

DESCRIPTION Ties for Control Point

JOB NO.

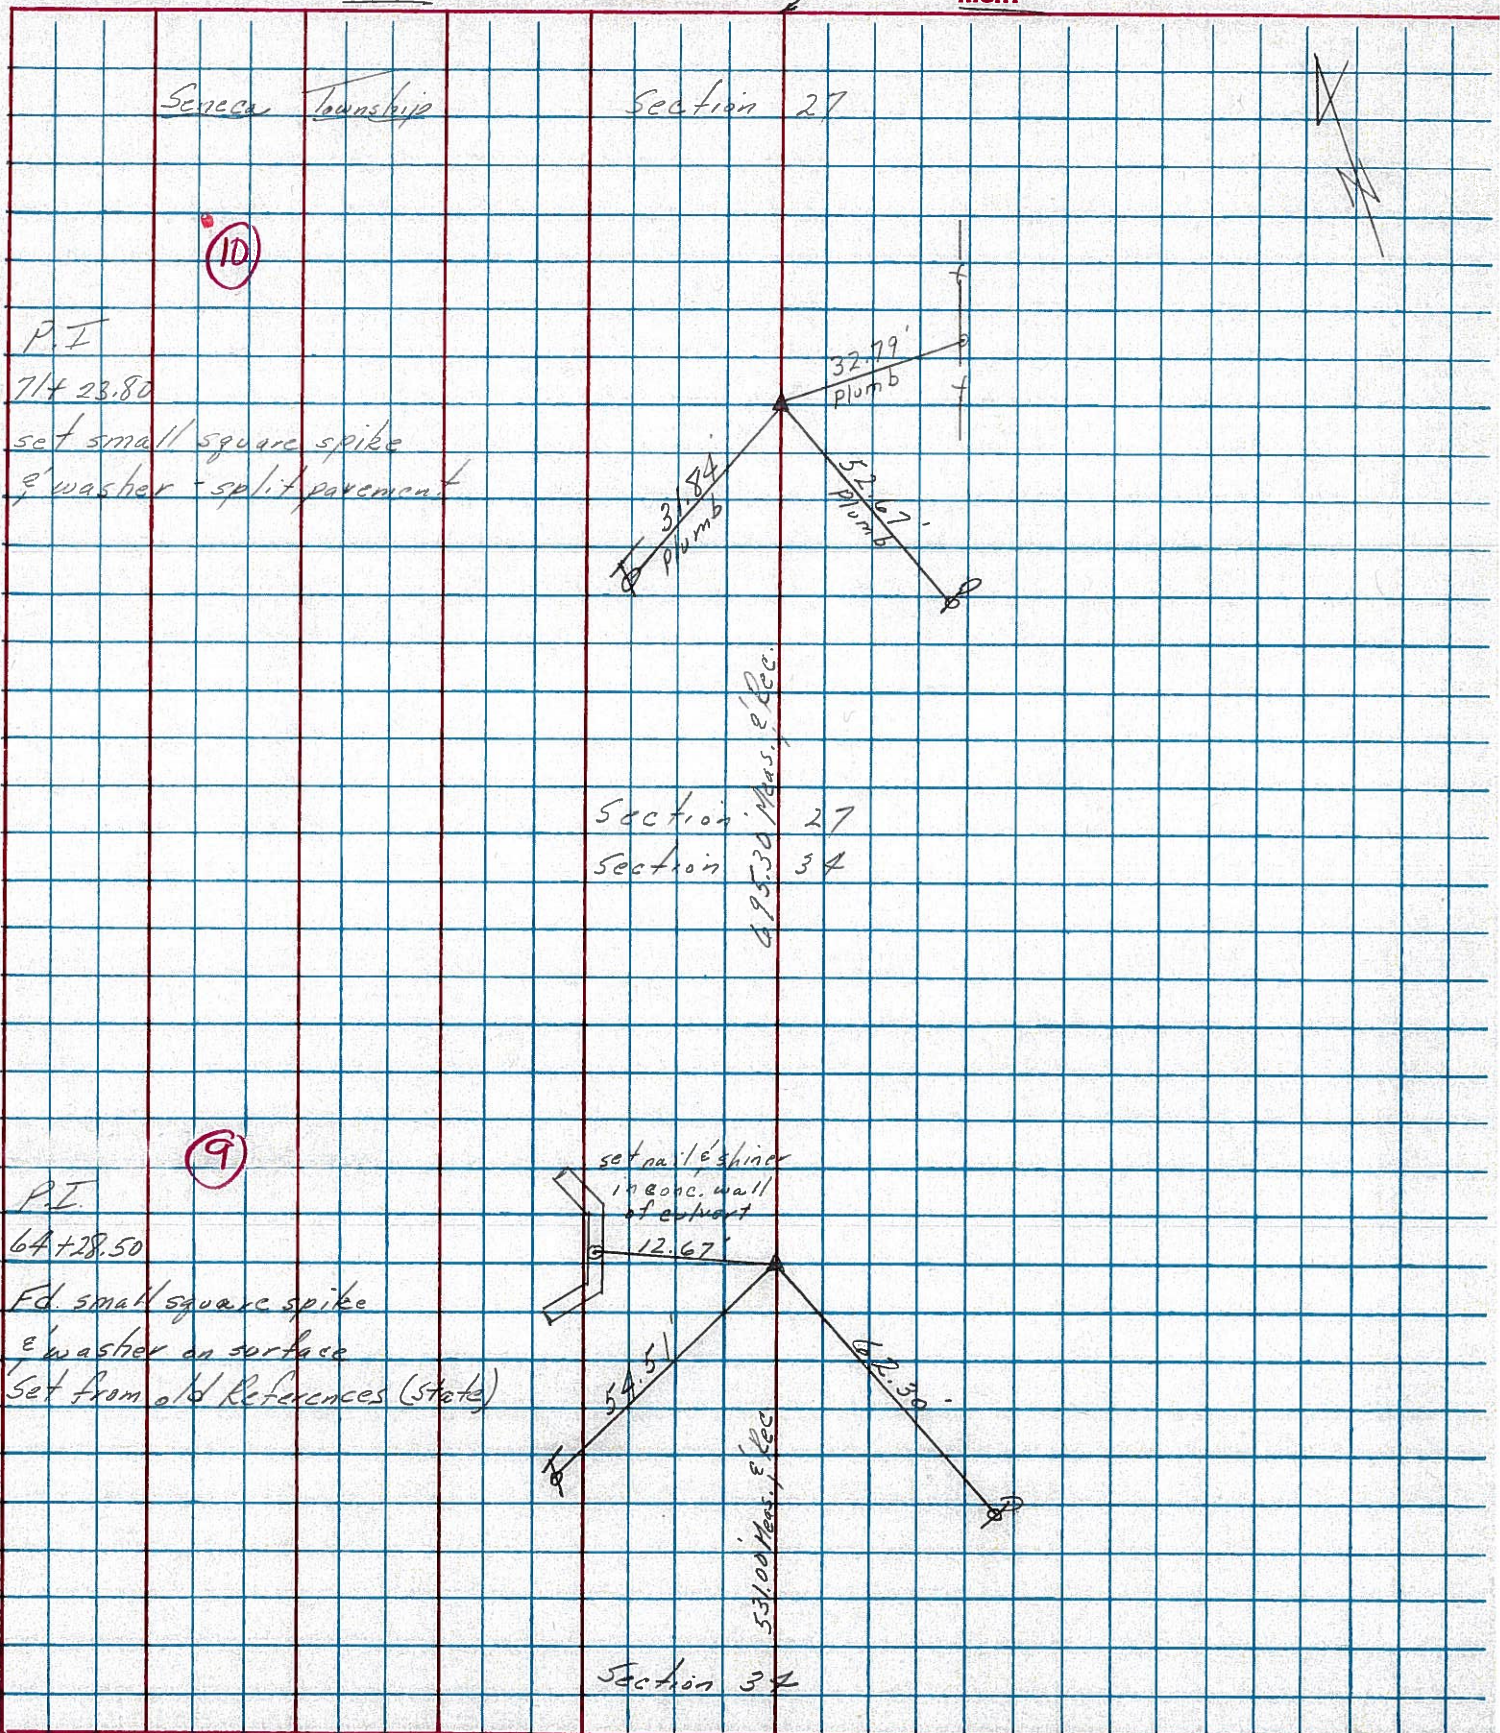

PERSONNEL TITLE PERSONNEL TITLE


COUNTY Seneca DATE 1-17-63

S. R. # 53 WEATHER

SEC. 01d 53 TEMP.

DESCRIPTION LEFT CENTER LINE RIGHT JOB NO.

STA. 78+00
R.R. SPIKE on E. of R/W
#117

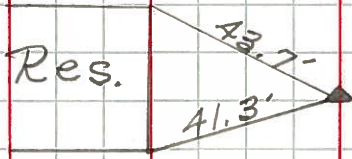

STA. 71+20.5
#116




STA. 63+31.5
#115



STA. 56+17.6
#114



STA. 48+16.3
R.R. SPIKE on E.
#113

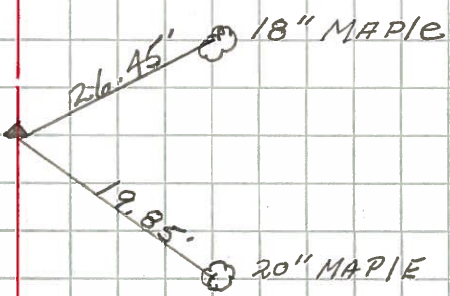

STA. 40+00
R.R. SPIKE on E. R/W
#112

