

O.D.O.T. DISTRICT 2 SURVEY OFFICE (USE ONLY)

PERSONNEL _____ REFERENCE NO. 24 A SHEET 29 OF 41

NOTES RHOADES DATE 4/25/17 ROUTE SR 53
 H.C. O'DONNELL WEATHER CLOUDY COUNTY SENECA
 R.C. RHOADES TEMP. 57° TOWNSHIP SENECA
 _____ SECTION 2
 _____ T 1 N R 14 E

TYPE MONUMENT P.K./WASHER


~~ON SURFACE~~ - BELOW 3"

~~LEFT~~ - Q PAV'T - RIGHT 0.7'

9.8' TO RT EDGE PAVEMENT


S.L.M. 291+28.33

Grid: Northing: 510253.111 Easting: 1771327.400

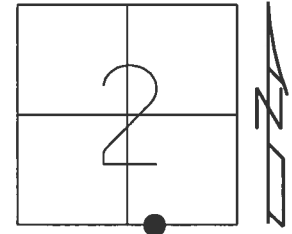

RECORD:
 COUNTY POINT
 P.K./WASHER ATOP
 P.K./WASHER ATOP
 R.R.SPIKE
 FD P.K./WASHER
 7/2/97, MC
 SET P.K./WASHER
 10/16/97, MC
 FD P.K./WASHER
 3" DOWN
 REFA24
 5/3/16, JFO
 SET MAG/WASHER
 NEWREFA24
 8/31/17, JFO

FD SHI
 6' UP
 36" LOCUST

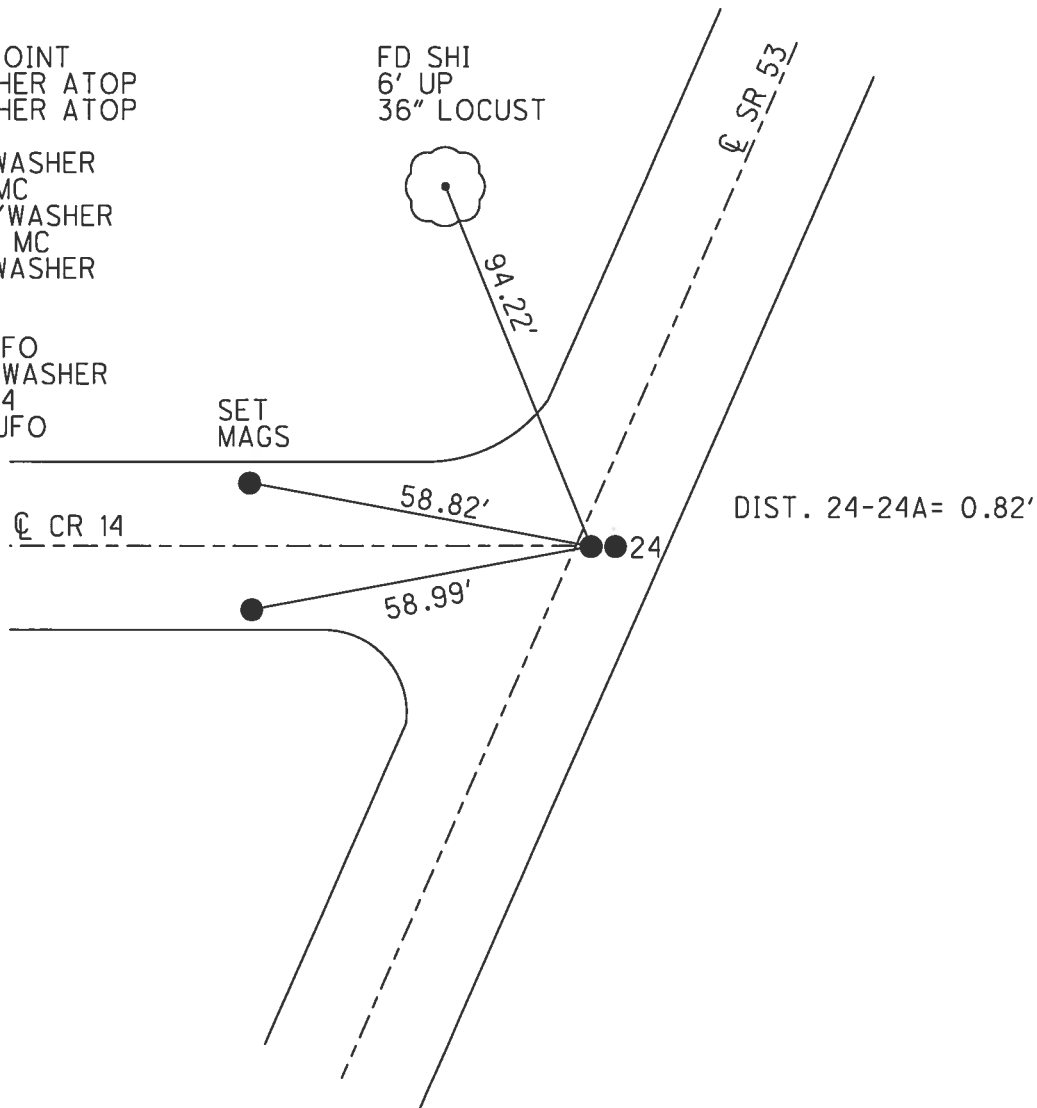

O.D.O.T. DISTRICT 2 SURVEY OFFICE

PERSONNEL

REFERENCE NO. 24

SHEET 24 OF 34

NOTES Canterbury

H.C. Branham

R.C. WEAVER

Rousos - DRAWING

DATE 7/2/97

WEATHER SUNNY

TEMP. +75°

ROUTE 53

COUNTY SENECA

TOWNSHIP SENECA

SECTION 2

T. 1 N. R. 14 E.


TYPE MONUMENT P.K. WASHER (Both)

ON SURFACE - BELOW SURFACE

LEFT = C. PAV'T. - RIGHT A: 15' RT & / B: 0.7 RT &

A 9.0 TO RT EDGE PAVEMENT


B 9.8 TO RT S.L.M. A 8+910.36 SLK / B 8+910.36 SLK

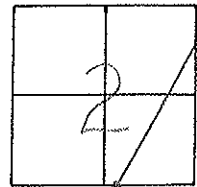

RESET P.K. WASHER @ BOTH PTS
 10/16/99
 M. R. C.

0+55±
 PK/WASHER ATOP
 SAME ATOP SAME
 CO. POINT = PK/WASHER
 ATOP SAME ATOP RR SPIKE

CUT NOTCH
 IN 'STOP' SIGN POST
 YUP

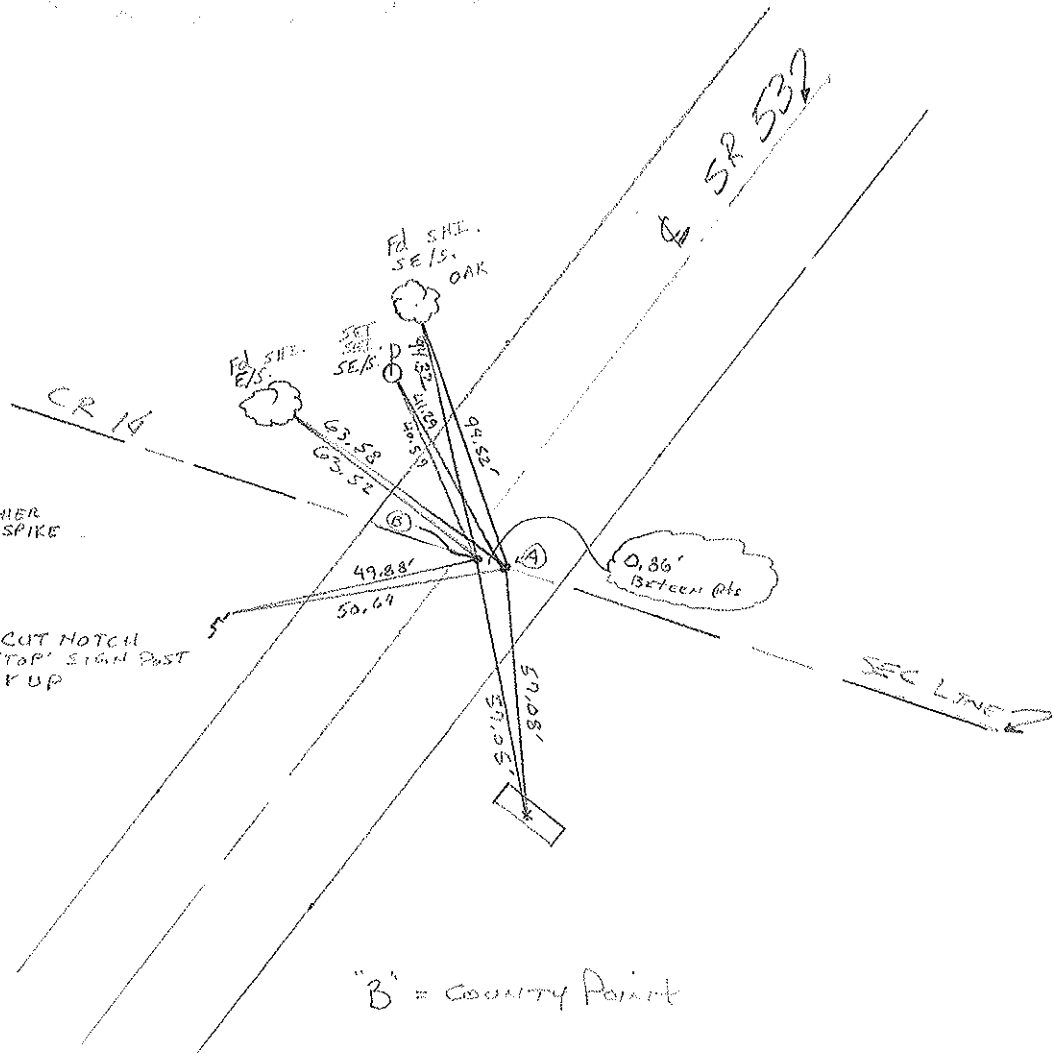

"B" = COUNTY POINT

O.D.O.T. DISTRICT 2 SURVEY OFFICE

PERSONNEL

REFERENCE NO. 24

SHEET 24 OF

NOTES Cronin (Draw)

DRAWN 11/08/89

H.G. RIPPLE

DATE 12/8/89

R.G. BARBOUR WORK

WEATHER SUNNY

GEYMAN

TEMP. 27°

ROUTE # 53

COUNTY SENECA

TOWNSHIP SENECA

SECTION 2

T 1 N R 14 E


TYPE MONUMENT P.K. Washer

ON SURFACE - BELOW SURFACE


LEFT - CL PAV'T. - RIGHT 1/2" ON E

 TO EDGE PAVEMENT

S.L.M. 5.5188

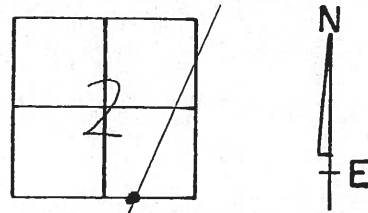

24-A

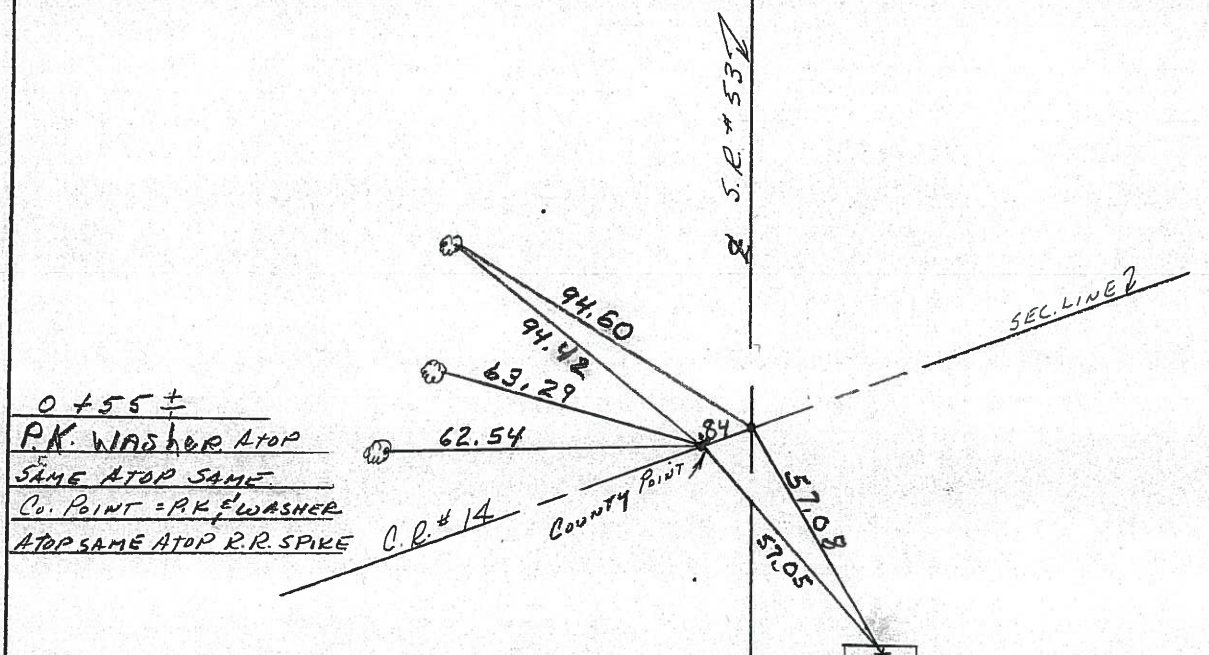

0 + 55 ±
P.K. WASHER ATOP
SAME ATOP SAME
Co. POINT = P.K. WASHER
ATOP SAME ATOP R.R. SPIKE

0 + 00 - Co. Rd. # 6
139 + 12.85 MEAS.
139 + 21 REC. END SEC. 'G'
0 + 00 Start SEC. 'A-2'

County Seneca S.R. 53

Date 8/10/82

Township Seneca

Weather sunny

Section 2

Temp. 65°

T/N, R/E

Personnel Cronin


Ripple

Geyman

Mosser

Barbour


~~#24~~

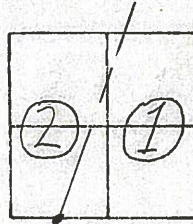

24-A



0+55 ±
set P.K.s, & washers atop
C.R. spike & P.K. washer

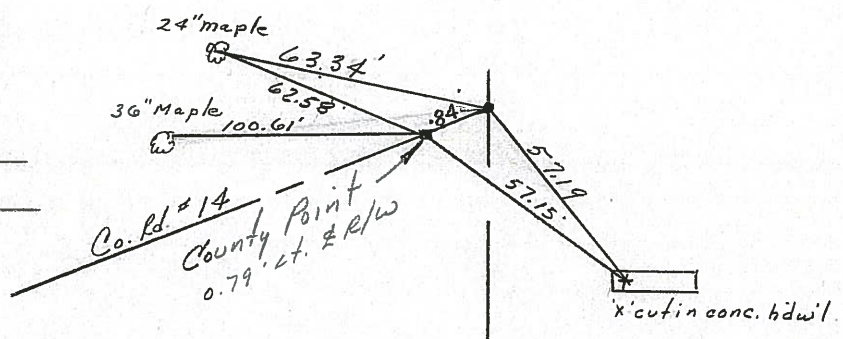

139+12.85 Meas
139+21 Rec END Sec. G =
0+00 start Sec. A-2

R/R/W S.R. # 53P