


O.D.O.T. DISTRICT 2 SURVEY OFFICE (USE ONLY)


PERSONNEL _____ REFERENCE NO. 28 SHEET 33 OF 41
 NOTES RHOADES DATE 4/20/17 ROUTE SR 53
 H.C. O'DONNELL WEATHER WINDY COUNTY SENECA
 R.C. RHOADES TEMP. 71° TOWNSHIP SENECA
 _____ SECTION 1
 _____ T 1 N R 14 E

TYPE MONUMENT P.K./WASHER
 ON SURFACE - ~~BELOW~~ ON _____
~~LEFT~~ - ☉ PAV'T - RIGHT 1.6'
8.7' TO RT EDGE PAVEMENT
 S.L.M. 349+09.04

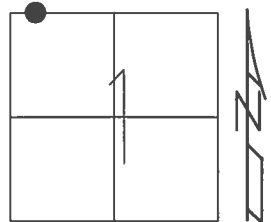

Grid: Northing: 515665.666 Easting: 1773357.236

RECORD: P.I.
 $\Delta = 02^{\circ}03' \text{ LT}$
 STA. 58+35
 P.K./WASHER ATOP
 P.K./WASHER ATOP
 BOAT SPIKE/WASHER
 FD P.K./WASHER
 7/2/97, MC
 SET P.K./WASHER
 10/16/97, MC
 FD P.K./WASHER
 REF28
 4/29/16, JFO
 SET MAG/WASHER
 NEWREF28
 9/7/17, JFO

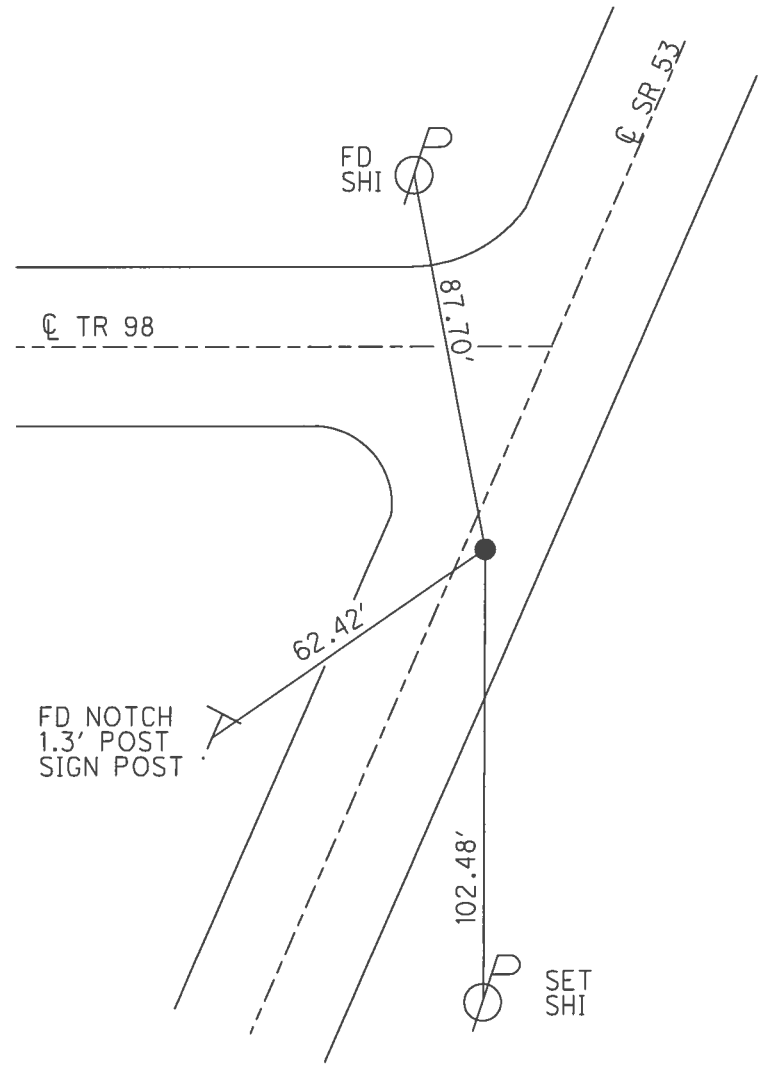

O.D.O.T. DISTRICT 2 SURVEY OFFICE

PERSONNEL

REFERENCE NO. 28

SHEET 28 OF 34

NOTES CANTERBURY

H.C. BARNHISEL

R.C. WEAVER

DATE 7/2/97

WEATHER SUN

TEMP. +78° F

ROUTE # 53

COUNTY SENECA

TOWNSHIP SENECA

SECTION 1

T L N R 14 E


TYPE MONUMENT P.K. + WASHER

ON SURFACE - BELOW SURFACE

LEFT - CL PAV'T. - RIGHT 1.6 RT 4


8.7 TO RT EDGE PAVEMENT

S.L.M. 10 + 678.35

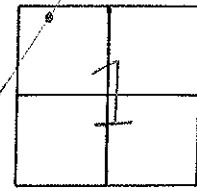

RESET P.K. + WASHER
 10/16/97
 M.R.C.

RECORD: P.I. STA 58+35
 $\Delta = 02^{\circ} 03' \text{ LT R. \& M.}$
 P.K. WASHER ATOP SAME
 ATOP BOAT SPR. + WASHER

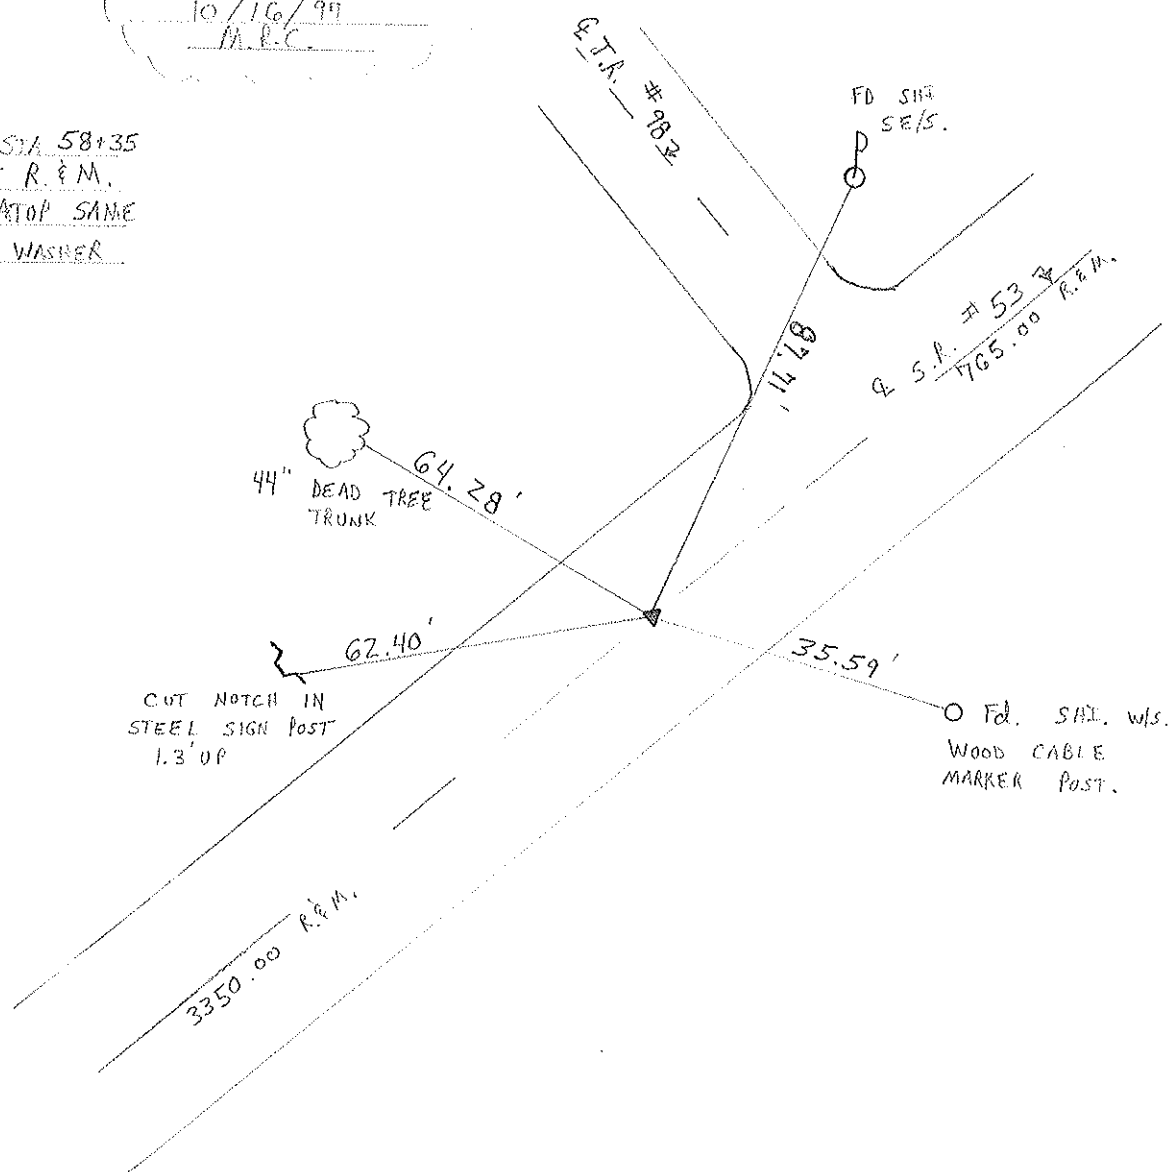

O.D.O.T. DISTRICT 2 SURVEY OFFICE


PERSONNEL

NOTES CRONIN (Draw)
 H.C. RIPPLE
 R.C. BARBOUR (WORK)
GEYMAN


REFERENCE NO. 28
 DRAWN 11/09/89
 DATE 12/8/89
 WEATHER SUNNY
 TEMP. 27°

SHEET 28 OF _____
 ROUTE # 53
 COUNTY SENECA
 TOWNSHIP SENECA
 SECTION 1
 T 1 N R 14 E

TYPE MONUMENT P.K. Washer
 ON SURFACE - BELOW SURFACE
 LEFT - ¢ PAV'T. - RIGHT 1 1/2' RT. ¢
 TO EDGE PAVEMENT
 S.L.M. 6.6129

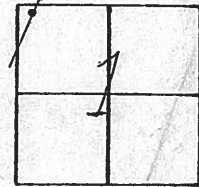

A=02°03' Lt. R. & M.
P.I.
58+35
P.K. WASHER 1 1/2' RT.
ATOP SAME ATOP BOAT
SPIKE & WASHER

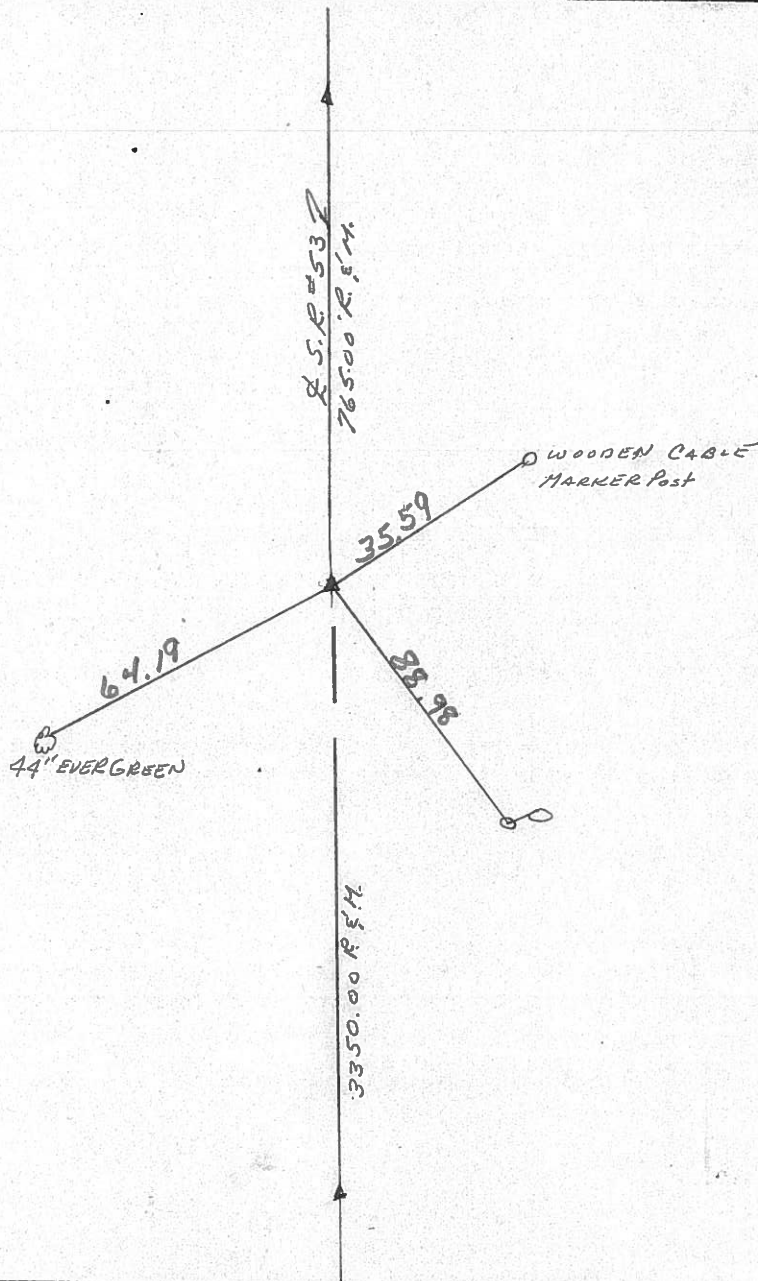

Q.D.O.T. DISTRICT 2 SURVEY OFFICE

Sht. of

County Seneca S.R. # 53

Date 8/10/82

Township Seneca

Weather sunny

Section 2

Temp. 60°

T/N, R/E

Personnel Cronin


Ripple

Geyman

Mosser

Barbour

#28

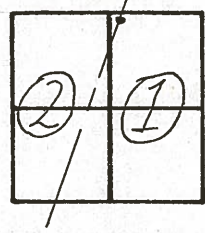


$\Delta = 02^{\circ}03'$ Lt. Plan. & Meas
P.I.

58+35

set P.K., & washer atop boat

spike, & washer 1.4' Pl. & Paint.

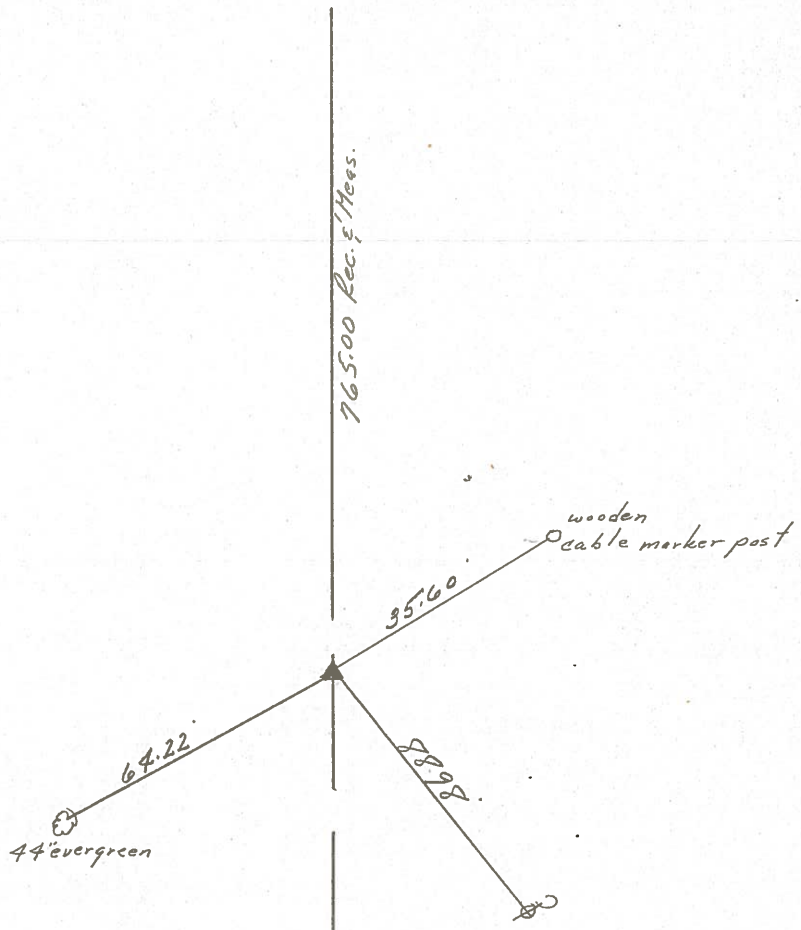

S.R./W S.R.#53
3335.00 Rec. & Meas.

