


O.D.O.T. DISTRICT 2 SURVEY OFFICE (USE ONLY)

PERSONNEL _____ REFERENCE NO. 32 A SHEET 40 OF 47
 NOTES ASTON DATE 9/8/23 ROUTE SR 53
 H.C. NIESE WEATHER DRIZZLE COUNTY SENECA
 R.C. RHOADES TEMP. 66° TOWNSHIP HOPEWELL
 SECTION 25
 DWG BY RHOADES PID R/W T 2 N R 14 E

TYPE MONUMENT MONBOX W/1" IPIN
 ON SURFACE - BELOW ON
 OFFSET $\text{\textcircled{C}}$ PAVEMENT ON LT : RT
- TO - EDGE PAVEMENT
 STATION: 412+54.75

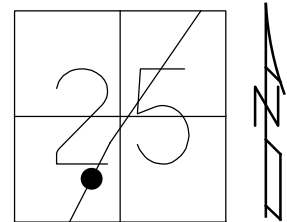


HORZ.DATUM: NAD83 2011 GEOID: NAVD88 2018
 GRID: NORTHING: 521703.132 EASTING: 1775288.480

RECORD: P.I.
 P.K./WASHER
 FD R.R.SPIKE
 3" DOWN
 11/8/91, CHENCY
 SET MAG/WASHER
 8/17/04, MB
 FD P.K./WASHER
 REFA32
 4/29/16, JFO
 FD MONBOX
 W/1" IPIN
 REF32A
 9/8/23, TDN

NOTE: REF 41 SEN 224


SENECA LPD:
 N: 290379.981
 E: 149975.670

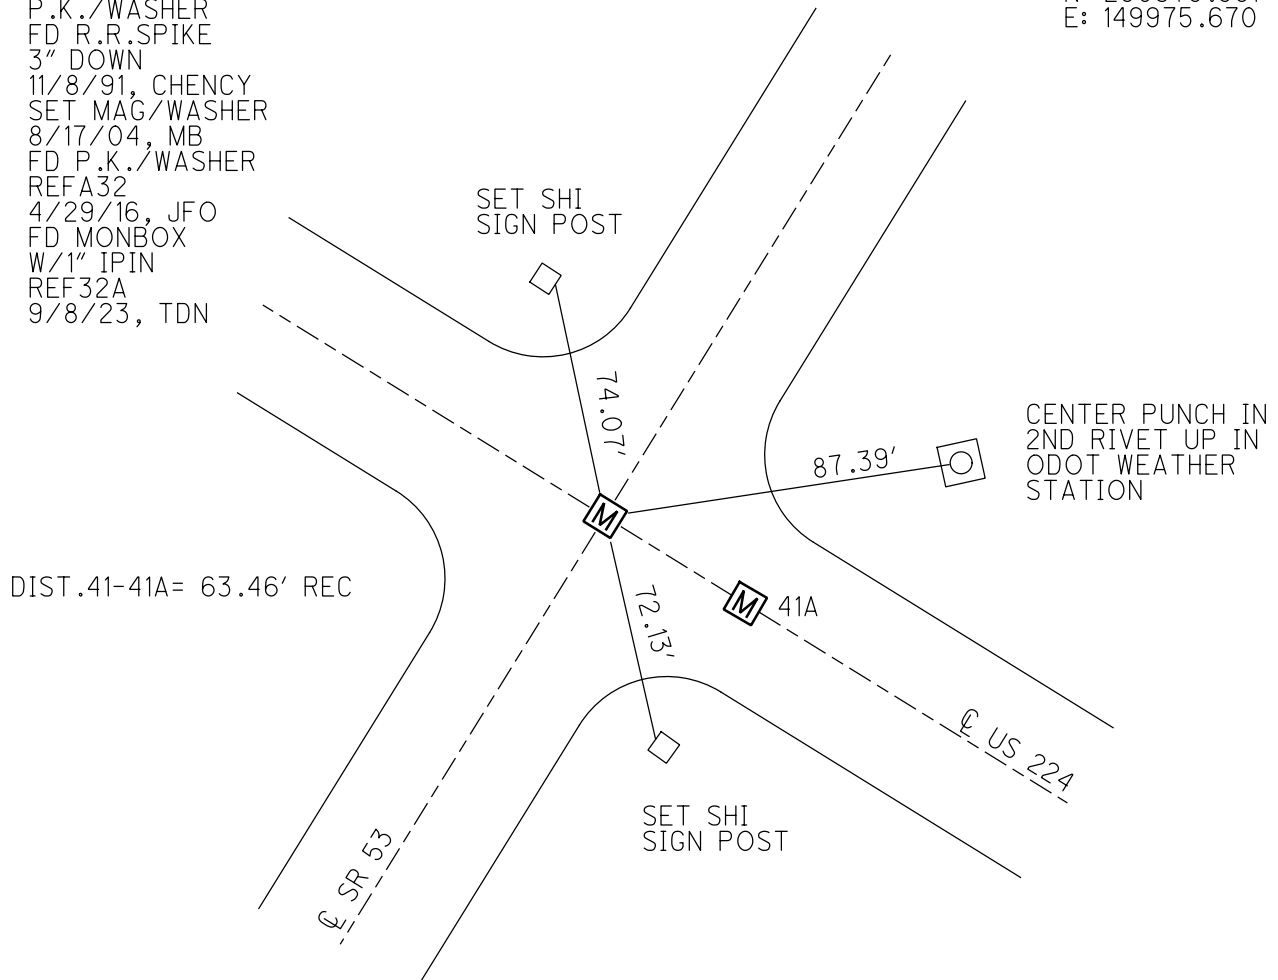

O.D.O.T. DISTRICT 2 SURVEY OFFICE (USE ONLY)

PERSONNEL _____ REFERENCE NO. 32 A SHEET 38 OF 41
 NOTES NUHFER DATE 4/26/04 ROUTE SR 53
 H.C. HOOKE WEATHER SUNNY COUNTY SENECA
 R.C. HOMAN TEMP. 50° TOWNSHIP HOPEWELL
HUSS SECTION 25
ARMS T 2 N R 14 E


TYPE MONUMENT P.K./WASHER
 ON SURFACE - ~~BELOW~~ ON _____
 LEFT - ☉ PAV'T - RIGHT ON _____
 - TO - EDGE PAVEMENT
 S.L.M. 412+54.75

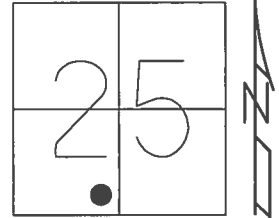

Grid: Northing: 521703.132 Easting: 1775288.480

RECORD: P.I.
 P.K./WASHER
 ON SURFACE
 FD R.R. SPIKE
 3" DOWN
 11/8/91, CHENCY
 SET MAG/WASHER
 8/17/04, MB
 FD P.K./WASHER
 REFA32
 4/29/16, JFO

NOTE:
 REF 41 SEN 224
 STA.632+98

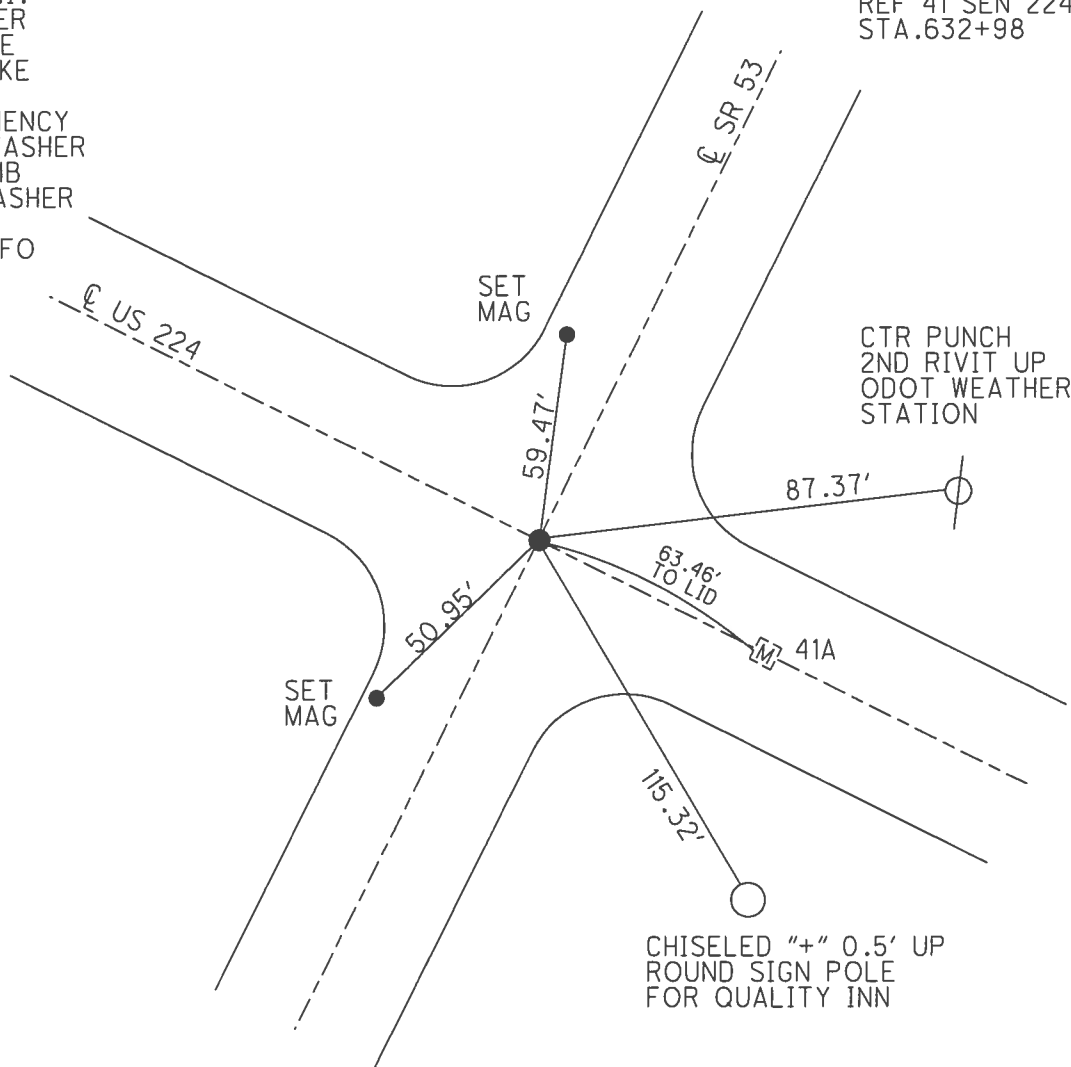

O.D.O.T. DISTRICT 2 SURVEY OFFICE

PERSONNEL

REFERENCE NO. 41


SHEET OF

NOTES R. Cheney
 H.C. R. BARBOUR
 R.C. J. Rippe
R. Geyman

DATE 11-8-91
 WEATHER SUNNY
 TEMP. 20°

ROUTE 224
 COUNTY Seneca
 TOWNSHIP Hope wull
 SECTION 25
T2 N R 14 E

TYPE MONUMENT P.K. + Washer
 ON SURFACE - BELOW R.R. Spt. 2" Down
~~BEFORE~~ - PAV'T. - FRONT
TO EDGE PAVEMENT
 S.L.M. 632+98

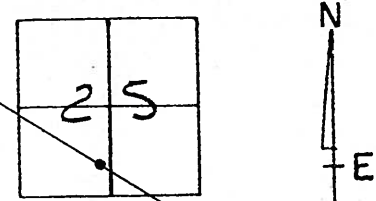

PI Intersection
SR. 53 + 224

32-A

