

O.D.O.T. DISTRICT 2 SURVEY OFFICE (USE ONLY)

PERSONNEL

REFERENCE NO. 34 A

SHEET 41 OF 47

NOTES RHOADES

DATE 4/29/16

ROUTE SR 53

H.C. O'DONNELL

WEATHER CLOUDY

COUNTY SENECA

R.C. RHOADES

TEMP. 58°

TOWNSHIP HOPEWELL

SECTION 25

DWG BY WHITAKER

PID 95778

T 2 N R 14 E

TYPE MONUMENT SM.MARKER SPIKE

ON SURFACE - ~~BELOW~~ ON

OFFSET 0 PAVEMENT ON LT : RT

- TO - EDGE PAVEMENT


STATION: 434+38.10

HORZ.DATUM: NAD83 2011


GEOID: NAVD88 2012A

GRID: NORTHING: 523574.306

EASTING: 1776402.723

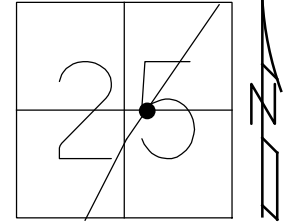

RECORD:  
D.N.F  
REFA34  
4/17/19, JFO

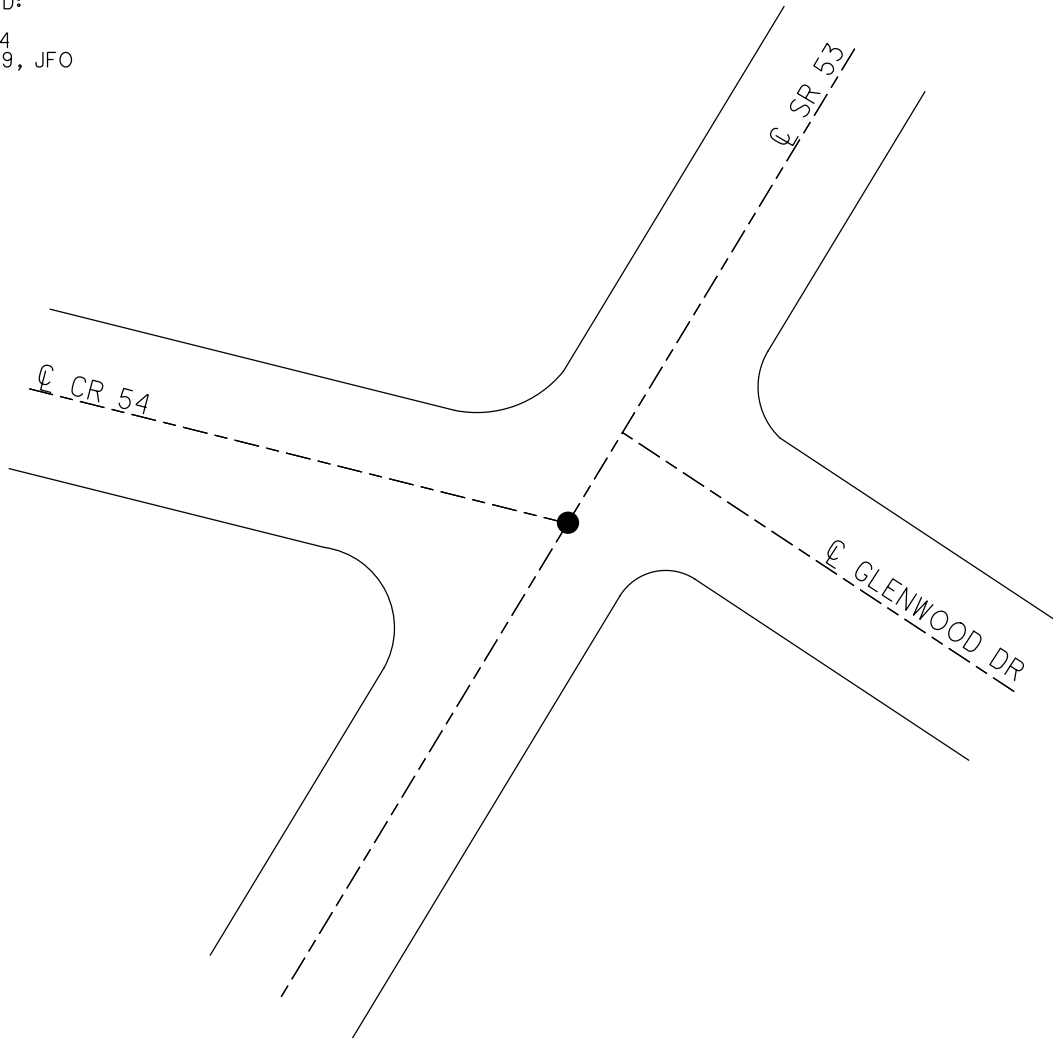



O.D.O.T. DISTRICT 2 SURVEY OFFICE (USE ONLY)

PERSONNEL \_\_\_\_\_ REFERENCE NO. 34 A SHEET 41 OF 41

NOTES RHOADES DATE 4/29/16 ROUTE SR 53  
H.C. O'DONNELL WEATHER CLOUDY COUNTY SENECA  
R.C. RHOADES TEMP. 58° TOWNSHIP HOPEWELL  
SECTION 25  
T 2 N R 14 E

TYPE MONUMENT SM.MARKER SPIKE  
ON SURFACE - ~~BELOW~~ ON  
LEFT - ☉ PAV'T - RIGHT ON  
- TO - EDGE PAVEMENT  
S.L.M. 434+38.13

Grid: Northing: 523574.306 Easting: 1776402.723

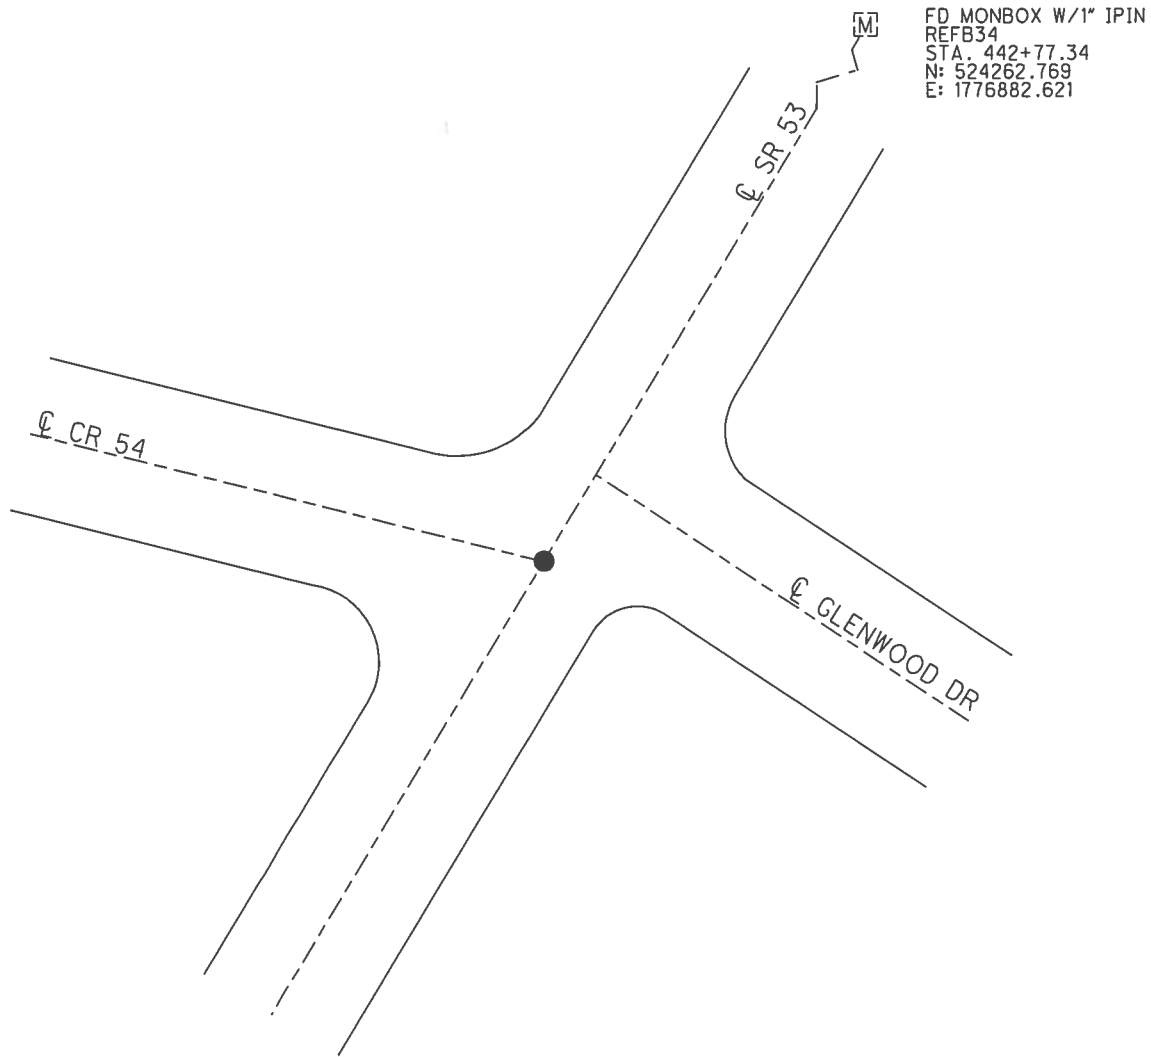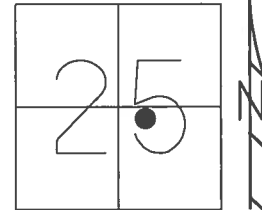

FD MONBOX W/1" IPIN  
REFB34  
STA. 442+77.34  
N: 524262.769  
E: 1776882.621