


O.D.O.T. DISTRICT 2 SURVEY OFFICE (USE ONLY)

PERSONNEL _____ REFERENCE NO. 51 SHEET 2 OF 5

NOTES HOMAN DATE 10/19/16 ROUTE SR 53
 H.C. LEU WEATHER SUNNY COUNTY SENECA
 R.C. LEU TEMP. 50° TOWNSHIP CLINTON


DWG BY RHOADES PID 95268 SECTION 19
 T 2 N R 15 E

TYPE MONUMENT MONBOX W/ IPIN
 ON SURFACE - ~~BELOW~~ ON
 OFFSET \odot PAVEMENT ON LT : RT
- TO - EDGE PAVEMENT
 STATION: 514+89.53

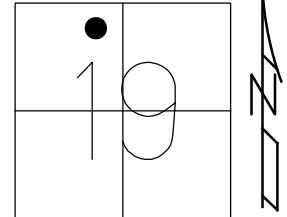

HORIZ.DATUM: NAD83 2011 GEOID: NAVD88 2012A
 GRID: NORTHING: 530422.928 EASTING: 1780578.696


RECORD:
 STA. 514+89.53
 FD MONBOX
 W/ IPIN
 CP8
 10/19/16, DCH
 REF51
 4/17/19, JFO

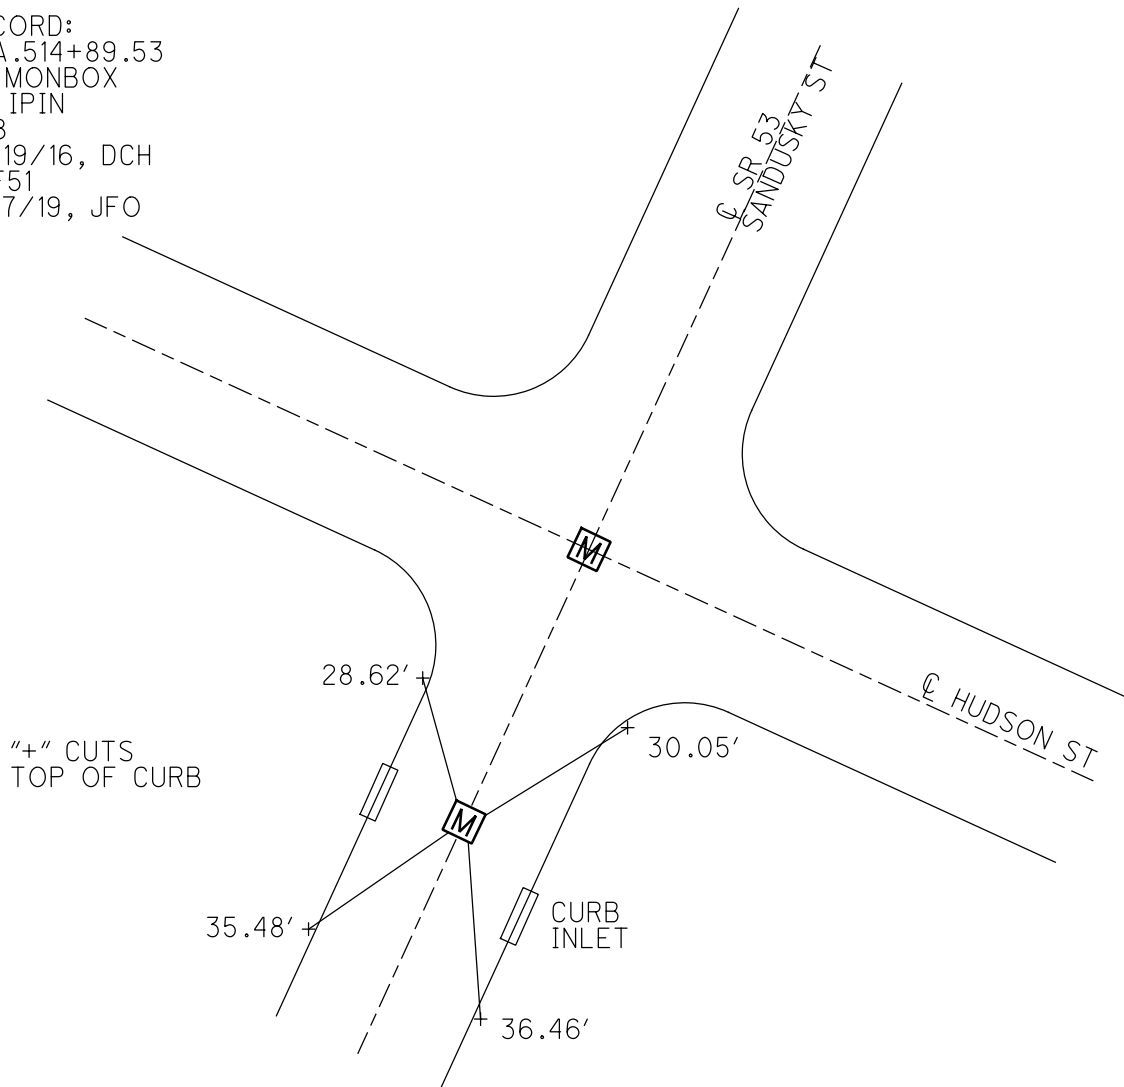

O.D.O.T. DISTRICT 2 SURVEY OFFICE (USE ONLY)

PERSONNEL _____ REFERENCE NO. 51 SHEET 2 OF 5
 NOTES HOMAN DATE 10/19/16 ROUTE SR 53
 H.C. LEU WEATHER SUNNY COUNTY SENECA
 R.C. LEU TEMP. 50° TOWNSHIP CLINTON
 DWG BY RHOADES PID 95268 SECTION 19
 T 2 N R 15 E

TYPE MONUMENT MONBOX W/ IPIN
 ON SURFACE - ~~BELOW~~ ON
 OFFSET ☐ PAVEMENT ON _____ LT : RT
 _____ TO _____ EDGE PAVEMENT
 STATION: 514+89.53

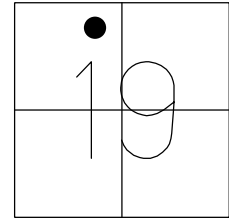

HORIZ.DATUM: _____ GEOID: _____
 GRID: NORTHING: 530422.928 EASTING: 1780578.696

RECORD:
 STA. 514+89.53
 FD MONBOX
 W/ IPIN
 CP8
 10/19/16, DCH

