



O.D.O.T. DISTRICT 2 SURVEY OFFICE (USE ONLY)

PERSONNEL _____ REFERENCE NO. 57 A SHEET 3 OF 26
NOTES MOSE DATE 6/14/11 ROUTE SR 53
H.C. LUMBREZER WEATHER CLOUDY COUNTY SENECA
R.C. HARBAUGH TEMP. 70° TOWNSHIP CLINTON
SECTION 7
T 2 N R 15 E

TYPE MONUMENT P.K./WASHER
ON SURFACE - ~~BELOW~~ ON _____
LEFT - Q PAV'T - RIGHT ON _____
12' TO RT EDGE PAVEMENT
S.L.M. 610+42.78

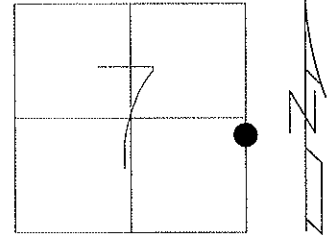

Grid: Northing: 539065.9260 Easting: 1784265.7100

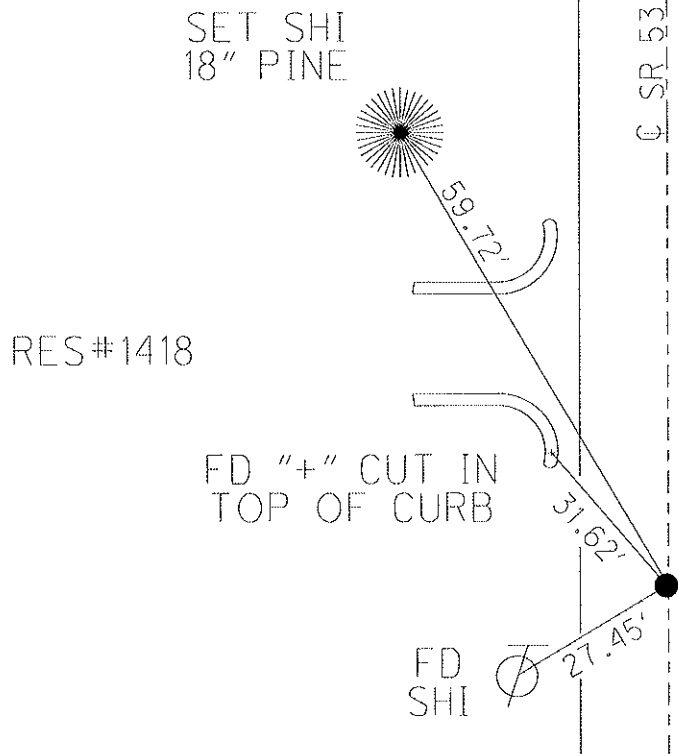

P.K. ATOP SM.SPIKE
BELOW P.K./WASHER

FD P.K./WASHER
GPS, SV126
6/15/10, JMH

RESET MAG/WASHER
9/28/11, RJL

NEW NORTH
TIFFIN CORP.

O.D.O.T. DISTRICT 2 SURVEY OFFICE

PERSONNEL

REFERENCE NO. 57-A

SHEET 4 OF 21

NOTES Cronin

H.C. Barbour

R.C. Geyman

DATE 6/30/88

WEATHER sunny

TEMP. 60°

ROUTE #53

COUNTY Seneca

TOWNSHIP Clinton

SECTION _____

T 2 N R 15 E



TYPE MONUMENT P.K. & washer

ON SURFACE - BELOW _____

LEFT - ☉ PAV'T. - RIGHT _____

TO _____ EDGE PAVEMENT

S.L.M. _____

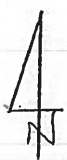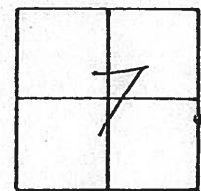

P.K. atop small spike
below P.K. & washer

