



O.D.O.T. DISTRICT 2 SURVEY OFFICE (USE ONLY)

PERSONNEL	REFERENCE NO. <u>60</u>	SHEET <u>6</u> OF <u>26</u>
NOTES <u>MOSE</u>	DATE <u>6/14/11</u>	ROUTE <u>SR 53</u>
H.C. <u>LUMBREZER</u>	WEATHER <u>CLOUDY</u>	COUNTY <u>SENECA</u>
R.C. <u>HARBAUGH</u>	TEMP. <u>70°</u>	TOWNSHIP <u>CLINTON</u>
		SECTION <u>6</u>
		T <u>2</u> N R <u>15</u> E

TYPE MONUMENT P.K./WASHER
 ON SURFACE - ~~BELOW~~ ON
 LEFT - CL PAV'T - RIGHT 0.7'
12.6' TO RT EDGE PAVEMENT
 S.L.M. 669+39.84
 Grid: Northing: 544960.7712 Easting: 1784427.0923

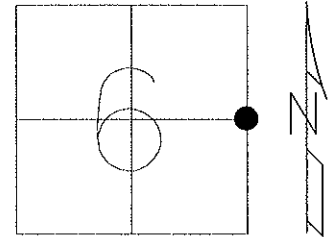

P.K. ATOP R.R. SPIKE
 BELOW SURFACE
 FD P.K./WASHER
 GPS, SV104
 5/26/10, KPM
 RESET MAG/WASHER
 9/28/11, RJL

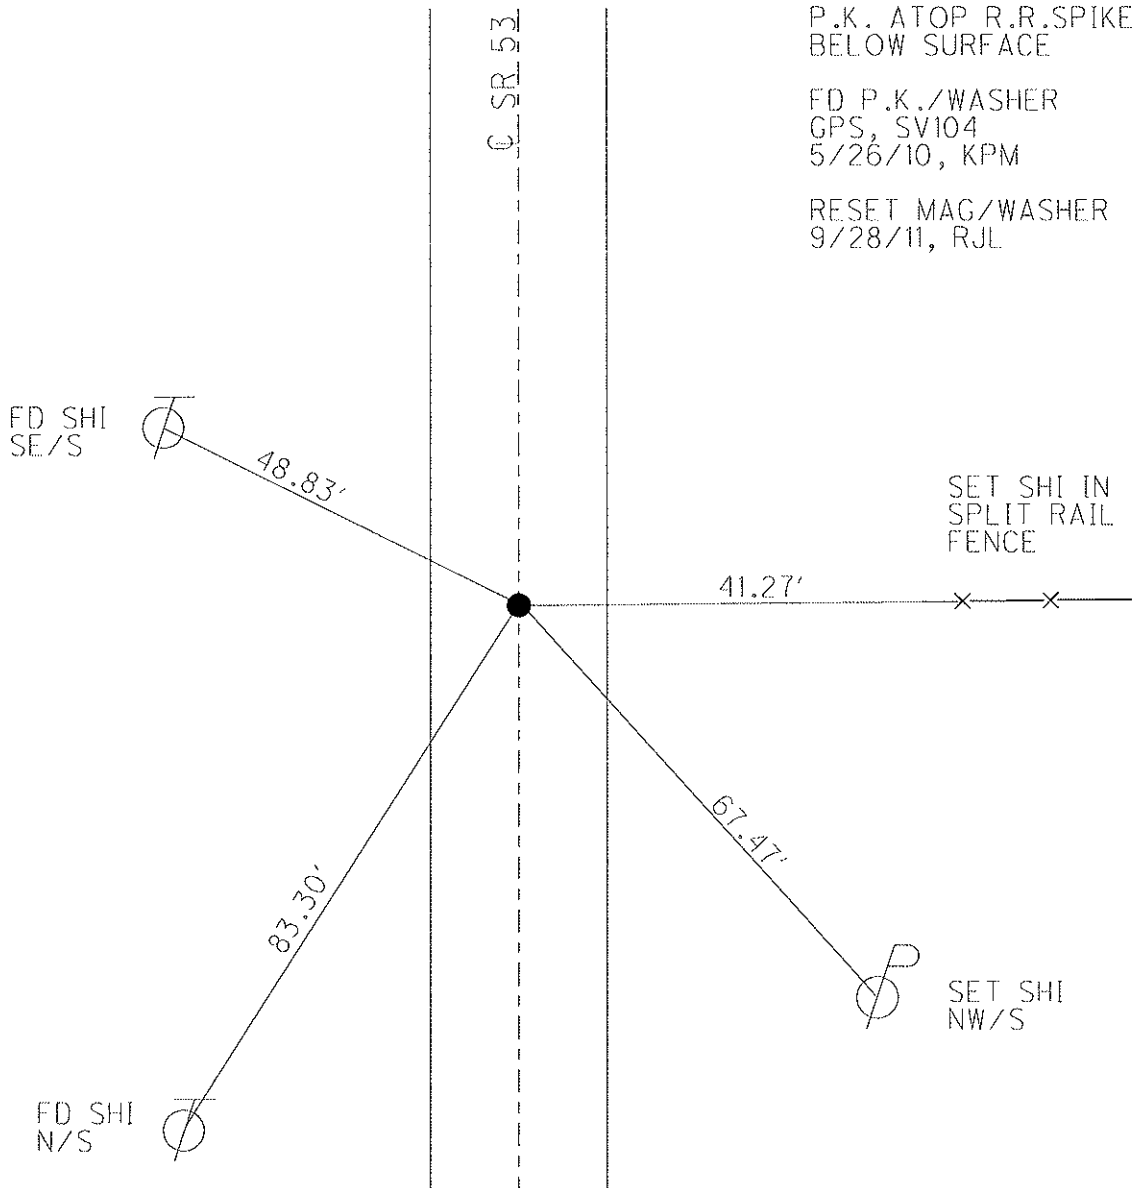

O.D.O.T. DISTRICT 2 SURVEY OFFICE

PERSONNEL _____

REFERENCE NO. 7

SHEET 7 OF 21

NOTES Cronin

H.C. Barbour

R.C. Geyman

DATE 6/30/88

WEATHER sunny

TEMP. 60°

ROUTE #53

COUNTY Seneca

TOWNSHIP Clinton

SECTION 6

T 2 N R 15 E

TYPE MONUMENT P.K. & washer


ON SURFACE - BELOW _____

LEFT- & PAV'T. - RIGHT _____


TO _____ EDGE PAVEMENT

S.L.M. sta 669 + 33.75

60

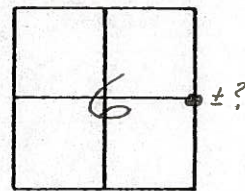

P.K. a top R.R. spike
below surface

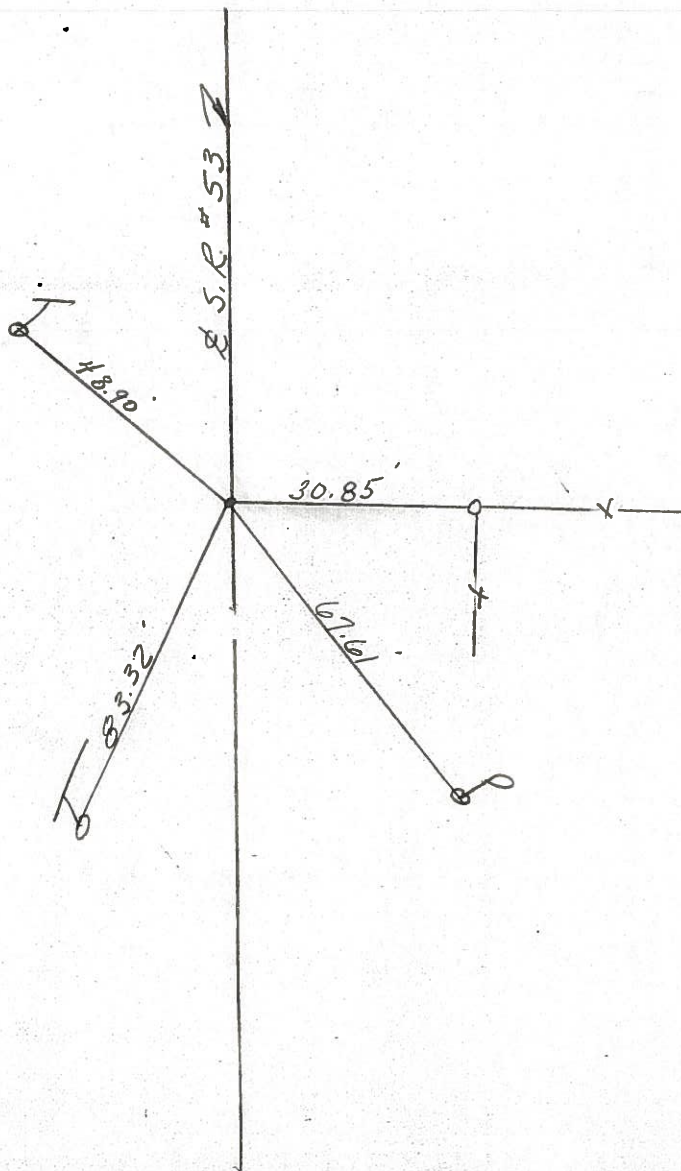

Q.D.O.T. DISTRICT 2 SURVEY OFFICE

Sht. ___ of ___

County Seneca S.R. 53

Date 31 July 80

Township Clinton

Weather Warm

Section 1/4 Cor. 6/5

Temp. 81°


T_N, R_E

Personnel I. Stone


P. Neuser

D. Curtis

R. Michalek

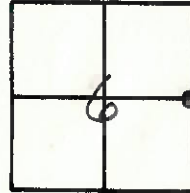

Ref. No. 60

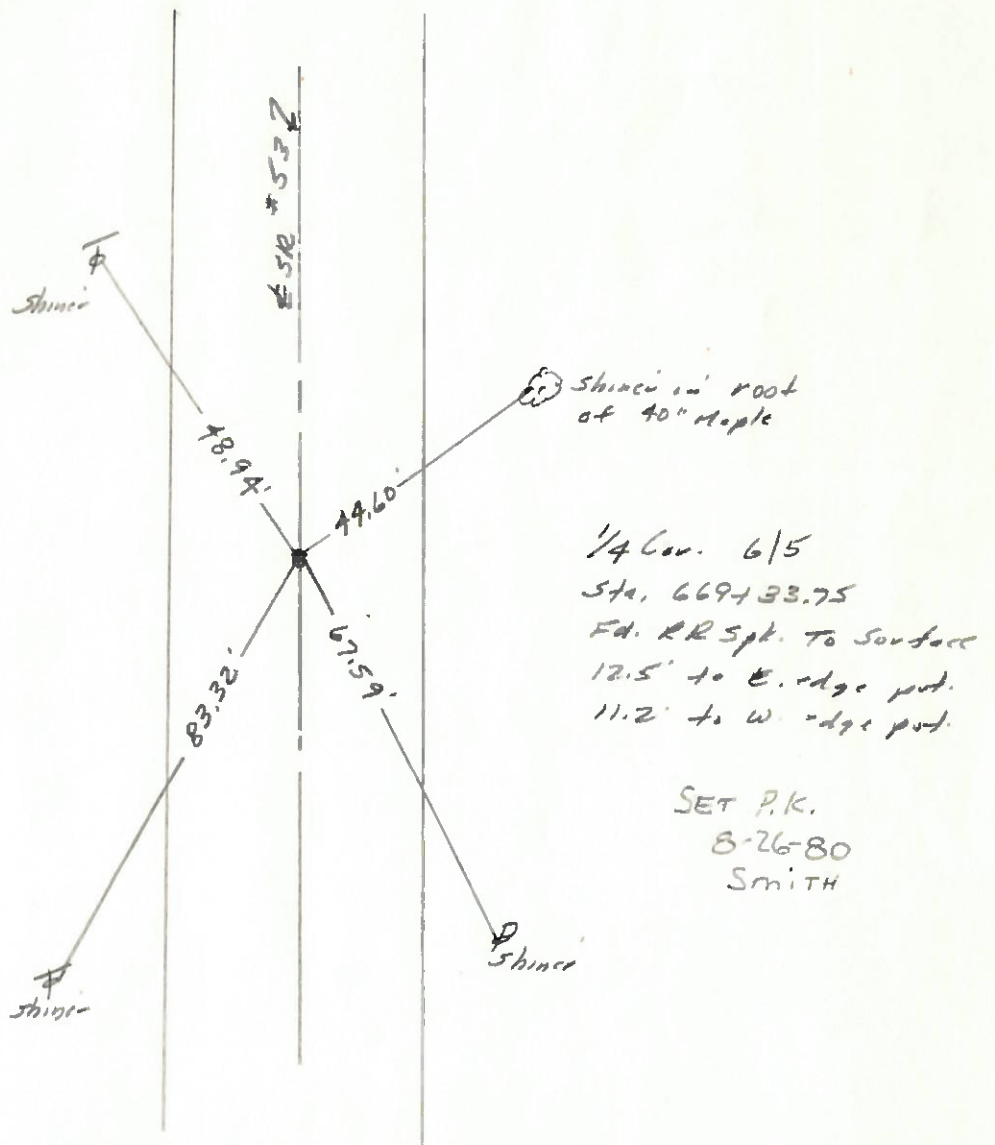

1/4 Cor. 6/5
Sta. 669+33.75
Ed. RR Spt. To Surface
12.5' to E. edge post.
11.2' to W. edge post.

SET P.K.
8-26-80
SMITH

PERSONNEL TITLE PERSONNEL TITLE
 Schneider _____
 Mosser _____
 Barbour _____


COUNTY Seneca DATE 3-20-79
 S. R. 53 WEATHER Fair
 SEC. 1 E 6 TEMP. 55°

DESCRIPTION Tiffin to Sandusky Co. Line JOB NO. _____

LEFT CENTER LINE RIGHT


60

P.I.
 669 + 33.75
 small spk.

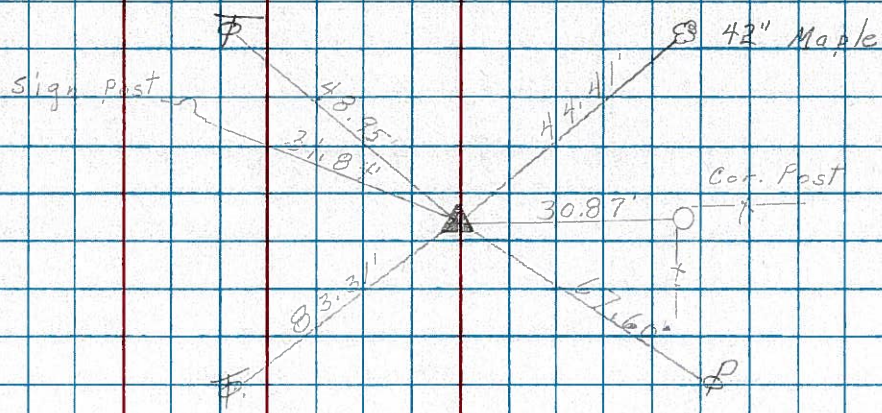


59

P.I.
 642 + 79.25
 small spk.

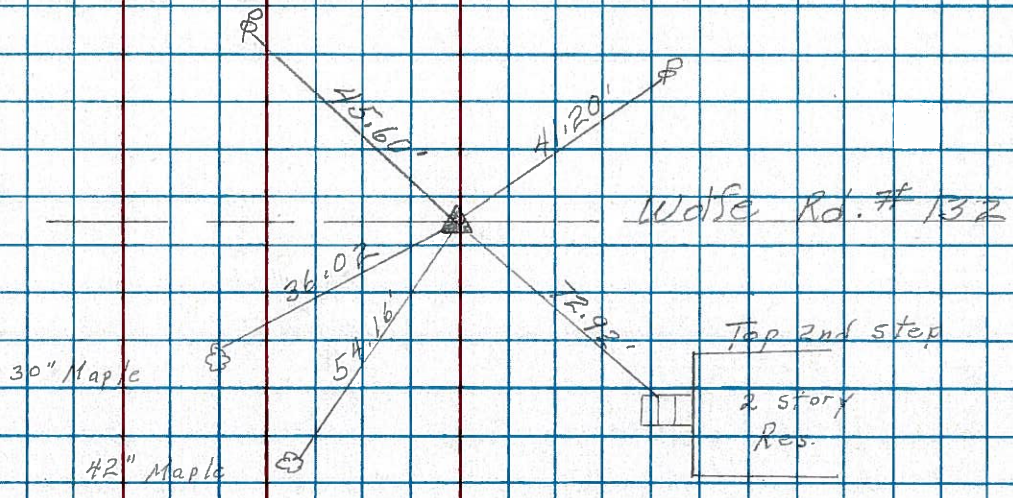

58

P.I.
 616 + 31.69 SAM
 small spk.

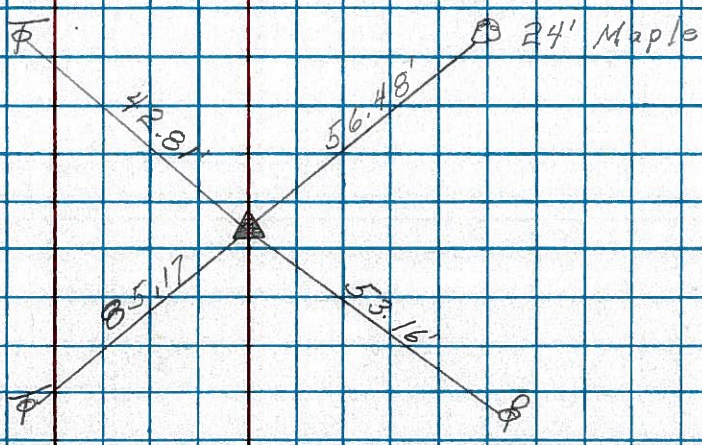


PERSONNEL	TITLE	PERSONNEL	TITLE	COUNTY	DATE
<u>Schneider</u>				<u>Seneca</u>	<u>9-18-69</u>
<u>Mosser</u>				<u>S. R. 53</u>	<u>WEATHER Fair</u>
<u>Barbour</u>				<u>SEC. Tiffin to Sen. Co. Line</u>	<u>TEMP. 60°</u>
<u>Potts</u>					

DESCRIPTION Ties for Control Points LEFT CENTER LINE RIGHT JOB NO.


(61)

695+38.31
small spk.
8376

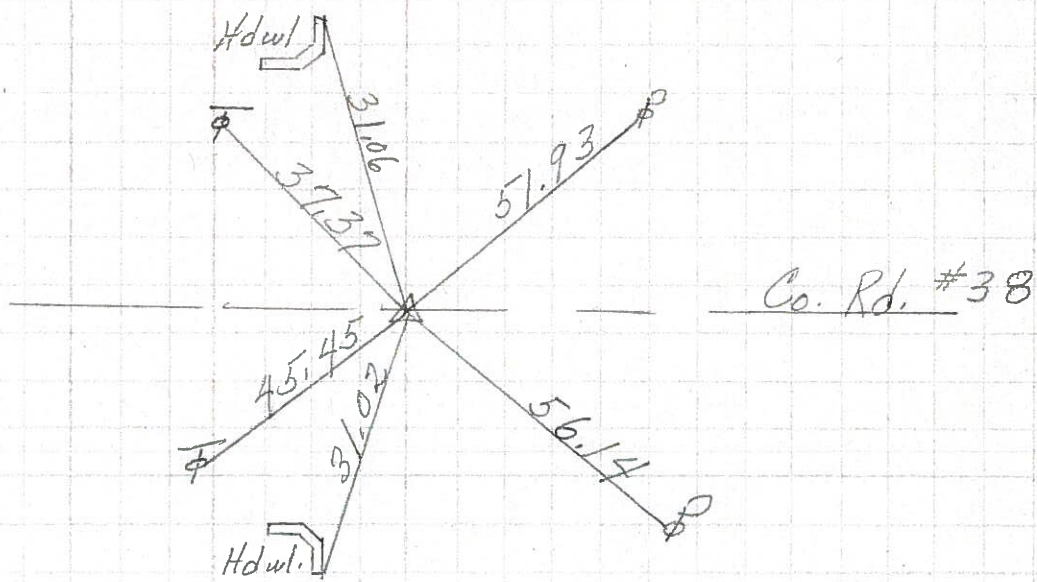


(60)

P.I.
669+33.75
small spk.
8375

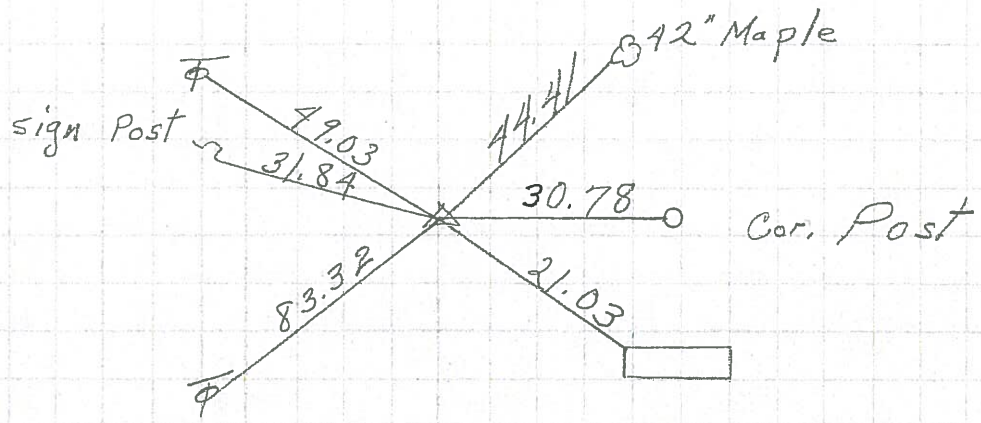

(59)

642+79.65
small spk.
8374

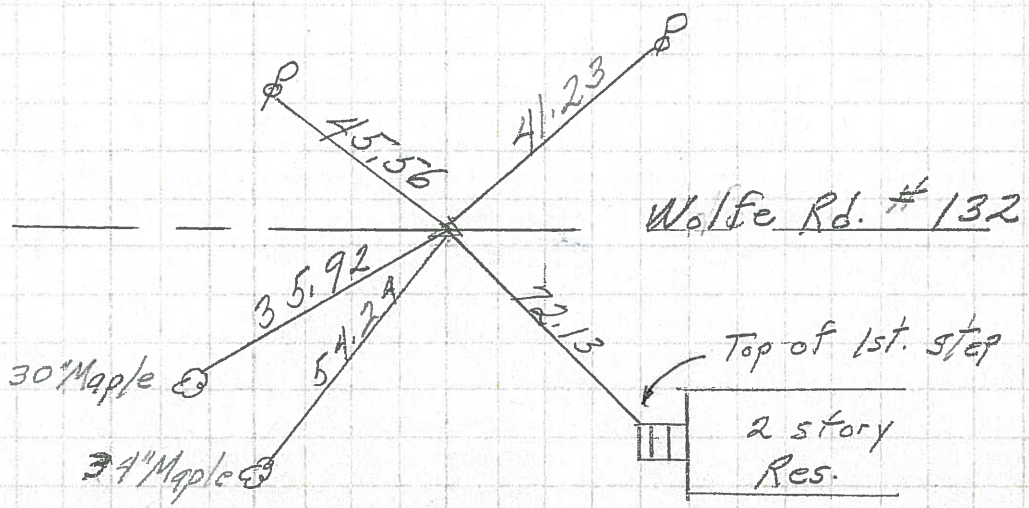

PERSONNEL	TITLE	PERSONNEL	TITLE	COUNTY	DATE
Krabill				Seneca	
Kawaleski				S. R. 53	WEATHER
Geyman				SEC	TEMP.
DESCRIPTION				Clinton Twp	JOB NO.

