


O.D.O.T. DISTRICT 2 SURVEY OFFICE (USE ONLY)

PERSONNEL	REFERENCE NO. <u>61</u>	SHEET <u>7</u> OF <u>26</u>
NOTES <u>MOSER</u>	DATE <u>6/14/11</u>	ROUTE <u>SR 53</u>
H.C. <u>LUMBREZER</u>	WEATHER <u>CLOUDY</u>	COUNTY <u>SENECA</u>
R.C. <u>HARBAUGH</u>	TEMP. <u>70°</u>	TOWNSHIP <u>CLINTON</u>
		SECTION <u>6</u>
		T <u>2</u> N R <u>15</u> E

TYPE MONUMENT R.R.SPIKE
~~ON SURFACE~~ - BELOW 4"
 LEFT - Q PAV'T - RIGHT ON
11.5' TO RT EDGE PAVEMENT
 S.L.M. 695+44.62

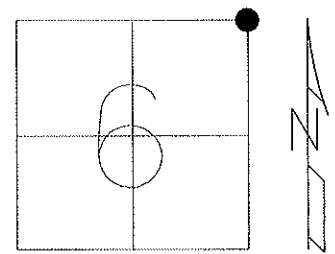


Grid: Northing:547564.6304 Easting:1784496.1979

P.K. ATOP R.R.SPIKE
 BELOW PAV'T

FD R.R.SPIKE
 5/21/10, JMH

GPS, SV105
 5/26/10, KPM

RESET MAG/WASHER
 9/28/11, RJL

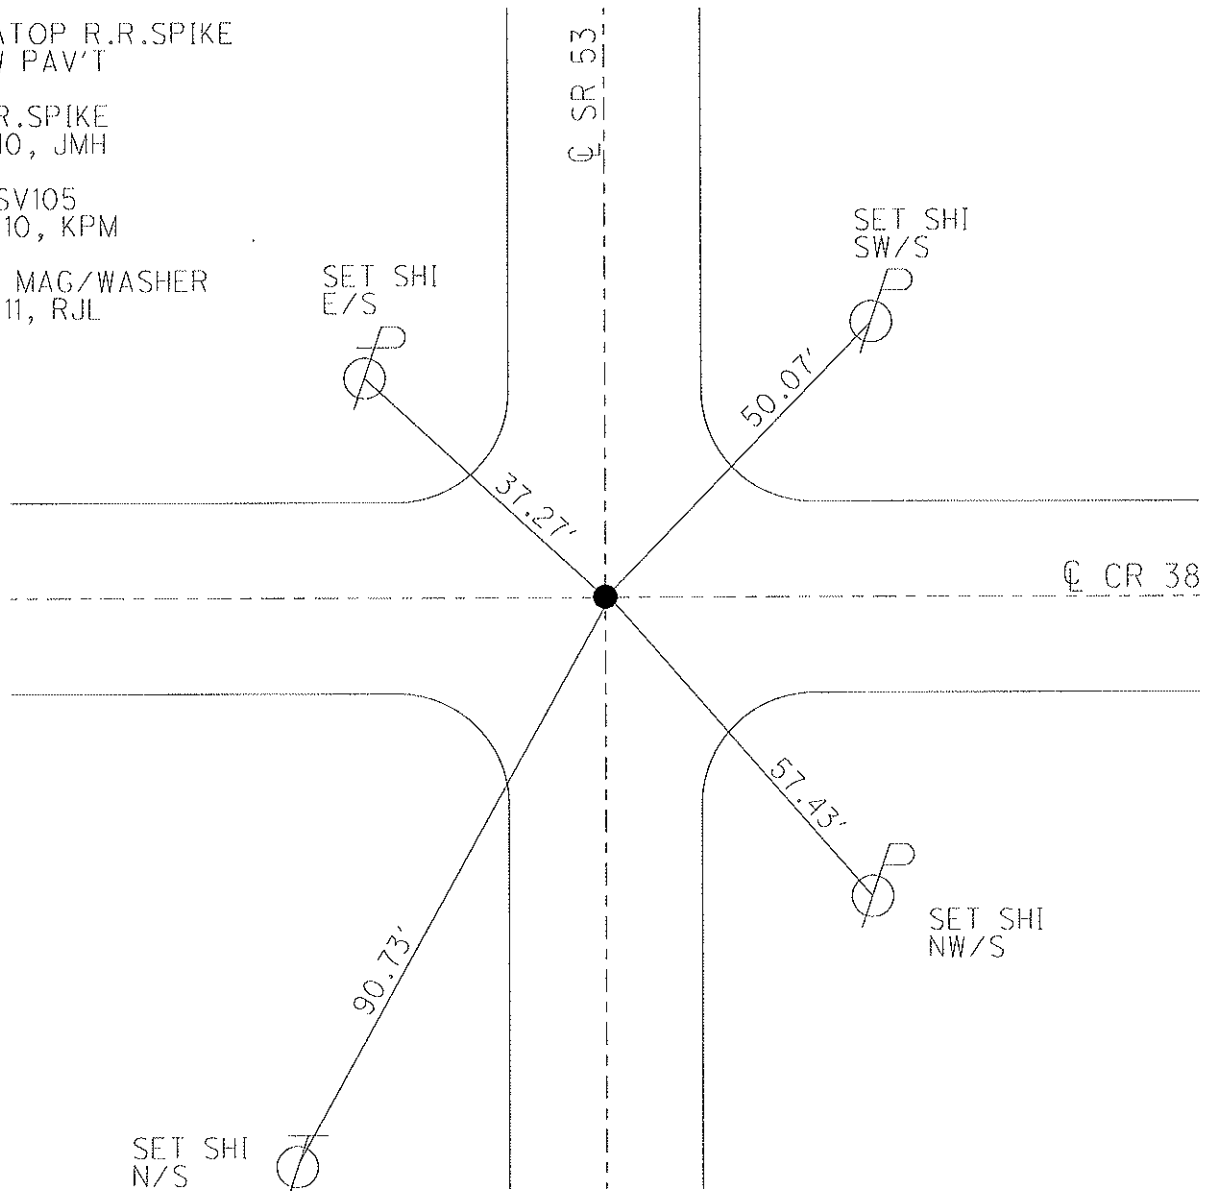

O.D.O.T. DISTRICT 2 SURVEY OFFICE

PERSONNEL _____

REFERENCE NO. 8

SHEET 8 OF 21

NOTES Cronin

H.C. Barbour

R.C. Geyman

DATE 6/30/88

WEATHER sunny

TEMP. 60°

ROUTE # 53

COUNTY Seneca

TOWNSHIP Clinton

SECTION 6

T. 2 N. R. 15 E.

TYPE MONUMENT P.K.


ON SURFACE - BELOW _____

LEFT - ☉ PAV'T. - RIGHT _____


TO _____ EDGE PAVEMENT

S.L.M. Sta 695+38.31

(61)

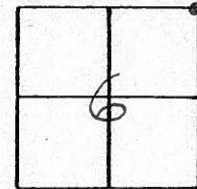

P.K. atop R.R.
Spike below pav't.
Dig when needed

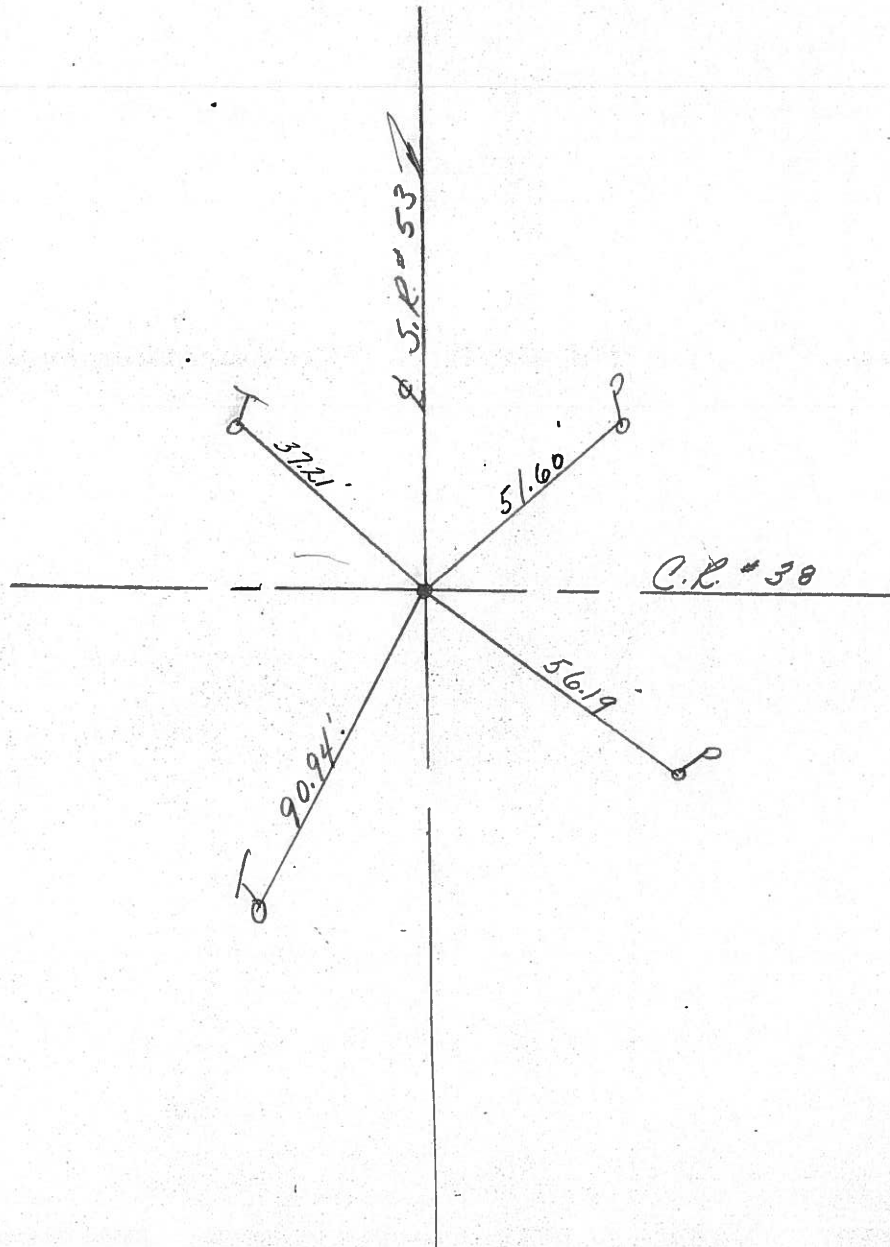

OD.O.T. DISTRICT 2 SURVEY OFFICE

Sht. ___ of ___

County Seneca S.R. 53

Date 31 July 80

Township Clinton - Pleasant

Weather Windy

Section Cor. Sec. 5-6-31-32

Temp. 81°


T. N, R. E

Personnel J. Stone
P. Houser
D. Curtis
R. Michalak

31	32
6	5



R.S. No. 61

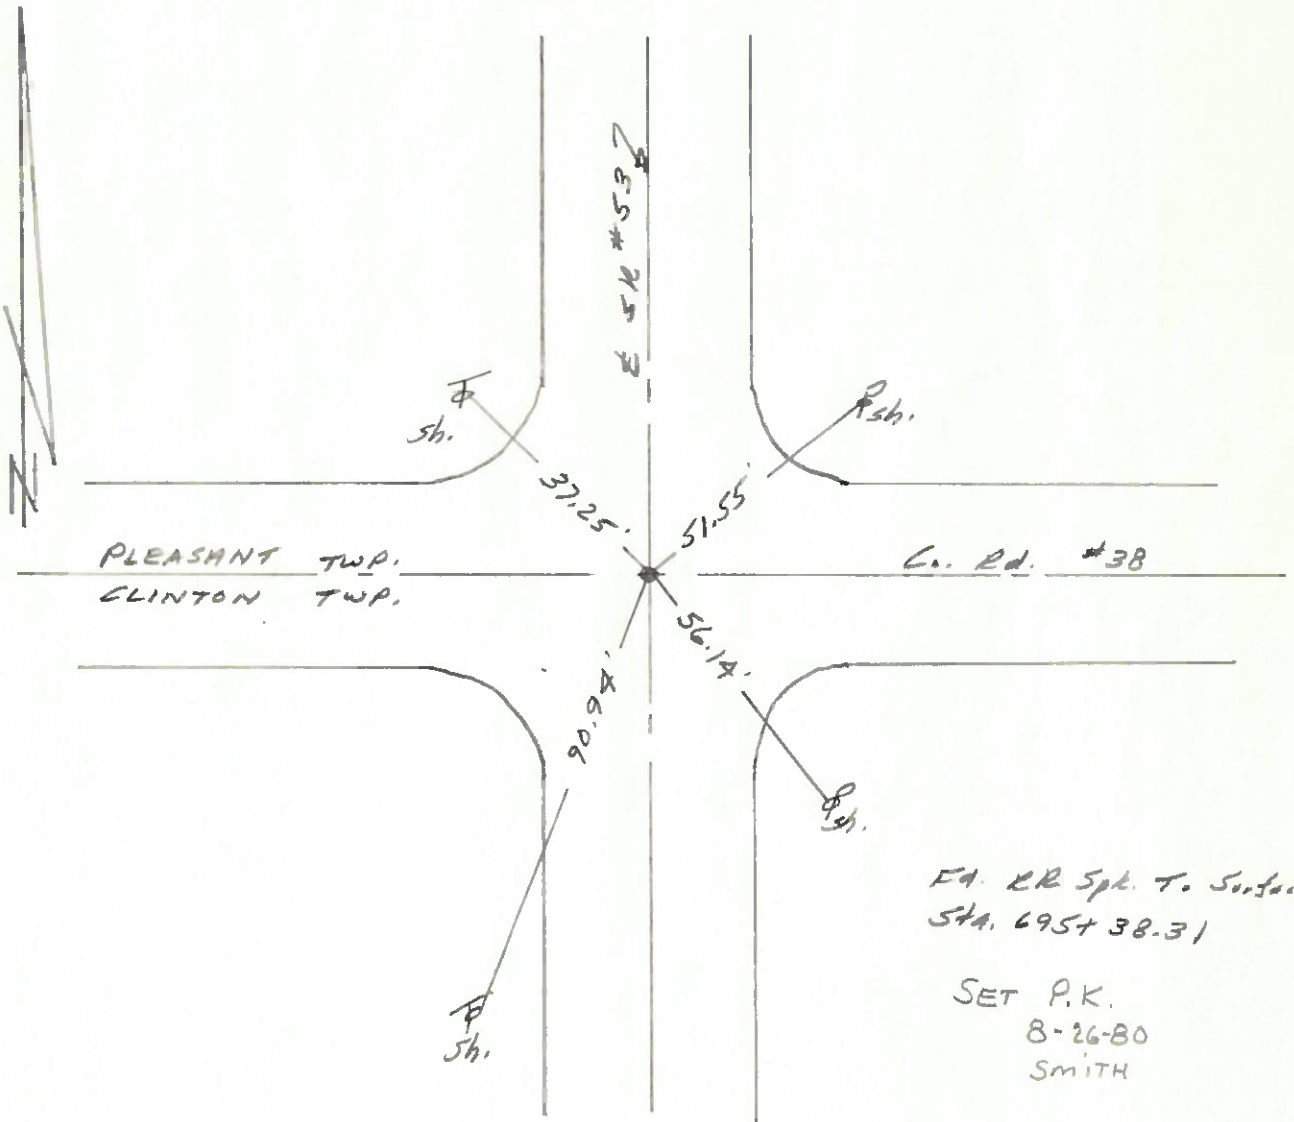

PERSONNEL TITLE PERSONNEL TITLE

Schneider

Mosser

Barbour

COUNTY Seneca

DATE 3-20-79

S. R. 53

WEATHER Fair

SEC. 29, 30 & 31, 32

TEMP. 55°

DESCRIPTION Tiffin to Sandusky Co. Line

JOB NO.

LEFT


CENTER LINE

RIGHT

63

P.I.
745 + 41.90
small spk.


Co. Rd. # 592
West

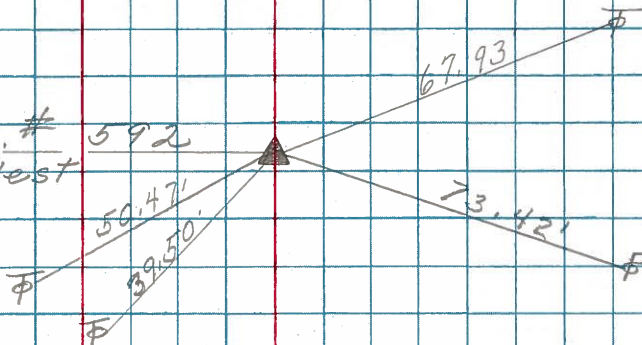

62

P.I.
729 + 48.88
small spk.


State Farm Ins. sign

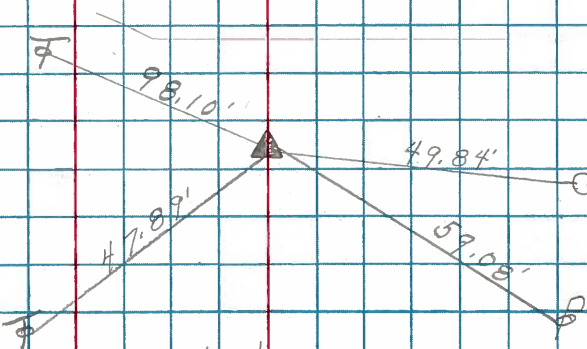

61

P.I.
695 + 38.31
small spk.

Co. Rd. # 38

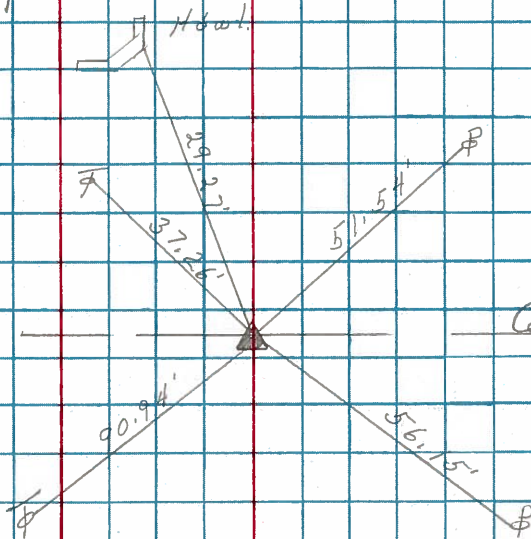


PERSONNEL	TITLE	PERSONNEL	TITLE	COUNTY	DATE
Schnöder				Seneca	9-18-69
Mosser				S. R. 53	WEATHER Fair
Barbour				SEC. Tiffin to Sen. Co. Line	TEMP. 60°
Potts					

DESCRIPTION Ties for Control Points LEFT CENTER LINE RIGHT JOB NO.


61

695+38.31
small spk.
8376

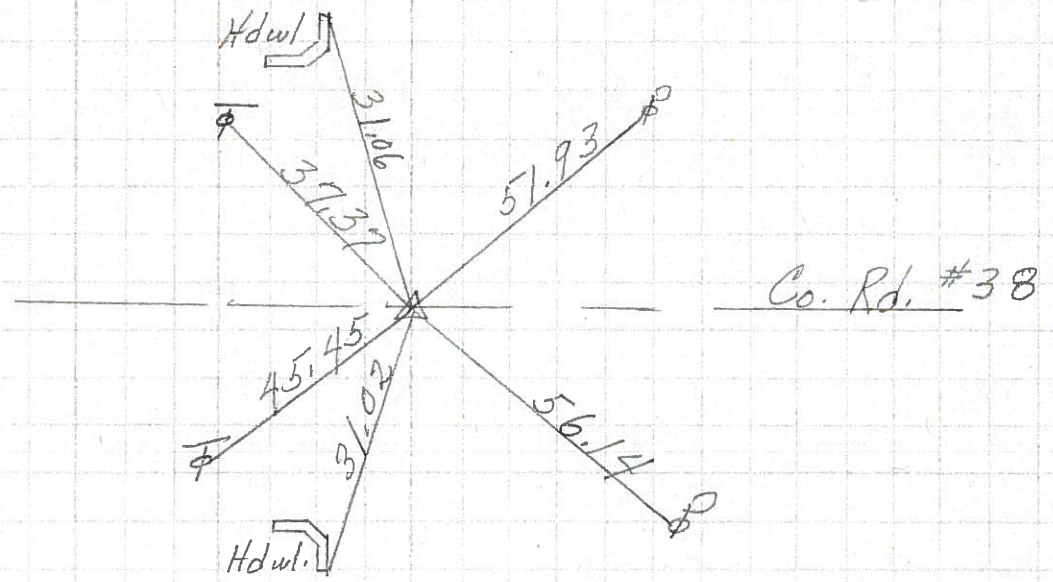


60

P.I.
669+33.75
small spk.
8375

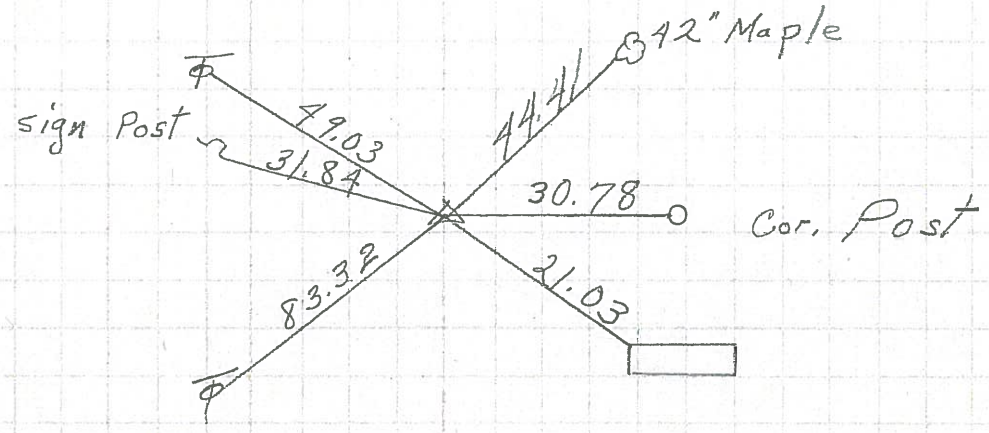


59

642+79.65
small spk.
8374

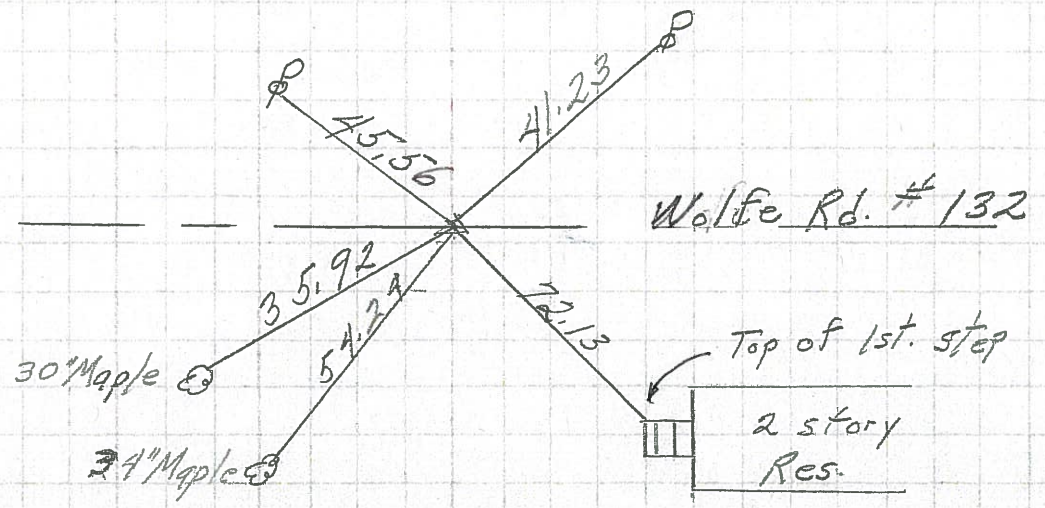

PERSONNEL	TITLE	PERSONNEL	TITLE	COUNTY	DATE
Krabill				Seneca	
Kawaleski				S. R. 53	WEATHER
Geyman				SEC.	TEMP.
DESCRIPTION				Clinton Twp	JOB NO.

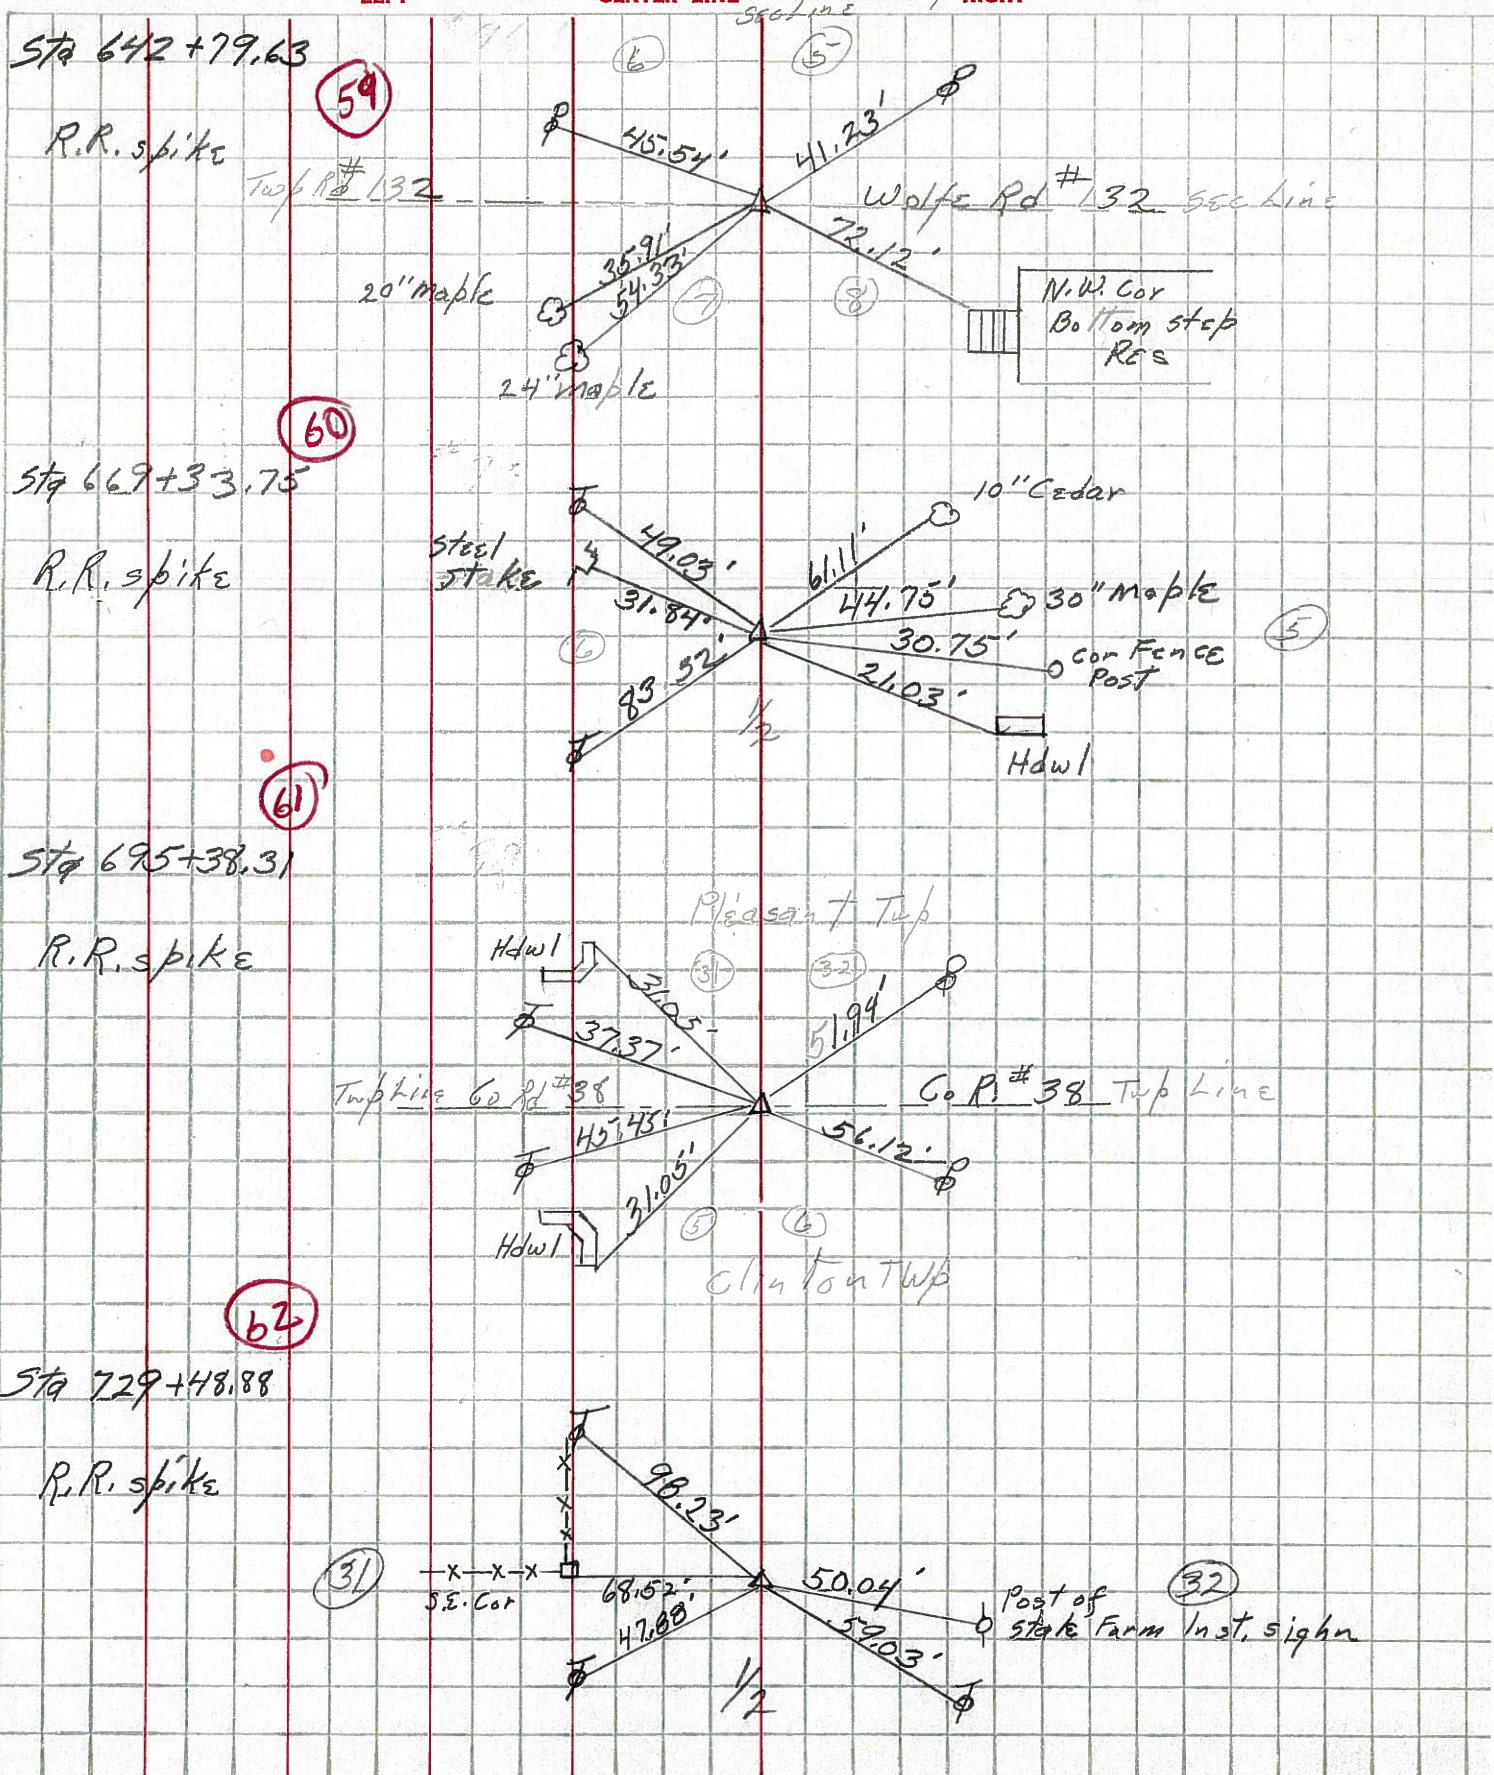

Sta 642+79.63
R.R. spike

59

Sta 669+33.75
R.R. spike

60

Sta 695+38.31
R.R. spike

61

Sta 729+48.88
R.R. spike

62