


O.D.O.T. DISTRICT 2 SURVEY OFFICE

PERSONNEL	REFERENCE NO. <u>64</u>	SHEET <u>10</u> OF <u>26</u>
NOTES <u>MOSE</u>	DATE <u>6/14/11</u>	ROUTE <u>SR 53</u>
H.C. <u>LUMBREZER</u>	WEATHER <u>CLOUDY</u>	COUNTY <u>SENECA</u>
R.C. <u>HARBAUGH</u>	TEMP. <u>70°</u>	TOWNSHIP <u>PLEASANT</u>
		SECTION <u>30</u>
		T <u>3</u> N R <u>15</u> E

TYPE MONUMENT P.K.SHANK  
 ON SURFACE - ~~BELOW~~ ON \_\_\_\_\_  
~~LEFT~~ - Q PAV'T - RIGHT 1.7'  
9.9' TO RT EDGE PAVEMENT  
 S.L.M. 772+10.03

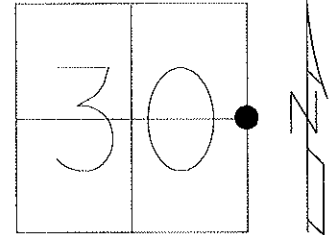


Grid: Northing:555228.0485 Easting:1784569.2042

P.K. ATOP SM.R.R.SPIKE  
 BELOW P.K./WASHER

FD P.K.SHANK  
 GPS, SV108  
 6/1/10, JMH

RESET MAG/WASHER  
 9/28/11, RJL

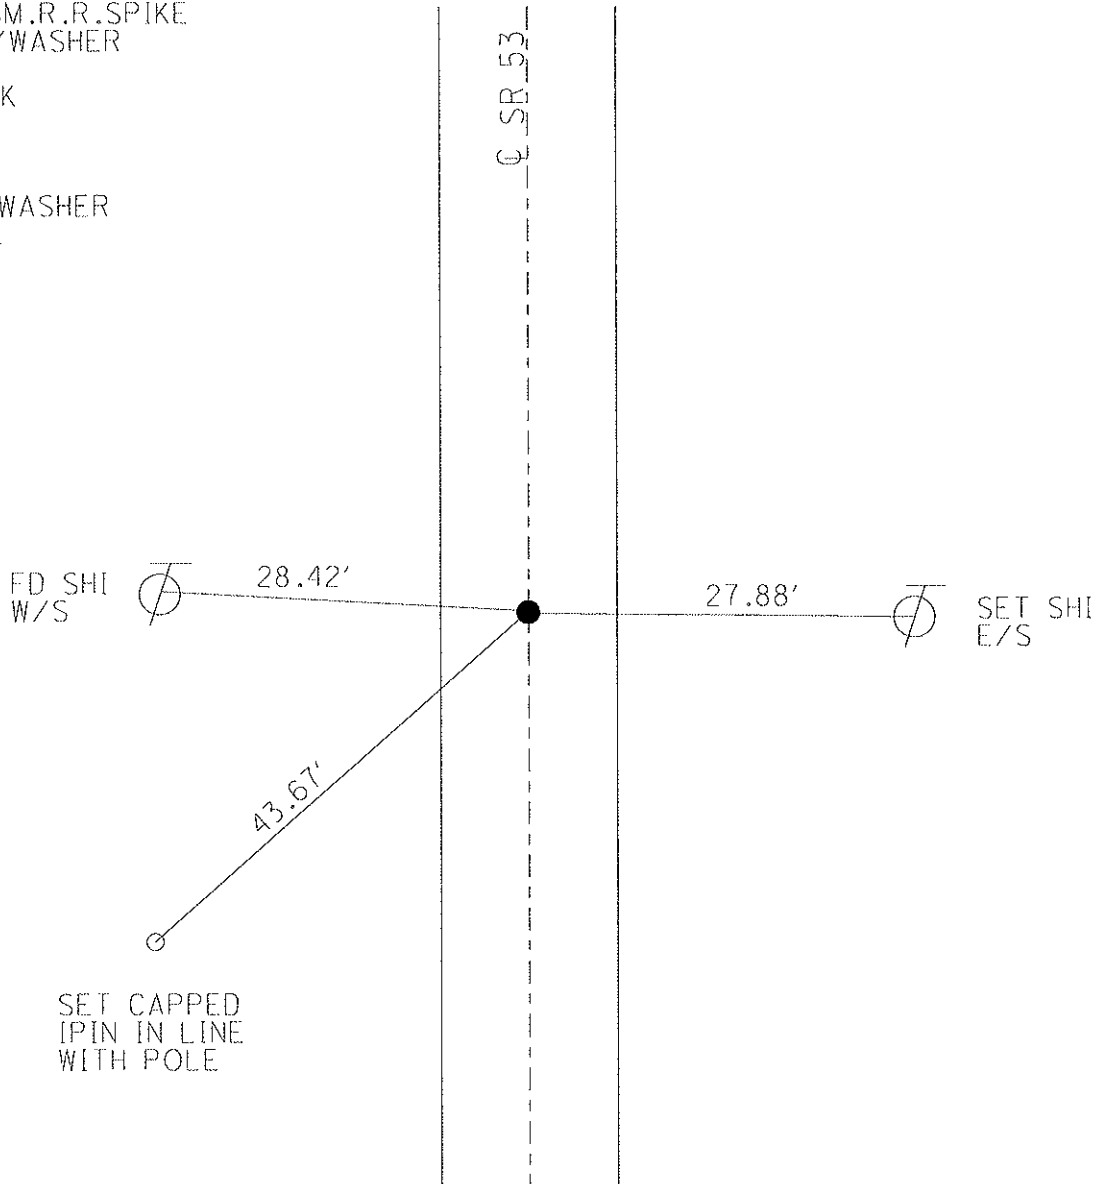

O.D.O.T. DISTRICT 2 SURVEY OFFICE

PERSONNEL

REFERENCE NO. 64

SHEET 11 OF 21

NOTES Cronin

H.C. Rippk

R.C. Barbour

Geyman

DATE 8/25/88

WEATHER sunny

TEMP. 65°

ROUTE #53

COUNTY Seneca

TOWNSHIP Pleasant

SECTION 30

T. 3 N R. 15 E


TYPE MONUMENT P.K. & washer

ON SURFACE - BELOW


LEFT - 0 PAV'T. - RIGHT 1.5

TO EDGE PAVEMENT

S.L.M. Sta. 772+0371

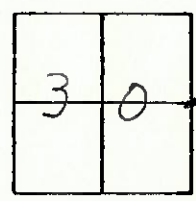

P.K. atop small spike below P.K. & washer

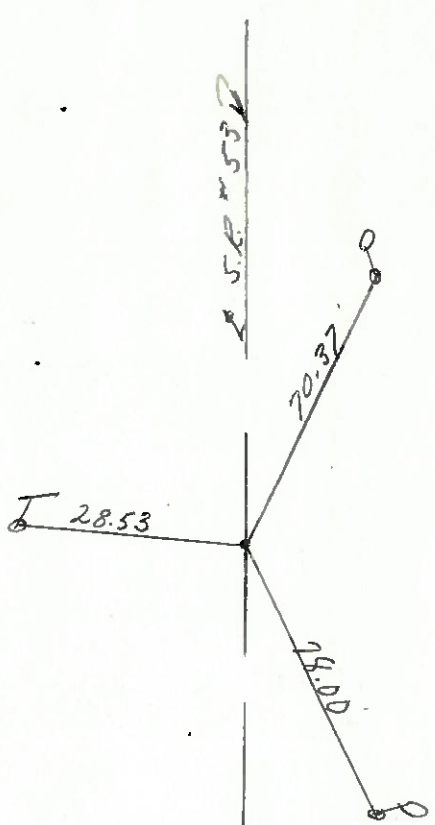

PERSONNEL	TITLE	PERSONNEL	TITLE	COUNTY	DATE
<u>Schneider</u>				<u>Seneca</u>	<u>6-27-77</u>
<u>Cronin</u>				S. R. <u>53</u>	WEATHER <u>Fair</u>
<u>Ripple</u>				SEC. <u>29 &amp; 30-19 &amp; 20</u>	TEMP. <u>80°</u>
<u>Geyman</u>					

DESCRIPTION Tiffin to Sandusky Co. Line JOB NO. \_\_\_\_\_

(65-A)

P.I.  
 813+62.67 R/w Mon. ⊕ 29.93 ⊖ 30.03' R/w Mon.  
 small spk.  
 Reset P.K. Nail  
 after Black Top

(65)

798+66.03  
 small spk.  
 Reset P.K. Nails

Co. Rd. # 150

28" Maple


28" Maple

Co. Rd. # 150

New pole

(64)

P.I.  
 772+03.71  
 small spk.  
 Reset P.K. Nail

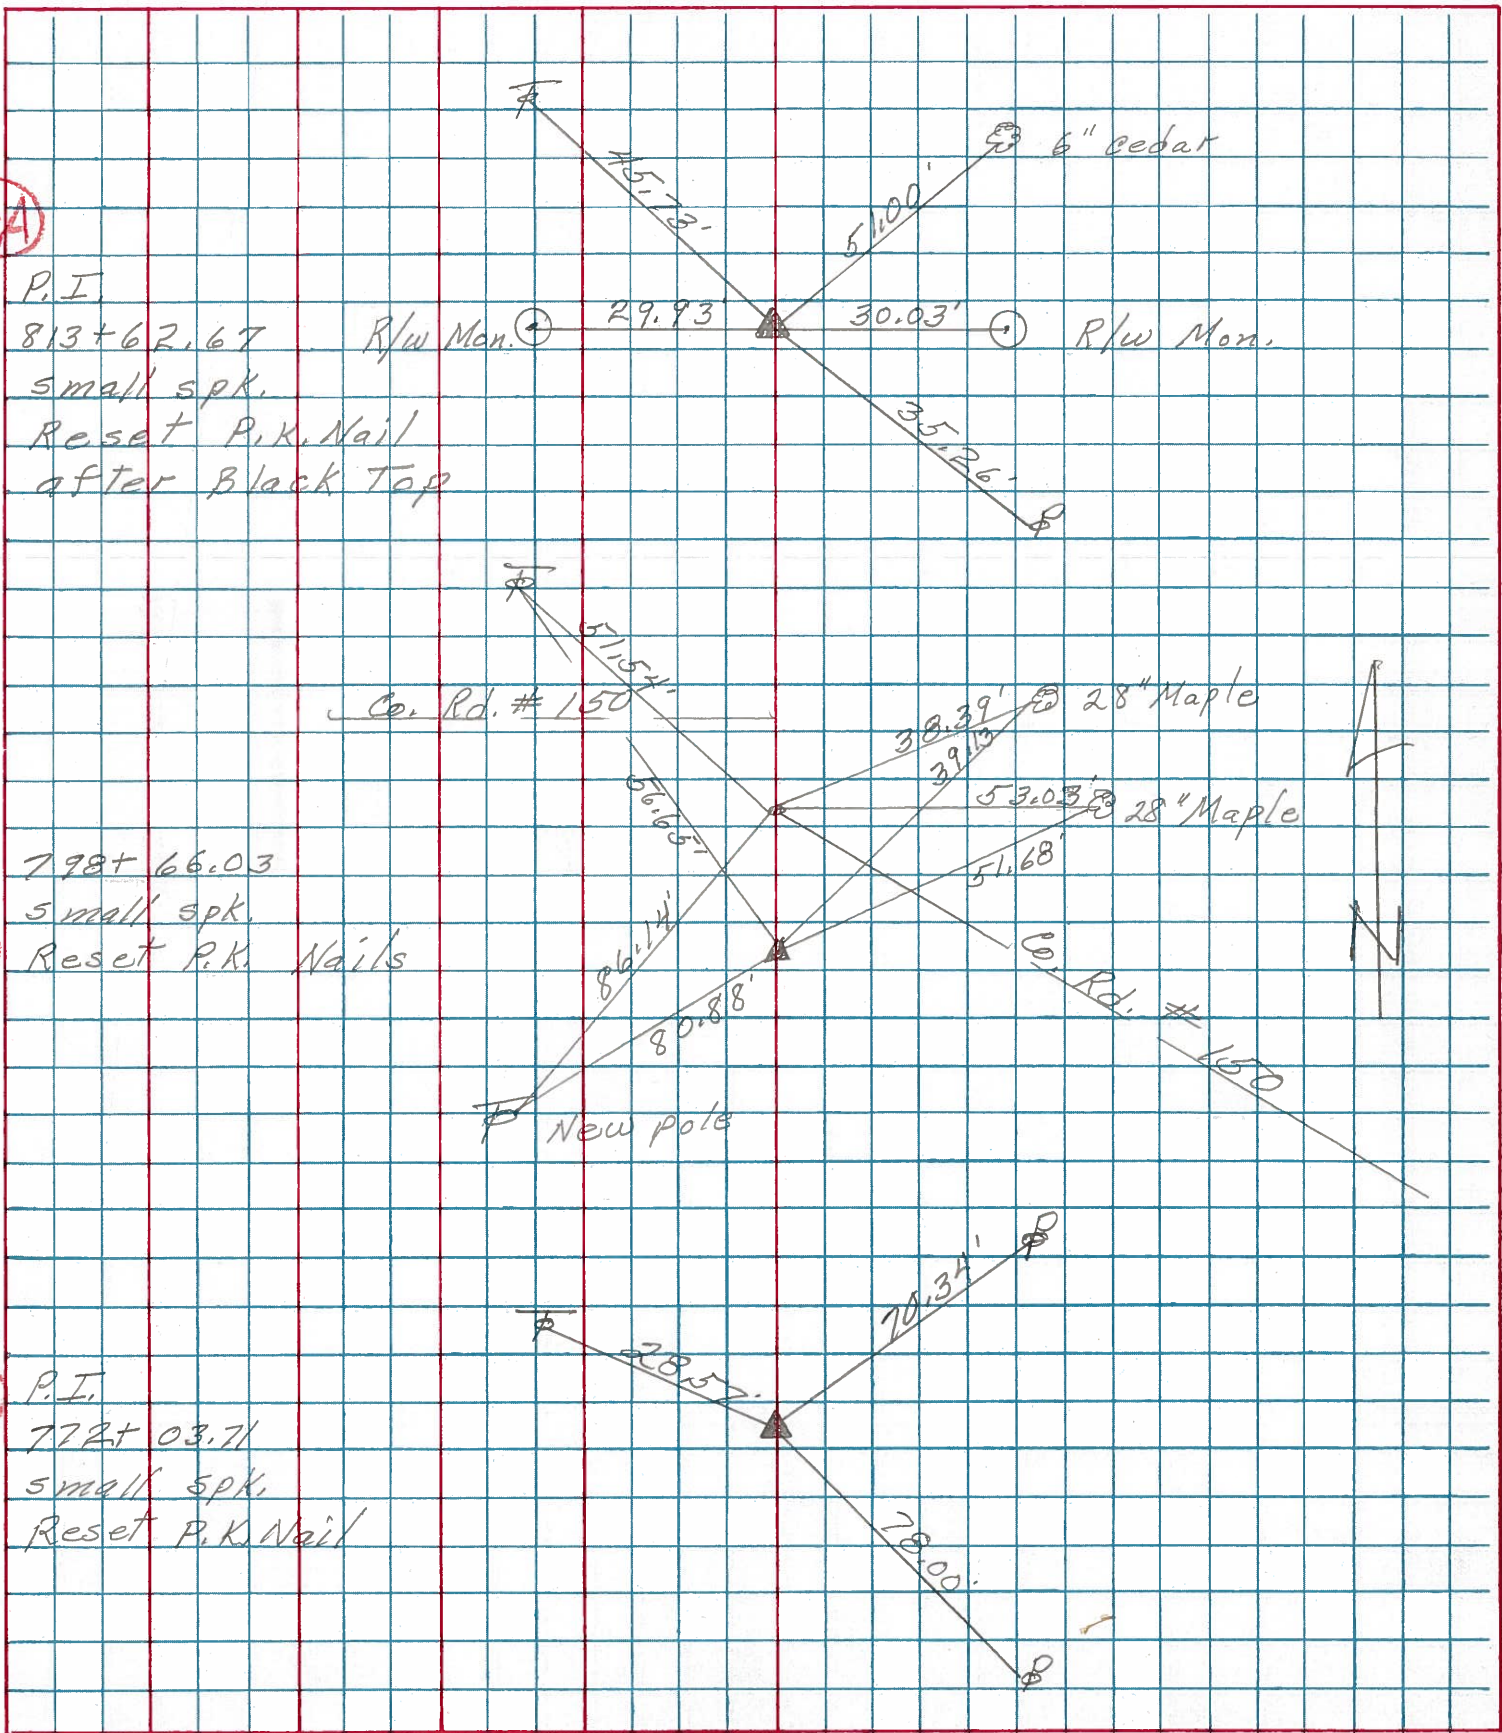




PERSONNEL	TITLE	PERSONNEL	TITLE
Schneider			
Mosser			
Barbour			
Potts			

COUNTY Seneca DATE 9-18-69  
 S. R. 53 WEATHER Fair  
 SEC. Tippin to Sar. Co. line TEMP. 65°

DESCRIPTION Ties for Control Points JOB NO. \_\_\_\_\_


(65)

798+66.03  
 Small spk.  
 8380

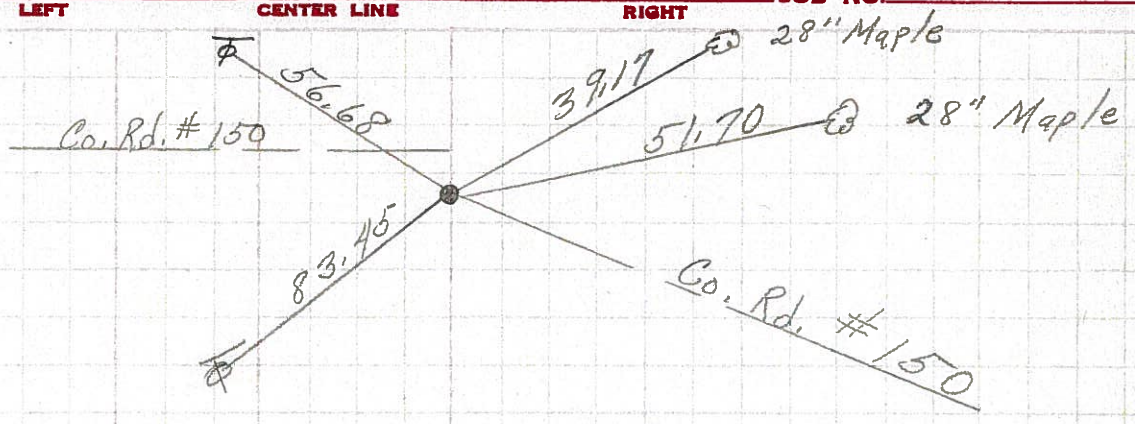


(64)

772+03.71  
 Small spk.  
 8379

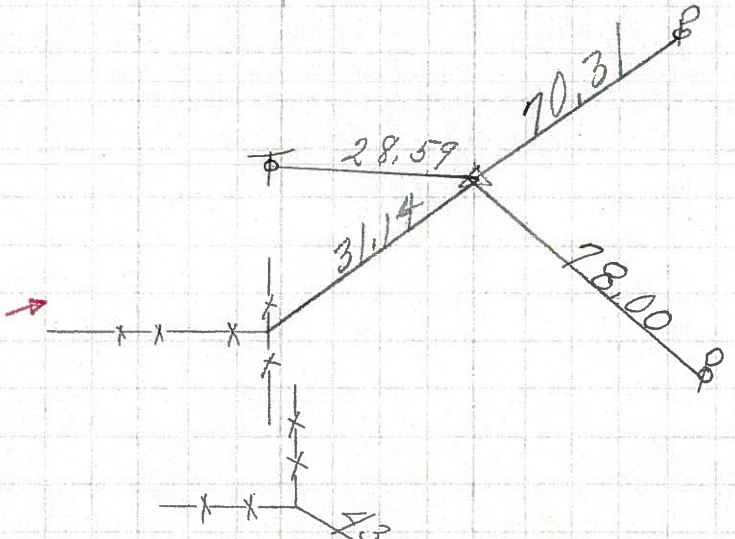


(63)

745+41.90  
 Small spk.  
 8378

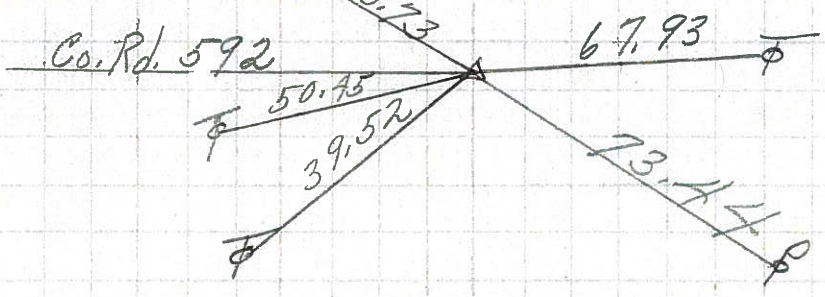

(62)


729+48.88  
 Small spk.  
 8377

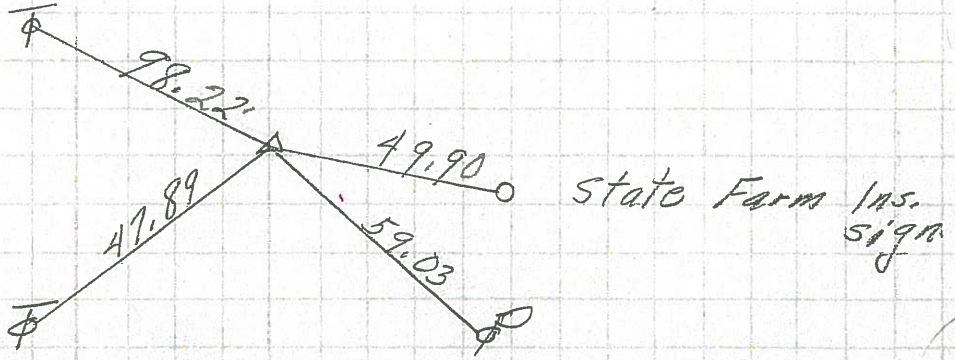



PERSONNEL	TITLE	PERSONNEL	TITLE	COUNTY	DATE
Krabill				SENECA	
Knowleski				S. R. 53	WEATHER
Geyman				SEC. A-B-C	TEMP.

DESCRIPTION	LEFT	CENTER LINE	RIGHT	JOB NO.
-------------	------	-------------	-------	---------

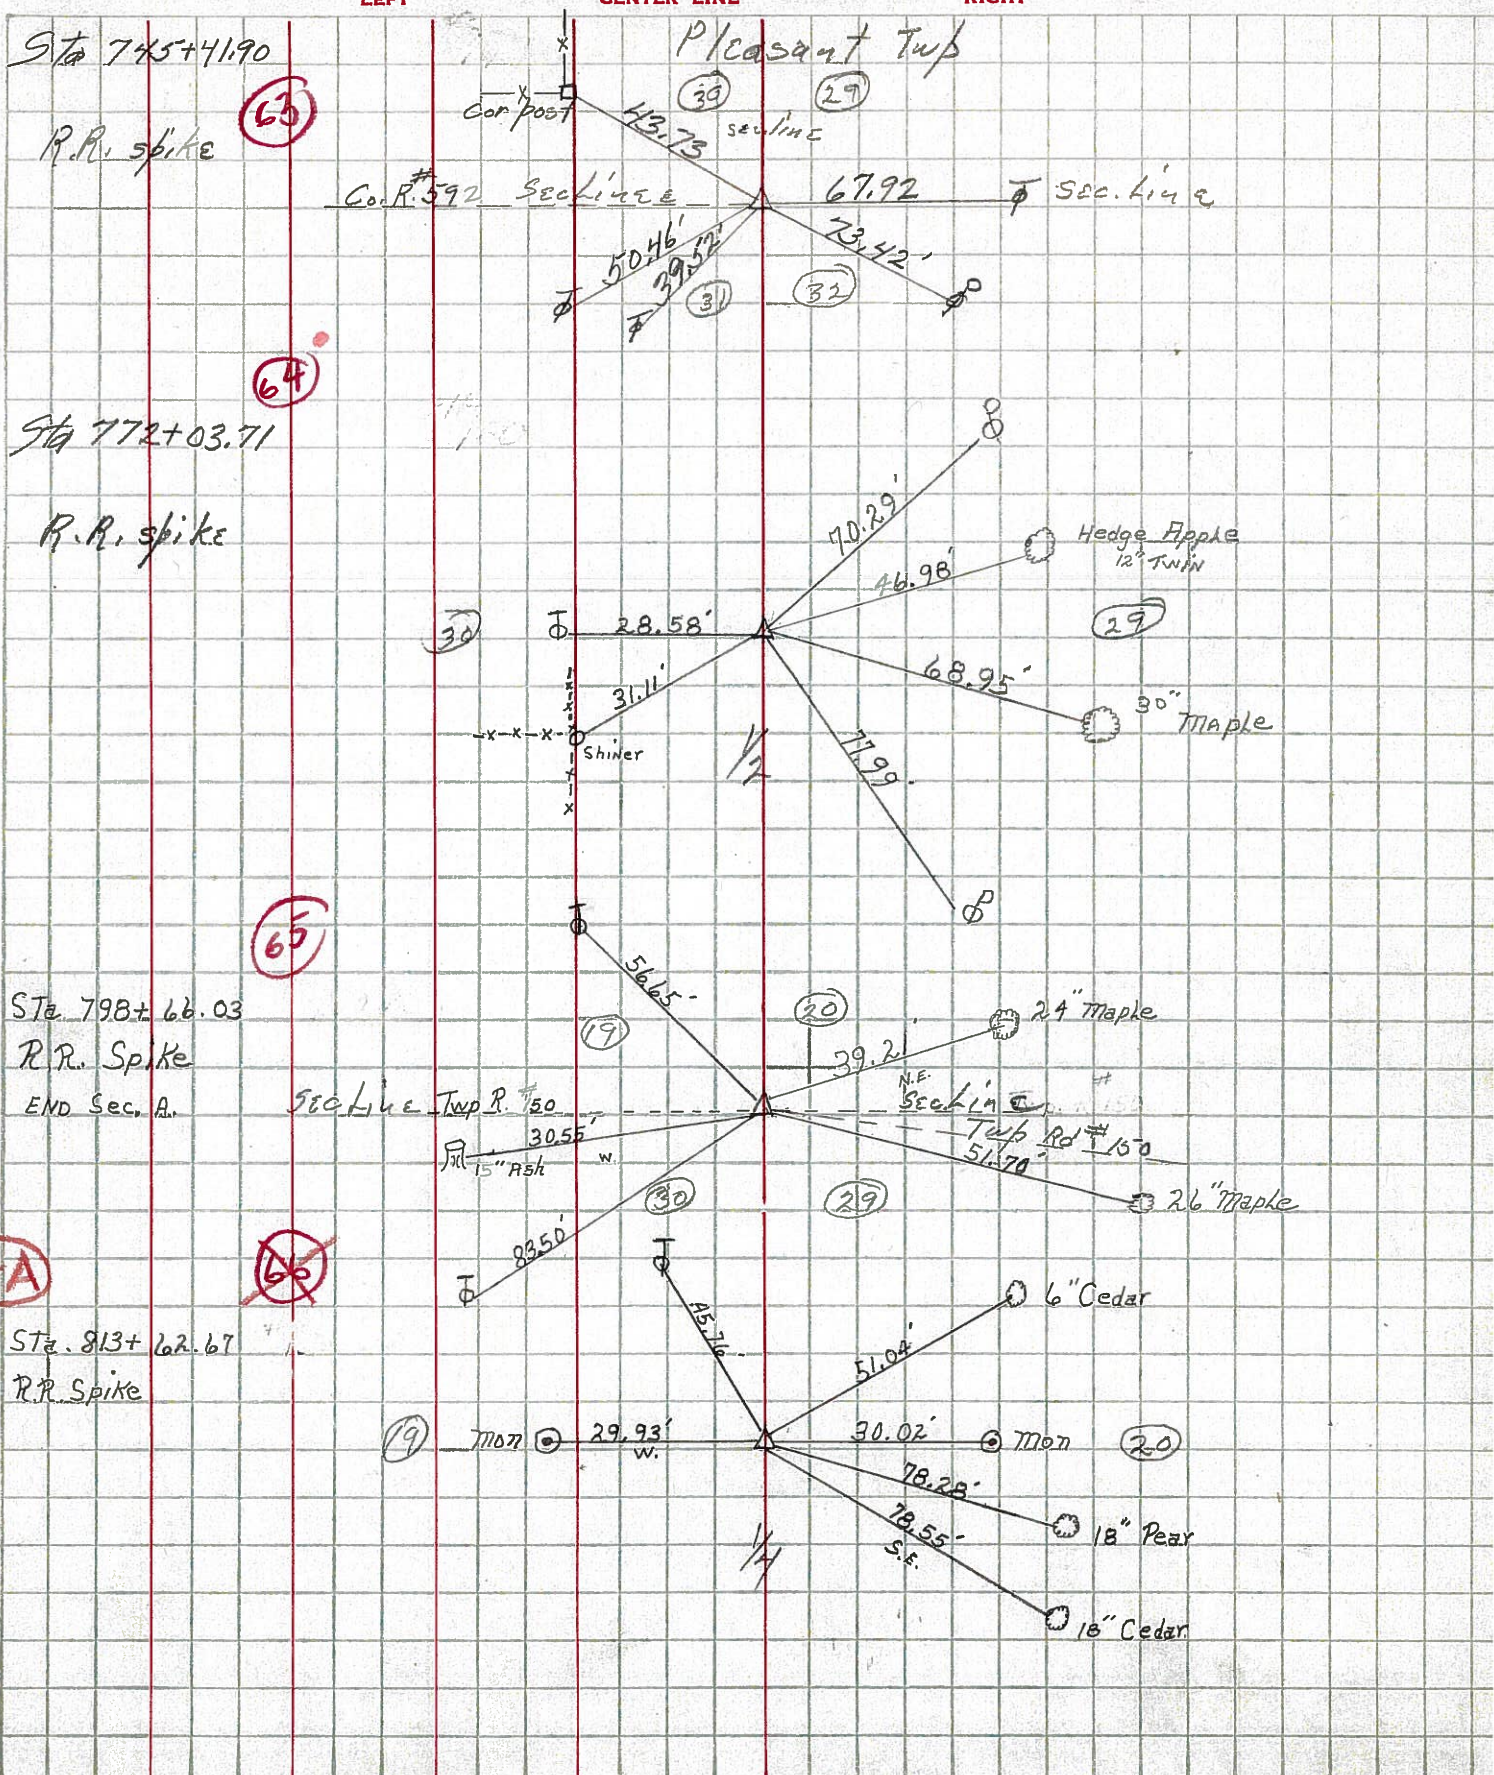

65-A

~~65~~