



O.D.O.T. DISTRICT 2 SURVEY OFFICE (USE ONLY)

PERSONNEL	REFERENCE NO. <u>66</u>	SHEET <u>13</u> OF <u>26</u>
NOTES <u>MOSEK</u>	DATE <u>6/14/11</u>	ROUTE <u>SR 53</u>
H.C. <u>LUMBREZER</u>	WEATHER <u>CLOUDY</u>	COUNTY <u>SENECA</u>
R.C. <u>HARBAUGH</u>	TEMP. <u>70°</u>	TOWNSHIP <u>PLEASANT</u>
		SECTION <u>19</u>
		T <u>3</u> N R <u>15</u> E

TYPE MONUMENT SM.R.R.SPIKE
~~ON SURFACE~~ - BELOW 3"
 LEFT - Q PAV'T - ~~RIGHT~~ 1.2'
10.3' TO LT EDGE PAVEMENT
 S.L.M. 827+60.43

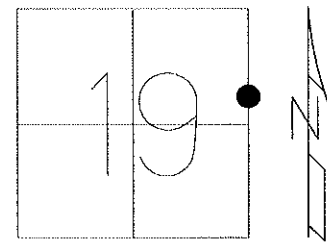

Grid: Northing: 560772.8849 Easting: 1784779.5640

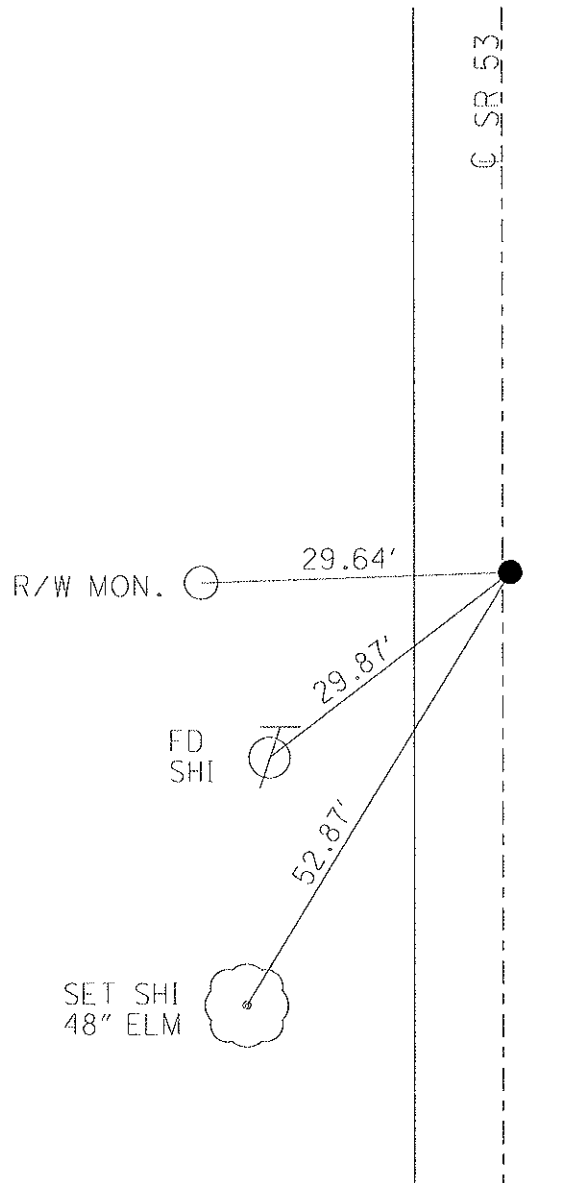

P.K. ATOP SM.R.R.SPIKE
 BELOW P.K./WASHER

FD SM.R.R.SPIKE
 GPS, SV110
 5/27/10, JMH

RESET MAG/WASHER
 GPS, FIN110
 10/4/11, RJL

O.D.O.T. DISTRICT 2 SURVEY OFFICE

PERSONNEL _____

REFERENCE NO. 66

SHEET 14 OF 21

NOTES Cronin

H.C. Ripple

R.C. Barbour

Geyman

DATE 8/25/88

WEATHER sunny

TEMP. 65°

ROUTE #53

COUNTY Seneca

TOWNSHIP Pleasant

SECTION 19

T 3 N R 15 E



TYPE MONUMENT P.K. WASHER

ON SURFACE - BELOW _____

LEFT - € PAV'T. - RIGHT 1.3'

TO _____ EDGE PAVEMENT

S.L.M. Sta. 827+52.74

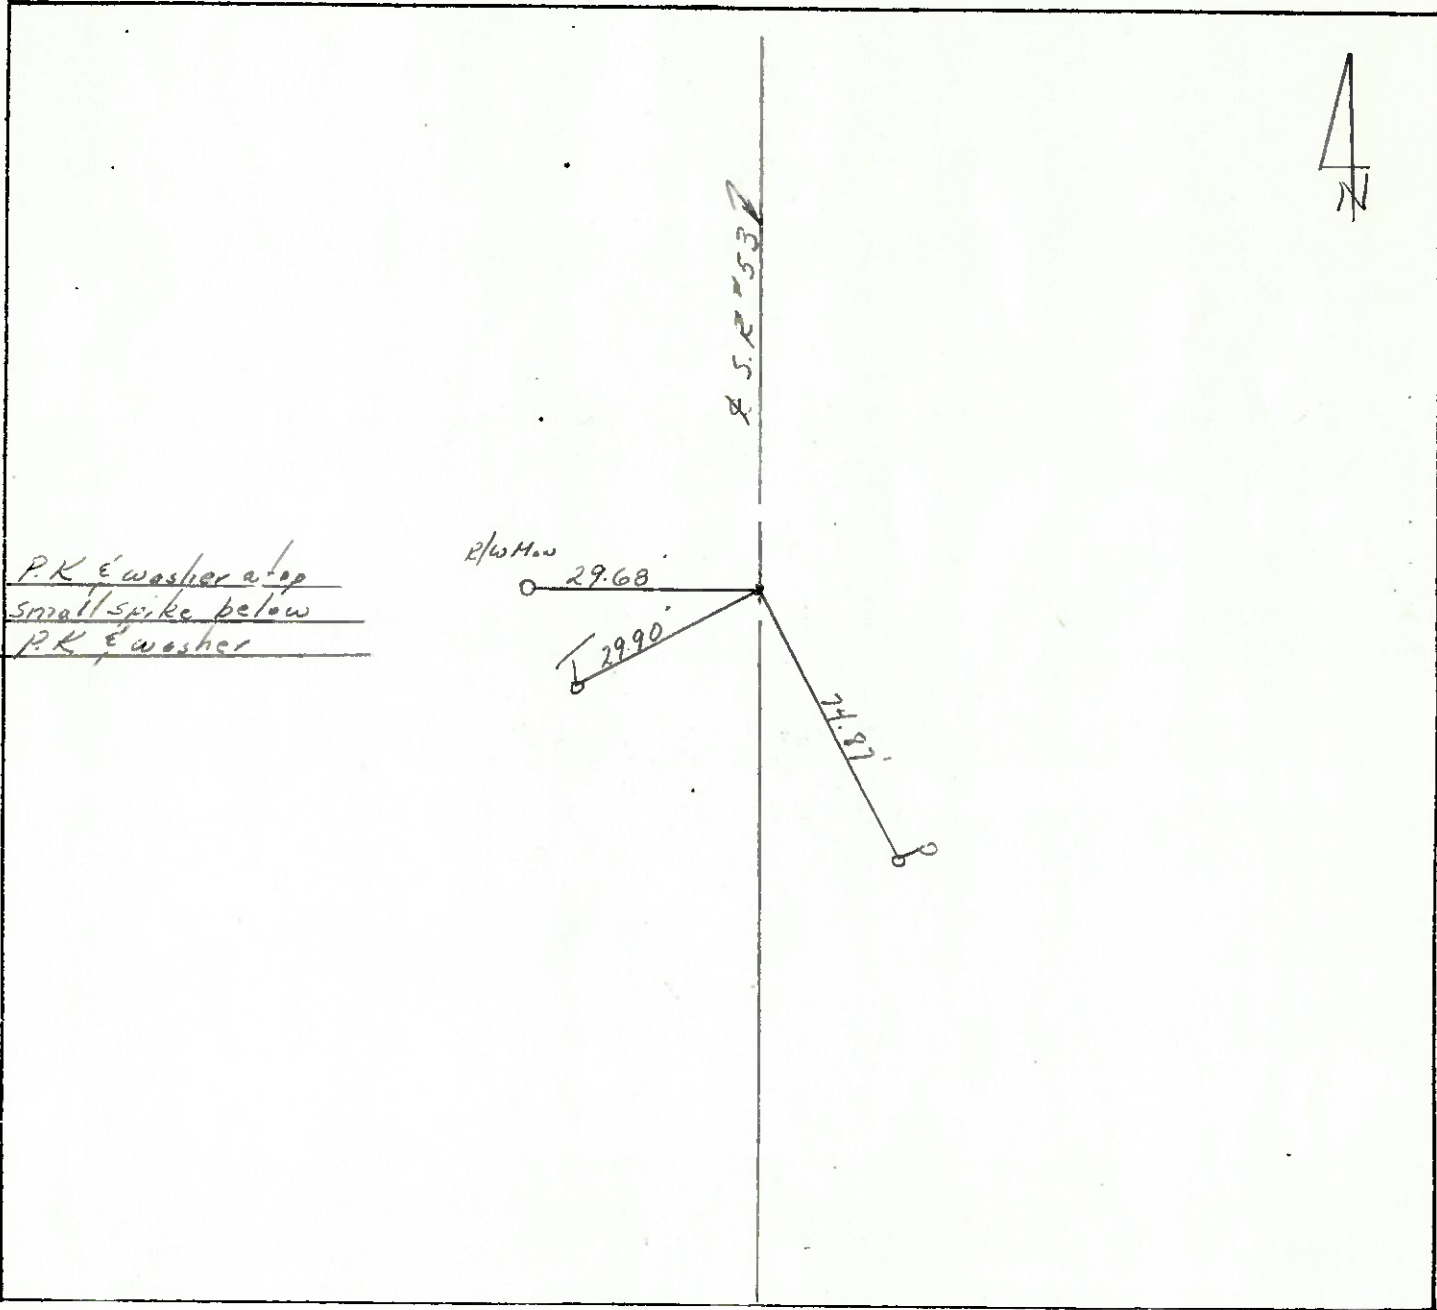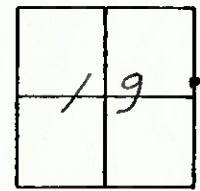

P.K. Washer at top
Small spike below
P.K. Washer


PERSONNEL	TITLE	PERSONNEL	TITLE	COUNTY	DATE		
Schneider				Seneca	6-27-77		
Cronin				S. R. 53	WEATHER Fair		
Ripple				SEC. T19E20	TEMP. 80°		
Geyman							
DESCRIPTION Tiffin to Sandusky Co Line				LEFT	CENTER LINE	RIGHT	JOB NO.

(67-A)

P.I.
853+26.81
small spk.
40' south of Co. Rd.


Co. Rd. # 30

Co. Rd. # 152
Fort Seneca

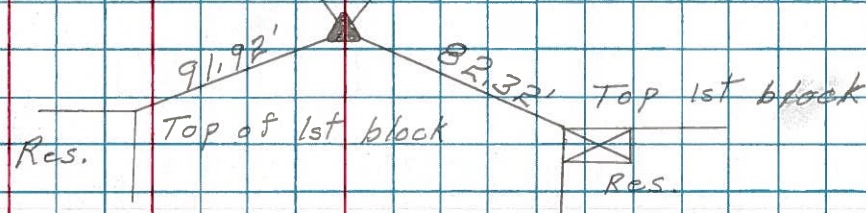


(67)

P.I.
836+68.01
small spk.
Reset P.K. Nail

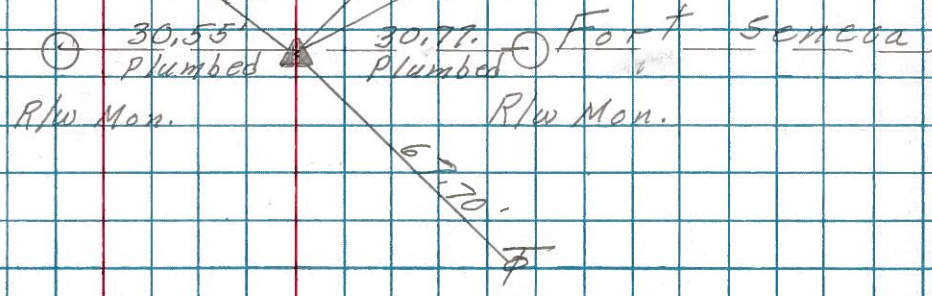

(66)

P.I.
827+52.74
small spk.
Reset P.K. Nail

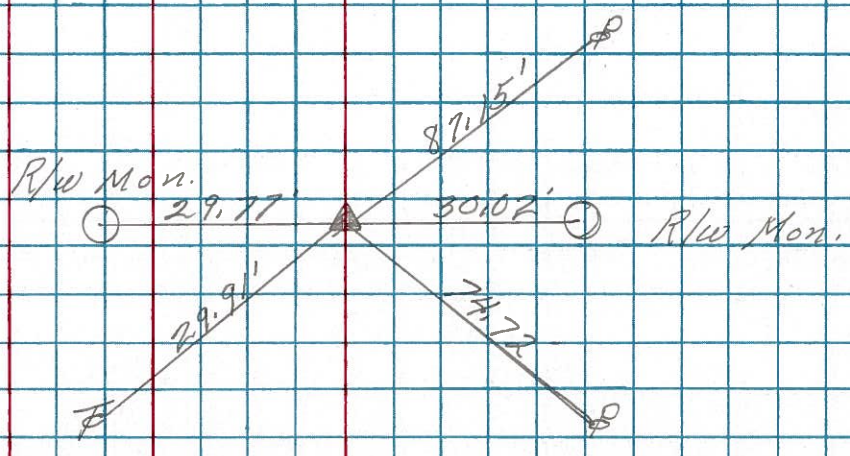


PERSONNEL	TITLE	PERSONNEL	TITLE	COUNTY	DATE
Schneider				Seneca	
Mosser				S. R. 53	WEATHER
Barbour				SEC. Tiffin to Sen. Co Line	TEMP.
Potts					

DESCRIPTION Ties for Control Points JOB NO. _____

(67-A)

853+26.81
small spk.
40' south of Co. Rd.


8384

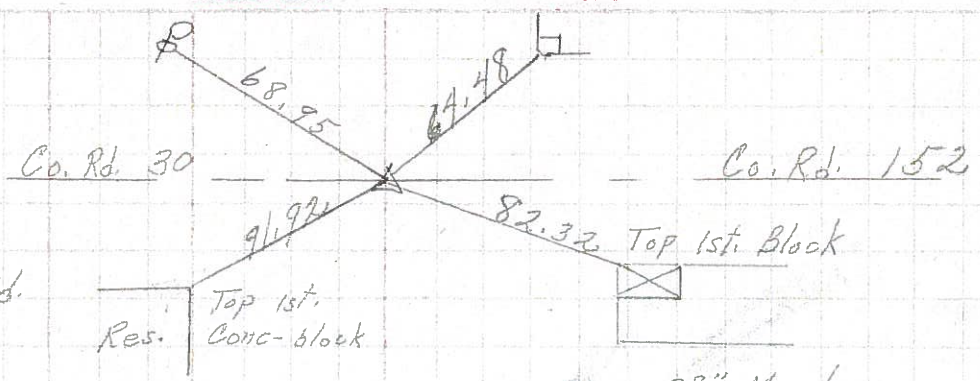

(67)

Fort Seneca
836+68.01
small spk.


8383

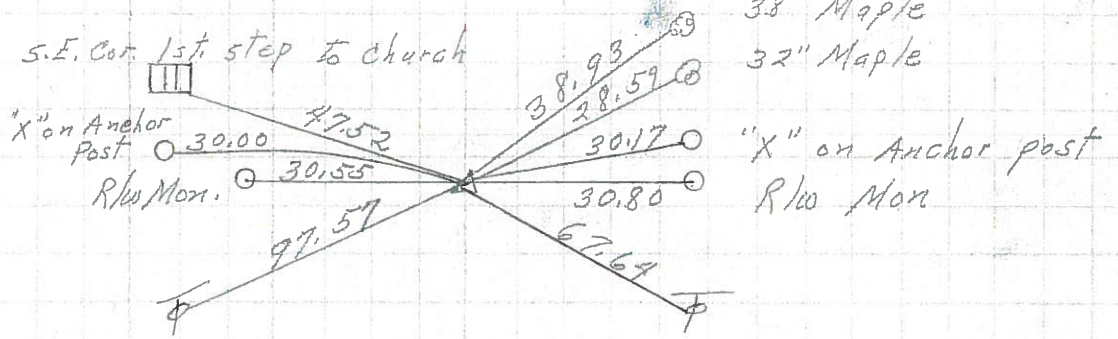

(66)

827+52.74
Small spk.


8382

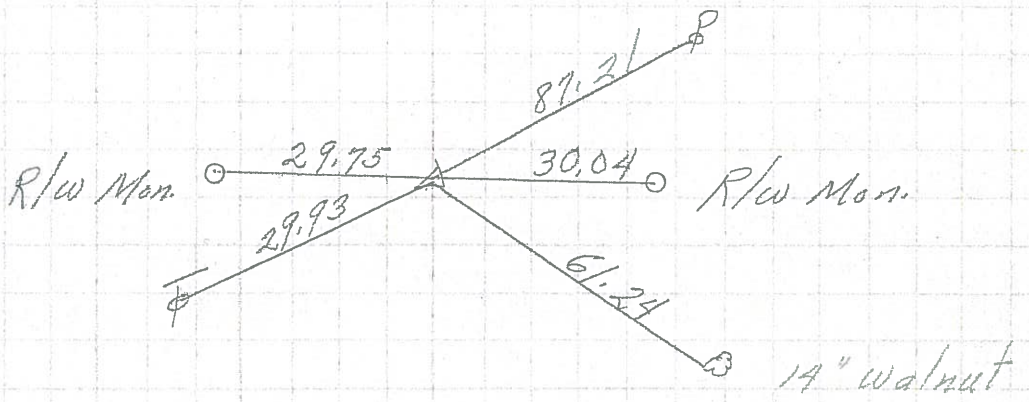

(65-A)

813+62.67
Small spk.

8381

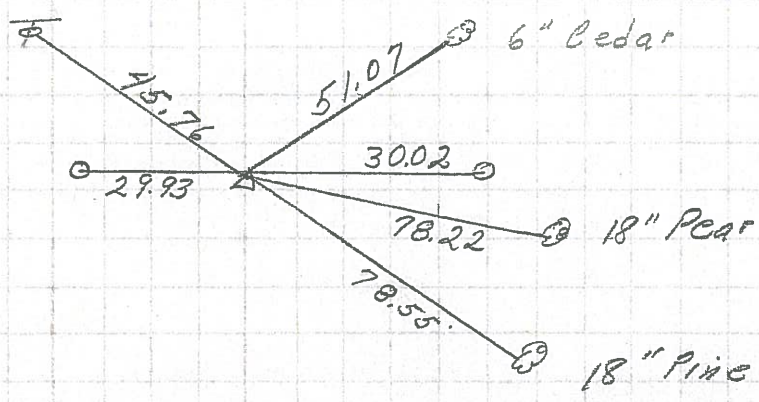

PERSONNEL	TITLE	PERSONNEL	TITLE	COUNTY	DATE
Krabill				Seneca	
Xowaleski				S. R. # 53	WEATHER
Geyman				SEC. A-B-C	TEMP.

DESCRIPTION	LEFT	CENTER LINE	RIGHT	JOB NO.
-------------	------	-------------	-------	---------

